


BALTIMORE NFL STADIUM



AT CAMDEN YARDS


HOME OF THE BALTIMORE RAVENS

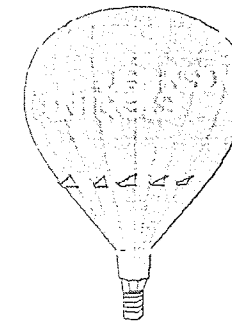

JOHNSON CONTROLS
Creating a better climate for business.

- Environmental Control System
- Building Automation System
- Fire Management System
- Security System
- Lighting Services
- Telecommunication System
- Integrated Motor Control Center
- Air and Water Systems Balancing
- Instrumentation System Installation
- Building Operations Management
- Energy Conservation Control
- Custom Programmed Maintenance

Automatic Temperature Controls
 Heating
 Air Conditioning
 Air Filters
 Water Treatment
 Coil Cleaning
 Control Center
 Fire Management
 Security Management
 Sound and Communication
 Programmed Clocks
 Contract Operations
 Time-Shared Automated Building Service
 Refrigeration
 Electrical Equipment
 Emergency Generator / Lighting Equipment
 Industrial Controls / Recording / Indication Equipment

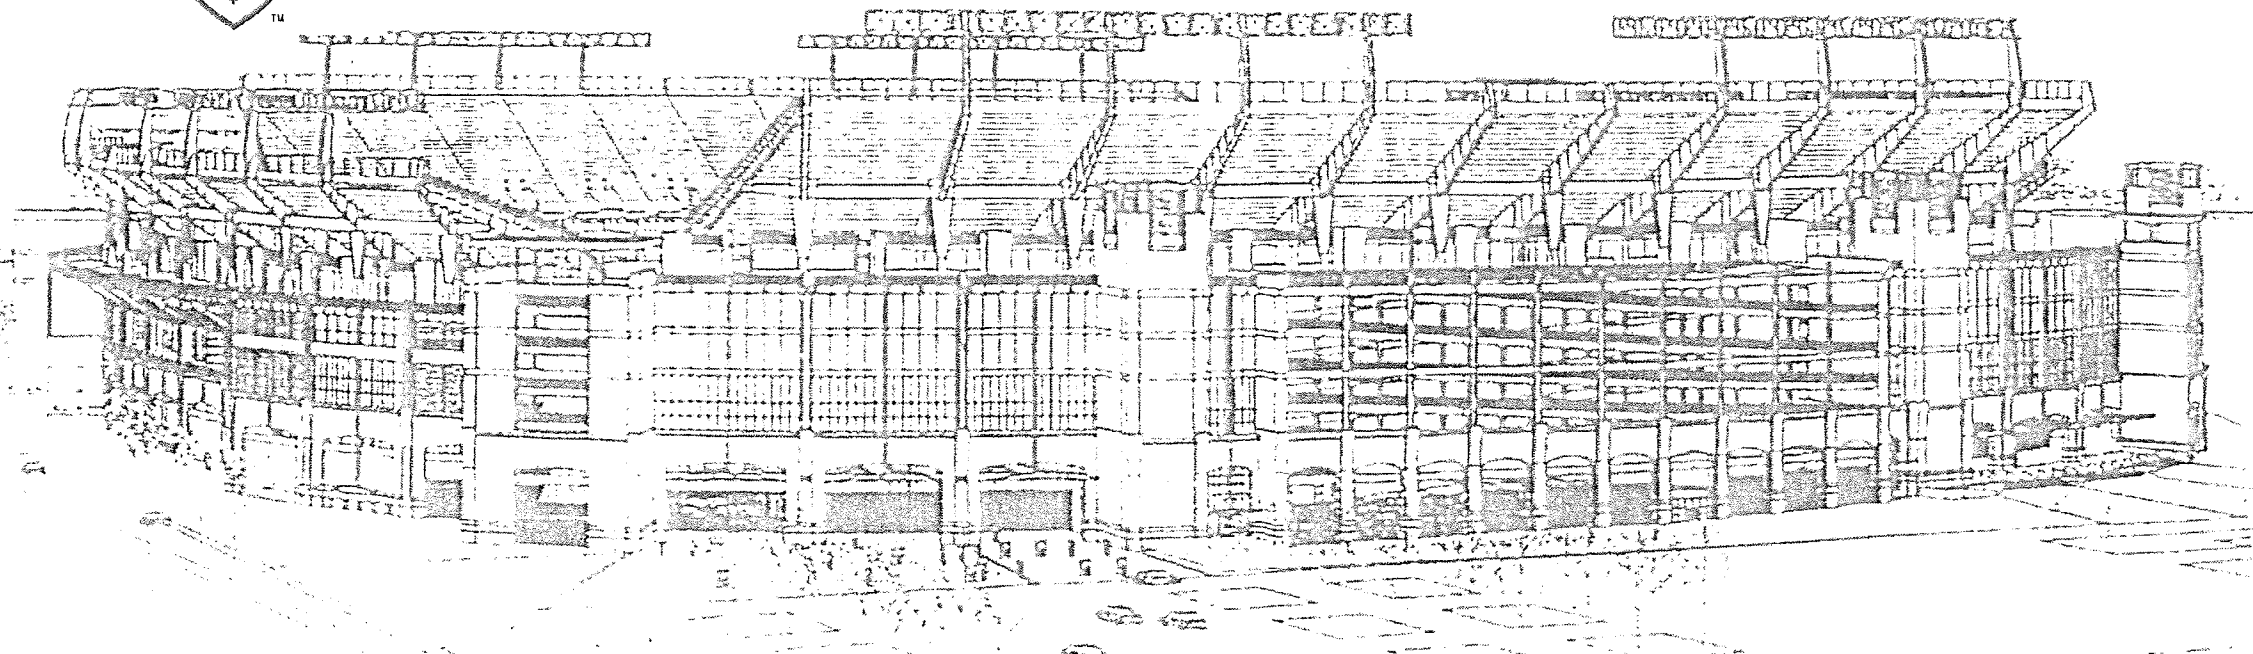

T A B L E O F C O N T E N T S

DRAWING NUMBER	DESCRIPTION	DRAWING NUMBER	DESCRIPTION
BL-6559-00	METASYS CONFIGURATION	BL-6559-31	HVU-3 GAME DAY LOCKER 3
BL-6559-01	AHU-1 CLUB/SUITES QUAD A	BL-6559-32	HVU-4 RECYCLE
BL-6559-02	FPVAV TERMINAL REHEAT QUAD A	BL-6559-33	HVU-5 FIELD MAINTENANCE
BL-6559-03	SUITE FAN COIL UNITS QUAD A	BL-6559-34	HVU-6 SHOP EAST
BL-6559-04	AHU-2 CLUB/SUITES QUAD B	BL-6559-35	HVU-7 SHOP WEST
BL-6559-05	FPVAV TERMINAL REHEAT QUAD B	BL-6559-36	HVU-8 FREIGHT ELEVATOR LOBBY
BL-6559-06	SUITE FAN COIL UNITS QUAD B	BL-6559-37	HVU-9 SERVICE TUNNEL
BL-6559-07	AHU-3 CLUB/SUITES QUAD C	BL-6559-38	HVU-10 SERVICE TUNNEL
BL-6559-08	FPVAV TERMINAL REHEAT QUAD C	BL-6559-39	HVU-11 SERVICE TUNNEL
BL-6559-09	SUITE FAN COIL UNITS QUAD C	BL-6559-40	HVU-12 SERVICE TUNNEL
BL-6559-10	AHU-4 CLUB/SUITES QUAD D	BL-6559-41	HVU-13 FREIGHT ELEVATOR LOBBY
BL-6559-11	FPVAV TERMINAL REHEAT QUAD D	BL-6559-42	CHILLED WATER SYSTEM
BL-6559-12	SUITE FAN COIL UNITS QUAD D	BL-6559-43	HOT WATER SYSTEM
BL-6559-13	AHU-9 PRESS LEVEL QUAD B & C	BL-6559-44	DOMESTIC HOT WATER SYSTEM
BL-6559-14	FPVAV TERMINAL REHEAT QUAD C	BL-6559-45	MISCELLANEOUS SYSTEMS
BL-6559-15	AHU-10 GAME DAY SERVICES	BL-6559-46	ATRIUM SMOKE EXHAUST
BL-6559-16	AHU-11 STADIUM OPERATIONS	BL-6559-47	ELECTRIC METERING/HEAT TRACE
BL-6559-17	AHU-12 BROADCAST MEDIA	BL-6559-48	MAU-2A KITCHEN FOOD SER QUAD A
BL-6559-18	AHU-13 SECURITY	BL-6559-49	MAU-2B CLC-2-PANTRY QUAD B
BL-6559-19	AHU-14 OFFICIALS	BL-6559-50	MAU-2C CLC-3-PANTRY QUAD C
BL-6559-20	AHU-15 VISITING LOCKER NO.1	BL-6559-51	MAU-2D CLC-4-PANTRY QUAD D
BL-6559-21	AHU-16 VISITING LOCKER NO.2	VALVE-1	VALVE SCHEDULE NO.1
BL-6559-22	AHU-17 HOME TEAM AREA	VALVE-2	VALVE SCHEDULE NO.2
BL-6559-23	TERMINAL REHEAT COILS	DAMPER-1	DAMPER SCHEDULE NO.1
BL-6559-24	AHU-18 HOME TEAM STORAGE	DAMPER-2	DAMPER SCHEDULE NO.2
BL-6559-25	AHU-19 MEDIA LOUNGE		
BL-6559-26	AHU-24 TICKET OFFICE QUAD C		
BL-6559-27	AHU-25 TICKET OFFICE QUAD D		
BL-6559-28	AHU-26 TICKET OFFICE QUAD B		
BL-6559-29	HVU-1 CONCESSION STO/COMM		
BL-6559-30	HVU-2 CONCESSION LOCKERS		

NOTE: ALL AHU/HVU EQUIPMENT TO HAVE ONE (1) DISCHARGE AIR THERMOMETER

T-2100-202 (-40TO160F)

REVISION INFORMATION	
NUMBER	
DATE	07/18/00
TIME	12:01 PM
FILE NAME	TITLERV1.vsd

IN CONSIDERATION OF THE RECEIPT OF THIS DOCUMENT, THE RECIPIENT AGREES NOT TO REPRODUCE, COPY, USE OR TRANSMIT THIS DOCUMENT AND/OR THE INFORMATION THEREIN CONTAINED, IN WHOLE OR IN PART, OR TO SUFFER SUCH ACTION BY OTHERS, FOR ANY PURPOSE, EXCEPT WITH THE WRITTEN PERMISSION OF JOHNSON CONTROLS, INC. AND FURTHER AGREES TO SURRENDER SAME TO JOHNSON CONTROLS, INC. UPON DEMAND.

COPYRIGHT JOHNSON CONTROLS, INC. 1997

PROJECT		BALTIMORE NFL STADIUM AT CAMDEN YARDS HOME OF THE BALTIMORE RAVENS			
ARCHITECT	HELLMUTH, OBATA, KASSABAUM, P.C. 323 WEST 8TH STREET, SUITE 700 KANSAS CITY, MISSOURI 64105			ENGINEER	ROSS MURPHY FINKELSTEIN, INC. 190 WEST OSTEND STREET BALTIMORE, MARYLAND 21230
USER DEFINED	S.E. - J. D. PRUSAK P.M. - W. J. THOMPSON A.E. - R. T. SCHLOTTERBECK			CONTRACTOR	THE POOLE & KENT COMPANY 4530 HOLLINS FERRY ROAD BALTIMORE, MARYLAND 21227
AS-BUILT			7/18/00	CME	
REFERENCE DRAWING	NO	REVISION/LOCATION	ECN	DATE	BY
SALES ENGINEER		PROJECT MANAGER	APPLICATION ENGINEER	DATE	CONTRACT NUMBER
JDP		WJT	RTS	0915/97	7052-0098
<p>Systems & Services Division</p>					Branch Information Johnson Controls, Inc. 60 Loveton Circle Sparks, Maryland 21152 TEL: 410-584-1160 FAX: 410-472-4928 BL-6559

UPPER CONCOURSE ROOF

QUAD 'A'

QUAD 'B'

BILL OF MATERIALS

Estimate:	networka/b	70520098.pre
Desig.	QtyPart #	Description
Panel Devices:		
NCM-1,2,5	3	EN-EWC22-0 UNIV PKG MOD,F/NCM-300
	3	NU-NCM350-1 NETWORK CTRL, ETHERNET-

UPPER CONCOURSE

UPPER SUITE LEVEL


LOWER SUITE LEVEL

CLUB LEVEL

PRESS LEVEL

MAIN CONCOURSE

SERVICE LEVEL

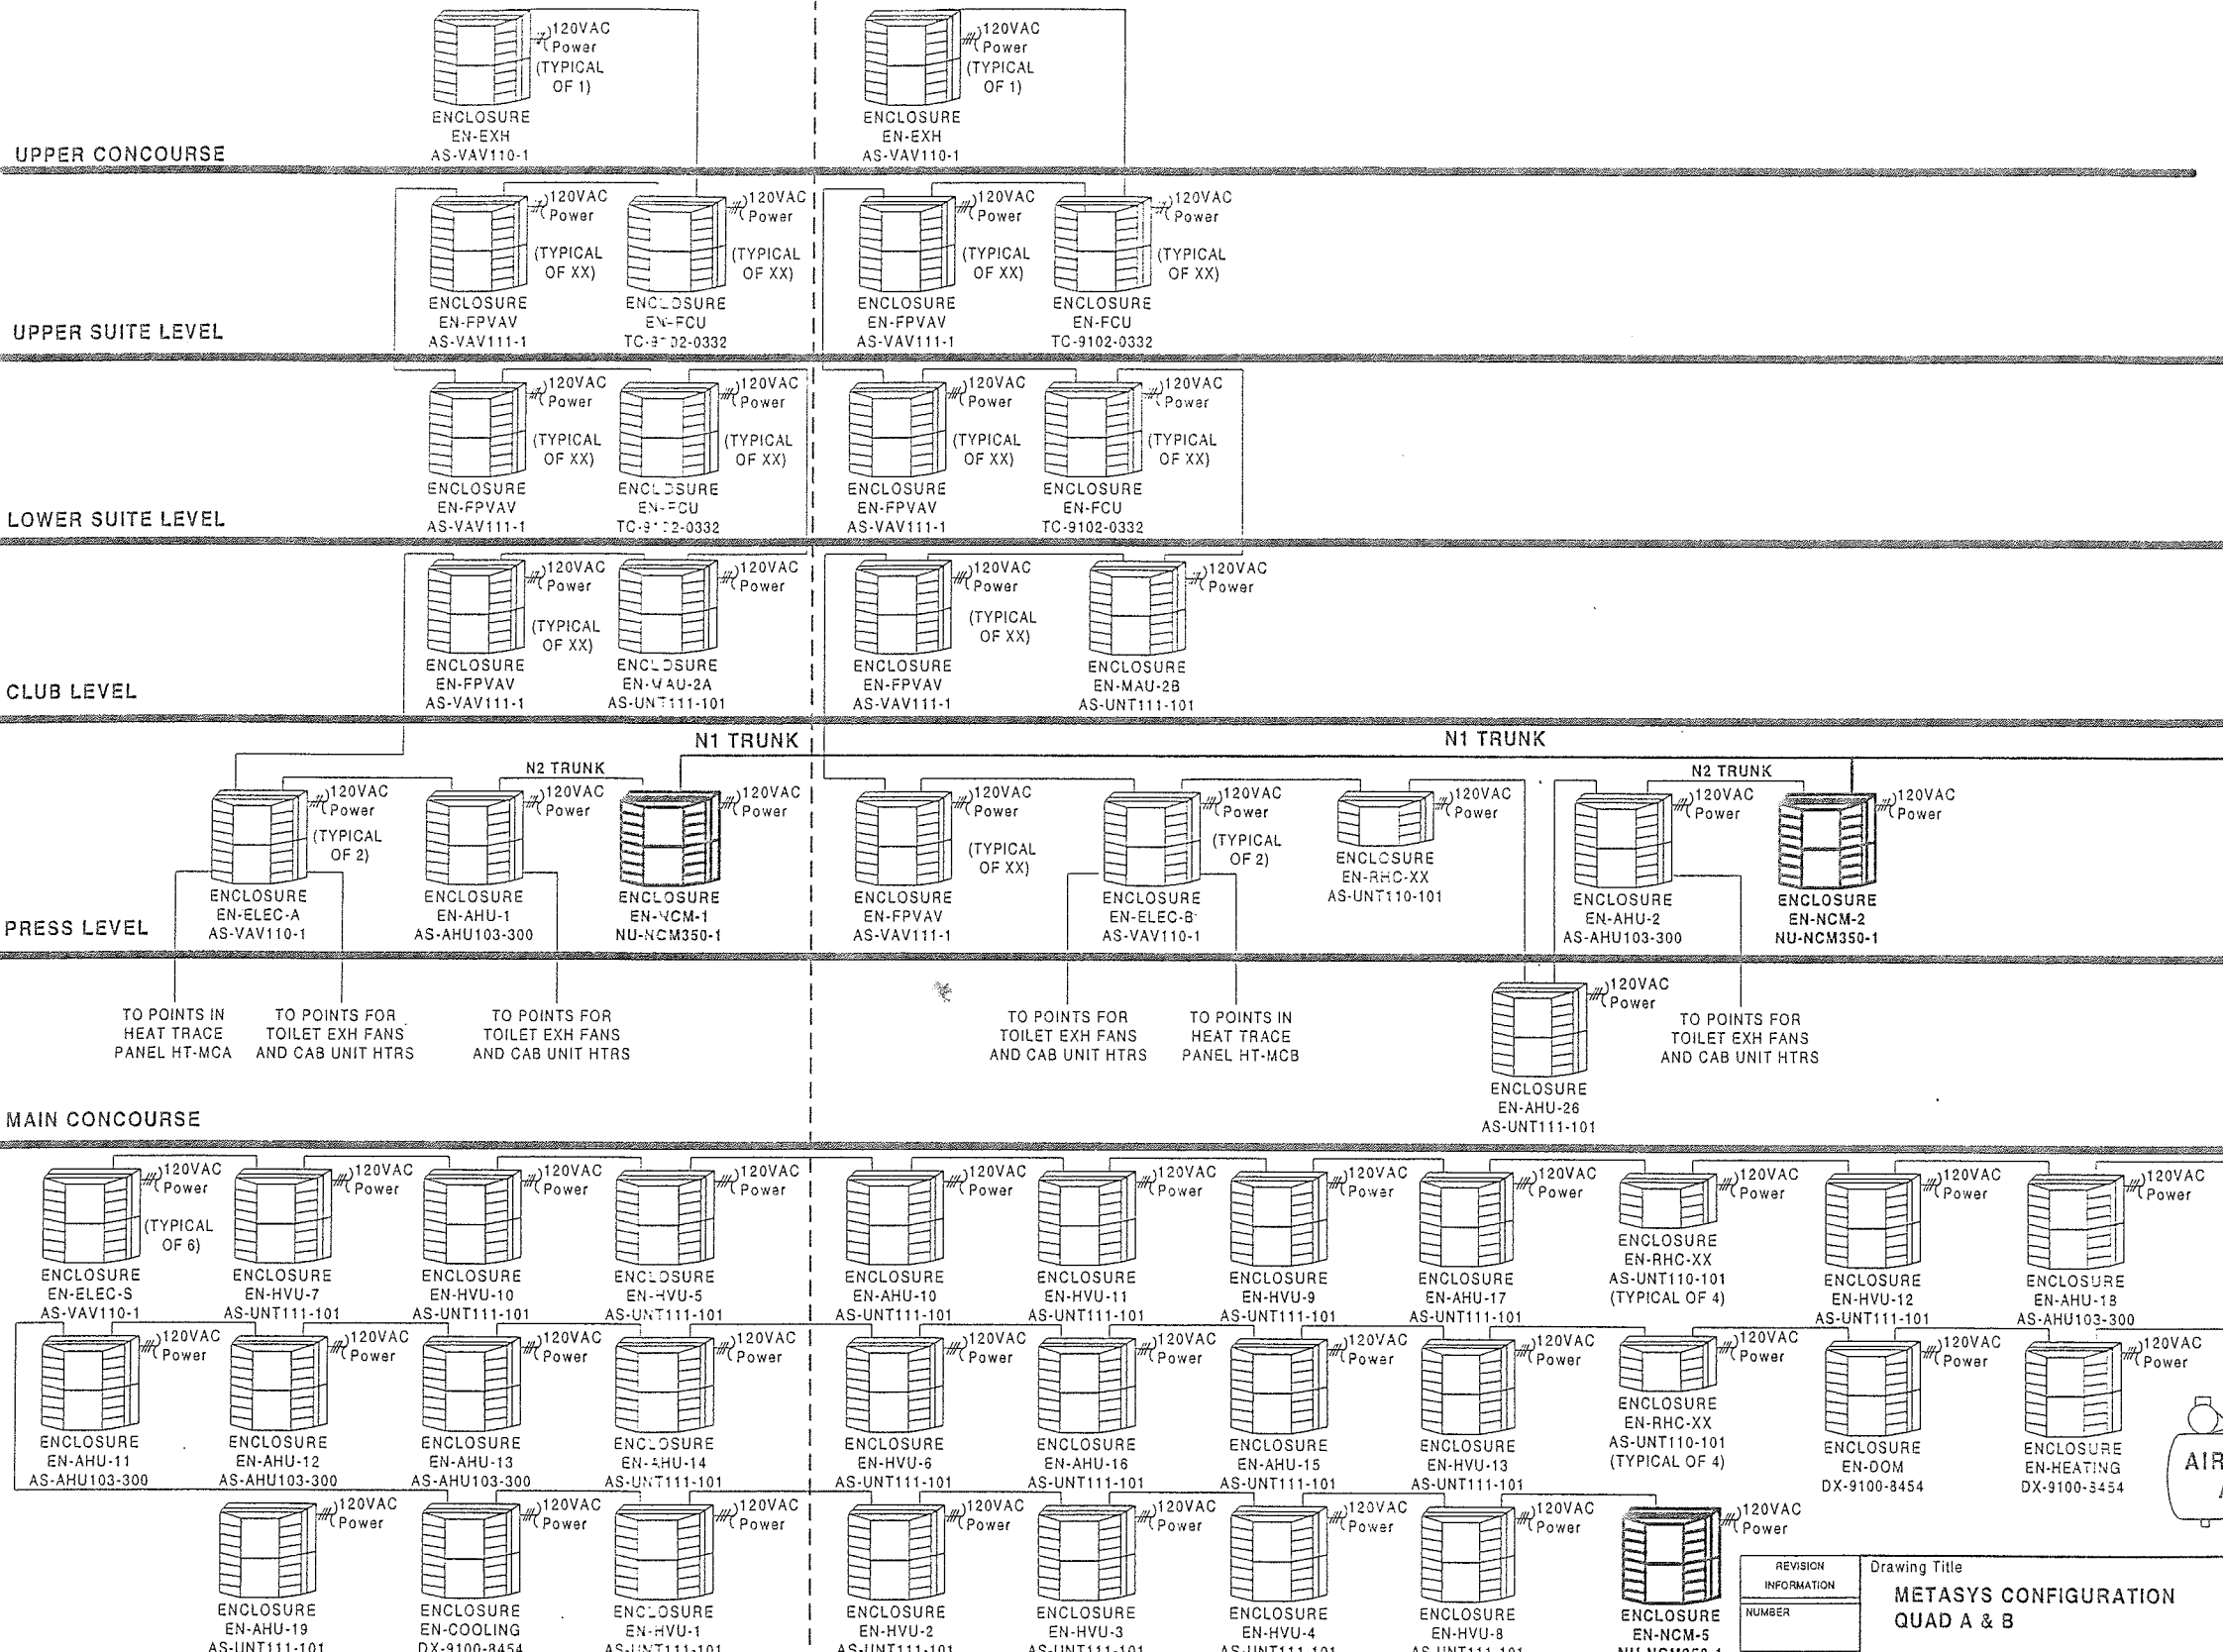

N1 TRUNK TO QUAD C NCM-3

N1 TRUNK CABLE = TO BE IN STRUCTURED WIRING SYSTEM SUPPLIED BY JOB ELECTRICIAN

N2 TRUNK CABLE = 3 CONDUCTOR #18AWG SHIELDED TWISTED WIRE SOLID OR STRANDED BELDON OR EQUAL

FIELD POINT WIRING TO BE 2 OR 3 CONDUCTOR #18AWG SHIELDED TWISTED WIRE SOLID OR STRANDED BELDON OR EQUAL



REVISION INFORMATION	Drawing Title				
NUMBER	METASYS CONFIGURATION QUAD A & B				
DATE	07/18/00				
TIME	11:59 AM				
FILE NAME	NETWORK1.vsd				
Project Title		BALTIMORE NFL STADIUM AT CAMDEN YARDS		BALTIMORE, MARYLAND	
AS-BUILT				7/18/00 CME	
REFERENCE DRAWING	NO.	REVISION-LOCATION	ECN	DATE	BY
Sales Engineer JDP	Project Manager WJT	Application Engineer RTS		DRAWN BY RTS	DATE 7/24/97
Branch information		Johnson Controls, Inc. 60 Loveton Circle Sparks, Md 21152		CONTRACT NUMBER 7052-0098	
Systems & Services Division		DRAWING NUMBER		BL-6559-00A	

UPPER CONCOURSE ROOF

QUAD 'C'

QUAD 'D'

BILL OF MATERIALS 70520098.pre

Estimate:	network/d	70520098.pre
Desig.	QtyPart #	Description
Field Devices:		
PTR-1	1 EPS-C-11280	EPSCN FX-870 9-PIN 3K 342/68CPS
WS-1	1 CPQ-A-15315	Deskpro 2000 5/166MCT.2.1GB./16MB
	1 WS-SWOPMI-0	PMI, NEW
	1 WS-SWOPMI-SCS	PMI, NEW, SUBSCRIPTION
Panel Devices:		
NCM-3,4	2 EN-ENC22-0	UNIV PKG MOD, F, NCM-3,4
	2 NU-NCM350-1	NETWORK CTRL, ETHERNET+

UPPER CONCOURSE

UPPER SUITE LEVEL

LOWER SUITE LEVEL



CLUB LEVEL

N1 TRUNK TO QUAD B NCM-2

PRESS LEVEL

MAIN CONCOURSE

SERVICE LEVEL

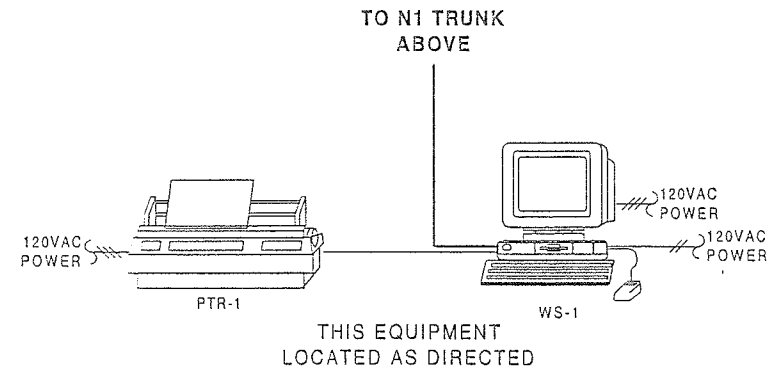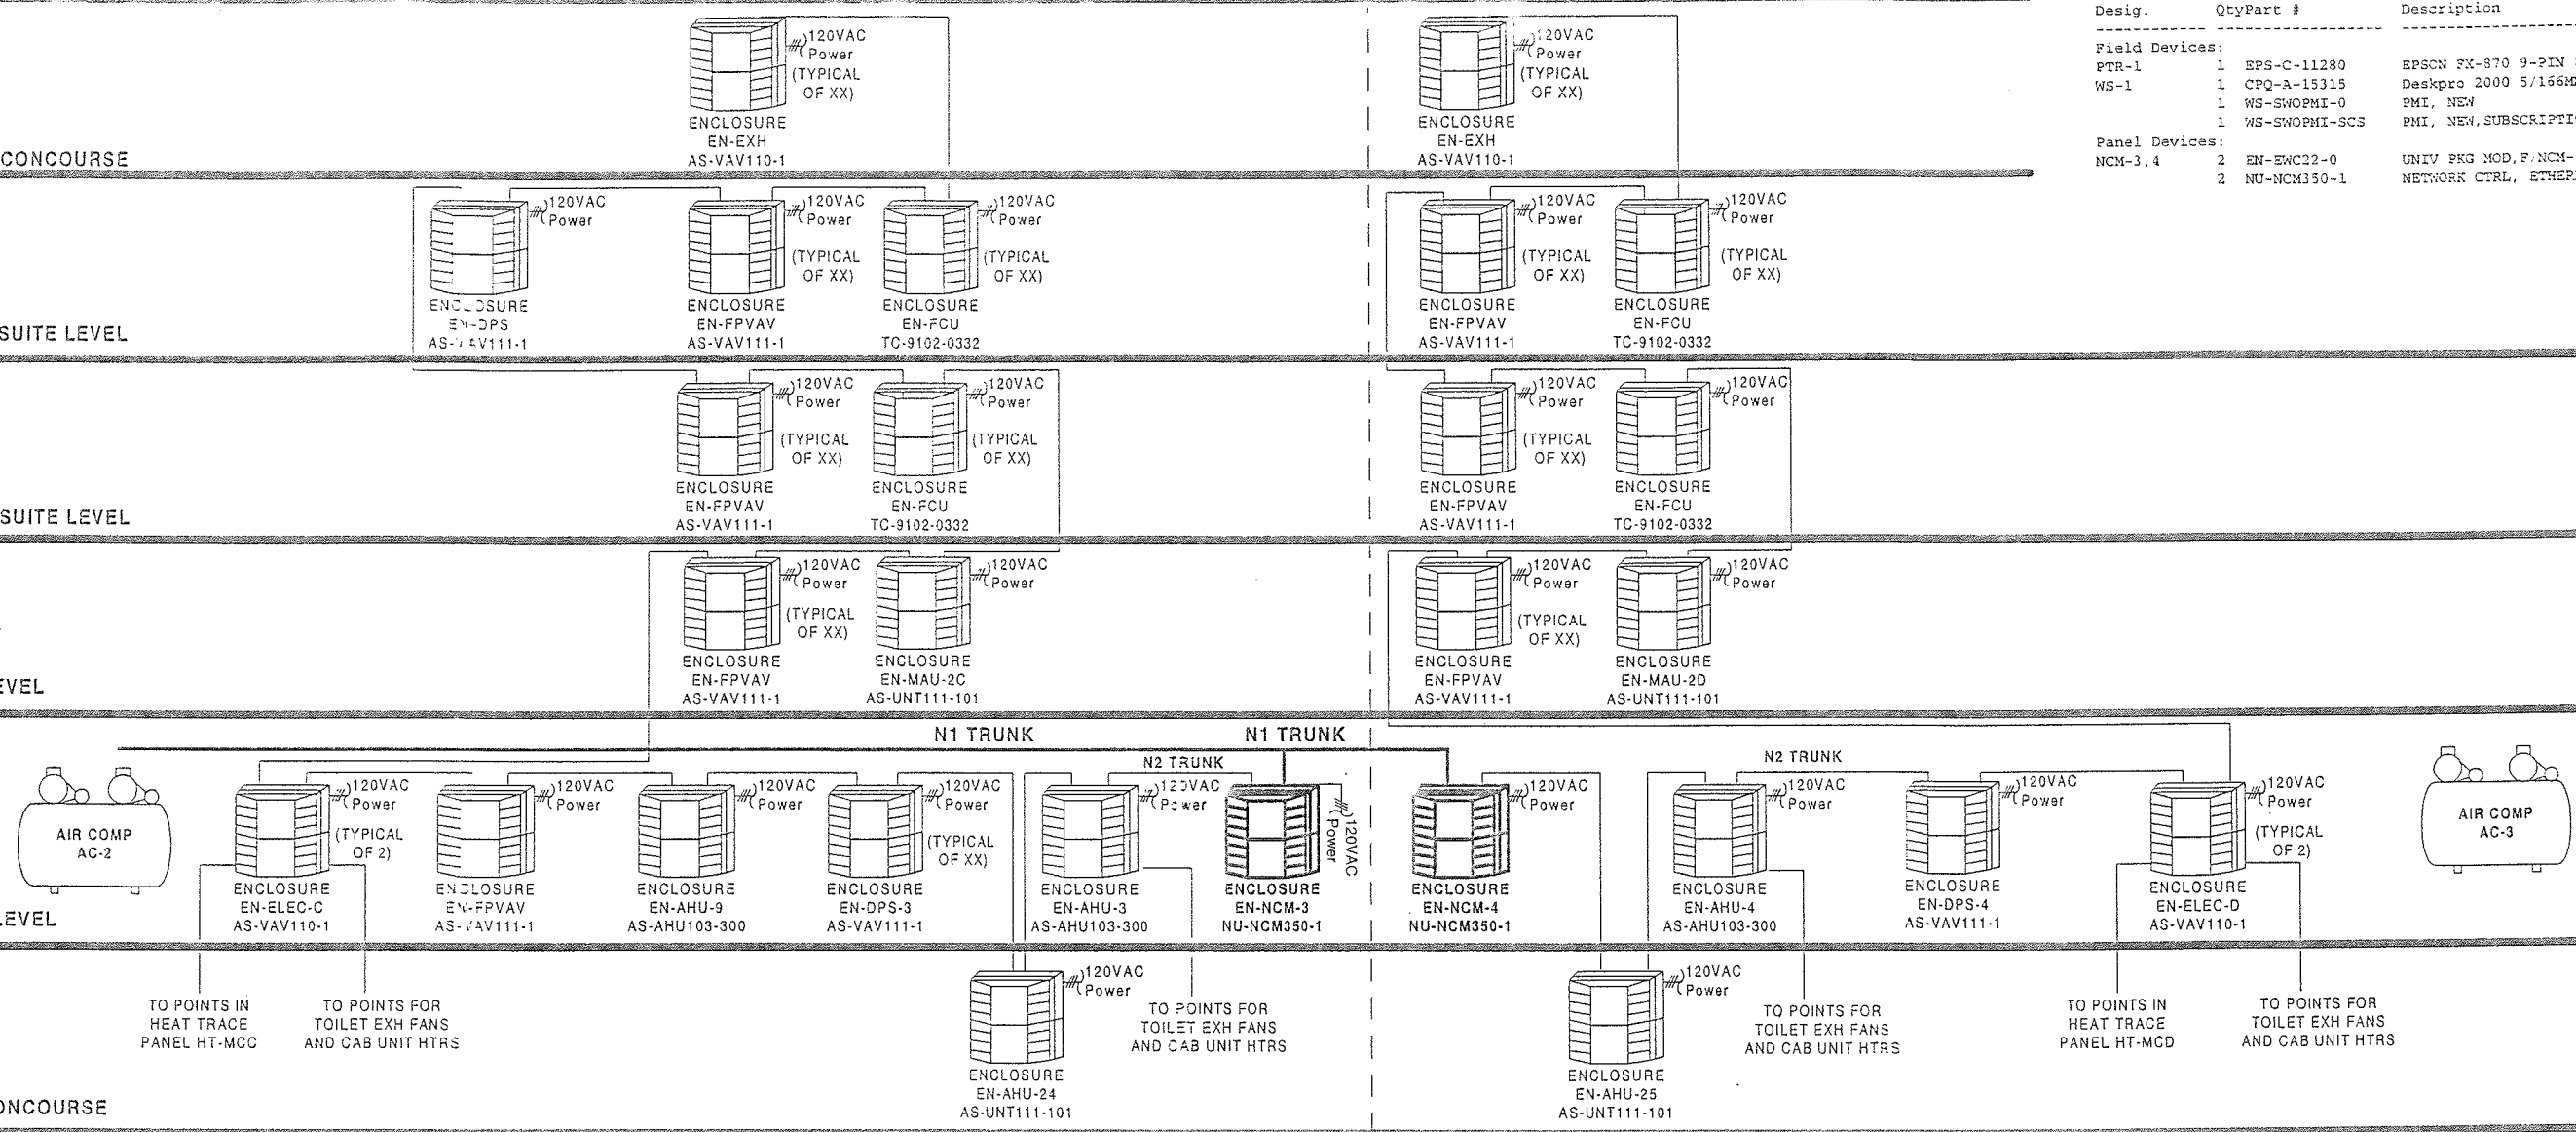


N1 TRUNK CABLE = TO BE IN STRUCTURED WIRING SYSTEM SUPPLIED BY JOB ELECTRICIAN

N2 TRUNK CABLE = 3 CONDUCTOR #18AWG SHIELDED TWISTED WIRE SOLID OR STRANDED BELDON OR EQUAL

FIELD POINT WIRING TO BE 2 OR 3 CONDUCTOR #18AWG SHIELDED TWISTED WIRE SOLID OR STRANDED BELDON OR EQUAL


REVISION INFORMATION	Drawing Title				
NUMBER	METASYS CONFIGURATION QUAD C & D	AS-BUILT		7/18/00	CME
DATE	07/18/00	REFERENCE DRAWING	NO	REVISION-LOCATION	ECN
TIME	12:02 PM	Sales Engineer	Project Manager	Application Engineer	DRAWN
FILE NAME	NETWORK2.vsd	JDP	WJT	RTS	APPROVED
		BY	DATE	BY	DATE
		RTS	7/24/97		
		Branch Information		CONTRACT NUMBER	
		JOHNSON CONTROLS		7052-0098	
		Systems & Services Division		DRAWING NUMBER	
		Baltimore, Maryland		BL-6559-00B	

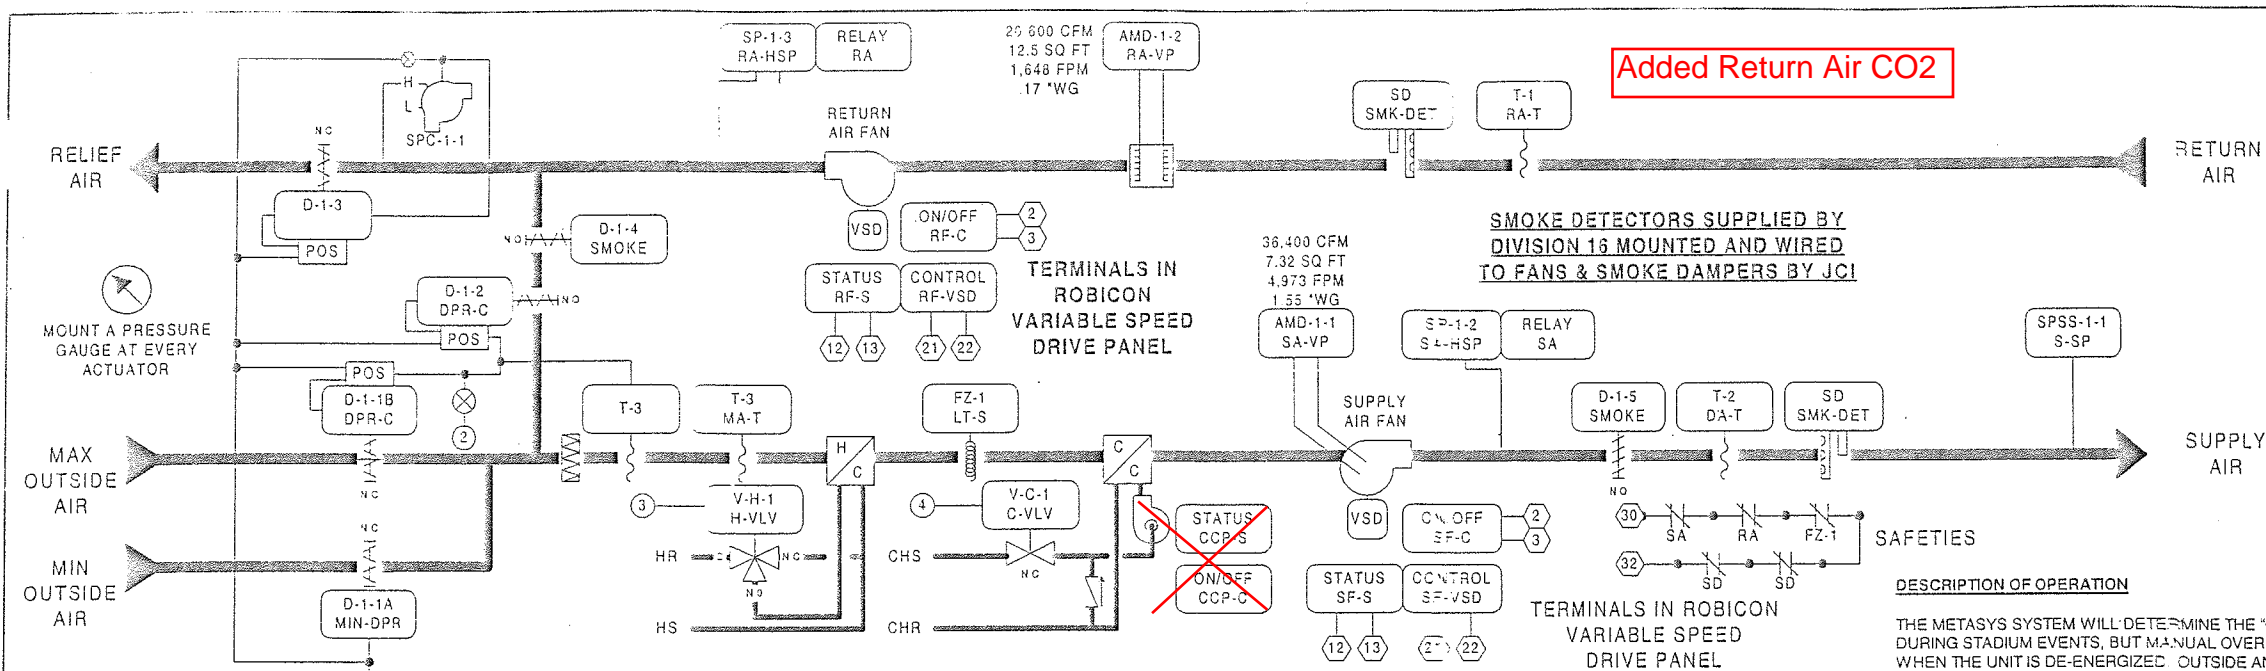


71520098 pre

Estimate	Qty	Part #	Description
AS-BUILT			7/13/00 CME
Field Devices:			SEE DAMPER SCHEDULE
D-1-1A, D-1-1 B	---		
B, D-1-2, D-1-3			
DPR-C	3	D-3153-1	DMPR ACT. 3-15 1/4" PILEDT
DPR-C, MIN-DP	2	D-3153-2	DMPR ACT. 3-15 1/4"
R			
FZ-1	5	G-2010-11	GAGE, 2" 0-30 PSIG, STEM
H-VLV, C-VLV	2	A70HA-1C	STAT. CO. 20" ED. MAN. LE 55P
MA-T, DA-T, RA	3	TE-6315P-1	SEE VALVE SCHEDULE
-T			SENS. T-NI, 0.1% 17" AVG
RA-VP	1	DPT-2641-2	KXOCR DP 0/3.25" 4-10ma
S-SP	1	DPT-2641-7	KXOCR DP 0/10.2" 4-20ma
SA-HSP, RA-HS	2	AFS-460	DUCT AIR FLOW HIGH STATIC
P			
SA-VP	1	DPT-2641-5	KXOCR DP 0/2.5" 4-20ma
SPC-1-1	1	R-317-1	CNTRLR DP, 0.05-1" WG
T-3	1	T-3610-1001	STAT. LOW VOL. 3" AVF, DOT
TEF	3	BZ-1030-11	ENCL. 4-5/8X 5-1/8 ID 3-3/8
	3	PD-101-35	RLY BASE, 3PDT, 11PDT 12VAC
	3	PD-109-51	RELAY PLUG-IN 3PDT 12VAC
Panel Devices:			
EN-AHU-1	1	AS-AHU103-300	AHU TERM BD IN EXCISE
	1	EN-EXP101-0	UNIV PKG MOD. CTR & BACKEN
EP-1, 2, 3	3	EP-3000-4	KXOCR, EP, 4-20ma, HE WEL
EP-4	1	V11HGA-100	3-W SOLENOID, W/OV, 12 VAC
PI-1, 2, 3, 4	4	G-2010-11	GAGE, 2" 0-30 PSIG, STEM
RLY-1, 2	2	AS-RLY002-0	RELAY, 2SPDT, 5 AMP 125VAC
SA, RA	2	PD-101-35	RLY BASE, 3PDT, 11PDT 12VAC
	2	PD-109-51	RELAY PLUG-IN 3PDT 12VAC


RETURN FAN WIRING DIAGRAM

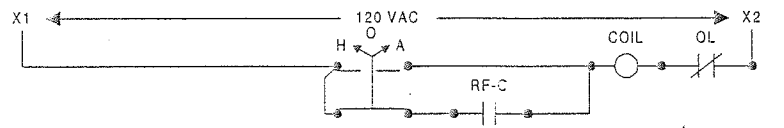

COOLING COIL PUMP DIAGRAM


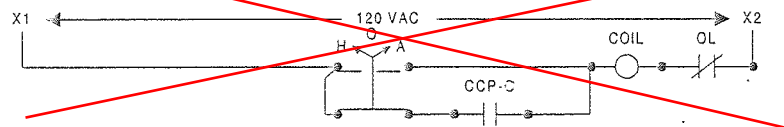


TOILET EXHAUST FAN DIAGRAM

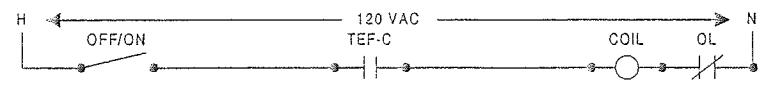

FAN	LOCATION	ELEC PANEL	CIRCUIT	LOCATION
TEF-A10	ROOF	RPUCA	13	UP CONCOURSE
TEF-A11	ROOF	RPUCA	17	UP CONCOURSE
TEF-A12	ROOF	RPUCA	21	UP CONCOURSE
TEF-A15	ROOF	RPUCA	9	UP CONCOURSE
TEF-A16	ROOF	STARTER		ROOF
TEF-A23	CLUB LEVEL	RP2CLA	11	CLUB LEVEL

CONTROLLED FROM MAU PANEL - UPPER CONCOURSE B03
USE (3) PD-109-51 & (3) PD-101-35 AT (3) PANEL/STARTER LOCATIONS

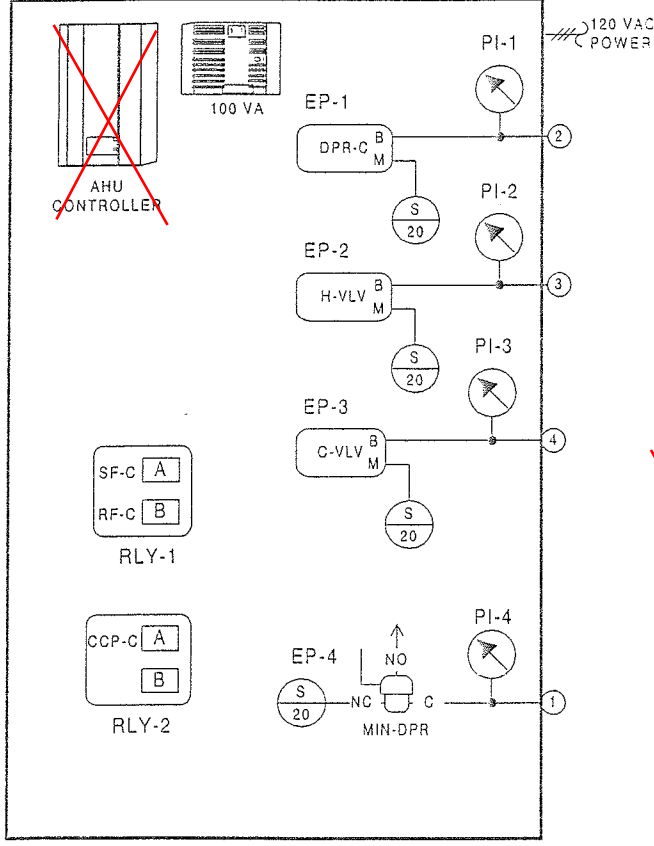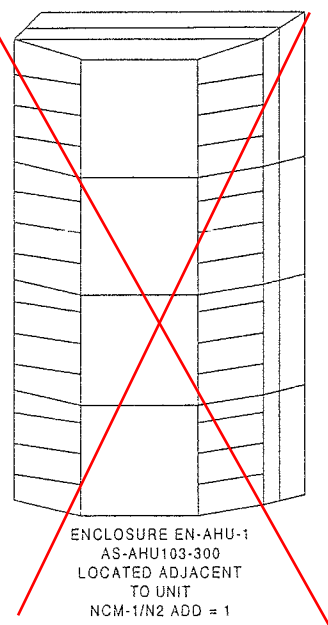

SEE BL-6559-01A FOR MORE WIRING DETAILS

DESCRIPTION OF OPERATION

THE METASYS SYSTEM WILL DETERMINE THE "OCCUPIED AND UNOCCUPIED" MODES OF OPERATION. OCCUPIED MODES GENERALLY OCCUR DURING STADIUM EVENTS, BUT MANUAL OVERRIDE THROUGH THE METASYS SYSTEM ON SELECTED UNITS WILL FREQUENTLY BE REQUIRED. WHEN THE UNIT IS DE-ENERGIZED OUTSIDE AND RELIEF AIR DAMPERS D-1-1A, D-1-1B, D-1-3 AND COOLING COIL VALVE V-C-1 WILL CLOSE; COOLING COIL PUMP WILL BE OFF; RETURN AIR DAMPER D-1-2 WILL BE OPEN AND HEATING COIL VALVE V-H-1 WILL BE CLOSED TO THE COIL. SMOKE DAMPERS D-1-4, D-1-5 WILL REMAIN OPEN UNDER CONTROL OF SMOKE DETECTION SYSTEM.

WARM-UP MODE - SUPPLY AND RETURN FANS WILL START AS DETERMINED BY THE OPTIMAL START PROGRAM OF THE METASYS SYSTEM. ON THE START OF THE UNIT, HEATING COIL VALVE V-H-1 WILL OPEN FULL TO COIL AND RETURN AIR DAMPER D-1-2 WILL BE FULLY OPEN WITH THE OUTSIDE AIR DAMPERS D-1-1A, D-1-1B AND RELIEF AIR DAMPER D-1-3 CLOSED. DURATION OF THE WARM-UP MODE IS DETERMINED BY THE METASYS SYSTEM AND WILL BE DYNAMICALLY UPDATED TO END FIFTEEN (15) MINUTES PRIOR TO OCCUPANCY TIME. WARM-UP MODE IS STOPPED WHEN RETURN AIR TEMPERATURE REACHES THE SETTING OF T-1 (70F).

OCCUPIED HEATING MODE - SUPPLY AND RETURN FANS WILL BE RUNNING, RETURN AIR DAMPER D-1-2 IS OPEN. MINIMUM OUTSIDE AIR DAMPER D-1-1A WILL OPEN AFTER THE WARM-UP MODE IS STOPPED. DISCHARGE SENSOR T-2, THROUGH THE METASYS SYSTEM CONTROL UNIT, WILL ON A RISE IN TEMPERATURE ABOVE ITS SETTING OF FORTY-FIVE (45F) MODULATE V-H-1 CLOSED TO THE HEATING COIL. ON A FURTHER RISE, T-2 WILL GRADUALLY MODULATE DAMPERS D-1-1B, OPEN WHILE SIMULTANEOUSLY CLOSING D-1-2. STATIC PRESSURE CONTROLLER SPC-1-1, LOCATED IN THE ENTERING SIDE OF THE RELIEF DAMPER WILL OVERRIDE THE CONTROL AND MODULATE D-1-3 TO MAINTAIN ITS SETTING TO ENSURE A POSITIVE BUILDING PRESSURE. LOW LIMIT THERMOSTAT T-3, SENSITIVE TO THE COLDEST SPOT IN THE AIR STREAM, WILL OVERRIDE T-2 TO PREVENT MIXED AIR FROM FALLING BELOW ITS SETTING OF FORTY (40F). ON A FALL IN TEMPERATURE, THE REVERSE WILL OCCUR. COOLING COIL VALVE V-C-1 WILL BE CLOSED TO THE COIL AND COIL CIRCULATION PUMP WILL BE OFF DURING THE HEATING MODE.

UNOCCUPIED HEATING MODE - IN THE UNOCCUPIED MODE ALL AIR HANDLING UNIT DAMPERS AND CONTROLS WILL RETURN TO THEIR NORMAL POSITION READY FOR RESTARTING.

OCCUPIED COOLING MODE - SUPPLY AND RETURN FANS AND COOLING COIL CIRCULATING PUMP START AND RUN CONTINUOUSLY. OUTSIDE AIR DAMPER D-1-1A WILL OPEN. OUTSIDE DAMPER D-1-1B AND RETURN DAMPER D-1-2 WILL, THROUGH THE METASYS SYSTEM CONTROL UNIT, BE UNDER FLOATING DRY BULB DIFFERENTIAL CONTROL WHICH WILL COMPARE THE TEMPERATURE OF THE RETURN AND OUTSIDE AIR STREAMS. THE OUTSIDE AIR WILL BE UTILIZED WHENEVER IT IS GREATER THAN SEVEN (7F) LESS THAN THE RETURN AIR TEMPERATURE. WHEN THE DIFFERENTIAL FALLS BELOW SEVEN (7F), MAXIMUM OUTSIDE AIR DAMPERS D-1-1B WILL CLOSE, OPENING RETURN AIR DAMPER D-1-2. DISCHARGE SENSOR T-2, THROUGH THE METASYS SYSTEM CONTROL UNIT, WILL IN SEQUENCE MODULATE OUTSIDE AND RETURN DAMPERS D-1-1B AND D-1-2 AND CHILLED WATER VALVE V-C-1 TO MAINTAIN ITS SETTING OF FORTY-FIVE (45F). HEATING COIL VALVE V-H-1 WILL REMAIN CLOSED TO THE COIL.

UNOCCUPIED COOLING MODE - SYSTEM IS DE-ENERGIZED AND THE FANS ARE OFF.

SMOKE CONTROL - SMOKE DETECTORS WILL, ON THE DETECTION OF PRODUCTS OF COMBUSTION, SHUT DOWN THE SUPPLY AND RETURN FANS AND CLOSE ALL SYSTEM DAMPERS.


FAN CONTROL - SYSTEM STATIC PRESSURE SENSING STATION SPSS-1-1 THROUGH A STATIC PRESSURE TRANSMITTER AND THE METASYS CONTROLLER WILL MODULATE THE SUPPLY FAN VARIABLE FREQUENCY DRIVE TO MAINTAIN ITS SETTING. ON A RISE IN STATIC AS SENSED BY SPSS-1-1 THE SUPPLY FAN DRIVE WILL GRADUALLY MODULATE FAN SPEED TO ITS MINIMUM POSITION TO MAINTAIN ITS SETTING. HIGH LIMIT STATIC PRESSURE CONTROLLER SPC-1-2, WHICH WILL OVERRIDE SPSS-1-1 TO PREVENT THE DISCHARGE FROM RISING ABOVE ITS SET POINT. SUPPLY DUCT AIR MONITORING STATION AMD-1-1 AND RETURN DUCT AIR MONITORING STATION AMD-1-2 THROUGH VELOCITY PRESSURE TRANSMITTERS WILL SEND SIGNALS TO THE METASYS CONTROLLER WHICH WILL COMPARE TOTAL SUPPLY AND RETURN AIR QUANTITIES AND MODULATE THE RETURN VARIABLE SPEED DRIVE BASED ON SETPOINT TO SYNCHRONIZE RETURN FAN VOLUME WITH THE SUPPLY FAN VOLUME SO AS TO MAINTAIN CONSTANT MINIMUM BALANCED OUTSIDE AIR FLOW. DIFFERENTIAL WILL BE REDUCED TO ZERO (0) (NO OUTSIDE AIR) DURING WARM-UP AND UNOCCUPIED MODES OF OPERATION. MANUALLY RESET HIGH LIMIT STATIC PRESSURE CONTROLLERS SPC-1-2 AND SPC-1-3 WILL STOP THEIR RESPECTIVE SUPPLY AND RETURN FANS WHENEVER THEIR SETTING IS REACHED. ALL FANS WILL BE REQUIRED TO BE MANUALLY RESTARTED IF DE-ENERGIZED BY STATIC PRESSURE CONTROLS. SUPPLY FANS WILL BE MANUALLY CONTROLLED USING A BY-PASS STARTER IF THEIR RESPECTIVE VARIABLE FREQUENCY FAN DRIVE FAILS.

TOILET EXHAUST FANS TEF-A10, A11, A12, A15, A16, A23 - THE FAN STARTS WHEN THE AHU SUPPLY FAN IS STARTED AND THE SYSTEM IS IN THE "OCCUPIED" MODE.

REVISION INFORMATION	IN CONSIDERATION OF THE RECEIPT OF THIS DOCUMENT, THE RECIPIENT AGREES NOT TO REPRODUCE, COPY, USE OR TRANSMIT THIS DOCUMENT AND/OR THE INFORMATION THEREIN CONTAINED, IN WHOLE OR IN PART, OR TO SUFFER SUCH ACTION BY OTHERS, FOR ANY PURPOSE, EXCEPT WITH THE WRITTEN PERMISSION OF JOHNSON CONTROLS, INC. AND FURTHER AGREES TO SURRENDER SAME TO JOHNSON CONTROLS, INC. UPON DEMAND.	DRAWING TITLE	AIR HANDLING UNIT AHU-1 CLUB/SUITES QUAD A
NUMBER		PROJECT TITLE	BALTIMORE NFL STADIUM AT CAMDEN YARDS
DATE	07/18/00	FILE NAME	AHU-1.vsd
TIME	02:17 PM	SALES ENGINEER	JDP
		PROJECT MANAGER	WJT
		APPLICATION ENGINEER	RTS
		DATE	08/25/97
		BY	RTS
		DATE	08/25/97
		CONTRACT NUMBER	7052-0098
		BRANCH INFORMATION	JOHNSON CONTROLS 60 LOVETON CIRCLE SPARKS, MD 21152
		WIRING NUMBER	BL-6559-01
		DATE	7/13/00
		BY	CME


JOHNSON CONTROLS
Systems & Services Division

TYPICAL FOR ALL AHU'S, HVU'S, AND MAU'S

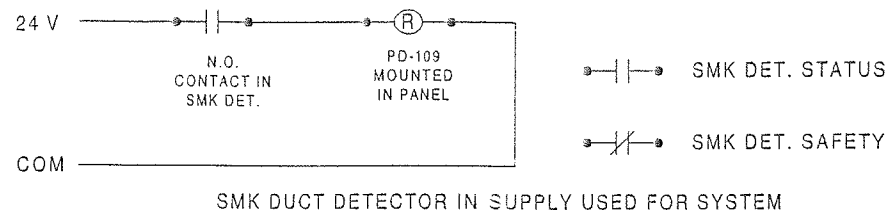


STATUS

TYPICAL FOR AHU-1,2,3,4

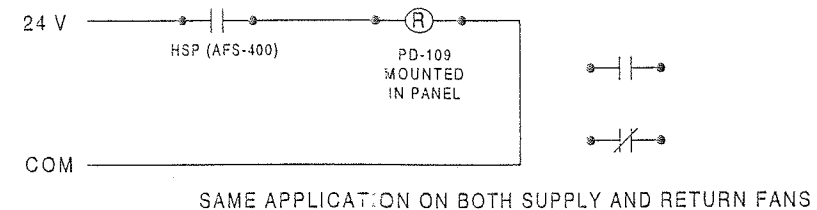

TYPICAL FOR AHU-1,2,3,4


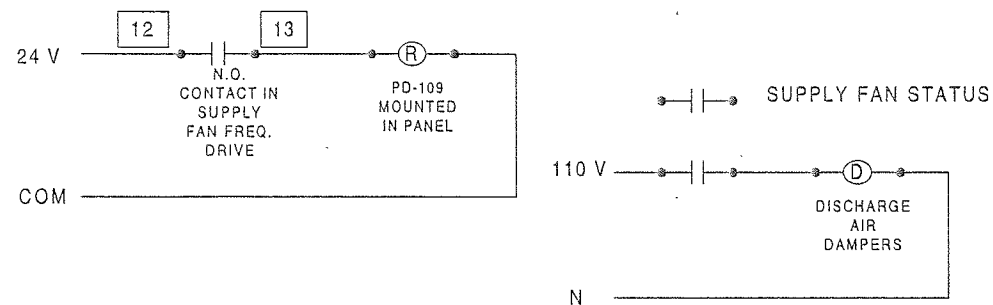


REVISION INFORMATION	Drawing Title								
NUMBER	WIRING DETAILS	AS-BUILT						7/18/00	CME
DATE		REFERENCE DRAWING	NO.	REVISION-LOCATION	ECN	DATE	BY		
07/18/00		Sales Engineer	JDP	Project Manager	WJT	Application Engineer	RTS	DRAWN	APPROVED
TIME	Project Title	Branch Information	CONTRACT NUMBER		DRAWING NUMBER				
02:07 PM	BALTIMORE NFL STADIUM AT CAMDEN YARDS	Johnson Controls, Inc. 60 Loveton Circle Sparks, Md 21152	7052-0098		BL-6559-01A				
FILE NAME	BALTIMORE, MARYLAND	JOHNSON CONTROLS Systems & Services Division							
Miscahu.vsd									

BILL OF MATERIALS

Estimate: quad a vavbox 70520098.pre


Desig.	Qty	Part #	Description
Field Devices:			
DC-1	46	AS-VAV110-1	VAV 6AI, 4BI, 8BO, 8K
V-RH-1	46	--	SEE VALVE SCHEDULE
VAV	46	ATP-2040-212	ACT, 2MIN+1.5" DP, 1/2" CPLG
ZN-T	30	TE-6410W-1000	MSTAT, NI, BCX, JACK

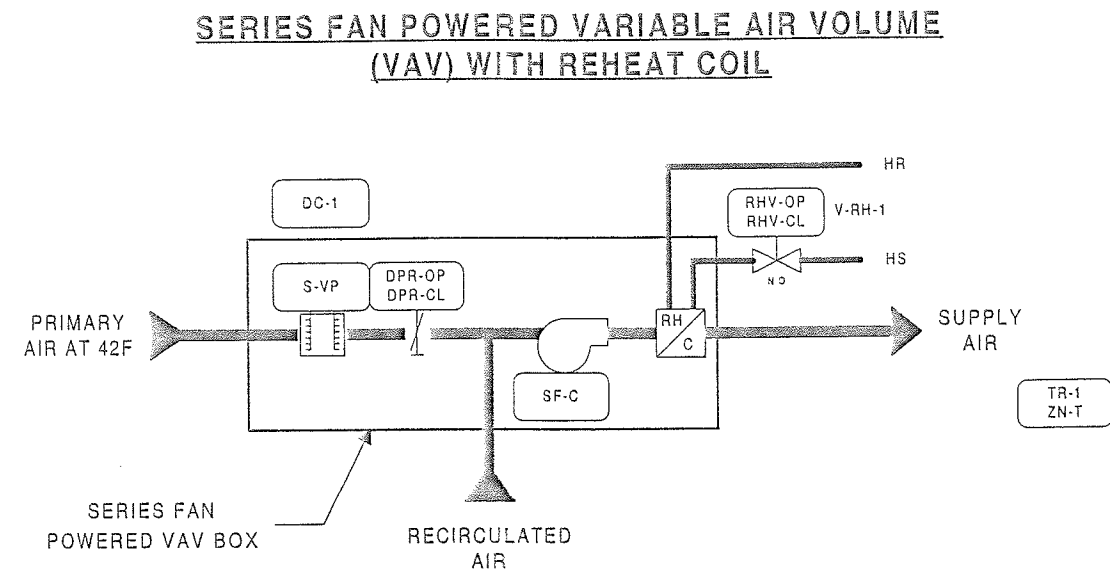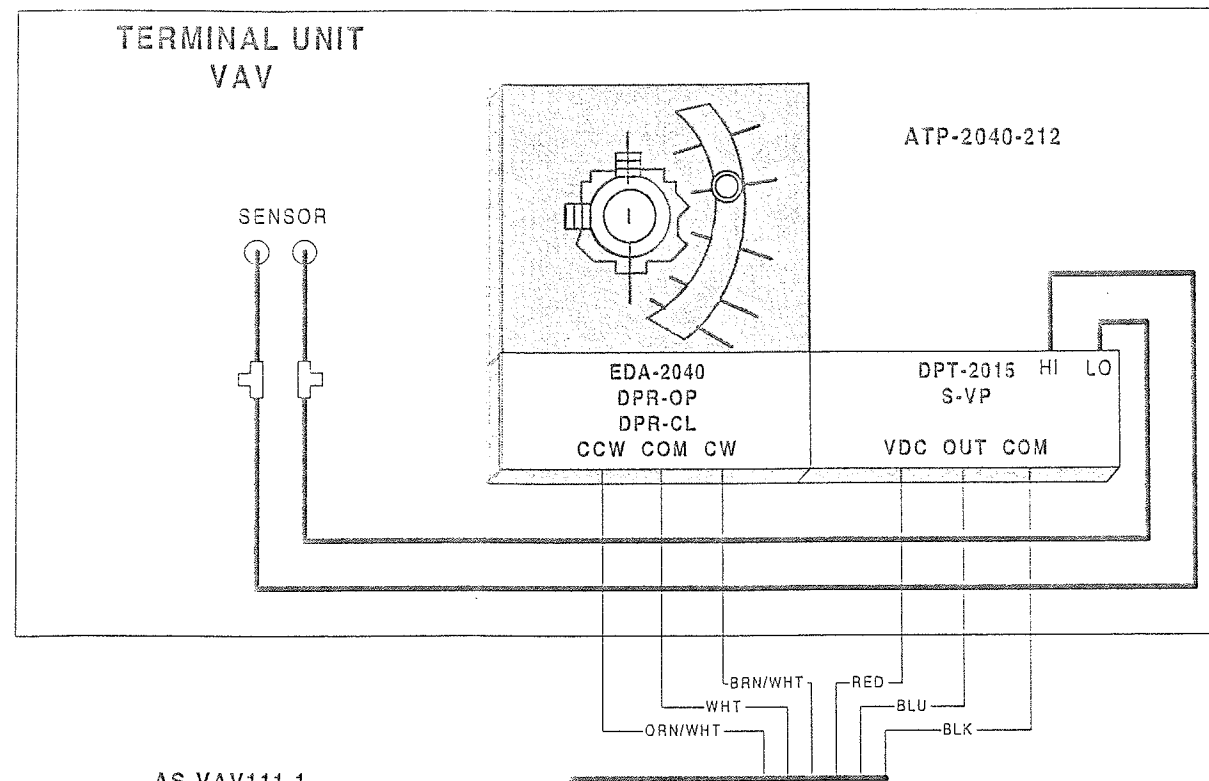

NOTE: VAV CONTROLLER (AS-VAV111-1) DAMPER ACTUATOR & DIFFERENTIAL PRESSURE TRANSMITTER (ATP-2040-212) ARE FACTORY MOUNTED BY TITUS

DESCRIPTION OF OPERATION

PRIMARY AIR VALVE WILL OPEN TO THEIR MINIMUM POSITION AND TERMINAL UNIT FAN WILL START AND RUN CONTINUOUSLY WHENEVER AIR HANDLING UNIT IS RUNNING. TERMINAL UNIT FANS WILL START THIRTY (30) SECONDS BEFORE OPENING OF AIR VALVES TO PREVENT BACK SPINNING OF FAN. FANS WILL ALSO BE OPERATED AS DEFINED IN THE UNOCCUPIED MODES. PRIMARY AIR VALVES WILL BE CLOSED DURING UNOCCUPIED HEATING MODE. ROOM SENSOR TR-1 WILL ON A RISE IN TEMPERATURE GRADUALLY MODULATE REHEAT COIL VALVE V-RH-1 CLOSED AND ON A CONTINUED RISE WILL GRADUALLY MODULATE PRIMARY AIR VALVE FROM IT'S MINIMUM TO MAXIMUM SETTING TO MAINTAIN IT'S SETTING OF SEVENTY-FIVE (75F). ON A FALL IN TEMPERATURE, THIS CYCLE IS REVERSED. DURING OPERATION OF THE WARM-UP MODE ALL PRIMARY AIR VALVES OPEN TO THEIR MAXIMUM POSITION AND TERMINAL FANS START TO PERMIT FULL AIR FLOW TO THE SPACES. REHEAT COIL VALVE V-RH-1 IS MODULATED IN RESPONSE TO ROOM SENSOR TO MAINTAIN SPACE TEMPERATURE.

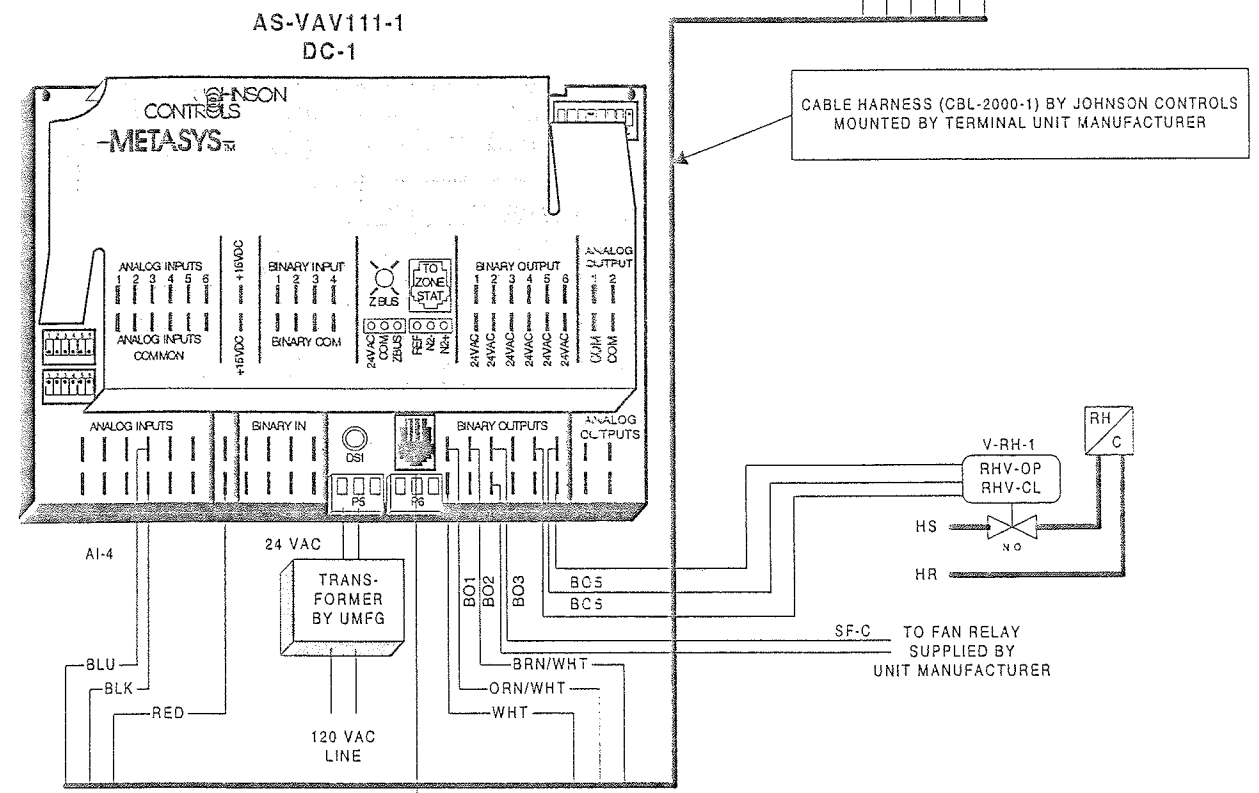

NOTE: BO-1 = DAMPER OPEN (CCW)
BO-2 = DAMPER CLOSED (CW)
IF DAMPER ROTATION REVERSED, MAKE CORRESPONDING WIRING CHANGE


CABLE HARNESS
8C#24 WIRE
WITH RJ45 JACKS

TR-1
ZN-T

<table border="1"> <tr><th>REVISION INFORMATION</th></tr> <tr><td>NUMBER</td></tr> <tr><td>DATE: 07/18/00</td></tr> <tr><td>TIME: 02:18 PM</td></tr> <tr><td>FILE NAME: VAVBOX-A.vsd</td></tr> </table>	REVISION INFORMATION	NUMBER	DATE: 07/18/00	TIME: 02:18 PM	FILE NAME: VAVBOX-A.vsd	<p>IN CONSIDERATION OF THE RECEIPT OF THIS DOCUMENT, THE RECIPIENT AGREES NOT TO REPRODUCE, COPY, USE OR TRANSMIT THIS DOCUMENT AND/OR THE INFORMATION THEREIN CONTAINED, IN WHOLE OR IN PART, OR TO SUFFER SUCH ACTION BY OTHERS, FOR ANY PURPOSE, EXCEPT WITH THE WRITTEN PERMISSION OF JOHNSON CONTROLS, INC. AND FURTHER AGREES TO SURRENDER SAME TO JOHNSON CONTROLS, INC. UPON DEMAND.</p> <p>COPYRIGHT JOHNSON CONTROLS, INC. 1998</p>	<p>DRAWING TITLE FAN POWERED TERMINAL REHEAT UNITS</p> <p>QUAD A</p> <p>PROJECT TITLE BALTIMORE NFL STADIUM AT CAMDEN YARDS</p> <p>BALTIMORE, MARYLAND</p>	<table border="1"> <tr> <td>AS-BUILT</td> <td>7/18/00</td> <td>CME</td> </tr> <tr> <td>REFERENCE DRAWING</td> <td>NO</td> <td>REVISION-LOCATION</td> </tr> <tr> <td>Sales Engineer: JDP</td> <td>Project Manager: WJT</td> <td>Application Engineer: RTS</td> </tr> <tr> <td>BY: RTS</td> <td>DATE: 08/25/97</td> <td>BY: DATE</td> </tr> <tr> <td colspan="2"> </td> <td> <p>7052-0098</p> <p>BL-6559-02</p> </td> </tr> </table>	AS-BUILT	7/18/00	CME	REFERENCE DRAWING	NO	REVISION-LOCATION	Sales Engineer: JDP	Project Manager: WJT	Application Engineer: RTS	BY: RTS	DATE: 08/25/97	BY: DATE			<p>7052-0098</p> <p>BL-6559-02</p>
REVISION INFORMATION																							
NUMBER																							
DATE: 07/18/00																							
TIME: 02:18 PM																							
FILE NAME: VAVBOX-A.vsd																							
AS-BUILT	7/18/00	CME																					
REFERENCE DRAWING	NO	REVISION-LOCATION																					
Sales Engineer: JDP	Project Manager: WJT	Application Engineer: RTS																					
BY: RTS	DATE: 08/25/97	BY: DATE																					
		<p>7052-0098</p> <p>BL-6559-02</p>																					

BILL OF MATERIALS 7CE20098.pre


Estimate:	quad a fcu		
Desig.	Qty	Part #	Description
Field Devices:			
DC-1	27	TC-9102-0332	FAN CONT3-SPEED 2-STS H/C
V-H-FC	54	--	SEE VALVE SCHEDULE
V-C-FC			
ZN-T	27	TM-9161-5002	MSTAT F/TC-9100 55-55F FSC

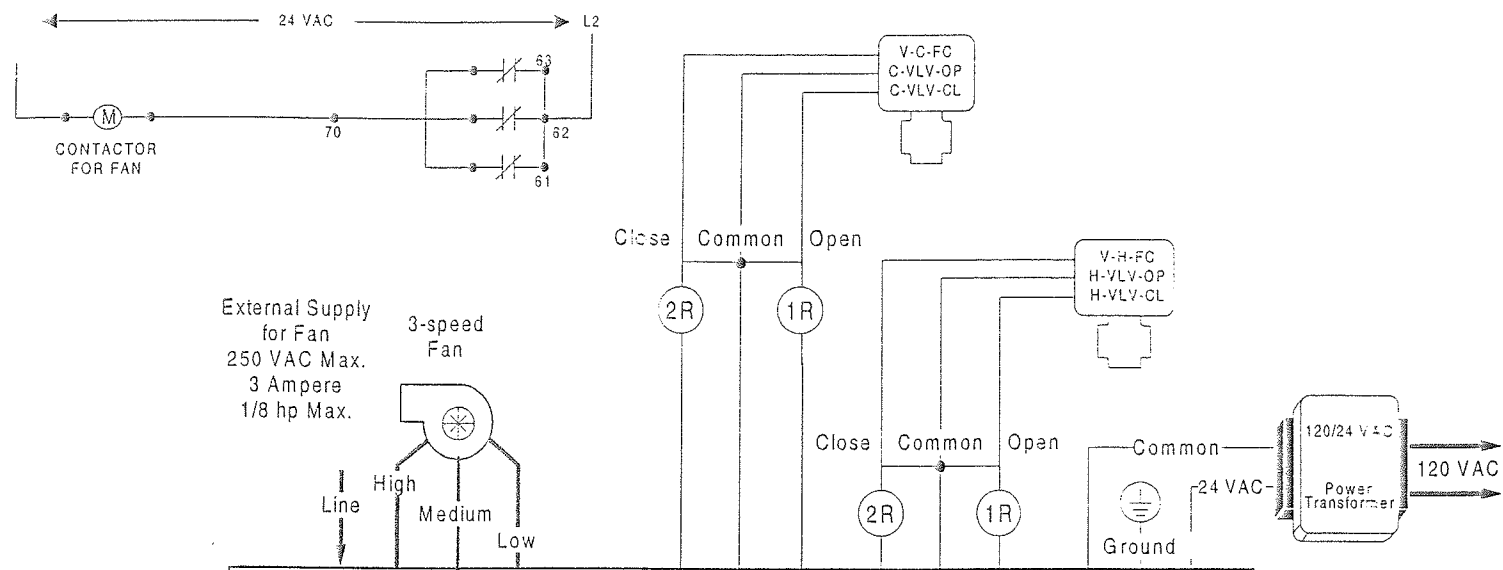

External Supply for Fan
250 VAC Max.
3 Ampere
1/8 hp Max.

**TRANSFORMER
SUPPLIED BY
UNIT MANUFACTURER**

VALVE WIRING
EXTEND -- CLOSE
RETRACT -- OPEN

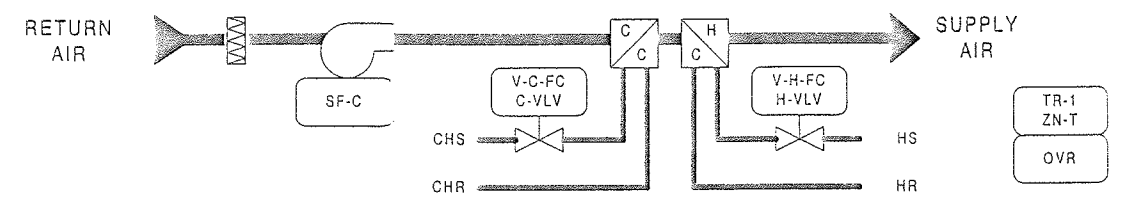


**NOTE: FCU CONTROLLER (TC-9102-0322)
ARE FACTORY MOUNTED BY TRANE**

DESCRIPTION OF OPERATION

THE METASYS SYSTEM WILL DETERMINE THE "OCCUPIED AND UNOCCUPIED" MODES OF OPERATION. OCCUPIED MODE GENERALLY OCCURS DURING THE NORMAL WORK WEEK AND STADIUM EVENTS, BUT MANUAL OVERRIDE THROUGH THE METASYS SYSTEM ON INDIVIDUAL UNITS WILL FREQUENTLY BE REQUIRED. SUITE OWNERS WILL HAVE THE ABILITY TO UTILIZE SUITES FOR PRIVATE FUNCTIONS AT ANYTIME. WHEN FAN COIL UNITS ARE DE-ENERGIZED, COOLING COIL VALVE V-C-FC AND HEATING COIL VALVE V-H-FC WILL BE CLOSED TO COILS.

OCCUPIED MODE - FAN COIL UNIT SUPPLY FAN WILL BE STARTED THROUGH ITS FAN SPEED SWITCH AND RUN CONTINUOUSLY. STARTING OF THE FAN COIL UNIT WILL INITIATE THE START OF THE RELATED EXHAUST FAN. THE EXHAUST AIR VOLUME INDUCES THE NATURAL VENTILATION OF THE SUITE AND MUST THEREFORE BE ENERGIZED WHENEVER THE SUITE IS OCCUPIED. ROOM SENSOR TR-1 WILL MODULATE HEATING COIL VALVE V-H-FC AND COOLING COIL VALVE V-C-FC IN SEQUENCE TO MAINTAIN ITS SETTING OF SEVENTY-FIVE (75F).

UNOCCUPIED MODE - ROOM SENSOR TR-1 WILL ON A FALL IN TEMPERATURE TO ITS SETTING OF FIFTY (50F) ACTIVATE SYSTEM TO RUN IN THE OCCUPIED MODE AS HEREINBEFORE DESCRIBED. ON A RISE IN TEMPERATURE TO FIFTY-FIVE (55F), FAN COIL UNIT WILL BE DE-ENERGIZED AND HEATING COIL VALVE WILL CLOSE.

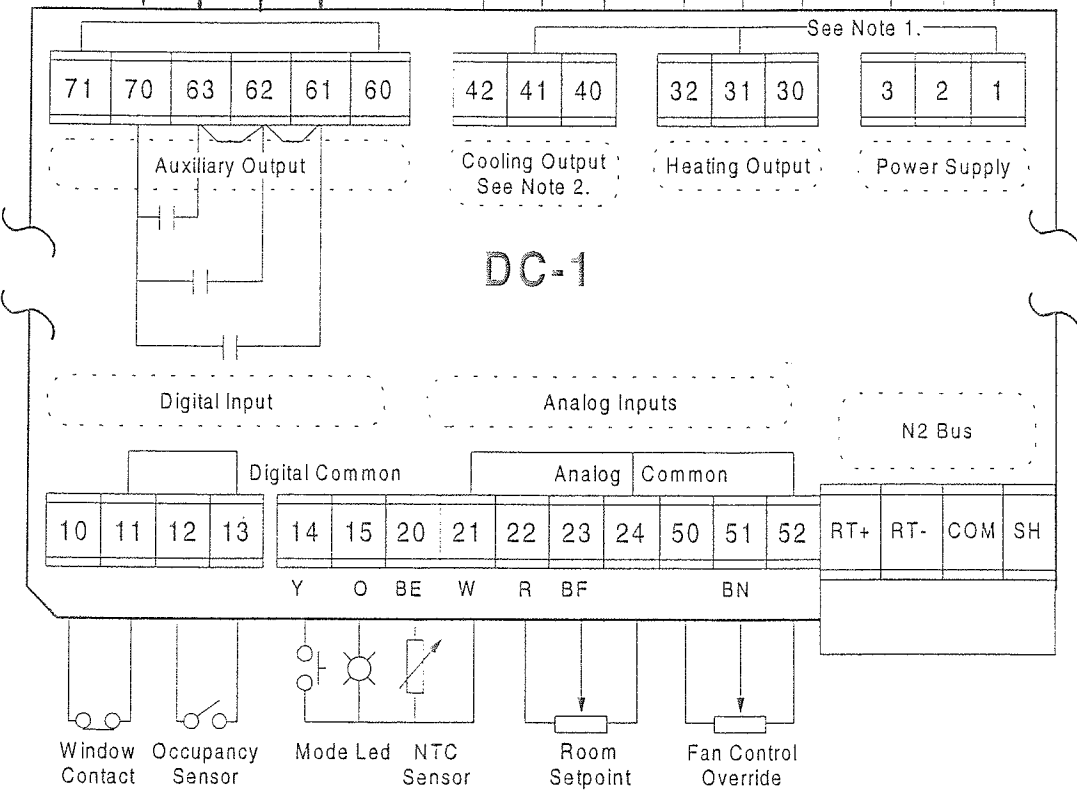


Note 1: For PAT, DAT, and On-Off outputs, terminals 1, 31, and 41 are internally connected.

WHT - REF
BLK - (-)
RED - (+)

REVISION INFORMATION	IN CONSIDERATION OF THE RECEIPT OF THIS DOCUMENT, THE RECIPIENT AGREES NOT TO REPRODUCE, COPY, USE OR TRANSMIT THIS DOCUMENT AND/OR THE INFORMATION THEREIN CONTAINED, IN WHOLE OR IN PART, OR TO SUFFER SUCH ACTION BY OTHERS, FOR ANY PURPOSE, EXCEPT WITH THE WRITTEN PERMISSION OF JOHNSON CONTROLS, INC. AND FURTHER AGREES TO SURRENDER SAME TO JOHNSON CONTROLS, INC. UPON DEMAND. COPYRIGHT JOHNSON CONTROLS, INC. 19nn	DRAWING TITLE	SUITE FAN COIL UNITS			
NUMBER		QUAD A	AS-BUILT	7/18/00	CME	
DATE		07/18/00	PROJECT TITLE	BALTIMORE NFL STADIUM AT CAMDEN YARDS		
TIME		02:34 PM	BALTIMORE, MARYLAND			
FILE NAME		FANCOILA.vsd		Johnson Controls, Inc. 60 Loveton Circle Sparks, MD 21152 7052-0098 DRAWING NUMBER BL-6559-03		


Full Spreadsheet		Software				Digital Controller Information					Panel Information				Intermediate Device				Field Device				Ref Detail	Comment				
Tag	Point Type	System Name	Object Name	Expanded ID	Display Units	DC Type	N2 Trunk	N2 Addr	Cable Destination Bay/Terminal	Module Type	Termination	Panel	Panel Location	Slot Number	Reference Drawing	Cable Number	Wiring/Tubing	Termination In	Device	Termination Out	Location	Wiring/Tubing	Terminations	Device	Location	Ref Detail	Comment	
		FCU-A				TC						EN-FCU	At FCU														Power to Controller	
		FCU-A				TC						EN-FCU	At FCU	01													N2 Trunk	
BO-1	FCU-A	H-VLV-OP	Htg Valve Open		Off On	TC		YIBO-1			32.31/COM.30	EN-FCU	At FCU	01		FC-x-BO-1						3/18	BLK,WHT,RED	VA-7150 (Heating)				
BO-2	FCU-A	H-VLV-CL	Htg Valve Close		Off On	TC		YIBO-2			32.31/COM.30	EN-FCU	At FCU	01		FC-x-BO-2						3/18	BLK,WHT,RED	VA-7150 (Heating)				
BO-3	FCU-A	C-VLV-OP	Cig Valve Open		Off On	TC		YIBO-3			42.41/COM.40	EN-FCU	At FCU	01		FC-x-BO-3						3/18	BLK,WHT,RED	VA-7150 (Cooling)				
BO-4	FCU-A	C-VLV-CL	Cig Valve Close		Off On	TC		YIBO-4			42.41/COM.40	EN-FCU	At FCU	01		FC-x-BO-4						3/18	BLK,WHT,RED	VA-7150 (Cooling)				
BO-5	FCU-A	F-SPD-1	Fan (Speed 1)		Off On	TC		YIBO-5			71.70 LINE 83.82	EN-FCU	At FCU	01		FC-x-BO-5						4/14	HI,MED,LOW,NEU	Starter Coil (3 spd fan)				
BO-6	FCU-A	F-SPD-2	Fan (Speed 2)		Off On	TC		YIBO-6			71.70 LINE 83.82	EN-FCU	At FCU	01		FC-x-BO-6						4/14	HI,MED,LOW,NEU	Starter Coil (3 spd fan)				
BO-7	FCU-A	F-SPD-3	Fan (Speed 3)		Off On	TC		YIBO-7			71.70 LINE 83.82	EN-FCU	At FCU	01		FC-x-BO-7						4/14	HI,MED,LOW,NEU	Starter Coil (3 spd fan)				
BI-1	FCU-A					TC		YIBI-1				EN-FCU	At FCU	01		FC-x-BI-1												
BI-2	FCU-A					TC		YIBI-2				EN-FCU	At FCU	01		FC-x-BI-2												
BI-3	FCU-A					TC		YIBI-3				EN-FCU	At FCU	01		FC-x-BI-3												
AI-1	FCU-A	ZN-T	Zone Temperature		Deg F	TC		YIAI-1			14 MODE,15 LED	EN-FCU	At FCU	01		FC-x-AI-1						3/22	14 MODE,15 LED	TM-9100 (Mode & LED)				
AI-2	FCU-A	ZN-SET	Zone Temp Set Point		Deg F	TC		YIAI-2			22,23,21/24	EN-FCU	At FCU	01		FC-x-AI-2						3/22	22,23,21/24	TM-9100 (Setpoint)				
AI-4	FCU-A	OVR	Fan Override		Lo-Md-Hi	TC		YIAI-4			51,21/24	EN-FCU	At FCU	01		FC-x-AI-4						3/22	51,21/24	TM-9100 (Fan Override)				

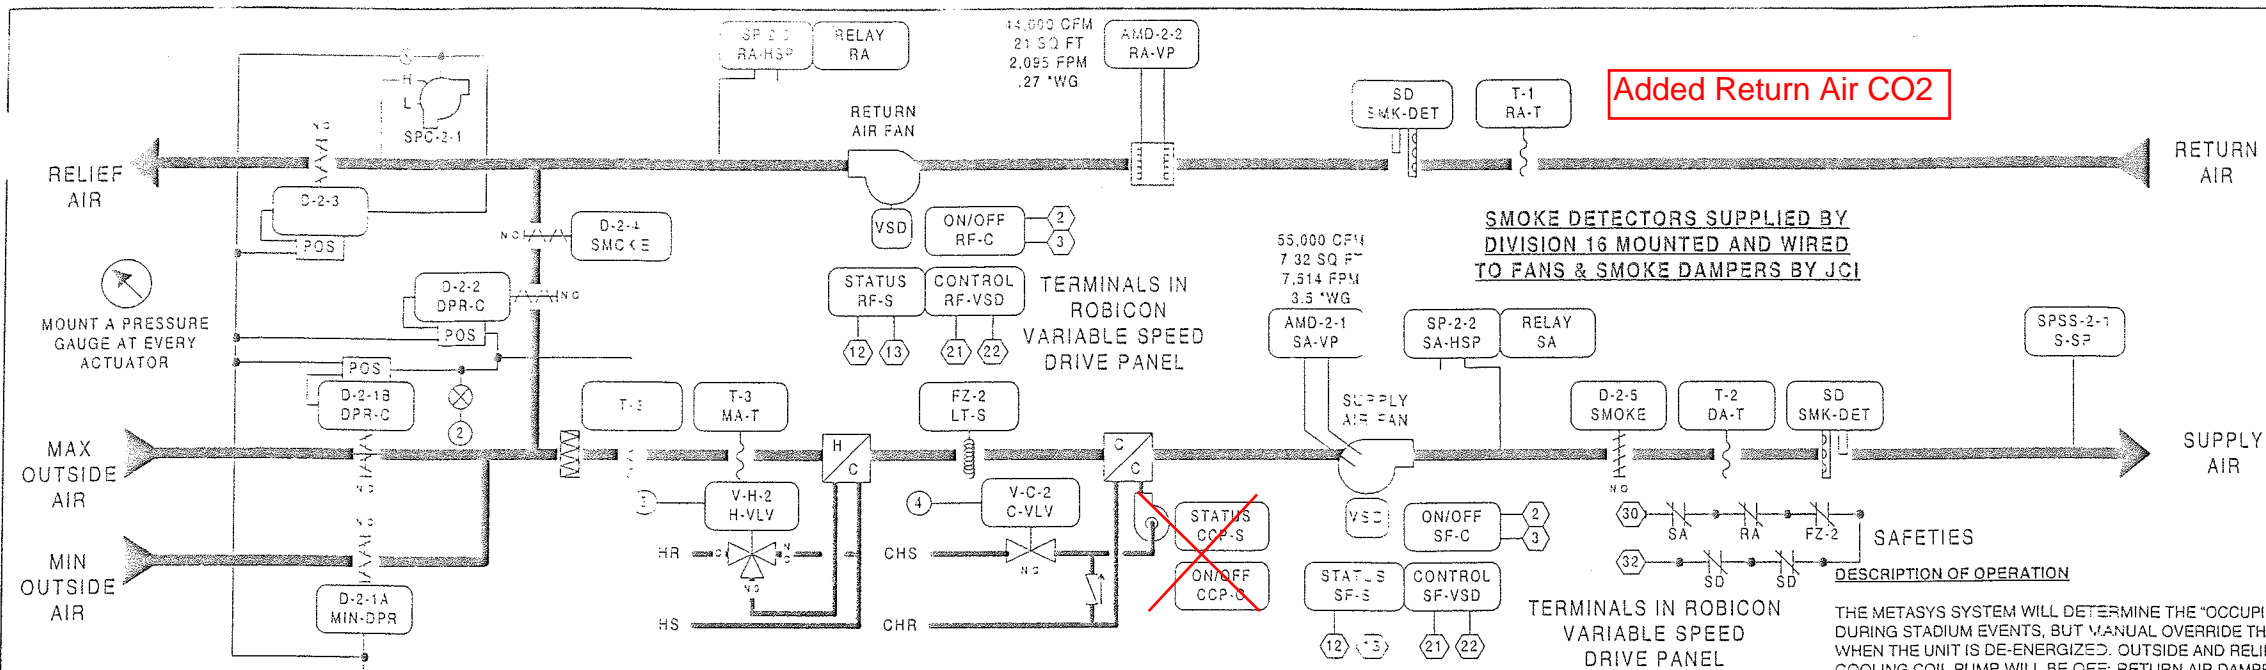


BILL OF MATERIALS 70520098.pre

Design.	Qty	Part #	Description
Field Devices:			
D-2-1A, D-2-1B	---	---	SEE DAMPER SCHEDULE
D-2-2, D-2-3	---	---	---
DPR-C	3	D-3153-1	CMPR ACT, 3-11, W/PILOT
DPR-C, MIN-DPR2	1	D-3153-1	CMPR ACT, 3-11, W/PILOT
	5	G-2010-11	GAGE, 2", 0-10 PSIG, STEM
FZ-2	1	A70HA-10	STAT, LL, 20', EL, MAN, 15/55P
H-VLV, C-VLV	1	---	SEE VALVE SCHEDULE
MA-T, DA-T	3	TE-6314P-1	SENS, T-NI, 1.14, 17' AVG
RA-T	1	---	---
RA-VP	1	DPT-2641-3	KDCUR DP 0.1, 1.5" 4-20ma
S-SP	1	DPT-2641-7	KDCUR DP 0.1, 1.0" 4-20ma
SA-HSP, RA-HSP2	1	AFS-467	DUCT AIR FLOW HIGH STATIC
SA-VP	1	DPT-2641-6	KDCUR DP 0.1, 1.0" 4-20ma
SPC-2-1	1	R-317-1	INTLR DP, 1.15-1" WG
T-3	1	T-3613-1391	STAT, LOW VCL, 3' AVG, DCT
TEP	4	BZ-1003-11	ENCL, 4-5/8" E-1/8" X 1-3/8"
	4	PD-101-35	RLY BASE, 3PDT, 1.19IN, 10A
	4	PD-109-51	RELAY PLUG-IN 3PDT 24VAC
Panel Devices:			
EN-AHU-2	1	AS-AHU103-300	AHU TERM BD IN EN035
	1	EN-EXP101-0	UNIV PKG MCD, IVR & BACKBN
EP-1, 2, 3	3	EP-3003-4	KDCUR, EP, 4-10ma, HI VOL
EP-4	1	V1HGA-100	3-W SOLENOID, MOV, 24 VAC
PI-1, 2, 3, 4	4	G-2010-11	GAGE, 2", 0-11 PSIG, STEM
RLY-1, 2	2	AS-RLY012-0	RELAY, 2SPDT 5 AMP 240VAC
SA, RA	2	PD-101-35	RLY BASE, 3PDT, 1.19IN, 10A
	2	PD-109-51	RELAY PLUG-IN 3PDT 24VAC


RETURN FAN WIRING DIAGRAM

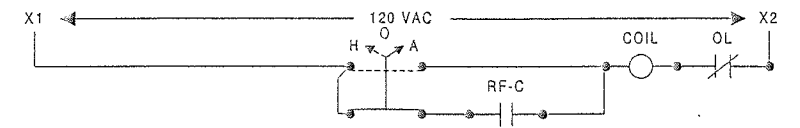

COOLING COIL PUMP DIAGRAM

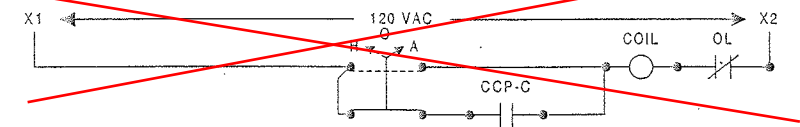


TOILET EXHAUST FAN DIAGRAM

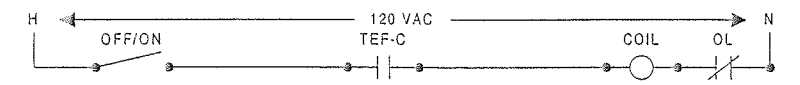

FAN	LOCATION	ELEC PANEL	CIRCUIT	LOCATION
TEF-B14	ROOF	STARTER		ROOF
TEF-B15	ROOF	RFUCB	17	UP CONCOURSE
TEF-B16	ROOF	RFUCB	13	UP CONCOURSE
TEF-B17	ROOF	STARTER		ROOF
TEF-B25	CLUB LEVEL	FP2CLB	11	CLUB LEVEL

CONTROLLED FROM MAU PANEL - UPPER CONCOURSE B03

USE (4) PD-109-51 & (4) PD-101-35 AT (4) PANEL/STARTER LOCATIONS

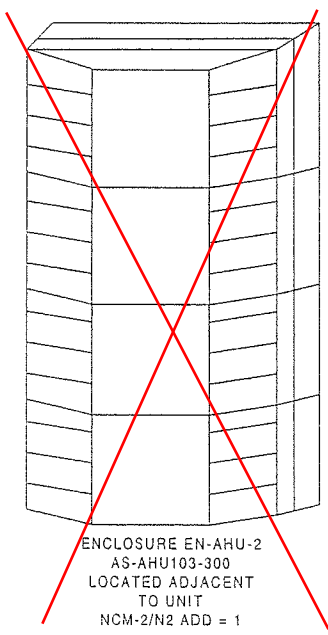

ENCLOSURE EN-AHU-2 AS-AHU103-300 LOCATED ADJACENT TO UNIT NCM-2/N2 ADD = 1

DESCRIPTION OF OPERATION

THE METASYS SYSTEM WILL DETERMINE THE "OCCUPIED AND UNOCCUPIED" MODES OF OPERATION. OCCUPIED MODES GENERALLY OCCUR DURING STADIUM EVENTS, BUT MANUAL OVERRIDE THROUGH THE METASYS SYSTEM ON SELECTED UNITS WILL FREQUENTLY BE REQUIRED. WHEN THE UNIT IS DE-ENERGIZED, OUTSIDE AND RELIEF AIR DAMPERS D-2-1A, D-2-1B, D-2-2, D-2-3 AND COOLING COIL VALVE V-C-2 WILL CLOSE; COOLING COIL PUMP WILL BE OFF; RETURN AIR DAMPER D-2-2 WILL BE OPEN AND HEATING COIL VALVE V-H-2 WILL BE CLOSED TO THE COIL. SMOKE DAMPERS D-2-4, D-2-5 WILL REMAIN OPEN UNDER CONTROL OF SMOKE DETECTION SYSTEM.

WARM-UP MODE - SUPPLY AND RETURN FANS WILL START AS DETERMINED BY THE OPTIMAL START PROGRAM OF THE METASYS SYSTEM. ON THE START OF THE UNIT, HEATING COIL VALVE V-H-2 WILL OPEN FULL TO COIL AND RETURN AIR DAMPER D-2-2 WILL BE FULLY OPEN WITH THE OUTSIDE AIR DAMPERS D-2-1A, D-2-1B AND RELIEF AIR DAMPER D-2-3 CLOSED. DURATION OF THE WARM-UP MODE IS DETERMINED BY THE METASYS SYSTEM AND WILL BE DYNAMICALLY UPDATED TO END FIFTEEN (15) MINUTES PRIOR TO OCCUPANCY TIME. WARM-UP MODE IS STOPPED WHEN RETURN AIR TEMPERATURE REACHES THE SETTING OF T-1 (70F).

OCCUPIED HEATING MODE - SUPPLY AND RETURN FANS WILL BE RUNNING, RETURN AIR DAMPER D-2-2 IS OPEN. MINIMUM OUTSIDE AIR DAMPER D-2-1A WILL OPEN AFTER THE WARM-UP MODE IS STOPPED. DISCHARGE SENSOR T-2, THROUGH THE METASYS SYSTEM CONTROL UNIT, WILL ON A RISE IN TEMPERATURE ABOVE ITS SETTING OF FORTY-FIVE (45F) MODULATE V-H-2 CLOSED TO THE HEATING COIL. ON A FURTHER RISE, T-2 WILL GRADUALLY MODULATE DAMPERS D-2-1B, OPEN WHILE SIMULTANEOUSLY CLOSING D-2-2. STATIC PRESSURE CONTROLLER SPC-2-1 LOCATED IN THE ENTERING SIDE OF THE RELIEF DAMPER WILL OVERRIDE THE CONTROL AND MODULATE D-2-3 TO MAINTAIN ITS SETTING TO ENSURE A POSITIVE BUILDING PRESSURE. LOW LIMIT THERMOSTAT T-3, SENSITIVE TO THE COLDEST SPOT IN THE AIR STREAM, WILL OVERRIDE T-2 TO PREVENT MIXED AIR FROM FALLING BELOW ITS SETTING OF FORTY (40F). ON A FALL IN TEMPERATURE, THE REVERSE WILL OCCUR. COOLING COIL VALVE V-C-2 WILL BE CLOSED TO THE COIL AND COIL CIRCULATION PUMP WILL BE OFF DURING THE HEATING MODE.

UNOCCUPIED HEATING MODE - IN THE UNOCCUPIED MODE ALL AIR HANDLING UNIT DAMPERS AND CONTROLS WILL RETURN TO THEIR NORMAL POSITION READY FOR RESTARTING.

OCCUPIED COOLING MODE - SUPPLY AND RETURN FANS AND COOLING COIL CIRCULATING PUMP START AND RUN CONTINUOUSLY. OUTSIDE AIR DAMPER D-2-1A WILL OPEN. OUTSIDE DAMPER D-2-1B AND RETURN DAMPER D-2-2 WILL, THROUGH THE METASYS SYSTEM CONTROL UNIT, BE UNDER FLOATING DRY BULB DIFFERENTIAL CONTROL WHICH WILL COMPARE THE TEMPERATURE OF THE RETURN AND OUTSIDE AIR STREAMS. THE OUTSIDE AIR WILL BE UTILIZED WHENEVER IT IS GREATER THAN SEVEN (7F) LESS THAN THE RETURN AIR TEMPERATURE. WHEN THE DIFFERENTIAL FALLS BELOW SEVEN (7F), MAXIMUM OUTSIDE AIR DAMPERS D-2-1B WILL CLOSE, OPENING RETURN AIR DAMPER D-2-2. DISCHARGE SENSOR T-2, THROUGH THE METASYS SYSTEM CONTROL UNIT, WILL IN SEQUENCE MODULATE OUTSIDE AND RETURN DAMPERS D-2-1B AND D-2-2 AND CHILLED WATER VALVE V-C-2 TO MAINTAIN ITS SETTING OF FORTY-FIVE (45F). HEATING COIL VALVE V-H-2 WILL REMAIN CLOSED TO THE COIL.

UNOCCUPIED COOLING MODE - SYSTEM IS DE-ENERGIZED AND THE FANS ARE OFF.

SMOKE CONTROL - SMOKE DETECTORS WILL, ON THE DETECTION OF PRODUCTS OF COMBUSTION, SHUT DOWN THE SUPPLY AND RETURN FANS AND CLOSE ALL SYSTEM DAMPERS.


FAN CONTROL - SYSTEM STATIC PRESSURE SENSING STATION SPSS-2-1 THROUGH A STATIC PRESSURE TRANSMITTER AND THE METASYS CONTROLLER WILL MODULATE THE SUPPLY FAN VARIABLE FREQUENCY DRIVE TO MAINTAIN ITS SETTING. ON A RISE IN STATIC AS SENSED BY SPSS-2-1 THE SUPPLY FAN DRIVE WILL GRADUALLY MODULATE FAN SPEED TO ITS MINIMUM POSITION TO MAINTAIN ITS SETTING. HIGH LIMIT STATIC PRESSURE CONTROLLER SPC-2-2, WHICH WILL OVERRIDE SPSS-2-1 TO PREVENT THE DISCHARGE FROM RISING ABOVE ITS SET POINT. SUPPLY DUCT AIR MONITORING STATION AMD-2-1 AND RETURN DUCT AIR MONITORING STATION AMD-2-2 THROUGH VELOCITY PRESSURE TRANSMITTERS WILL SEND SIGNALS TO THE METASYS CONTROLLER WHICH WILL COMPARE TOTAL SUPPLY AND RETURN AIR QUANTITIES AND MODULATE RETURN FAN VARIABLE SPEED DRIVE BASED ON SETPOINT TO SYNCHRONIZE RETURN FAN VOLUME WITH THE SUPPLY FAN VOLUME SO AS TO MAINTAIN CONSTANT MINIMUM BALANCED OUTSIDE AIR FLOW. DIFFERENTIAL WILL BE REDUCED TO ZERO (0) (NO OUTSIDE AIR) DURING WARM-UP AND UNOCCUPIED MODES OF OPERATION. MANUALLY RESET HIGH LIMIT STATIC PRESSURE CONTROLLERS SPC-2-2 AND SPC-2-3 WILL STOP THEIR RESPECTIVE SUPPLY AND RETURN FANS WHENEVER THEIR SETTING IS REACHED. ALL FANS WILL BE REQUIRED TO BE MANUALLY RESTARTED IF DE-ENERGIZED BY STATIC PRESSURE CONTROLS. SUPPLY FANS WILL BE MANUALLY CONTROLLED USING A BY-PASS STARTER IF THEIR RESPECTIVE VARIABLE FREQUENCY FAN DRIVE FAILS.

TOILET EXHAUST FANS TEF-B14, B15, B16, B17, B25 - THE FAN WILL START WHEN THE AHU SUPPLY FAN IS STARTED AND THE SYSTEM IS IN THE "OCCUPIED" MODE.

SEE BL-6559-01A FOR ADDITIONAL WIRING DETAIL

REVISION INFORMATION NUMBER DATE 07/18/00 TIME 02:37 PM FILE NAME AHU-2.vsd	IN CONSIDERATION OF THE RECEIPT OF THIS DOCUMENT, THE RECIPIENT AGREES NOT TO REPRODUCE, COPY, USE OR TRANSMIT THIS DOCUMENT AND/OR THE INFORMATION THEREIN CONTAINED, IN WHOLE OR IN PART, OR TO SUFFER SUCH ACTION BY OTHERS, FOR ANY PURPOSE, EXCEPT WITH THE WRITTEN PERMISSION OF JOHNSON CONTROLS, INC. AND FURTHER AGREES TO SURRENDER SAME TO JOHNSON CONTROLS, INC. UPON DEMAND. COPYRIGHT JOHNSON CONTROLS, INC. 1998	DRAWING TITLE AIR HANDLING UNIT AHU-2 CLUB/SUITES QUAD B PRESS LEVEL QUAD B PROJECT TITLE BALTIMORE NFL STADIUM AT CAMDEN YARDS BALTIMORE, MARYLAND	<table border="1"> <tr> <td>AS-BUILT</td> <td>7/18/00</td> <td>CME</td> </tr> <tr> <td>REFERENCE DRAWING</td> <td>NO</td> <td>REVISION LOCATION</td> </tr> <tr> <td>SALES ENGINEER JDP</td> <td>PROJECT MANAGER WJT</td> <td>APPLICATION ENGINEER RTS</td> </tr> <tr> <td colspan="2">DRAWN BY RTS</td> <td>DATE 08-25-97</td> </tr> <tr> <td colspan="2">APPROVED BY</td> <td>DATE</td> </tr> <tr> <td colspan="2">BRANCH INFORMATION</td> <td>CONTRACT NUMBER</td> </tr> <tr> <td colspan="2">JOHNSON CONTROLS 60 LOYETON CIRCLE SPARKS, MD 21152</td> <td>7052-0098</td> </tr> <tr> <td colspan="2">SYSTEMS & SERVICES DIVISION</td> <td>DRAWING NUMBER BL-6559-04</td> </tr> </table>	AS-BUILT	7/18/00	CME	REFERENCE DRAWING	NO	REVISION LOCATION	SALES ENGINEER JDP	PROJECT MANAGER WJT	APPLICATION ENGINEER RTS	DRAWN BY RTS		DATE 08-25-97	APPROVED BY		DATE	BRANCH INFORMATION		CONTRACT NUMBER	JOHNSON CONTROLS 60 LOYETON CIRCLE SPARKS, MD 21152		7052-0098	SYSTEMS & SERVICES DIVISION		DRAWING NUMBER BL-6559-04
AS-BUILT	7/18/00	CME																									
REFERENCE DRAWING	NO	REVISION LOCATION																									
SALES ENGINEER JDP	PROJECT MANAGER WJT	APPLICATION ENGINEER RTS																									
DRAWN BY RTS		DATE 08-25-97																									
APPROVED BY		DATE																									
BRANCH INFORMATION		CONTRACT NUMBER																									
JOHNSON CONTROLS 60 LOYETON CIRCLE SPARKS, MD 21152		7052-0098																									
SYSTEMS & SERVICES DIVISION		DRAWING NUMBER BL-6559-04																									

Full Spreadsheet	Software					Digital Controller Information					Panel Information				Intermediate Device				Field Device				Ref Detail	Comment				
	Tag	Point Type	System Name	Object Name	Expanded ID	Display Units	DC Type	N2 Trunk	N2 Addr	Cable Destination Bay/Termination	Module Type	Termination	Panel	Panel Location	Slot Number	Reference Drawing	Cable Number	Wiring/Tubing	Termination In	Device	Termination Out	Location			Wiring/Tubing	Terminations	Device	Location
		AHU-2				AHU						EN-AHU-2	Press Lev MER B		IM.3-10											Power to Controller N2 Trunk		
		AHU-2				AHU						EN-AHU-2	Press Lev MER B		0IM.3-10													
	BO-1	AHU-2	MIN-DPR	Min OA Damper Control	Closed: Open	AHU			1BO-1			BO# 24V	EN-AHU-2	Press Lev MER B		0IM.3-10	AH-1-BO-1		V111GA-100			2/18	2-Wire	SAV-24VAC		A50		
	BO-2	AHU-2	SFC	Supply Fan Control	Off On	AHU			1BO-2	RLY		BO# 24V,BICOM	EN-AHU-2	Press Lev MER B		0IM.3-10	AH-1-BO-2	3/18	A,COILS.COM	RELAY-A	COM.NO	2/14	See starter detail	Starter (NO)		A53		
	BO-3	AHU-2	RF-C	Return Fan Control	Off On	AHU			1BO-3	RLY		BO# 24V,BICOM	EN-AHU-2	Press Lev MER B		0IM.3-10	AH-1-BO-3	3/18	B,COILS.COM	RELAY-B	COM.NO	2/14	See starter detail	Starter (NO)		A53		
	BO-4	AHU-2	CCP-C	Cig Coil Pump 2 Control	Off On	AHU			1BO-4	RLY		BO# 24V,BICOM	EN-AHU-2	Press Lev MER B		0IM.3-10	AH-1-BO-4	3/18	A,COILS.COM	RELAY-A	COM.NO	2/14	See starter detail	Starter (NO)		A50		
	BO-5	AHU-2	TEF-C	Toilet Exn Fan Control	Off On	AHU			1BO-5			BO# 24V	EN-AHU-2	Press Lev MER B		0IM.3-10	AH-1-BO-5					2/18	Device dependent	24VAC OUT				
	BO-6	AHU-2				AHU			1BO-6				EN-AHU-2	Press Lev MER B		0IM.3-10	AH-1-BO-6											
	BO-7	AHU-2				AHU			1BO-7				EN-AHU-2	Press Lev MER B		0IM.3-10	AH-1-BO-7											
	BO-8	AHU-2				AHU			1BO-8				EN-AHU-2	Press Lev MER B		0IM.3-10	AH-1-BO-8											
	BO-9	AHU-2				AHU			1BO-9				EN-AHU-2	Press Lev MER B		0IM.3-10	AH-1-BO-9											
	BO-10	AHU-2				AHU			1BO-10				EN-AHU-2	Press Lev MER B		0IM.3-10	AH-1-BO-10											
	AO-1	AHU-2	DPR-C	Damper Control	% Open	AHU			1AO-1			AO#,AOCOM	EN-AHU-2	Press Lev MER B		0IM.3-10	AH-1-AO-1	2/18	+-	EP-8000-4	SUPPLY,O	1/4"	Barb Fitting	EP-PNEU.		A28		
	AO-2	AHU-2	H-VLV	Heating Coil Valve	% Open	AHU			1AO-2			AO#,AOCOM	EN-AHU-2	Press Lev MER B		0IM.3-10	AH-1-AO-2	2/18	+-	EP-8000-4	SUPPLY,O	1/4"	Barb Fitting	EP-PNEU.		A28		
	AO-3	AHU-2	C-VLV	Cig Coil Valve	% Open	AHU			1AO-3			AO#,AOCOM	EN-AHU-2	Press Lev MER B		0IM.3-10	AH-1-AO-3	2/18	+-	EP-8000-4	SUPPLY,O	1/4"	Barb Fitting	EP-PNEU.		A21		
	AO-4	AHU-2	SF-VSD	Sup Fan Var Spd Drive	%	AHU			1AO-4			AO#,AOCOM	EN-AHU-2	Press Lev MER B		0IM.3-10	AH-1-AO-4					2/18	Device dependent	0-20mA OUT		A21		
	AO-5	AHU-2	RF-VSD	Ret Fan Var Spd Drive	%	AHU			1AO-5			AO#,AOCOM	EN-AHU-2	Press Lev MER B		0IM.3-10	AH-1-AO-5					2/18	Device dependent	0-20mA OUT				
	AO-6	AHU-2				AHU			1AO-6				EN-AHU-2	Press Lev MER B		0IM.3-10	AH-1-AO-6					2/22	Device dependent	Aux Contact (NO)		A40		
	BI-1	AHU-2	SF-S	Supply Fan Status	Off On	AHU			1BI-1			BI#,BICOM	EN-AHU-2	Press Lev MER B		0IM.3-10	AH-1-BI-1					2/22	Device dependent	Aux Contact (NO)		A40		
	BI-2	AHU-2	RF-S	Return Fan Status	Off On	AHU			1BI-2			BI#,BICOM	EN-AHU-2	Press Lev MER B		0IM.3-10	AH-1-BI-2					2/22	Device dependent	Contact (NO)		A40		
	BI-3	AHU-2	SMK-DET	Smoke Detectors	Normal Alarm	AHU			1BI-3			BI#,BICOM	EN-AHU-2	Press Lev MER B		0IM.3-10	AH-1-BI-3					2/22	NO,M1	A70 (NC)		A41		
	BI-4	AHU-2	LT-S	Low Temperature Stat	Normal Alarm	AHU			1BI-4			BI#,BICOM	EN-AHU-2	Press Lev MER B		0IM.3-10	AH-1-BI-4					2/22	Device dependent	Aux Contact (NO)		A40		
	BI-5	AHU-2	CCP-S	Cig Coil Pump 2 Status	Off On	AHU			1BI-5			BI#,BICOM	EN-AHU-2	Press Lev MER B		0IM.3-10	AH-1-BI-5					2/22	Device dependent	AFS-460 & Relay		A40		
	BI-6	AHU-2	SA-HSP	Supply Air Static Press	Normal Alarm	AHU			1BI-6			BI#,BICOM	EN-AHU-2	Press Lev MER B		0IM.3-10	AH-1-BI-6					2/22	Device dependent	AFS-460 & Relay		A40		
	BI-7	AHU-2	RA-HSP	Return Air Static Press	Normal Alarm	AHU			1BI-7			BI#,BICOM	EN-AHU-2	Press Lev MER B		0IM.3-10	AH-1-BI-7					2/22	Device dependent	AFS-460 & Relay		A40		
	BI-8	AHU-2				AHU			1BI-8				EN-AHU-2	Press Lev MER B		0IM.3-10	AH-1-BI-8											
	AI-1	AHU-2	RA-VP	Return Air Val Pressure	In. Wg	AHU			1AI-1			AI#,+VDC	EN-AHU-2	Press Lev MER B		0IM.3-10	AH-1-AI-1					2/18	+-	DPT-2641		A2		
	AI-2	AHU-2	RA-T	Return Air Temperature	Deg F	AHU			1AI-2			AI#,AICM	EN-AHU-2	Press Lev MER B		0IM.3-10	AH-1-AI-2					2/18	2-Wire	TE-8318P-1		A4		
	AI-3	AHU-2	DA-T	Disch Air Temperature	Deg F	AHU			1AI-3			AI#,AICM	EN-AHU-2	Press Lev MER B		0IM.3-10	AH-1-AI-3					2/18	2-Wire	TE-8318P-1		A4		
	AI-4	AHU-2	MA-T	Mixed Air Temperature	Deg F	AHU			1AI-4			AI#,AICM	EN-AHU-2	Press Lev MER B		0IM.3-10	AH-1-AI-4					2/18	2-Wire	TE-8318P-1		A4		
	AI-5	AHU-2				AHU			1AI-5				EN-AHU-2	Press Lev MER B		0IM.3-10	AH-1-AI-5											
	AI-6	AHU-2				AHU			1AI-6				EN-AHU-2	Press Lev MER B		0IM.3-10	AH-1-AI-6											
	AI-7	AHU-2	S-SP	Supply Static Pressure	In. Wg	AHU			1AI-7			AI#,+VDC	EN-AHU-2	Press Lev MER B		0IM.3-10	AH-1-AI-7					2/18	+-	DPT-2641		A2		
	AI-8	AHU-2	S-VP	Supply Val Pressure	In. Wg	AHU			1AI-8			AI#,+VDC	EN-AHU-2	Press Lev MER B		0IM.3-10	AH-1-AI-8					2/18	+-	DPT-2641		A2		

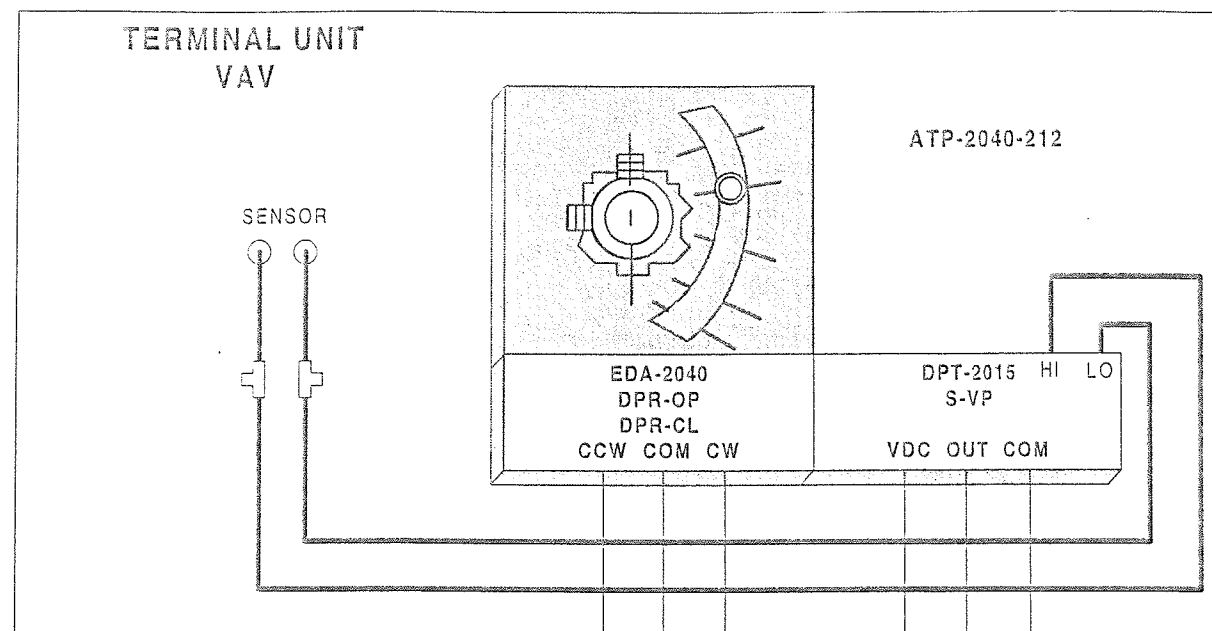


BILL OF MATERIALS

Estimate: quad b vavbox 70520098 pre

Desig.	Qty	Part #	Description
Field Devices:			
DC-1	53	AS-VAV110-1	VAV 6" L, 4BI, 8BO, 8K
V-RH-1	53	--	SEE VALVE SCHEDULE
VAV	53	ATP-2040-212	ACT, 2MIN-1.5" DP, 1/2" CPLG
ZN-T	35	TE-6410W-1000	MSTAT, MT, BOX, JACK


SERIES FAN POWERED VARIABLE AIR VOLUME (VAV) WITH REHEAT COIL

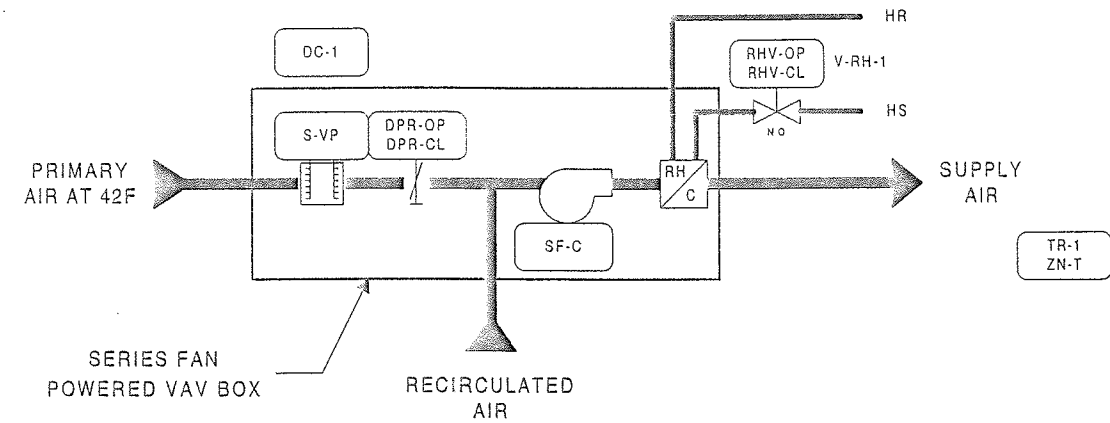

NOTE: VAV CONTROLLER (AS-VAV111-1) DAMPER ACTUATOR & DIFFERENTIAL PRESSURE TRANSMITTER (ATP-2040-212) ARE FACTORY MOUNTED BY TITUS

DESCRIPTION OF OPERATION

PRIMARY AIR VALVE WILL OPEN TO THEIR MINIMUM POSITION AND TERMINAL UNIT FAN WILL START AND RUN CONTINUOUSLY WHENEVER AIR HANDLING UNIT IS RUNNING. TERMINAL UNIT FANS WILL START THIRTY (30) SECONDS BEFORE OPENING OF AIR VALVES TO PREVENT BACK SPINNING OF FAN. FANS WILL ALSO BE OPERATED AS DEFINED IN THE UNOCCUPIED MODES. PRIMARY AIR VALVES WILL BE CLOSED DURING UNOCCUPIED HEATING MODE. ROOM SENSOR TR-1 WILL ON A RISE IN TEMPERATURE GRADUALLY MODULATE REHEAT COIL VALVE V-RH-1 CLOSED AND ON A CONTINUED RISE WILL GRADUALLY MODULATE PRIMARY AIR VALVE FROM IT'S MINIMUM TO MAXIMUM SETTING TO MAINTAIN IT'S SETTING OF SEVENTY-FIVE (75F). ON A FALL IN TEMPERATURE, THIS CYCLE IS REVERSED. DURING OPERATION OF THE WARM-UP MODE ALL PRIMARY AIR VALVES OPEN TO THEIR MAXIMUM POSITION AND TERMINAL FANS START TO PERMIT FULL AIR FLOW TO THE SPACES. REHEAT COIL VALVE V-RH-1 IS MODULATED IN RESPONSE TO ROOM SENSOR TO MAINTAIN SPACE TEMPERATURE.

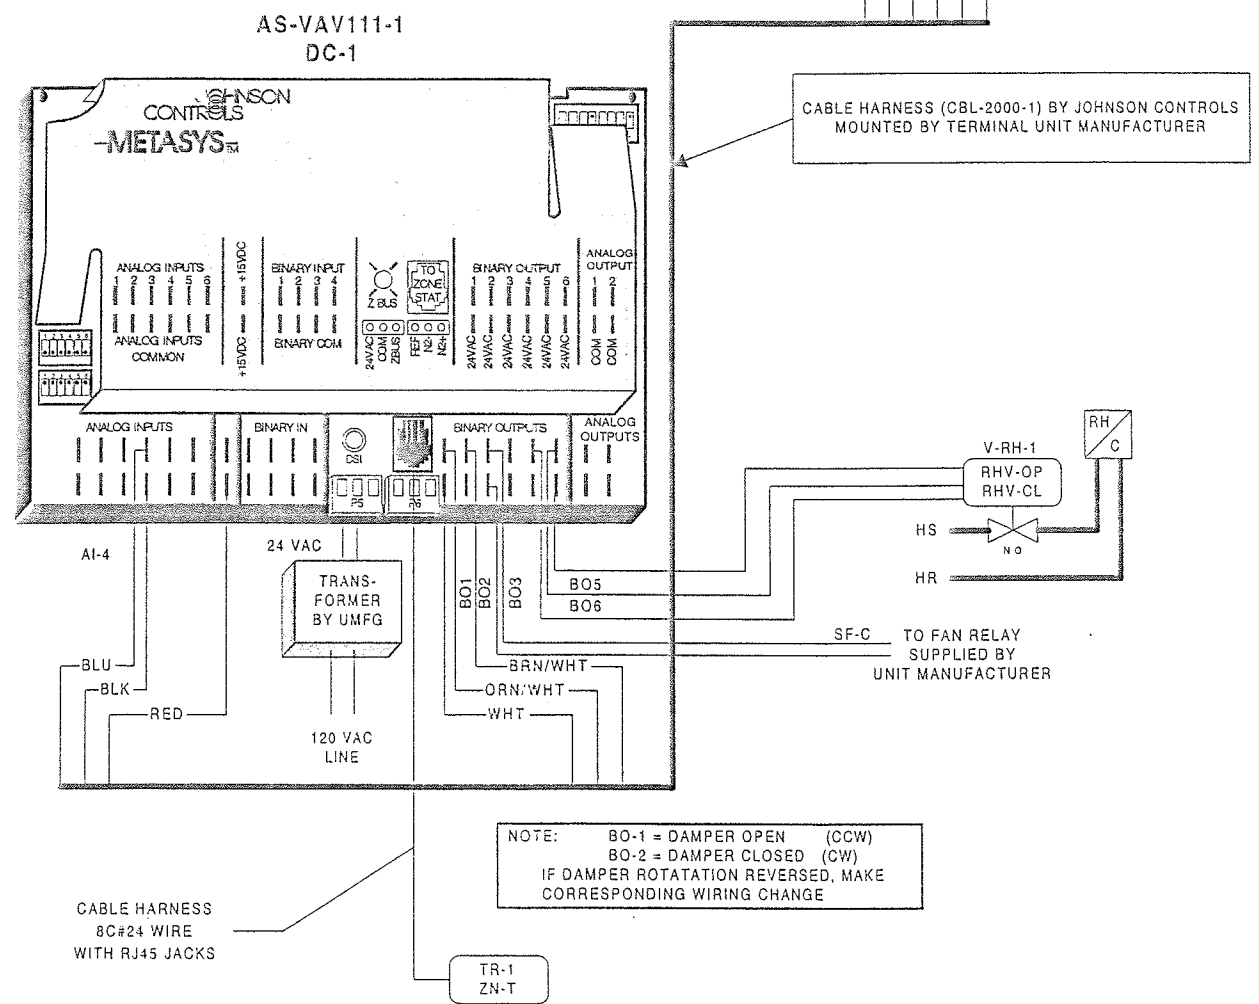


REVISION INFORMATION	DRAWING TITLE	AS-BUILT		DATE	BY
NUMBER	FAN POWERED TERMINAL REHEAT UNITS			7/18/00	CME
DATE	QUAD B	REFERENCE DRAWING	NO.	REVISION-LOCATION	ECN
07/18/00		JDP	WJT	RTS	
TIME	PROJECT TITLE	DRAWN		APPROVED	
02:39 PM	BALTIMORE NFL STADIUM AT CAMDEN YARDS	SALES ENGINEER	PROJECT MANAGER	APPLICATION ENGINEER	
FILE NAME	BALTIMORE, MARYLAND	JDP	WJT	RTS	
VAVBOX-B.vs		BY	DATE	DATE	
		RTS	08/26/97		
		Branch Information		CONTRACT NUMBER	
		JOHNSON CONTROLS Controls Group		7052-0098	
		Johnson Controls, Inc. 60 Loveton Circle Sparks, MD 21152		DRAWING NUMBER	
				BL-6559-05	

IN CONSIDERATION OF THE RECEIPT OF THIS DOCUMENT, THE RECIPIENT AGREES NOT TO REPRODUCE, COPY, USE OR TRANSMIT THIS DOCUMENT AND/OR THE INFORMATION THEREIN CONTAINED, IN WHOLE OR IN PART, OR TO SUFFER SUCH ACTION BY OTHERS, FOR ANY PURPOSE, EXCEPT WITH THE WRITTEN PERMISSION OF JOHNSON CONTROLS, INC. AND FURTHER AGREES TO SURRENDER SAME TO JOHNSON CONTROLS, INC. UPON DEMAND.


Copyright Johnson Controls, Inc. 1999

Full Spreadsheet		Software				Digital Controller Information					Panel Information				Intermediate Device				Field Device				Ref Detail	Comment			
Tag	Point Type	System Name	Object Name	Expanded ID	Display Units	DC Type	N2 Trunk	N2 Addr	Cable Destination Bay/Terminal	Module Type	Termination	Panel	Panel Location	Slot Number	Reference Drawing	Cable Number	Wiring/Tubing	Termination In	Device	Termination Out	Location	Wiring/Tubing	Terminations	Device	Location	Ref Detail	Comment
		FP-VAV-B				VAV						EN-FPVAV AT VAVBOX															Power to Controller
		FP-VAV-B				VAV	1	X				EN-FPVAV AT VAVBOX		0													N2 Trunk
AI-1		FP-VAV-B	ZN-T	Zone Temperature	Dag F	VAV	1	X AI-1			PHONE JACK	EN-FPVAV AT VAVBOX		0		FPVAV-x-AI-1	2/26		PHONE JACK				Metastat-Ph Jack			U2	
AI-2		FP-VAV-B				VAV	1	X AI-2				EN-FPVAV AT VAVBOX		0		FPVAV-x-AI-2											
AI-3		FP-VAV-B				VAV	1	X AI-3				EN-FPVAV AT VAVBOX		0		FPVAV-x-AI-3											
AI-4		FP-VAV-B	S-VP	Supply Vel Pressure	In. Wg	VAV	1	X AI-4			AI#,AICM,+15VDC	EN-FPVAV AT VAVBOX		0		FPVAV-x-AI-4	3/18		OUT.COM,+VDC				DPT-2000			U9	
AI-5		FP-VAV-B				VAV	1	X AI-5				EN-FPVAV AT VAVBOX		0		FPVAV-x-AI-5											
AI-6		FP-VAV-B				VAV	1	X AI-6				EN-FPVAV AT VAVBOX		0		FPVAV-x-AI-6											
BI-1		FP-VAV-B				VAV	1	X BI-1				EN-FPVAV AT VAVBOX		0		FPVAV-x-BI-1											
BI-2		FP-VAV-B				VAV	1	X BI-2				EN-FPVAV AT VAVBOX		0		FPVAV-x-BI-2											
BI-3		FP-VAV-B				VAV	1	X BI-3				EN-FPVAV AT VAVBOX		0		FPVAV-x-BI-3											
BI-4		FP-VAV-B				VAV	1	X BI-4				EN-FPVAV AT VAVBOX		0		FPVAV-x-BI-4											
BO-1		FP-VAV-B	DPR-OP	Damper Open	Off Cn	VAV	1	X BO-1			BO-a,BO-b,24VAC	EN-FPVAV AT VAVBOX		0		FPVAV-x-BO-1	3/18		CW,COW,COM				EDA-2040			U54	
BO-2		FP-VAV-B	DPR-CL	Damper Close	Off Cn	VAV	1	X BO-2			BO-a,BO-b,24VAC	EN-FPVAV AT VAVBOX		0		FPVAV-x-BO-2	3/18		CW,COW,COM				EDA-2040			U54	
BO-3		FP-VAV-B	SF-C	Supply Fan Control	Off Cn	VAV	1	X BO-3			BO#,24VAC	EN-FPVAV AT VAVBOX		0		FPVAV-x-BO-3	2/18	COIL	RELAY				INO,COM			U51	
BO-4		FP-VAV-B				VAV	1	X BO-4				EN-FPVAV AT VAVBOX		0		FPVAV-x-BO-4											
BO-5		FP-VAV-B	RHV-OP	Reheat Valve Open	Off Cn	VAV	1	X BO-5			BO-a,BO-b,24VAC	EN-FPVAV AT VAVBOX		0		FPVAV-x-BO-5	3/18		BLK,RED,WHT				VA-7150			U58	
BO-6		FP-VAV-B	RHV-CL	Reheat Valve Close	Off Cn	VAV	1	X BO-6			BO-a,BO-b,24VAC	EN-FPVAV AT VAVBOX		0		FPVAV-x-BO-6	3/18		BLK,RED,WHT				VA-7150			U58	
AO-1		FP-VAV-B				VAV	1	X AO-1				EN-FPVAV AT VAVBOX		0		FPVAV-x-AO-1											
AO-2		FP-VAV-B				VAV	1	X AO-2				EN-FPVAV AT VAVBOX		0		FPVAV-x-AO-2											

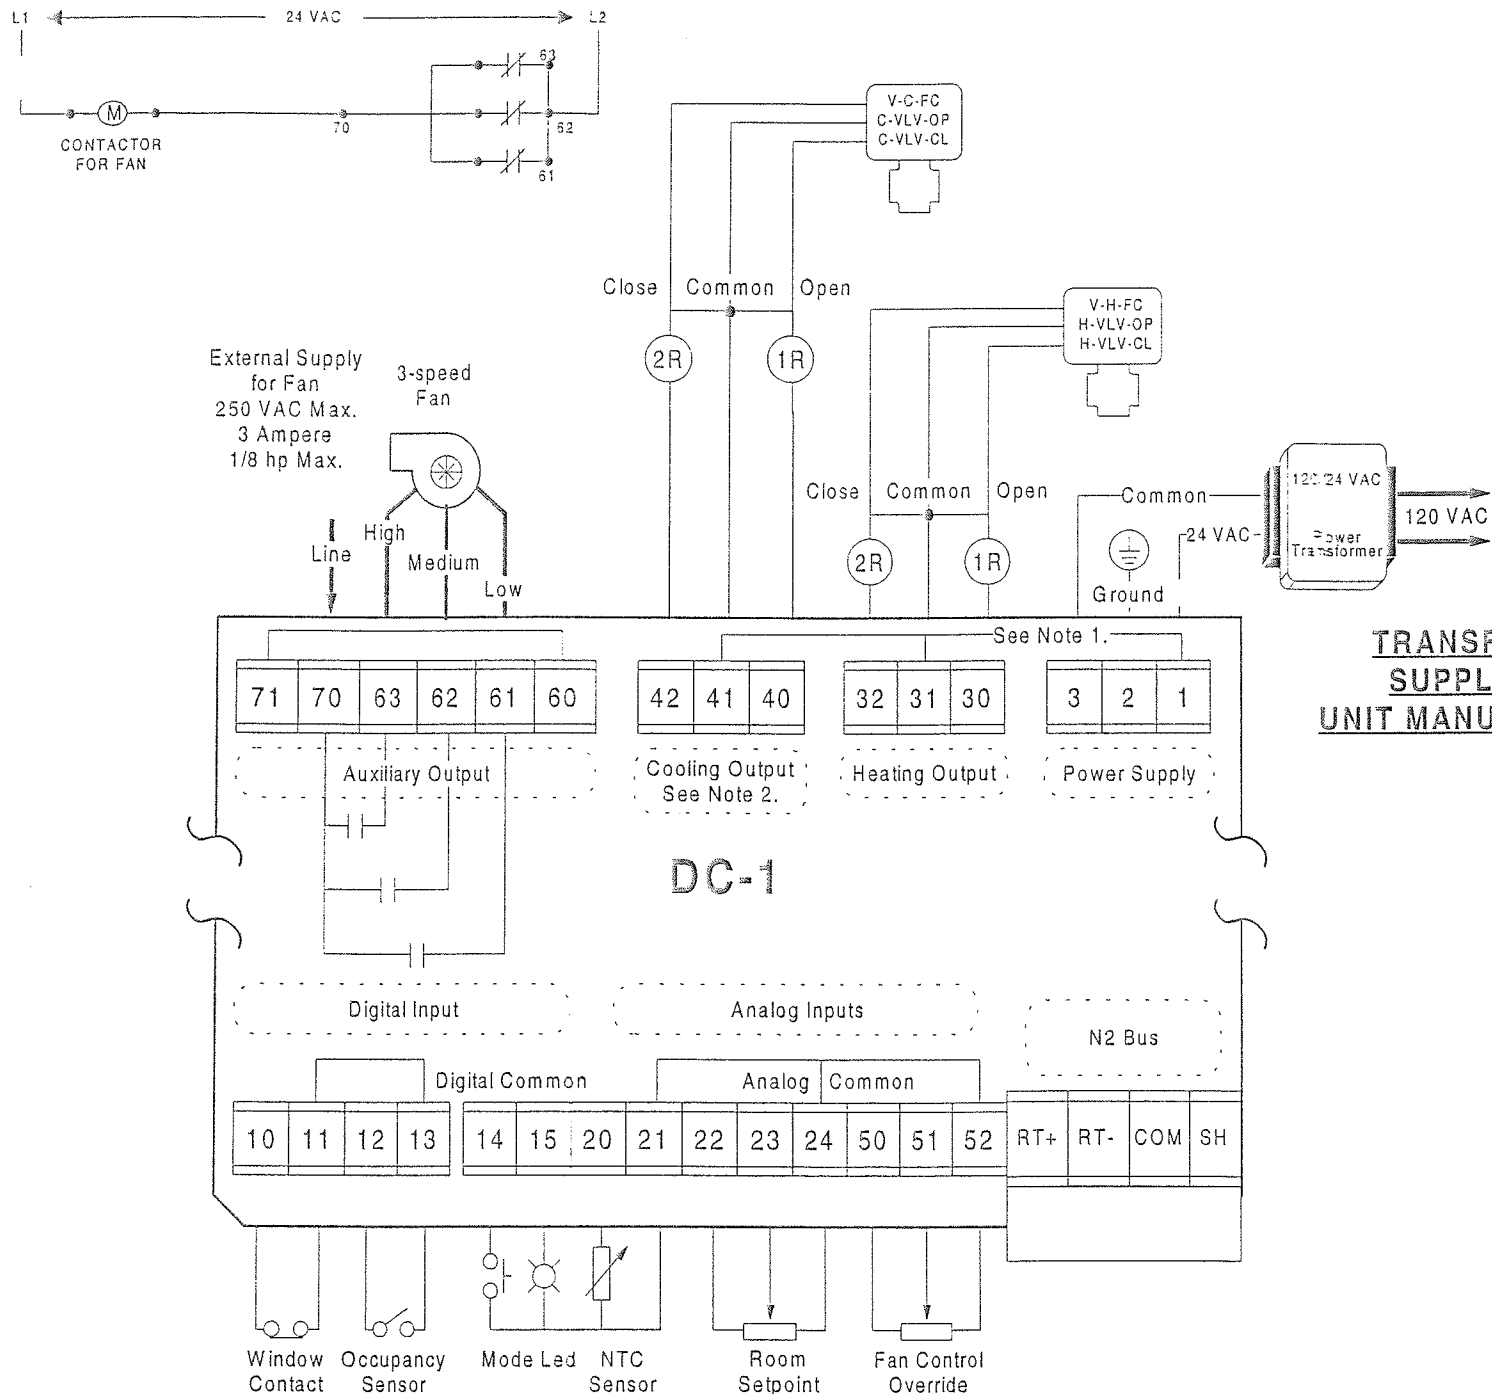

BILL OF MATERIALS

Estimate:	quad b fcu		70520098.ppt
Desig.	Qty	Part #	Description
Field Devices:			
DC-1	27	TC-9102-0332	FAN CONTROLLER 2-STG H/C
V-H-FC	54	--	SEE VALVE SCHEDULE
V-C-FC			
ZN-T	27	TM-9161-5002	MSTAT F/TC-9100 55-85F FSC

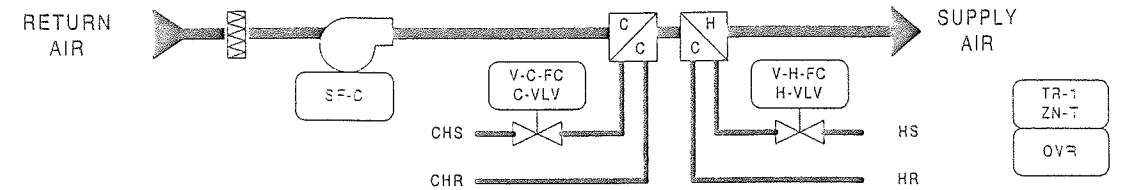

**TRANSFORMER
SUPPLIED BY
UNIT MANUFACTURER**

**NOTE: FCU CONTROLLER (TC-9102-0322)
ARE FACTORY MOUNTED BY TRANE**

DESCRIPTION OF OPERATION

THE METASYS SYSTEM WILL DETERMINE THE "OCCUPIED AND UNOCCUPIED" MODES OF OPERATION. OCCUPIED MODE GENERALLY OCCURS DURING THE NORMAL WORK WEEK AND STADIUM EVENTS, BUT MANUAL OVERRIDE THROUGH THE METASYS SYSTEM ON INDIVIDUAL UNITS WILL FREQUENTLY BE REQUIRED. SUITE OWNERS WILL HAVE THE ABILITY TO UTILIZE SUITES FOR PRIVATE FUNCTIONS AT ANYTIME. WHEN FAN COIL UNITS ARE DE-ENERGIZED, COOLING COIL VALVE V-C-FC AND HEATING COIL VALVE V-H-FC WILL BE CLOSED TO COILS.


OCCUPIED MODE - FAN COIL UNIT SUPPLY FAN WILL BE STARTED THROUGH ITS FAN SPEED SWITCH AND RUN CONTINUOUSLY. STARTING OF THE FAN COIL UNIT WILL INITIATE THE START OF THE RELATED EXHAUST FAN. THE EXHAUST AIR VOLUME INDUCES THE NATURAL VENTILATION OF THE SUITE AND MUST THEREFORE BE ENERGIZED WHENEVER THE SUITE IS OCCUPIED. ROOM SENSOR TR-1 WILL MODULATE HEATING COIL VALVE V-H-FC AND COOLING COIL VALVE V-C-FC IN SEQUENCE TO MAINTAIN ITS SETTING OF SEVENTY-FIVE (75F).

UNOCCUPIED MODE - ROOM SENSOR TR-1 WILL ON A FALL IN TEMPERATURE TO ITS SETTING OF FIFTY (50F) ACTIVATE SYSTEM TO RUN IN THE OCCUPIED MODE AS HEREINBEFORE DESCRIBED. ON A RISE IN TEMPERATURE TO FIFTY-FIVE (55F), FAN COIL UNIT WILL BE DE-ENERGIZED AND HEATING COIL VALVE WILL CLOSE.

Note 1: For PAT, DAT, and On-Off outputs, terminals 1, 31, and 41 are internally connected.

REVISION INFORMATION	IN CONSIDERATION OF THE RECEIPT OF THIS DOCUMENT, THE RECIPIENT AGREES NOT TO REPRODUCE, COPY, USE OR TRANSMIT THIS DOCUMENT AND/OR THE INFORMATION THEREIN CONTAINED, IN WHOLE OR IN PART, OR TO SUFFER SUCH ACTION BY OTHERS, FOR ANY PURPOSE, EXCEPT WITH THE WRITTEN PERMISSION OF JOHNSON CONTROLS, INC. AND FURTHER AGREES TO SURRENDER SAME TO JOHNSON CONTROLS, INC. UPON DEMAND.	DRAWING TITLE	AS-BUILT		DATE	BY	
NUMBER		COPYRIGHT JOHNSON CONTROLS, INC. 1998	SUITE FAN COIL UNITS			7/18/00	CME
DATE	QUAD B		REFERENCE DRAWING NO.	REVISION-LOCATION	ECN	DATE	BY
TIME		BALTIMORE NFL STADIUM AT CAMDEN YARDS	Sales Engineer	Project Manager	Application Engineer	DRAWN	APPROVED
FILE NAME		BALTIMORE, MARYLAND	JDP	WJT	RTS	BY RTS	DATE 8/28/97
			Branch Information		CONTRACT NUMBER		
			Johnson Controls, Inc. 60 Loveton Circle Sparks, MD 21152		7052-0098		
			Controls Group		DRAWING NUMBER BL-6559-06		

Full Spreadsheet		Software				Digital Controller Information					Panel Information				Intermediate Device				Field Device								
Tag	Point Type	System Name	Object Name	Expanded ID	Display Units	DC Type	N2 Trunk	N2 Addr	Cable Destination Bay/Terminal	Module Type	Termination	Panel	Panel Location	Slot Number	Reference Drawing	Cable Number	Wiring/Tubing	Termination In	Device	Termination Out	Location	Wiring/Tubing	Terminations	Device	Location	Ref Detail	Comment
		FCU-B				TC						EN-FCU	AI FCU														Power to Controller
		FCU-B				TC	1	Y				EN-FCU	AI FCU	01													N2 Trunk
BO-1		FCU-B	H-VLV-OP	Htg Valve Open	Off On	TC	1	Y	BO-1		32,31.COM,30	EN-FCU	AI FCU	01		FCU-x-BO-1					3/18	BLK,WHT,RED	VA-7150 (Heating)				
BO-2		FCU-B	H-VLV-CL	Htg Valve Close	Off On	TC	1	Y	BO-2		32,31.COM,30	EN-FCU	AI FCU	01		FCU-x-BO-2					3/18	BLK,WHT,RED	VA-7150 (Heating)				
BO-3		FCU-B	C-VLV-OP	Clg Valve Open	Off On	TC	1	Y	BO-3		42,41.COM,40	EN-FCU	AI FCU	01		FCU-x-BO-3					3/18	BLK,WHT,RED	VA-7150 (Cooling)				
BO-4		FCU-B	C-VLV-CL	Clg Valve Close	Off On	TC	1	Y	BO-4		42,41.COM,40	EN-FCU	AI FCU	01		FCU-x-BO-4					3/18	BLK,WHT,RED	VA-7150 (Cooling)				
BO-5		FCU-B	F-SPD-1	Fan (Speed 1)	Off On	TC	1	Y	BO-5		71,70 LINE/63,62,EN	EN-FCU	AI FCU	01		FCU-x-BO-5					4/14	HI,MED,LOW,NEU	Starter Coil (3 spd fan)				
BO-6		FCU-B	F-SPD-2	Fan (Speed 2)	Off On	TC	1	Y	BO-6		71,70 LINE/63,62,EN	EN-FCU	AI FCU	01		FCU-x-BO-6					4/14	HI,MED,LOW,NEU	Starter Coil (3 spd fan)				
BO-7		FCU-B	F-SPD-3	Fan (Speed 3)	Off On	TC	1	Y	BO-7		71,70 LINE/63,62,EN	EN-FCU	AI FCU	01		FCU-x-BO-7					4/14	HI,MED,LOW,NEU	Starter Coil (3 spd fan)				
BI-1		FCU-B				TC	1	Y	BI-1			EN-FCU	AI FCU	01		FCU-x-BI-1											
BI-2		FCU-B				TC	1	Y	BI-2			EN-FCU	AI FCU	01		FCU-x-BI-2											
BI-3		FCU-B				TC	1	Y	BI-3			EN-FCU	AI FCU	01		FCU-x-BI-3											
AI-1		FCU-B	ZN-T	Zone Temperature	Deg F	TC	1	Y	AI-1		14 MODE,15 LED	EN-FCU	AI FCU	01		FCU-x-AI-1					3/22	14 MODE,15 LED	TM-9100 (Mode & LED)				
AI-2		FCU-B	ZN-SET	Zone Temp Set Point	Deg F	TC	1	Y	AI-2		22,23,21/24	EN-FCU	AI FCU	01		FCU-x-AI-2					3/22	22,23,21/24	TM-9100 (Setpoint)				
AI-4		FCU-B	OVR	Fan Override	Lo-Md-H	TC	1	Y	AI-4		51,21/24	EN-FCU	AI FCU	01		FCU-x-AI-4					2/22	51,21/24	TM-9100 (Fan Override)				

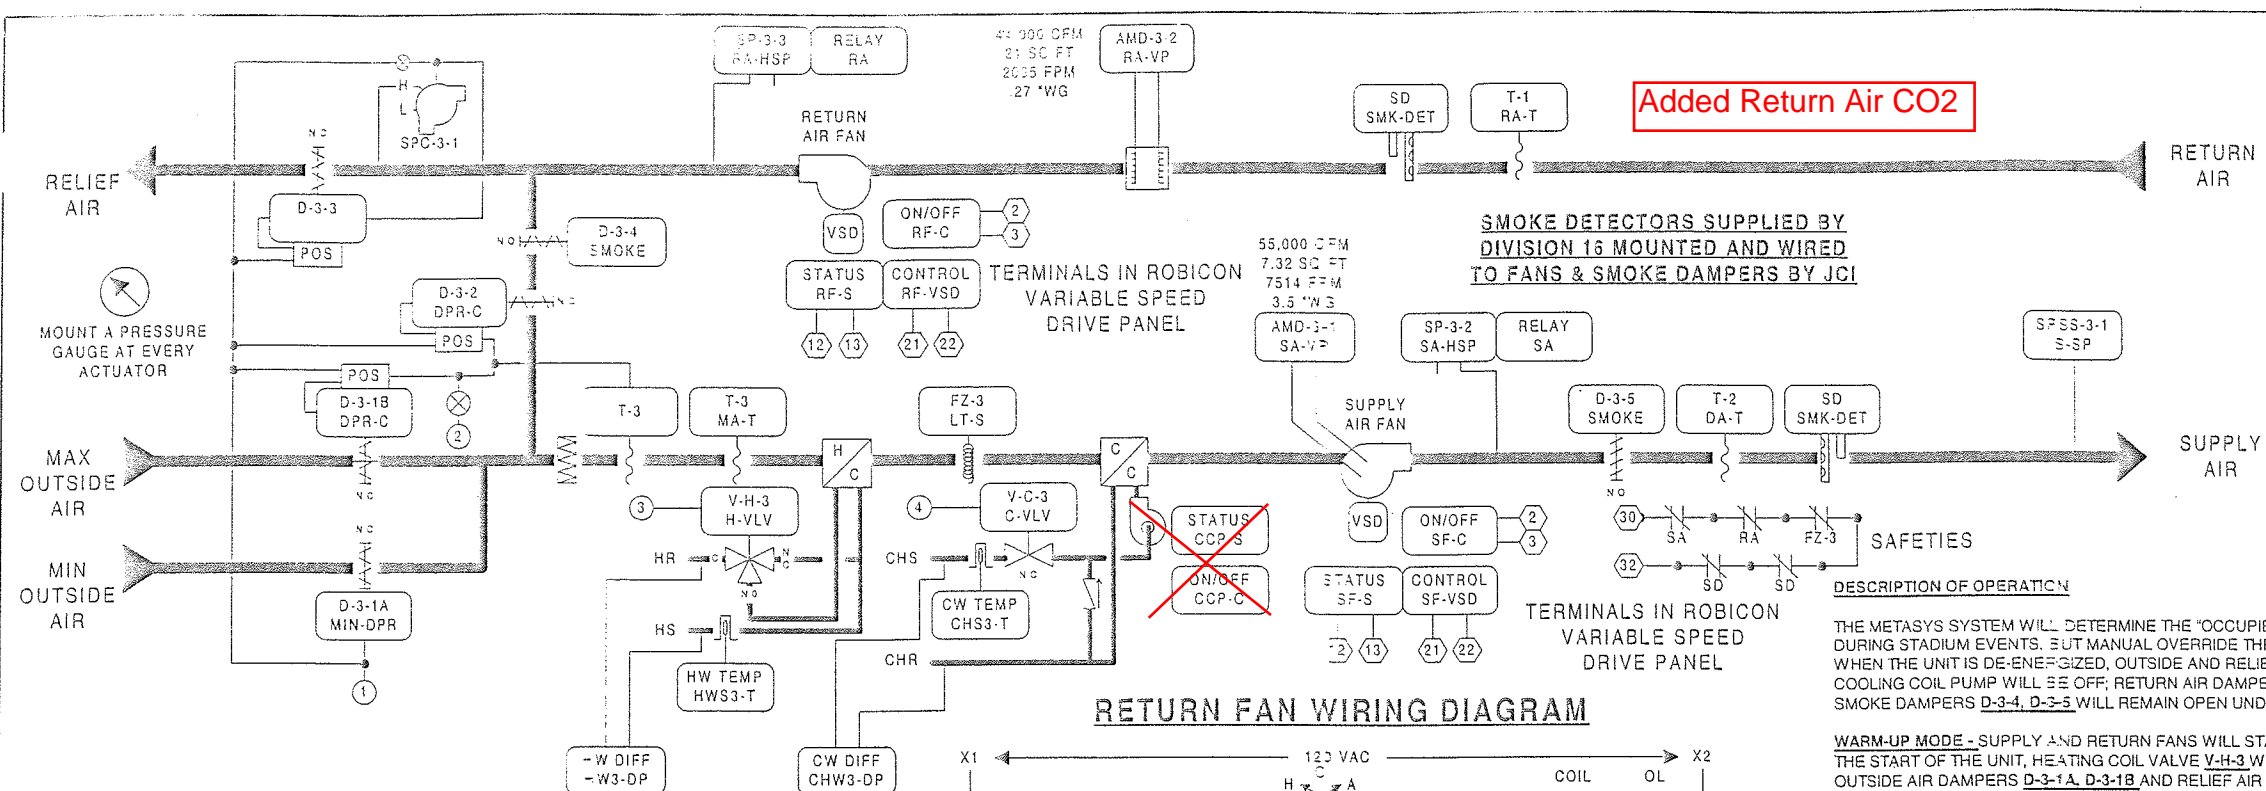


Estimate: ahu-3
70520098.prj

Design	Qty/Part #	Description
Field Devices:		
D-3-1A, D-3-1B	---	SEE DAMPER SCHEDULE
D-3-2, D-3-3	---	---
DPR-C	3 D-3153-1	DMPR ACT, 3-134, W/PILOT
DPR-C, MIN-DPR2	D-3153-2	DMPR ACT, 3-134
FZ-3	5 G-2010-11	GAGE, 1", 0-30 PSIG, STEM
H-VLV, C-VLV	1 A70HA-1C	STAT, 1.1, 20", EL, MAN, 15/55F
HW3-DP, CHS3-DP2	C-252	SEE VALVE SCHEDULE
HWS3-T, CHS3-T2	FE-611AP-1	DELTA TRANS RGS/HALP
	2 W2-1000-5	SENS, T-NL, 0.1%, F/WZ1000-5
MA-T, DA-T	3 TE-611SP-1	WELL, SFASS, 1/2" NPT+COMPND
RA-T		SENS, T-NL, 0.1%, 17" AVG
RA-VP	1 DPT-2641-3	XDCUR IP 0/0.5" 4-20ma
S-SP	1 DPT-2641-7	XDCUR IP 0/10.0" 4-20ma
SA-HSP, RA-HSP2	AFS-450	DUCT AIR FLCW HIGH STATIC
SA-VP	1 DPT-2641-5	XDCUR IP 0/5.0" 4-20ma
SPC-3-1	1 R-317-1	CTRLR DP, 0.05-1" WG
T-3	1 T-3610-1001	STAT, LOW VOL, 3" AVG, DCT
TEF	4 BZ-1000-11	EXCL, 4-E/SX 5-1/8 X 3-3/8
	4 PD-101-35	RLY BASE, 3PDT, 11PIN, 10A
	4 PD-109-51	RELAY PLUG-IN 3PDT 24VAC
Panel Devices:		
EN-AHU-3	1 AS-AHU103-300	AHU TERM SD IN ENC35
	1 EN-EXP101-3	UNIV FKG MCD, C/R & BACKRN
EP-1, 2, 3	3 EP-3000-4	XDCUR EP, 4-20ma, HI VOL
EP-4	1 V11HGA-100	1-W SLENOID, W/OV, 24 VAC
PI-1, 2, 3, 4	4 G-2010-11	GAGE, 1", 0-30 PSIG, STEM
RLY-1, 2	2 AS-RLY3002-0	RELAY, 3SPDT 5 AMP 240VAC
SA, RA	2 PD-101-35	RLY BASE, 3PDT, 11PIN, 10A
	2 PD-109-51	RELAY PLUG-IN 3PDT 24VAC


SMOKE DETECTORS SUPPLIED BY DIVISION 16 MOUNTED AND WIRED TO FANS & SMOKE DAMPERS BY JCI

RETURN FAN WIRING DIAGRAM

NOTE: HW & CW TEMPS & DIFF PRESSURE (4) POINTS ARE IN ENCLOSURE EN-DPS-3 AS-AVAV111-1 (NCM-3/N2 ADD = 2)

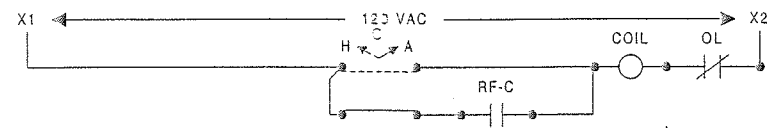

COOLING COIL PUMP DIAGRAM

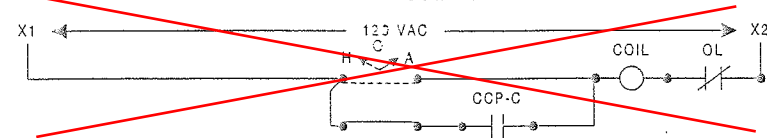


TOILET EXHAUST FAN DIAGRAM


FAN	LOCATION	ELEC PANEL	CIRCUIT	LOCATION
TEF-C6	ROOF	STARTER		UP CONCOURSE
TEF-C7	ROOF	RPUC	15	UP CONCOURSE
TEF-C8	ROOF	RPUC	19	UP CONCOURSE
TEF-C9	ROOF	STARTER		UP CONCOURSE
TEF-C14	CLUB LEVEL	RP2CLC	11	CLUB LEVEL

CONTROLLED FROM MAU PANEL - UPPER CONCOURSE B03

USE (4) PD-109-51 & (4) PD-101-35 AT (4) PANEL/STARTER LOCATIONS

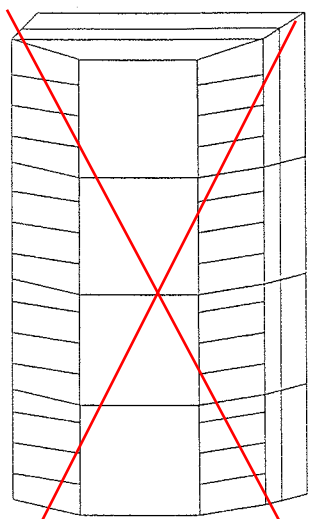

ENCLOSURE EN-AHU-3 AS-AHU103-300 LOCATED ADJACENT TO UNIT NCM-3/N2 ADD = 1

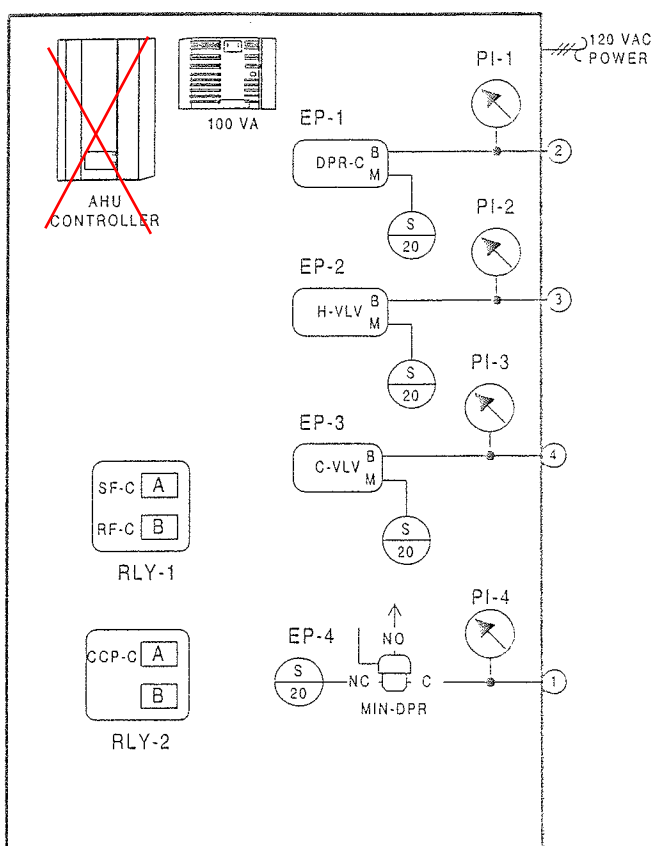

SEE BL-6559-01A FOR ADDITIONAL WIRING DETAIL

DESCRIPTION OF OPERATION

THE METASYS SYSTEM WILL DETERMINE THE "OCCUPIED AND UNOCCUPIED" MODES OF OPERATION. OCCUPIED MODES GENERALLY OCCUR DURING STADIUM EVENTS. BUT MANUAL OVERRIDE THROUGH THE METASYS SYSTEM ON SELECTED UNITS WILL FREQUENTLY BE REQUIRED. WHEN THE UNIT IS DE-ENERGIZED, OUTSIDE AND RELIEF AIR DAMPERS D-3-1A, D-3-1B, D-3-3 AND COOLING COIL VALVE V-C-3 WILL CLOSE; COOLING COIL PUMP WILL BE OFF; RETURN AIR DAMPER D-3-2 WILL BE OPEN AND HEATING COIL VALVE V-H-3 WILL BE CLOSED TO THE COIL. SMOKE DAMPERS D-3-4, D-3-5 WILL REMAIN OPEN UNDER CONTROL OF SMOKE DETECTION SYSTEM.

WARM-UP MODE - SUPPLY AND RETURN FANS WILL START AS DETERMINED BY THE OPTIMAL START PROGRAM OF THE METASYS SYSTEM. ON THE START OF THE UNIT, HEATING COIL VALVE V-H-3 WILL OPEN FULL TO COIL AND RETURN AIR DAMPER D-3-2 WILL BE FULLY OPEN WITH THE OUTSIDE AIR DAMPERS D-3-1A, D-3-1B AND RELIEF AIR DAMPER D-3-3 CLOSED. DURATION OF THE WARM-UP MODE IS DETERMINED BY THE METASYS SYSTEM AND WILL BE DYNAMICALLY UPDATED TO END FIFTEEN (15) MINUTES PRIOR TO OCCUPANCY TIME. WARM-UP MODE IS STOPPED WHEN RETURN AIR TEMPERATURE REACHES THE SETTING OF T-1 (70F).

OCCUPIED HEATING MODE - SUPPLY AND RETURN FANS WILL BE RUNNING, RETURN AIR DAMPER D-3-2 IS OPEN. MINIMUM OUTSIDE AIR DAMPER D-3-1A WILL OPEN AFTER THE WARM-UP MODE IS STOPPED. DISCHARGE SENSOR T-2, THROUGH THE METASYS SYSTEM CONTROL UNIT, WILL ON A RISE IN TEMPERATURE ABOVE ITS SETTING OF FORTY-FIVE (45F) MODULATE V-H-3 CLOSED TO THE HEATING COIL. ON A FURTHER RISE, T-2 WILL GRADUALLY MODULATE DAMPERS D-3-1B OPEN WHILE SIMULTANEOUSLY CLOSING D-3-2. STATIC PRESSURE CONTROLLER SPC-3-1 LOCATED IN THE ENTERING SIDE OF THE RELIEF DAMPER WILL OVERRIDE THE CONTROL AND MODULATE D-3-3 TO MAINTAIN ITS SETTING TO ENSURE A POSITIVE BUILDING PRESSURE. LOW LIMIT THERMOSTAT T-3, SENSITIVE TO THE COLDEST SPOT IN THE AIR STREAM, WILL OVERRIDE T-2 TO PREVENT MIXED AIR FROM FALLING BELOW ITS SETTING OF FORTY (40F). ON A FALL IN TEMPERATURE, THE REVERSE WILL OCCUR. COOLING COIL VALVE V-C-3 WILL BE CLOSED TO THE COIL AND COIL CIRCULATION PUMP WILL BE OFF DURING THE HEATING MODE.

UNOCCUPIED HEATING MODE - IN THE UNOCCUPIED MODE ALL AIR HANDLING UNIT DAMPERS AND CONTROLS WILL RETURN TO THEIR NORMAL POSITION READY FOR RESTARTING.

OCCUPIED COOLING MODE - SUPPLY AND RETURN FANS AND COOLING COIL CIRCULATING PUMP START AND RUN CONTINUOUSLY. OUTSIDE AIR DAMPER D-3-1A WILL OPEN. OUTSIDE DAMPER D-3-1B AND RETURN DAMPER D-3-2 WILL, THROUGH THE METASYS SYSTEM CONTROL UNIT, BE UNDER FLOATING DRY BULBS DIFFERENTIAL CONTROL WHICH WILL COMPARE THE TEMPERATURE OF THE RETURN AND OUTSIDE AIR STREAMS. THE OUTSIDE AIR WILL BE UTILIZED WHENEVER IT IS GREATER THAN SEVEN (7F) LESS THAN THE RETURN AIR TEMPERATURE. WHEN THE DIFFERENTIAL FALLS BELOW SEVEN (7F), MAXIMUM OUTSIDE AIR DAMPERS D-3-1B WILL CLOSE, OPENING RETURN AIR DAMPER D-3-2. DISCHARGE SENSOR T-2, THROUGH THE METASYS SYSTEM CONTROL UNIT, WILL IN SEQUENCE MODULATE OUTSIDE AND RETURN DAMPERS D-3-1B AND D-3-2 AND CHILLED WATER VALVE V-C-3 TO MAINTAIN ITS SETTING OF FORTY-FIVE (45F). HEATING COIL VALVE V-H-3 WILL REMAIN CLOSED TO THE COIL.

UNOCCUPIED COOLING MODE - SYSTEM IS DE-ENERGIZED AND THE FANS ARE OFF.

SMOKE CONTROL - SMOKE DETECTORS WILL, ON THE DETECTION OF PRODUCTS OF COMBUSTION, SHUT DOWN THE SUPPLY AND RETURN FANS AND CLOSE ALL SYSTEM DAMPERS.



FAN CONTROL - SYSTEM STATIC PRESSURE SENSING STATION SPSS-3-1 THROUGH A STATIC PRESSURE TRANSMITTER AND THE METASYS CONTROLLER WILL MODULATE THE SUPPLY FAN VARIABLE FREQUENCY DRIVE TO MAINTAIN ITS SETTING. ON A RISE IN STATIC AS SENSED BY SPSS-3-1 THE SUPPLY FAN DRIVE WILL GRADUALLY MODULATE FAN SPEED TO ITS MINIMUM POSITION TO MAINTAIN ITS SETTING. HIGH LIMIT STATIC PRESSURE CONTROLLER SPC-3-2 WHICH WILL OVERRIDE SPSS-3-1 TO PREVENT THE DISCHARGE FROM RISING ABOVE ITS SET POINT. SUPPLY DUCT AIR MONITORING STATION AMD-3-1 AND RETURN DUCT AIR MONITORING STATION AMD-3-2 THROUGH VELOCITY PRESSURE TRANSMITTERS WILL SEND SIGNALS TO THE METASYS CONTROLLER WHICH WILL COMPARE TOTAL SUPPLY AND RETURN AIR QUANTITIES AND MODULATE THE RETURN FAN VARIABLE FREQUENCY DRIVE BASED ON SETPOINT TO SYNCHRONIZE RETURN FAN VOLUME WITH THE SUPPLY FAN VOLUME SO AS TO MAINTAIN CONSTANT MINIMUM BALANCED OUTSIDE AIR FLOW. DIFFERENTIAL WILL BE REDUCED TO ZERO (0) (NO OUTSIDE AIR) DURING WARM-UP AND UNOCCUPIED MODES OF OPERATION. MANUALLY RESET HIGH LIMIT STATIC PRESSURE CONTROLLERS SPC-3-2 AND SPC-3-3 WILL STOP THEIR RESPECTIVE SUPPLY AND RETURN FANS WHENEVER THEIR SETTING IS REACHED. ALL FANS WILL BE REQUIRED TO BE MANUALLY RESTARTED IF DE-ENERGIZED BY STATIC PRESSURE CONTROLS. SUPPLY FANS WILL BE MANUALLY CONTROLLED USING A BY-PASS STARTER IF THEIR RESPECTIVE VARIABLE FREQUENCY FAN DRIVE FAILS.

TOILET EXHAUST FANS TEF-C6, C7, C8, C9, C14 - THE FAN WILL START WHEN THE AHU SUPPLY FAN IS STARTED AND THE SYSTEM IS IN THE "OCCUPIED" MODE.

REVISION INFORMATION NUMBER DATE 07/18/00 TIME 02:48 PM FILE NAME AHU-3.vsd	IN CONSIDERATION OF THE RECEIPT OF THIS DOCUMENT, THE RECIPIENT AGREES NOT TO REPRODUCE, COPY, USE OR TRANSMIT THIS DOCUMENT AND/OR THE INFORMATION THEREIN CONTAINED, IN WHOLE OR IN PART, OR TO SUFFER SUCH ACTION BY OTHERS, FOR ANY PURPOSE, EXCEPT WITH THE WRITTEN PERMISSION OF JOHNSON CONTROLS, INC. AND FURTHER AGREES TO SURRENDER SAME TO JOHNSON CONTROLS, INC. UPON DEMAND. COPYRIGHT JOHNSON CONTROLS, INC. 1998	DRAWING TITLE AIR HANDLING UNIT AHU-3 CLUB/SUITES QUAD C PRESS LEVEL QUAD C PROJECT TITLE BALTIMORE NFL STADIUM AT CAMDEN YARDS BALTIMORE, MARYLAND	<table border="1"> <tr> <td>AS-BUILT</td> <td>7/18/00</td> <td>CME</td> </tr> <tr> <td>REFERENCE DRAWING NO</td> <td>REVISION/DATE</td> <td>ECN</td> </tr> <tr> <td>State Engineer JDP</td> <td>Project Manager WJT</td> <td>Application Engineer RTS</td> </tr> <tr> <td>Drawn BY RTS</td> <td>DATE 08/28/97</td> <td>BY DATE</td> </tr> <tr> <td colspan="2"> </td> <td> CONTRACT NUMBER 7052-0098 DRAWING NUMBER BL-6559-07 </td> </tr> </table>	AS-BUILT	7/18/00	CME	REFERENCE DRAWING NO	REVISION/DATE	ECN	State Engineer JDP	Project Manager WJT	Application Engineer RTS	Drawn BY RTS	DATE 08/28/97	BY DATE			CONTRACT NUMBER 7052-0098 DRAWING NUMBER BL-6559-07
AS-BUILT	7/18/00	CME																
REFERENCE DRAWING NO	REVISION/DATE	ECN																
State Engineer JDP	Project Manager WJT	Application Engineer RTS																
Drawn BY RTS	DATE 08/28/97	BY DATE																
		CONTRACT NUMBER 7052-0098 DRAWING NUMBER BL-6559-07																

Full Spreadsheet		Software				Digital Controller Information					Panel Information				Intermediate Device				Field Device				Ref Detail	Comment			
Tag	Point Type	System Name	Object Name	Expanded ID	Display Units	DC Type	N2 Trunk	N2 Addr	Cable Destination Bay/Terminal	Module Type	Termination	Panel	Panel Location	Slot Number	Reference Drawing	Cable Number	Wiring/Tubing	Termination In	Device	Termination Out	Location	Wiring/Tubing	Terminations	Device	Location	Ref Detail	Comment
		AHU-3				AHU						EN-AHU-3	Press Lev MER C		IM-3-11												Power to Controller
		AHU-3				AHU						EN-AHU-3	Press Lev MER C		0IM-3-11												N2 Trunk
BO-1	AHU-3	MIN-DPR	Min OA Damper Control		Closed: Open	AHU		1BO-1				EN-AHU-3	Press Lev MER C		0IM-3-11	AH-1-BO-1		V11HGA-100			2/18	2-Wire	SAV-24VAC		A50		
BO-2	AHU-3	SF-C	Supply Fan Control		Off On	AHU		1BO-2	RLY	BO# 24V BICCM		EN-AHU-3	Press Lev MER C		0IM-3-11	AH-1-BO-2	3/18	A.COILS.COM RELAY-A	COM.NO		2/14	See starter detail	Starter (NO)		A53		
BO-3	AHU-3	RF-C	Return Fan Control		Off On	AHU		1BO-3	RLY	BO# 24V BICCM		EN-AHU-3	Press Lev MER C		0IM-3-11	AH-1-BO-3	3/18	B.COILS.COM RELAY-B	COM.NO		2/14	See starter detail	Starter (NO)		A53		
BO-4	AHU-3	CCP-C	Cig Coil Pump 3 Control		Off On	AHU		1BO-4	RLY	BO# 24V BICCM		EN-AHU-3	Press Lev MER C		0IM-3-11	AH-1-BO-4	3/18	A.COILS.COM RELAY-A	COM.NO		2/14	See starter detail	Starter (NO)		A50		
BO-5	AHU-3	TEF-C	Toilet Exh Fan Control		Off On	AHU		1BO-5		BO# 24V		EN-AHU-3	Press Lev MER C		0IM-3-11	AH-1-BO-5					2/18	Device dependent	24VAC OUT		A50		
BO-6	AHU-3					AHU		1BO-6				EN-AHU-3	Press Lev MER C		0IM-3-11	AH-1-BO-6											
BO-7	AHU-3					AHU		1BO-7				EN-AHU-3	Press Lev MER C		0IM-3-11	AH-1-BO-7											
BO-8	AHU-3					AHU		1BO-8				EN-AHU-3	Press Lev MER C		0IM-3-11	AH-1-BO-8											
BO-9	AHU-3					AHU		1BO-9				EN-AHU-3	Press Lev MER C		0IM-3-11	AH-1-BO-9											
BO-10	AHU-3					AHU		1BO-10				EN-AHU-3	Press Lev MER C		0IM-3-11	AH-1-BO-10											
AO-1	AHU-3	DPR-C	Damper Control		% Open	AHU		1AO-1		AO# ACCOM		EN-AHU-3	Press Lev MER C		0IM-3-11	AH-1-AO-1	2/18	+-	EP-8000-4	SUPPLY.O		1/4"	Barb Fitting	EP-PNEU.		A28	
AO-2	AHU-3	H-VLV	Heating Coil Valve		% Open	AHU		1AO-2		AO# ACCOM		EN-AHU-3	Press Lev MER C		0IM-3-11	AH-1-AO-2	2/18	+-	EP-8000-4	SUPPLY.O		1/4"	Barb Fitting	EP-PNEU.		A28	
AO-3	AHU-3	C-VLV	Cig Coil Valve		% Open	AHU		1AO-3		AO# ACCOM		EN-AHU-3	Press Lev MER C		0IM-3-11	AH-1-AO-3	2/18	+-	EP-8000-4	SUPPLY.O		1/4"	Barb Fitting	EP-PNEU.		A28	
AO-4	AHU-3	SF-VSD	Sup Fan Var Spd Drive		%	AHU		1AO-4		AO# ACCOM		EN-AHU-3	Press Lev MER C		0IM-3-11	AH-1-AO-4					2/18	Device dependent	0-20mA OUT		A21		
AO-5	AHU-3	RF-VSD	Ret Fan Var Spd Drive		%	AHU		1AO-5		AO# ACCOM		EN-AHU-3	Press Lev MER C		0IM-3-11	AH-1-AO-5					2/18	Device dependent	0-20mA OUT		A21		
AO-6	AHU-3					AHU		1AO-6				EN-AHU-3	Press Lev MER C		0IM-3-11	AH-1-AO-6											
BI-1	AHU-3	SF-S	Supply Fan Status		Off On	AHU		1BI-1		BI# BICCM		EN-AHU-3	Press Lev MER C		0IM-3-11	AH-1-BI-1					2/22	Device dependent	Aux Contact (NO)		A40		
BI-2	AHU-3	RF-S	Return Fan Status		Off On	AHU		1BI-2		BI# BICCM		EN-AHU-3	Press Lev MER C		0IM-3-11	AH-1-BI-2					2/22	Device dependent	Aux Contact (NO)		A40		
BI-3	AHU-3	SMK-DET	Smoke Detectors		Normal Alarm	AHU		1BI-3		BI# BICCM		EN-AHU-3	Press Lev MER C		0IM-3-11	AH-1-BI-3					2/22	Device dependent	Contact (NO)		A40		
BI-4	AHU-3	LT-S	Low Temperature Stat		Normal Alarm	AHU		1BI-4		BI# BICCM		EN-AHU-3	Press Lev MER C		0IM-3-11	AH-1-BI-4					2/22	INO M1	A70 (NO)		A41		
BI-5	AHU-3	CCP-S	Cig Coil Pump 3 Status		Off On	AHU		1BI-5		BI# BICCM		EN-AHU-3	Press Lev MER C		0IM-3-11	AH-1-BI-5					2/22	Device dependent	Aux Contact (NO)		A40		
BI-6	AHU-3	SA-HSP	Supply Air Static Press		Normal Alarm	AHU		1BI-6		BI# BICCM		EN-AHU-3	Press Lev MER C		0IM-3-11	AH-1-BI-6					2/22	Device dependent	AFS-460 & Relay		A40		
BI-7	AHU-3	RA-HSP	Return Air Static Press		Normal Alarm	AHU		1BI-7		BI# BICCM		EN-AHU-3	Press Lev MER C		0IM-3-11	AH-1-BI-7					2/22	Device dependent	AFS-460 & Relay		A40		
BI-8	AHU-3					AHU		1BI-8				EN-AHU-3	Press Lev MER C		0IM-3-11	AH-1-BI-8											
AI-1	AHU-3	RA-VP	Return Air Vel Pressure		In. w/g	AHU		1AI-1		AI# +VDC		EN-AHU-3	Press Lev MER C		0IM-3-11	AH-1-AI-1					2/18	+-	DPT-2641		A2		
AI-2	AHU-3	RA-T	Return Air Temperature		Dev F	AHU		1AI-2		AI# AICM		EN-AHU-3	Press Lev MER C		0IM-3-11	AH-1-AI-2					2/18	2-Wire	TE-6316P-1		A4		
AI-3	AHU-3	DA-T	Disch Air Temperature		Dev F	AHU		1AI-3		AI# AICM		EN-AHU-3	Press Lev MER C		0IM-3-11	AH-1-AI-3					2/18	2-Wire	TE-6316P-1		A4		
AI-4	AHU-3	MA-T	Mixed Air Temperature		Dev F	AHU		1AI-4		AI# AICM		EN-AHU-3	Press Lev MER C		0IM-3-11	AH-1-AI-4					2/18	2-Wire	TE-6316P-1		A4		
AI-5	AHU-3					AHU		1AI-5				EN-AHU-3	Press Lev MER C		0IM-3-11	AH-1-AI-5											
AI-6	AHU-3					AHU		1AI-6				EN-AHU-3	Press Lev MER C		0IM-3-11	AH-1-AI-6											
AI-7	AHU-3	S-SP	Supply Static Pressure		In. w/g	AHU		1AI-7		AI# +VDC		EN-AHU-3	Press Lev MER C		0IM-3-11	AH-1-AI-7					2/18	+-	DPT-2641		A2		
AI-8	AHU-3	S-VP	Supply Vel Pressure		In. w/g	AHU		1AI-8		AI# +VDC		EN-AHU-3	Press Lev MER C		0IM-3-11	AH-1-AI-8					2/18	+-	DPT-2641		A2		

Full Spreadsheet		Software				Digital Controller Information					Panel Information					Intermediate Device				Field Device							
Tag	Point Type	System Name	Object Name	Expanded ID	Display Units	DC Type	N2 Trunk	N2 Addr	Cable Destination Bqy/Terminal	Module Type	Termination	Panel	Panel Location	Slot Number	Reference Drawing	Cable Number	Wiring/Tubing	Termination In	Device	Termination Out	Location	Wiring/Tubing	Terminations	Device	Location	Ref Detail	Comment
		HEATING				VAV						EN-DPS-3	Press Lav MER C														Power to Controller
		HEATING				VAV		2				EN-DPS-3	Press Lav MER C	0													N2 Trunk
AI-1	HEATING	HWS3-T	HW Sup Temp At AHU-3	Diag F		VAV	1	2	AI-1	AI4,AICM		EN-DPS-3	Press Lav MER C	0		DPS-2-AI-1					2/18	2-Wire	TE-631AP-1	U1			
AI-2	HEATING	HWS3-DP	HW Diff Press At AHU-3	PSI		VAV	1	2	AI-2	AI4,AICM,+15VDC		EN-DPS-3	Press Lav MER C	0		DPS-2-AI-2					3/18	Device dependent	Rco/Hal 252C	U5			4-20ma with 500 OHM Resistor
AI-3	COOLING	CHS3-T	CW Sup Temp At AHU-3	Diag F		VAV	1	2	AI-3	AI4,AICM		EN-DPS-3	Press Lav MER C	0		DPS-2-AI-3					2/18	2-Wire	TE-631AP-1	U1			
AI-4	COOLING	CHW3-DP	CW Diff Press At AHU-3	PSI		VAV	1	2	AI-4	AI4,AICM,+15VDC		EN-DPS-3	Press Lav MER C	0		DPS-2-AI-4					3/18	Device dependent	Rob/Hal 252C	U5			4-20ma with 500 OHM Resistor
AI-5	HEATING					VAV	1	2	AI-5			EN-DPS-3	Press Lav MER C	0		DPS-2-AI-5											
AI-6	HEATING					VAV	1	2	AI-6			EN-DPS-3	Press Lav MER C	0		DPS-2-AI-6											
BI-1	HEATING					VAV	1	2	BI-1			EN-DPS-3	Press Lav MER C	0		DPS-2-BI-1											
BI-2	HEATING					VAV	1	2	BI-2			EN-DPS-3	Press Lav MER C	0		DPS-2-BI-2											
BI-3	HEATING					VAV	1	2	BI-3			EN-DPS-3	Press Lav MER C	0		DPS-2-BI-3											
BI-4	HEATING					VAV	1	2	BI-4			EN-DPS-3	Press Lav MER C	0		DPS-2-BI-4											
BO-1	HEATING					VAV	1	2	BO-1			EN-DPS-3	Press Lav MER C	0		DPS-2-BO-1											
BO-2	HEATING					VAV	1	2	BO-2			EN-DPS-3	Press Lav MER C	0		DPS-2-BO-2											
BO-3	HEATING					VAV	1	2	BO-3			EN-DPS-3	Press Lav MER C	0		DPS-2-BO-3											
BO-4	HEATING					VAV	1	2	BO-4			EN-DPS-3	Press Lav MER C	0		DPS-2-BO-4											
BO-5	HEATING					VAV	1	2	BO-5			EN-DPS-3	Press Lav MER C	0		DPS-2-BO-5											
BO-6	HEATING					VAV	1	2	BO-6			EN-DPS-3	Press Lav MER C	0		DPS-2-BO-6											
AO-1	HEATING					VAV	1	2	AO-1			EN-DPS-3	Press Lav MER C	0		DPS-2-AO-1											
AO-2	HEATING					VAV	1	2	AO-2			EN-DPS-3	Press Lav MER C	0		DPS-2-AO-2											

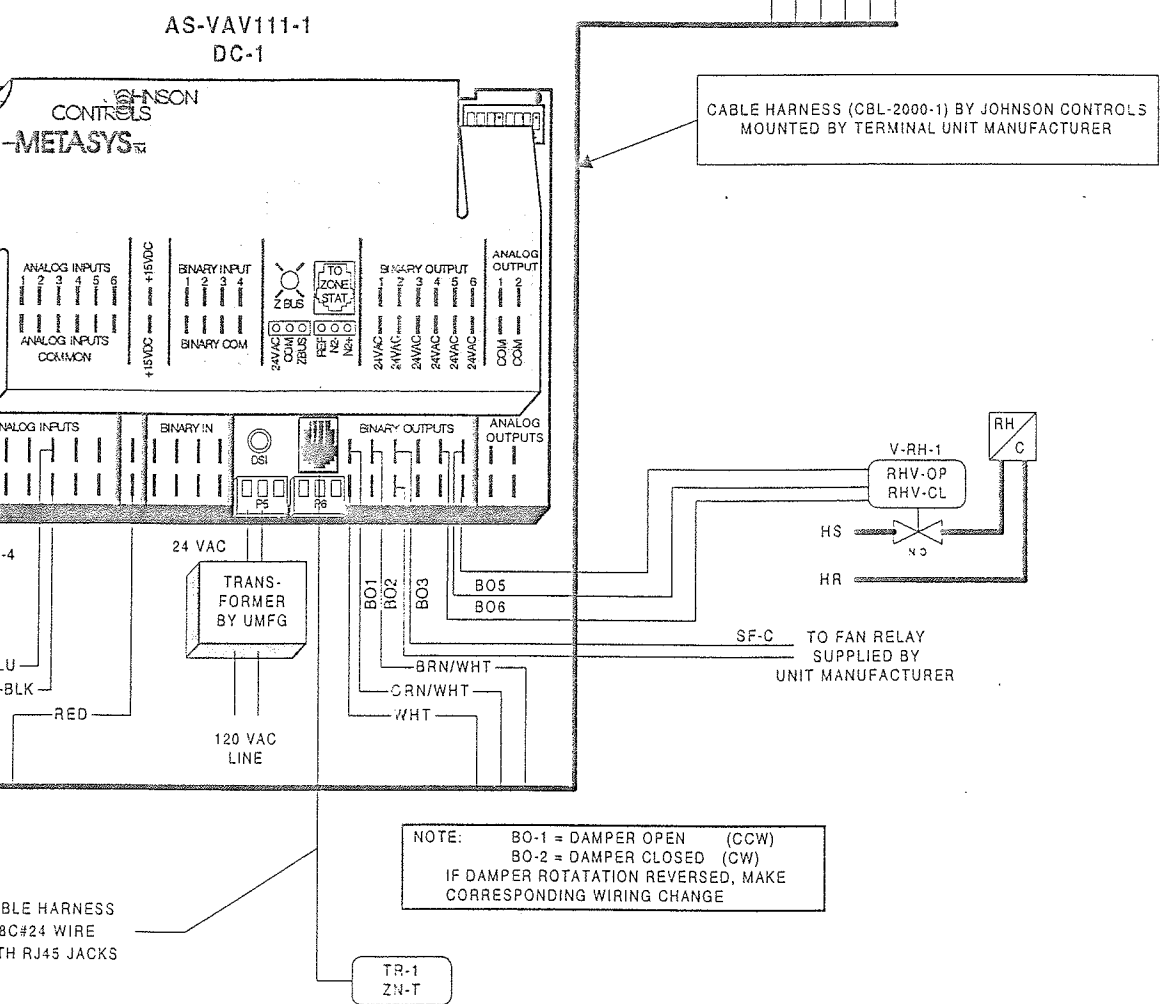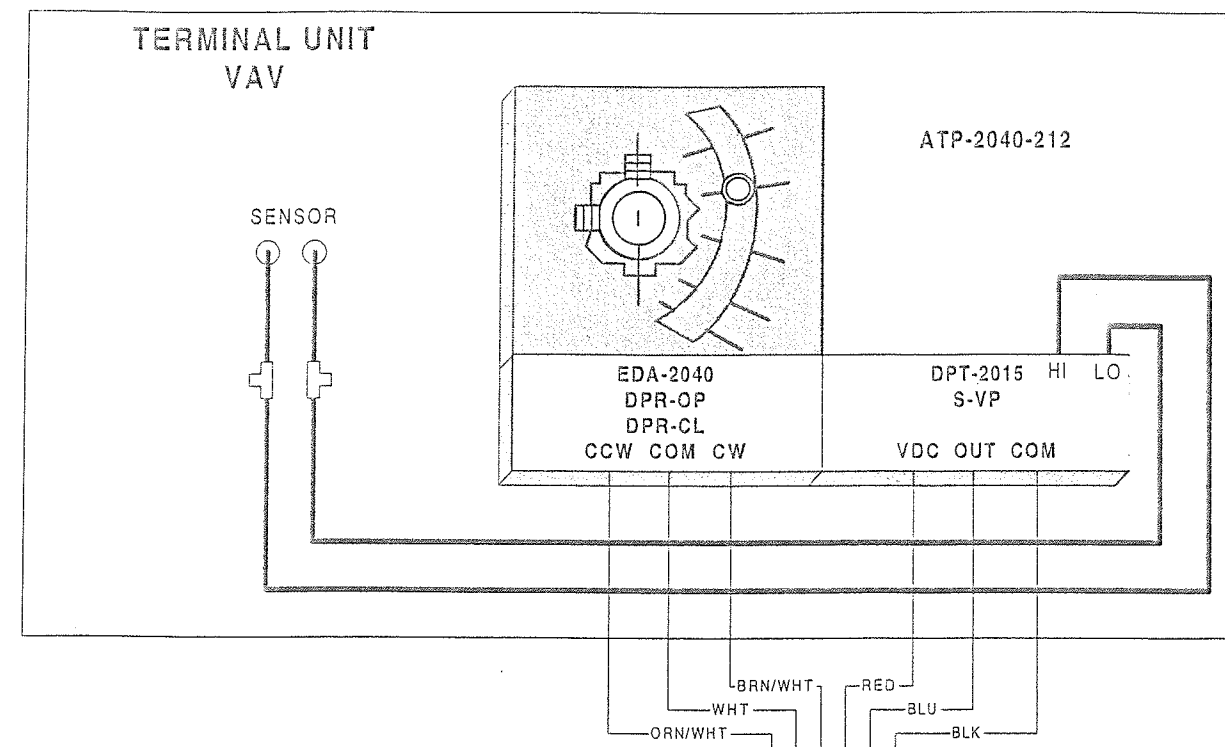


NOTE: BO-1 = DAMPER OPEN (CCW)
BO-2 = DAMPER CLOSED (CW)
IF DAMPER ROTATION REVERSED, MAKE
CORRESPONDING WIRING CHANGE

CABLE HARNESS
8C#24 WIRE
WITH RJ45 JACKS

BILL OF MATERIALS

Estimate: quad c vavbox 70520098.pre

Desig.	Qty	Part #	Description
Field Devices:			
DC-1	60	AS-VAV110-1	VAV 6AI, 4BI, 8BO, 8K
V-RH-1	60	--	SEE VALVE SCHEDULE
VAV	60	ATP-2040-212	ACT 2MIN+1.5"DP, 1/2"CPLG
ZN-T	38	TE-6410W-1000	MSTR&T, NI, BOX, JACK

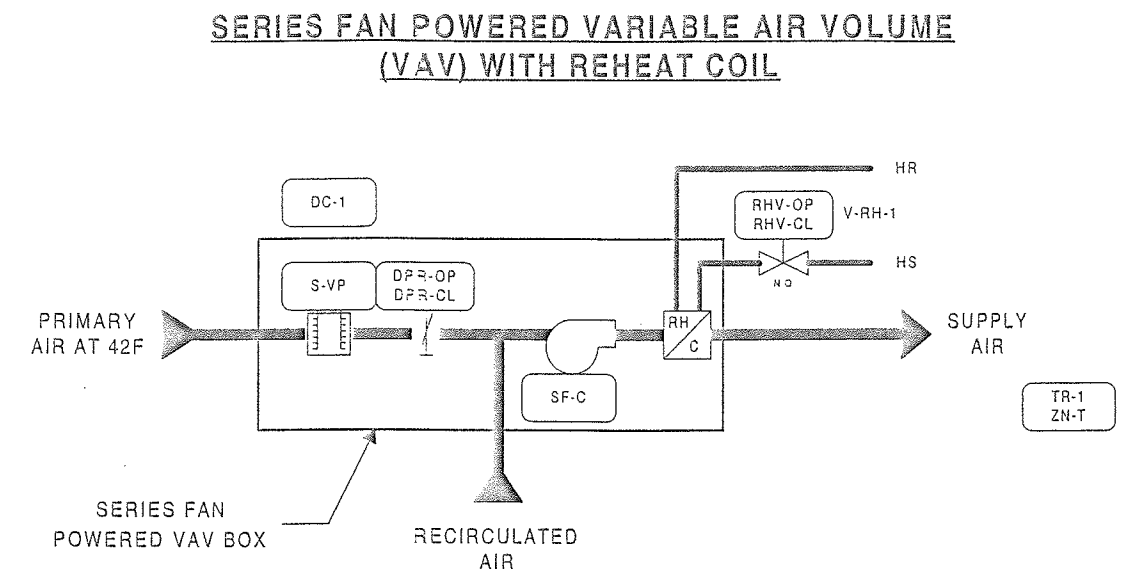


**NOTE: VAV CONTROLLER (AS-VAV111-1)
DAMPER ACTUATOR & DIFFERENTIAL PRESSURE
TRANSMITTER (ATP-2040-212)
ARE FACTORY MOUNTED BY TITUS**

DESCRIPTION OF OPERATION

PRIMARY AIR VALVE WILL OPEN TO THEIR MINIMUM POSITION AND TERMINAL UNIT FAN WILL START AND RUN CONTINUOUSLY WHENEVER AIR HANDLING UNIT IS RUNNING. TERMINAL UNIT FANS WILL START THIRTY (30) SECONDS BEFORE OPENING OF AIR VALVES TO PREVENT BACK SPINNING OF FAN. FANS WILL ALSO BE OPERATED AS DEFINED IN THE UNOCCUPIED MODES. PRIMARY AIR VALVES WILL BE CLOSED DURING UNOCCUPIED HEATING MODE. ROOM SENSOR TR-1 WILL ON A RISE IN TEMPERATURE GRADUALLY MODULATE REHEAT COIL VALVE V-RH-1 CLOSED AND ON A CONTINUED RISE WILL GRADUALLY MODULATE PRIMARY AIR VALVE FROM IT'S MINIMUM TO MAXIMUM SETTING TO MAINTAIN IT'S SETTING OF SEVENTY-FIVE (75F). ON A FALL IN TEMPERATURE, THIS CYCLE IS REVERSED. DURING OPERATION OF THE WARM-UP MODE ALL PRIMARY AIR VALVES OPEN TO THEIR MAXIMUM POSITION AND TERMINAL FANS START TO PERMIT FULL AIR FLOW TO THE SPACES. REHEAT COIL VALVE V-RH-1 IS MODULATED IN RESPONSE TO ROOM SENSOR TO MAINTAIN SPACE TEMPERATURE.

REVISION INFORMATION	IN CONSIDERATION OF THE RECEIPT OF THIS DOCUMENT, THE RECIPIENT AGREES NOT TO REPRODUCE, COPY, USE OR TRANSMIT THIS DOCUMENT AND/OR THE INFORMATION THEREIN CONTAINED, IN WHOLE OR IN PART, OR TO SUFFER SUCH ACTION BY OTHERS, FOR ANY PURPOSE, EXCEPT WITH THE WRITTEN PERMISSION OF JOHNSON CONTROLS, INC. AND FURTHER AGREES TO SURRENDER SAME TO JOHNSON CONTROLS, INC. UPON DEMAND.	DRAWING TITLE	AS-BUILT	
NUMBER		FAN POWERED TERMINAL REHEAT UNITS	7/18/00 CME	
DATE	QUAD C	REFERENCE DRAWING NO.	REVISION LOCATION	ECN
TIME	BALTIMORE NFL STADIUM AT CAMDEN YARDS	Sales Engineer	Project Manager	Application Engineer
FILE NAME	BALTIMORE, MARYLAND	JDP	WJT	RTS
		DRAWN BY RTS DATE 08/28/97		APPROVED BY DATE
		Branch Information		CONTRACT NUMBER
		JOHNSON CONTROLS Controls Group		7052-0098
		Johnson Controls, Inc. 60 Loveton Circle Sparks, MD 21152		DRAWING NUMBER BL-6559-08

Full Spreadsheet		Software				Digital Controller Information						Panel Information				Intermediate Device				Field Device				Ref Detail	Comment		
Tag	Point Type	System Name	Object Name	Expanded ID	Display Units	DC Type	N2 Trunk	N2 Addr	Cable Destination Bay/Terminal	Module Type	Termination	Panel	Panel Location	Slot Number	Reference Drawing	Cable Number	Wiring/Tubing	Termination In	Device	Termination Out	Location	Wiring/Tubing	Terminations	Device	Location	Ref Detail	Comment
		FP-VAV-C				VAV																					Power to Controller N2 Trunk
		FP-VAV-C				VAV	1	X						0													
AI-1		FP-VAV-C	ZN-T	Zone Temperature	Deg F	VAV	1	X	AI-1		PHONE JACK			0		FPVAV-x-AI-1					8/26	PHONE JACK	Metastat-Ph Jack			U2	
AI-2		FP-VAV-C				VAV	1	X	AI-2					0		FPVAV-x-AI-2											
AI-3		FP-VAV-C				VAV	1	X	AI-3					0		FPVAV-x-AI-3											
AI-4		FP-VAV-C	S-VP	Supply Vel Pressure	in. Wg	VAV	1	X	AI-4		AI#_AICM,+15VDC			0		FPVAV-x-AI-4					3/18	OUT.COM,+VDC	DPT-2000			U9	
AI-5		FP-VAV-C				VAV	1	X	AI-5					0		FPVAV-x-AI-5											
AI-6		FP-VAV-C				VAV	1	X	AI-6					0		FPVAV-x-AI-6											
BI-1		FP-VAV-C				VAV	1	X	BI-1					0		FPVAV-x-BI-1											
BI-2		FP-VAV-C				VAV	1	X	BI-2					0		FPVAV-x-BI-2											
BI-3		FP-VAV-C				VAV	1	X	BI-3					0		FPVAV-x-BI-3											
BI-4		FP-VAV-C				VAV	1	X	BI-4					0		FPVAV-x-BI-4											
BO-1		FP-VAV-C	DPR-OP	Damper Open	C# On	VAV	1	X	BO-1		BO-a,BO-b,24VAC			0		FPVAV-x-BO-1					3/18	CW,CCW,COM	EDA-2040			U54	
BO-2		FP-VAV-C	DPR-CL	Damper Close	C# On	VAV	1	X	BO-2		BO-a,BO-b,24VAC			0		FPVAV-x-BO-2					3/18	CW,CCW,COM	EDA-2040			U54	
BO-3		FP-VAV-C	SF-C	Supply Fan Control	C# On	VAV	1	X	BO-3		BO#_24VAC			0		FPVAV-x-BO-3	2/18	COIL	RELAY	NO,CCM	2/14	See starter detail	Starter (NO)			U51	
BO-4		FP-VAV-C				VAV	1	X	BO-4					0		FPVAV-x-BO-4											
BO-5		FP-VAV-C	RHV-OP	Reheat Valve Open	C# On	VAV	1	X	BO-5		BO-a,BO-b,24VAC			0		FPVAV-x-BO-5					3/18	BLK,RED,WHT	VA-7150			U58	
BO-6		FP-VAV-C	RHV-CL	Reheat Valve Close	C# On	VAV	1	X	BO-6		BO-a,BO-b,24VAC			0		FPVAV-x-BO-6					3/18	BLK,RED,WHT	VA-7150			U58	
AO-1		FP-VAV-C				VAV	1	X	AO-1					0		FPVAV-x-AO-1											
AO-2		FP-VAV-C				VAV	1	X	AO-2					0		FPVAV-x-AO-2											

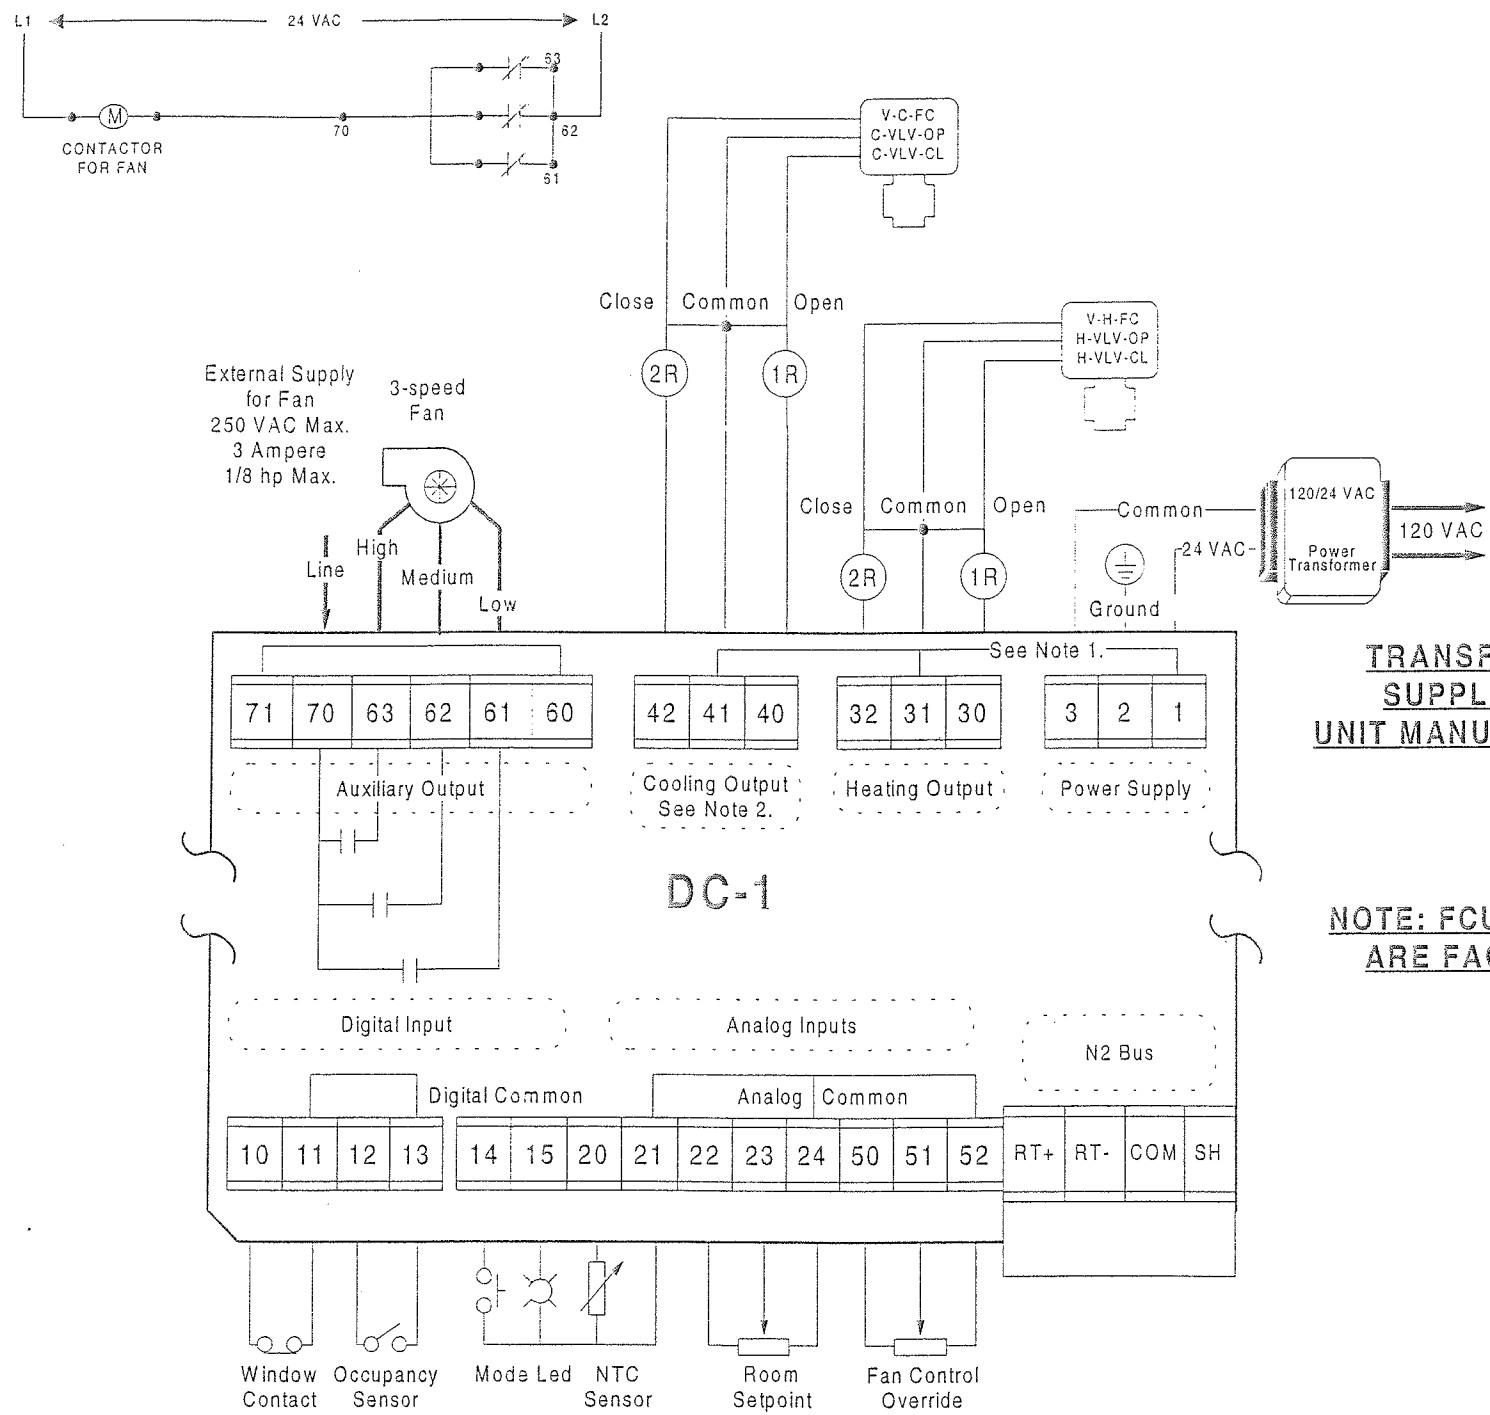

Note 1: For PAT, DAT, and On-Off outputs, terminals 1, 31, and 41 are internally connected.


**TRANSFORMER
SUPPLIED BY
UNIT MANUFACTURER**

**NOTE: FCU CONTROLLER (TC-9102-0322)
ARE FACTORY MOUNTED BY TRANE**

BILL OF MATERIALS

Estimate: quad c fcu 70520098.pre

Desig.	Qty	Part #	Description
Field Devices:			
DC-1	27	TC-9102-0322	FAN CONTROLLER-SPEED 2-STG H/C
HWS-DP,	2	C-252	DELTA TRANS ROB/HALP
CHWS-DP			
HWS5-T,	2	TE-631AP-1	SENS, T-NI, 0.1%, F/WZ1000-5
CHS5-T			
	2	WZ-1000-5	WELL, BRASS, 1/2"NPT+COMPND
V-H-FC,	54	--	SEE VALVE SCHEDULE
V-C-FC			
ZN-T	27	TM-9161-5002	MSIAT F/TC-9100 55-85F FSC

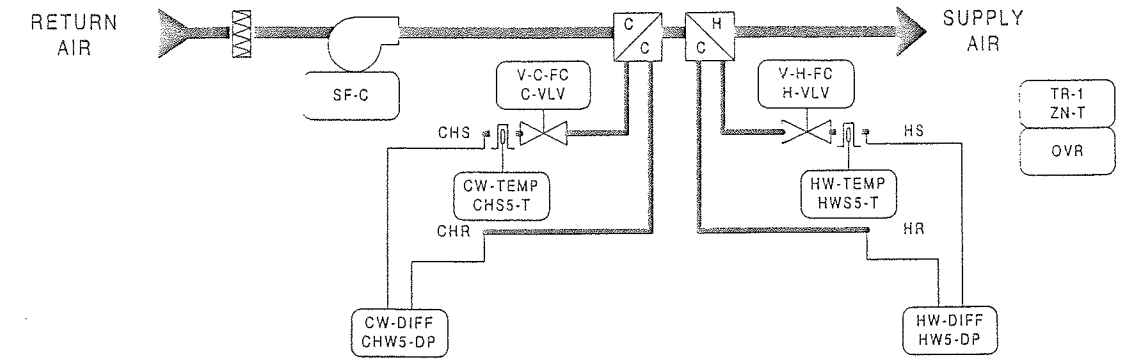

**NOTE: HW & CW TEMPS & DIFF PRESSURE
(4) POINTS ARE IN ENCLOSURE EN-DPS
AS-VAV111-1 (NCM-3/N2 ADD = 3)
LOCATE ON UPPER SUITE LEVEL**

DESCRIPTION OF OPERATION

THE METASYS SYSTEM WILL DETERMINE THE "OCCUPIED AND UNOCCUPIED" MODES OF OPERATION. OCCUPIED MODE GENERALLY OCCURS DURING THE NORMAL WORK WEEK AND STADIUM EVENTS, BUT MANUAL OVERRIDE THROUGH THE METASYS SYSTEM ON INDIVIDUAL UNITS WILL FREQUENTLY BE REQUIRED. SUITE OWNERS WILL HAVE THE ABILITY TO UTILIZE SUITES FOR PRIVATE FUNCTIONS AT ANYTIME. WHEN FAN COIL UNITS ARE DE-ENERGIZED, COOLING COIL VALVE V-C-FC AND HEATING COIL VALVE V-H-FC WILL BE CLOSED TO COILS.

OCCUPIED MODE - FAN COIL UNIT SUPPLY FAN WILL BE STARTED THROUGH ITS FAN SPEED SWITCH AND RUN CONTINUOUSLY. STARTING OF THE FAN COIL UNIT WILL INITIATE THE START OF THE RELATED EXHAUST FAN. THE EXHAUST AIR VOLUME INDUCES THE NATURAL VENTILATION OF THE SUITE AND MUST THEREFORE BE ENERGIZED WHENEVER THE SUITE IS OCCUPIED. ROOM SENSOR TR-1 WILL MODULATE HEATING COIL VALVE V-H-FC AND COOLING COIL VALVE V-C-FC IN SEQUENCE TO MAINTAIN ITS SETTING OF SEVENTY-FIVE (75F).


UNOCCUPIED MODE - ROOM SENSOR TR-1 WILL ON A FALL IN TEMPERATURE TO ITS SETTING OF FIFTY (50F) ACTIVATE SYSTEM TO RUN IN THE OCCUPIED MODE AS HEREINBEFORE DESCRIBED. ON A RISE IN TEMPERATURE TO FIFTY-FIVE (55F), FAN COIL UNIT WILL BE DE-ENERGIZED AND HEATING COIL VALVE WILL CLOSE.

REVISION INFORMATION	IN CONSIDERATION OF THE RECEIPT OF THIS DOCUMENT, THE RECIPIENT AGREES NOT TO REPRODUCE, COPY, USE OR TRANSMIT THIS DOCUMENT AND/OR THE INFORMATION THEREIN CONTAINED, IN WHOLE OR IN PART, OR TO SUFFER SUCH ACTION BY OTHERS, FOR ANY PURPOSE, EXCEPT WITH THE WRITTEN PERMISSION OF JOHNSON CONTROLS, INC. AND FURTHER AGREES TO SURRENDER SAME TO JOHNSON CONTROLS, INC. UPON DEMAND. COPYRIGHT JOHNSON CONTROLS, INC. 1998	DRAWING TITLE	SUITE FAN COIL UNITS		DATE	7/18/00	BY	CME	
NUMBER		QUAD C	AS-BUILT		ECN				
DATE		07/18/00	PROJECT TITLE	BALTIMORE NFL STADIUM AT CAMDEN YARDS		REFERENCE DRAWING	NO	REVISION LOCATION	
TIME		03:04 PM		BALTIMORE, MARYLAND		Salas Engineer	JDP	Project Manager	WJT
FILE NAME		FANCOILC.vsd				Application Engineer	RTS	DRAWN	BY
							DATE	08/28/97	
							BY	DATE	
							CONTRACT NUMBER	7052-0098	
							DRAWING NUMBER	BL-6559-09	
							Johnson Controls, Inc.		
							60 Loveton Circle		
							Sparks, MD 21152		



Full Spreadsheet		Software				Digital Controller Information					Panel Information					Intermediate Device				Field Device			Ref Detail	Comment				
Tag	Point Type	System Name	Object Name	Expanded ID	Display Units	DC Type	N2 Trunk	N2 Addr	Cable Destination Bay/Termincl	Module Type	Termination	Panel	Panel Location	Slot Number	Reference Drawing	Cable Number	Wiring/Tubing	Termination In	Device	Termination Out	Location	Wiring/Tubing	Terminations	Device	Location	Ref Detail	Comment	
		FCU-C				TC						EN-FCU	AT FOU														Power to Controller	
		FCU-C				TC		Y				EN-FCU	AT FOU	0													N2 Trunk	
BO-1		FCU-C	H-VLV-OP	Htg Valve Open	Off On	TC		Y	YIBO-1		32.31.COM.30	EN-FCU	AT FOU	0		FCU-x-BO-1					3/18	BLK,WHT,RED	VA-7150 (Heating)					
BO-2		FCU-C	H-VLV-CL	Htg Valve Close	Off On	TC		Y	YIBO-2		32.31.COM.30	EN-FCU	AT FOU	0		FCU-x-BO-2					3/18	BLK,WHT,RED	VA-7150 (Heating)					
BO-3		FCU-C	C-VLV-OP	Ctg Valve Open	Off On	TC		Y	YIBO-3		42.41.COM.40	EN-FCU	AT FOU	0		FCU-x-BO-3					3/18	BLK,WHT,RED	VA-7150 (Cooling)					
BO-4		FCU-C	C-VLV-CL	Ctg Valve Close	Off On	TC		Y	YIBO-4		42.41.COM.40	EN-FCU	AT FOU	0		FCU-x-BO-4					3/18	BLK,WHT,RED	VA-7150 (Cooling)					
BO-5		FCU-C	F-SPD-1	Fan (Speed 1)	Off On	TC		Y	YIBO-5		71.70 LINE/63.62.6	EN-FCU	AT FOU	0		FCU-x-BO-5					4/14	HI,MED,LOW,NEU	Starter Coil (3 spd fan)					
BO-6		FCU-C	F-SPD-2	Fan (Speed 2)	Off On	TC		Y	YIBO-6		71.70 LINE/63.62.6	EN-FCU	AT FOU	0		FCU-x-BO-6					4/14	HI,MED,LOW,NEU	Starter Coil (3 spd fan)					
BO-7		FCU-C	F-SPD-3	Fan (Speed 3)	Off On	TC		Y	YIBO-7		71.70 LINE/63.62.6	EN-FCU	AT FOU	0		FCU-x-BO-7					4/14	HI,MED,LOW,NEU	Starter Coil (3 spd fan)					
BI-1		FCU-C				TC		Y	YIBI-1			EN-FCU	AT FOU	0		FCU-x-BI-1												
BI-2		FCU-C				TC		Y	YIBI-2			EN-FCU	AT FOU	0		FCU-x-BI-2												
BI-3		FCU-C				TC		Y	YIBI-3			EN-FCU	AT FOU	0		FCU-x-BI-3												
AI-1		FCU-C	ZN-T	Zone Temperature	Deg F	TC		Y	YIAI-1		14 MODE,15 LED.2	EN-FCU	AT FOU	0		FCU-x-AI-1					3/22	14 MODE,15 LED	TM-9100 (Mode & LED)					
AI-2		FCU-C	ZN-SET	Zone Temp Set Point	Deg F	TC		Y	YIAI-2		22.23,21/24	EN-FCU	AT FOU	0		FCU-x-AI-2					3/22	22.23,21/24	TM-9100 (Setpoint)					
AI-4		FCU-C	OVR	Fan Override	Lo-Md-Hi	TC		Y	YIAI-4		51.21/24	EN-FCU	AT FOU	0		FCU-x-AI-4					2/22	51,21/24	TM-9100 (Fan Override)					

Full Spreadsheet		Software				Digital Controller Information					Panel Information				Intermediate Device				Field Device									
Tag	Point Type	System Name	Object Name	Expanded ID	Display Units	DC Type	N2 Trunk	N2 Addr	Cable Destination 8av/Terminal	Module Type	Termination	Panel	Panel Location	Slot Number	Reference Drawing	Cable Number	Wiring/Tubing	Termination In	Device	Termination Out	Location	Wiring/Tubing	Terminations	Device	Location	Ref Detail	Comment	
		HEATING				VAV						EN-DPS	Upper Suite Level														Power to Controller	
		HEATING				VAV						EN-DPS	Upper Suite Level	01													N2 Trunk	
AI-1	HEATING	HWSS-T	HW Sup Temp At FCU	Deg F		VAV	1	3	AI-1	AI4,AICM		EN-DPS	Upper Suite Level	01		DPS-3-AI-1					2/18	2-Wire	TE-631AP-1	U1				
AI-2	HEATING	HW5-DP	HW Diff Press At FCU	PSI		VAV	1		AI-2	AI4,AICM,+15VDC		EN-DPS	Upper Suite Level	01		DPS-3-AI-2					3/18	Device dependent	Rob/Hal 252C	U5			4-20ma with 500 OHM Resistor	
AI-3	COOLING	CHSS-T	CW Sup Temp At FCU	Deg F		VAV	1		AI-3	AI4,AICM		EN-DPS	Upper Suite Level	01		DPS-3-AI-3					12/18	2-Wire	TE-631AP-1	U1				
AI-4	COOLING	CHWS-DP	CW Diff Press At FCU	PSI		VAV	1		AI-4	AI4,AICM,+15VDC		EN-DPS	Upper Suite Level	01		DPS-3-AI-4					3/18	Device dependent	Rob/Hal 252C	U5			4-20ma with 500 OHM Resistor	
AI-5	HEATING					VAV	1		AI-5			EN-DPS	Upper Suite Level	01		DPS-3-AI-5												
AI-6	HEATING					VAV	1		AI-6			EN-DPS	Upper Suite Level	01		DPS-3-AI-6												
BI-1	HEATING					VAV	1		BI-1			EN-DPS	Upper Suite Level	01		DPS-3-BI-1												
BI-2	HEATING					VAV	1		BI-2			EN-DPS	Upper Suite Level	01		DPS-3-BI-2												
BI-3	HEATING					VAV	1		BI-3			EN-DPS	Upper Suite Level	01		DPS-3-BI-3												
BI-4	HEATING					VAV	1		BI-4			EN-DPS	Upper Suite Level	01		DPS-3-BI-4												
BO-1	HEATING					VAV	1		BO-1			EN-DPS	Upper Suite Level	01		DPS-3-BO-1												
BO-2	HEATING					VAV	1		BO-2			EN-DPS	Upper Suite Level	01		DPS-3-BO-2												
BO-3	HEATING					VAV	1		BO-3			EN-DPS	Upper Suite Level	01		DPS-3-BO-3												
BO-4	HEATING					VAV	1		BO-4			EN-DPS	Upper Suite Level	01		DPS-3-BO-4												
BO-5	HEATING					VAV	1		BO-5			EN-DPS	Upper Suite Level	01		DPS-3-BO-5												
BO-6	HEATING					VAV	1		BO-6			EN-DPS	Upper Suite Level	01		DPS-3-BO-6												
AO-1	HEATING					VAV	1		AO-1			EN-DPS	Upper Suite Level	01		DPS-3-AO-1												
AO-2	HEATING					VAV	1		AO-2			EN-DPS	Upper Suite Level	01		DPS-3-AO-2												

Design	Qty	Part #	Description
Field Devices:			
D-4-1A, D-4-1B1	---	---	SEE DAMPER SCHEDULE
D-4-2, D-4-3	---	---	---
DPR-C	3	D-3153-1	DMPR ACT, 3-13#, W/PILOT
DPR-C, MIN-DPR2	2	D-3153-2	DMPR ACT, 3-13#
FE-4	5	G-2010-11	GAGE, 2", 0-30 PSIG, STEM
H-VLV, C-VLV	1	A70HA-1C	STAT, LL, 20", EL. MAN, 15/55F
HV4-DP, CH4-DP2	1	C-252	DELTA TRANS RCB/HALP
HWS4-T, CHS4-T2	2	TE-611AP-1	SENS, T-NI, 0.1#, 5"/WZ1000-5
MA-T, DA-T	2	WZ-1000-5	WELL, BRASS, 1/2" NPT, COMPND
RA-T	3	TE-611SP-1	SENS, T-NI, 0.1#, 17" AVG
RA-VP	1	DPT-2641-2	XDUCR DP 0/0.25" 4-20ma
S-SP	1	DPT-2641-7	XDUCR DP 0/10.0" 4-20ma
SA-HSP, RA-HSP2	2	AFS-150	DUCT AIR FLOW HIGH STATIC
SA-VP	1	DPT-2641-5	XDUCR DP 0/2.5" 4-20ma
SPC-4-1	1	R-317-1	CTRLR DP, 0.05-1" WG
T-3	1	T-3610-1001	STAT, LOW VOL, 3" AVG, DCT
TEF	5	BZ-1260-11	ENCL, 4-5/SX 5-1/8 X 3-3/8
	5	PD-101-35	RLY BASE, 3PDT, 11PIN, 10A
	5	PD-109-51	RELAY PLUG-IN 3PDT 24VAC
Panel Devices:			
EN-AHU-4	1	AS-AHU103-300	AHU TERM BD IN EMC35
	1	EN-EXP101-J	UNIV PKG MOD, CUR & BACKBN
EP-1, 2, 3	3	EP-3000-4	XDUCR, EP, 4-20ma, HI VOL
EP-4	1	V11HGA-100	1-W SOLENOID, W/OV, 24 VAC
PC-1, 2, 3, 4	4	G-2010-11	GAGE, 2", 0-30 PSIG, STEM
RLY-1, 2	2	AS-RLY002-0	RELAY, 2SPDT 5 AMP 240VAC
SA, RA	2	PD-111-35	RLY BASE, 3PDT, 11PIN, 10A
	2	PD-109-51	RELAY PLUG-IN 3PDT 24VAC

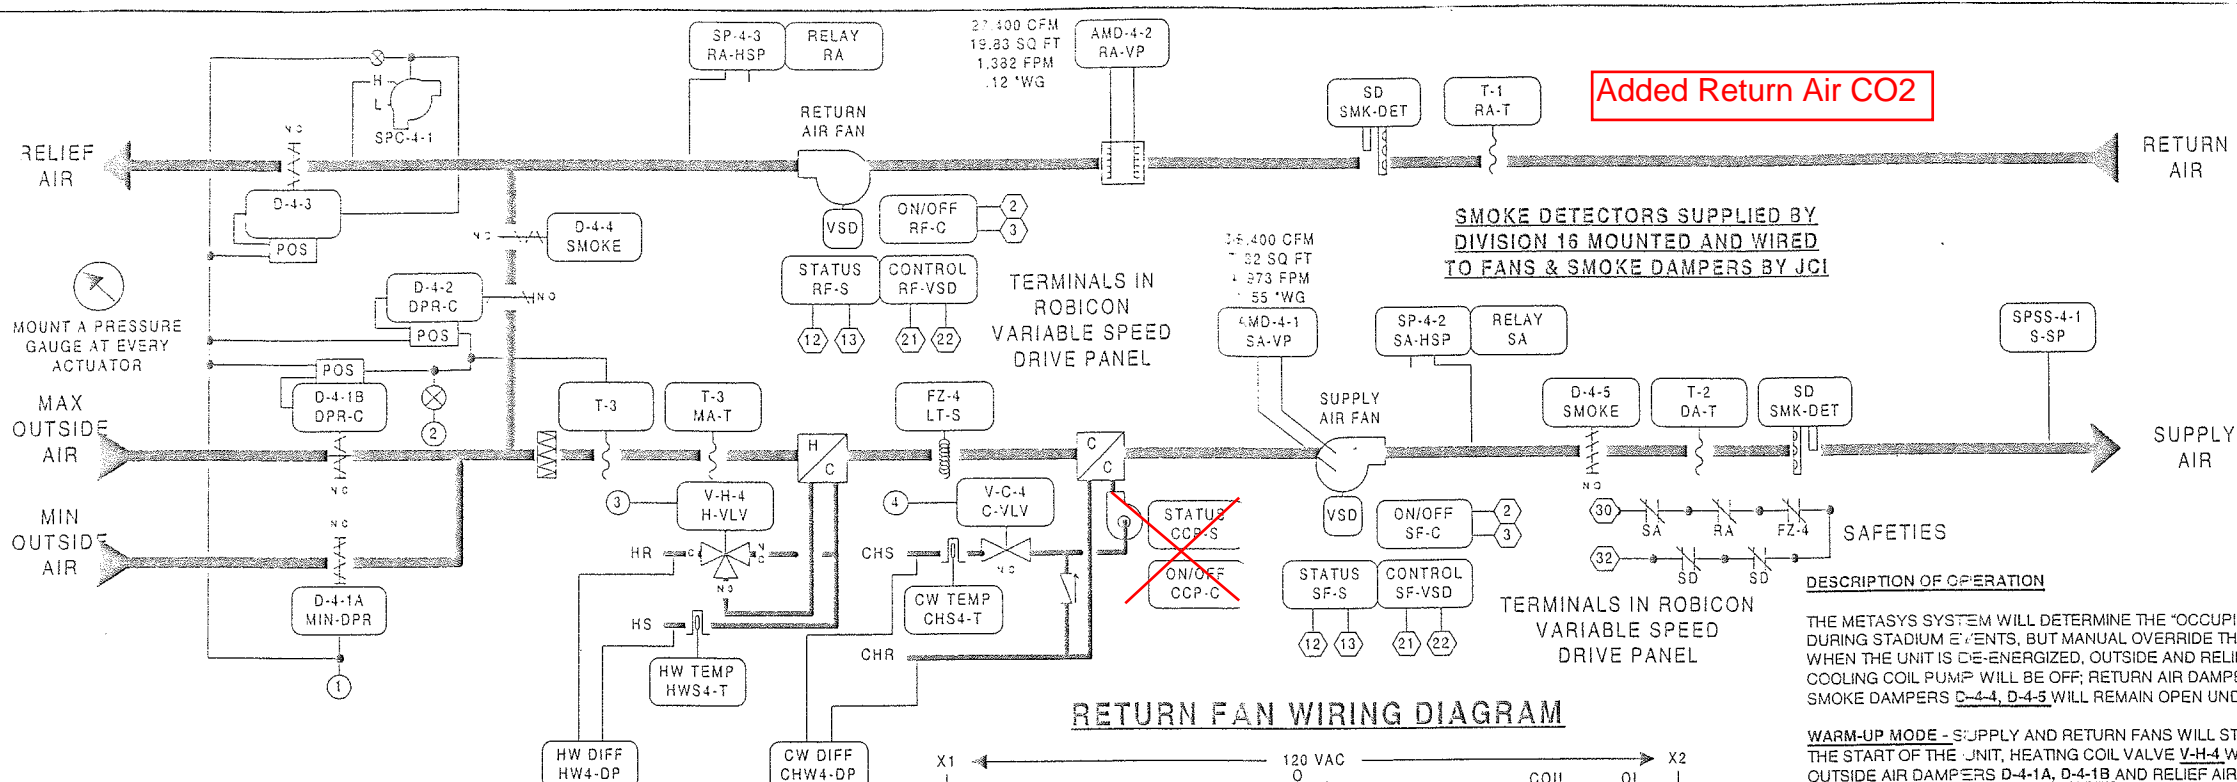


NOTE: HW & CW TEMPS & DIFF PRESSURE (4) POINTS ARE IN ENCLOSURE EN-DPS-4 AS-VAV111-1 (NCM-4/N2 ADD = 2)

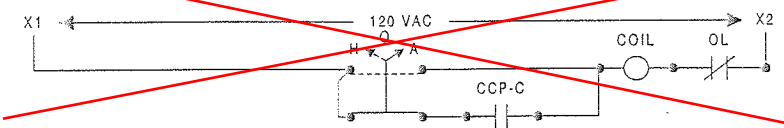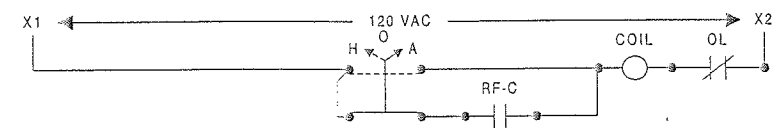


FAN	LOCATION	ELEC PANEL	CIRCUIT	LOCATION
TEF-D6	ROOF	STARTER		UP CONCOURSE
TEF-D7	ROOF	RPUCD	21	UP CONCOURSE
TEF-D8	ROOF	RPUCD	11	UP CONCOURSE
TEF-D9	ROOF	RPUCD	17	UP CONCOURSE
TEF-D11	ROOF	RPUCD	7	UP CONCOURSE
TEF-D15	CLUB LEVEL	RP2CLD	11	CLUB LEVEL
TEF-D17	UPPER SUITE	RPUSC	33	UPPER SUITE

CONTROLLED FROM MAU PANEL LOCATED ON UPPER CONCOURSE

USE (5) PD-109-51 & (5) PD-101-35 AT (5) PANEL/STARTER LOCATIONS

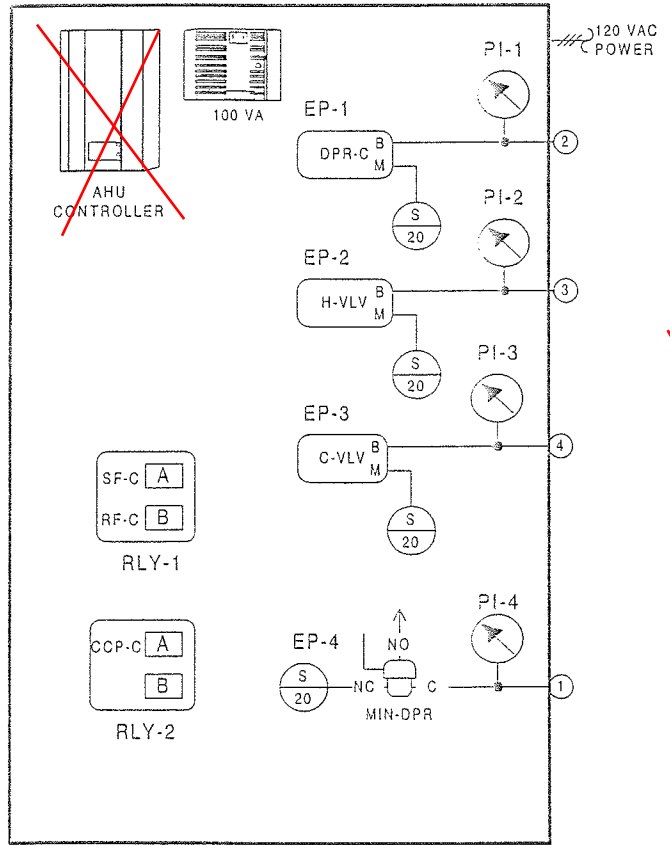

SEE BL-6559-01A FOR ADDITIONAL WIRING DETAIL

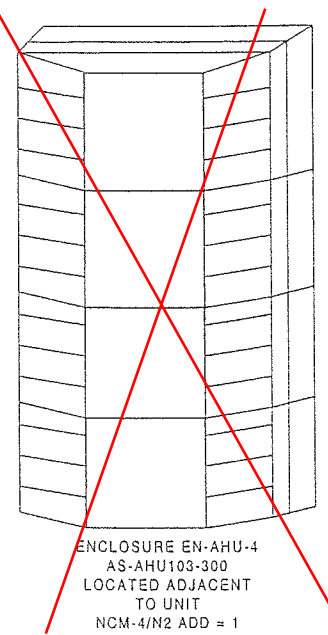

THE METASYS SYSTEM WILL DETERMINE THE "OCCUPIED AND UNOCCUPIED" MODES OF OPERATION. OCCUPIED MODES GENERALLY OCCUR DURING STADIUM EVENTS, BUT MANUAL OVERRIDE THROUGH THE METASYS SYSTEM ON SELECTED UNITS WILL FREQUENTLY BE REQUIRED. WHEN THE UNIT IS DE-ENERGIZED, OUTSIDE AIR DAMPERS D-4-1A, D-4-1B, D-4-3 AND COOLING COIL VALVE V-C-4 WILL CLOSE; COOLING COIL PUMP WILL BE OFF; RETURN AIR DAMPER D-4-2 WILL BE OPEN AND HEATING COIL VALVE V-H-4 WILL BE CLOSED TO THE COIL. SMOKE DAMPERS D-4-4, D-4-5 WILL REMAIN OPEN UNDER CONTROL OF SMOKE DETECTION SYSTEM.

WARM-UP MODE - SUPPLY AND RETURN FANS WILL START AS DETERMINED BY THE OPTIMAL START PROGRAM OF THE METASYS SYSTEM. ON THE START OF THE UNIT, HEATING COIL VALVE V-H-4 WILL OPEN FULL TO COIL AND RETURN AIR DAMPER D-4-2 WILL BE FULLY OPEN WITH THE OUTSIDE AIR DAMPERS D-4-1A, D-4-1B AND RELIEF AIR DAMPER D-4-3 CLOSED. DURATION OF THE WARM-UP MODE IS DETERMINED BY THE METASYS SYSTEM AND WILL BE DYNAMICALLY UPDATED TO END FIFTEEN (15) MINUTES PRIOR TO OCCUPANCY TIME. WARM-UP MODE IS STOPPED WHEN RETURN AIR TEMPERATURE REACHES THE SETTING OF T-1 (70F).

OCCUPIED HEATING MODE - SUPPLY AND RETURN FANS WILL BE RUNNING. RETURN AIR DAMPER D-4-2 IS OPEN. MINIMUM OUTSIDE AIR DAMPER D-4-1A WILL OPEN AFTER THE WARM-UP MODE IS STOPPED. DISCHARGE SENSOR T-2, THROUGH THE METASYS SYSTEM CONTROL UNIT, WILL ON A RISE IN TEMPERATURE ABOVE ITS SETTING OF FORTY-FIVE (45F) MODULATE V-H-4 CLOSED TO THE HEATING COIL. ON A FURTHER RISE, T-2 WILL GRADUALLY MODULATE DAMPERS D-4-1B, OPEN WHILE SIMULTANEOUSLY CLOSING D-4-2. STATIC PRESSURE CONTROLLER SPC-4-1 LOCATED IN THE ENTERING SIDE OF THE RELIEF DAMPER WILL OVERRIDE THE CONTROL AND MODULATE D-4-3 TO MAINTAIN ITS SETTING TO ENSURE A POSITIVE BUILDING PRESSURE. LOW LIMIT THERMOSTAT T-3, SENSITIVE TO THE COLDEST SPOT IN THE AIR STREAM, WILL OVERRIDE T-2 TO PREVENT MIXED AIR FROM FALLING BELOW ITS SETTING OF FORTY (40F). ON A FALL IN TEMPERATURE, THE REVERSE WILL OCCUR. COOLING COIL VALVE V-C-4 WILL BE CLOSED TO THE COIL AND COIL CIRCULATION PUMP WILL BE OFF DURING THE HEATING MODE.

UNOCCUPIED HEATING MODE - IN THE UNOCCUPIED MODE ALL AIR HANDLING UNIT DAMPERS AND CONTROLS WILL RETURN TO THEIR NORMAL POSITION READY FOR RESTARTING.

OCCUPIED COOLING MODE - SUPPLY AND RETURN FANS AND COOLING COIL CIRCULATING PUMP START AND RUN CONTINUOUSLY. OUTSIDE AIR DAMPER D-4-1A WILL OPEN. OUTSIDE DAMPER D-4-1B AND RETURN DAMPER D-4-2 WILL, THROUGH THE METASYS SYSTEM CONTROL UNIT, BE UNDER FLOATING DRY BULB DIFFERENTIAL CONTROL WHICH WILL COMPARE THE TEMPERATURE OF THE RETURN AND OUTSIDE AIR STREAMS. THE OUTSIDE AIR WILL BE UTILIZED WHENEVER IT IS GREATER THAN SEVEN (7F) LESS THAN THE RETURN AIR TEMPERATURE. WHEN THE DIFFERENTIAL FALLS BELOW SEVEN (7F), MAXIMUM OUTSIDE AIR DAMPERS D-4-1B WILL CLOSE, OPENING RETURN AIR DAMPER D-4-2. DISCHARGE SENSOR T-2, THROUGH THE METASYS SYSTEM CONTROL UNIT, WILL IN SEQUENCE MODULATE OUTSIDE AND RETURN DAMPERS D-4-1B AND D-4-2 AND CHILLED WATER VALVE V-C-1 TO MAINTAIN ITS SETTING OF FORTY-FIVE (45F). HEATING COIL VALVE V-H-4 WILL REMAIN CLOSED TO THE COIL.

UNOCCUPIED COOLING MODE - SYSTEM IS DE-ENERGIZED AND THE FANS ARE OFF.

SMOKE CONTROL - SMOKE DETECTORS WILL, ON THE DETECTION OF PRODUCTS OF COMBUSTION, SHUT DOWN THE SUPPLY AND RETURN FANS AND CLOSE ALL SYSTEM DAMPERS.

FAN CONTROL - SYSTEM STATIC PRESSURE SENSING STATION SPSS-4-1 THROUGH A STATIC PRESSURE TRANSMITTER AND THE METASYS CONTROLLER WILL MODULATE THE SUPPLY FAN VARIABLE FREQUENCY DRIVE TO MAINTAIN ITS SETTING. ON A RISE IN STATIC AS SENSED BY SPSS-4-1 THE SUPPLY FAN DRIVE WILL GRADUALLY MODULATE FAN SPEED TO ITS MINIMUM POSITION TO MAINTAIN ITS SETTING. HIGH LIMIT STATIC PRESSURE CONTROLLER SPC-4-2 WHICH WILL OVERRIDE SPSS-4-1 TO PREVENT THE DISCHARGE FROM RISING ABOVE ITS SET POINT. SUPPLY DUCT AIR MONITORING STATION AMD-4-1 AND RETURN DUCT AIR MONITORING STATION AMD-4-2 THROUGH VELOCITY PRESSURE TRANSMITTERS WILL SEND SIGNALS TO THE METASYS CONTROLLER WHICH WILL COMPARE TOTAL SUPPLY AND RETURN AIR QUANTITIES AND MODULATE THE RETURN FAN VARIABLE FREQUENCY DRIVE BASED ON SETPOINT TO SYNCHRONIZE RETURN FAN VOLUME WITH THE SUPPLY FAN VOLUME SO AS TO MAINTAIN CONSTANT MINIMUM BALANCED OUTSIDE AIR FLOW. DIFFERENTIAL WILL BE REDUCED TO ZERO (0) (NO OUTSIDE AIR) DURING WARM-UP AND UNOCCUPIED MODES OF OPERATION. MANUALLY RESET HIGH LIMIT STATIC PRESSURE CONTROLLERS SPC-4-2 AND SPC-4-3 WILL STOP THEIR RESPECTIVE SUPPLY AND RETURN FANS WHENEVER THEIR SETTING IS REACHED. ALL FANS WILL BE REQUIRED TO BE MANUALLY RESTARTED IF DE-ENERGIZED BY STATIC PRESSURE CONTROLS. SUPPLY FANS WILL BE MANUALLY CONTROLLED USING A BY-PASS STARTER IF THEIR RESPECTIVE VARIABLE FREQUENCY FAN DRIVE FAILS.

TOILET EXHAUST FANS TEF-D6, D7, D8, D9, D11, D15, D17 - THE FAN WILL START WHEN THE AHU SUPPLY FAN IS STARTED AND THE SYSTEM IS IN THE "OCCUPIED" MODE.

REVISION INFORMATION	IN CONSIDERATION OF THE RECEIPT OF THIS DOCUMENT, THE RECIPIENT AGREES NOT TO REPRODUCE, COPY, USE OR TRANSMIT THIS DOCUMENT AND/OR THE INFORMATION THEREIN CONTAINED, IN WHOLE OR IN PART, OR TO SUFFER SUCH ACTION BY OTHERS, FOR ANY PURPOSE, EXCEPT WITH THE WRITTEN PERMISSION OF JOHNSON CONTROLS, INC. AND FURTHER AGREES TO SURRENDER SAME TO JOHNSON CONTROLS, INC. UPON DEMAND.	DRAWING TITLE	AIR HANDLING UNIT AHU-4 CLUB/SUITES QUAD D	AS-BUILT	7/18/00	CME
NUMBER			PRESS LEVEL QUAD D	REFERENCE DRAWING	NO.	REV'S LOCATION
DATE	07/18/00			Sales Engineer	Project Manager	Application Engineer
TIME	03:07 PM			JDP	WJT	RTS
FILE NAME	AHU-4.vsd			BY	DATE	DATE
				BY	DATE	DATE
				CONTRACT NUMBER		
				7052-0098		
				DRAWING NUMBER		
				BL-6559-10		



JOHNSON CONTROLS
Systems & Services Division

JOHNSON CONTROLS
60 LOVETON CIRCLE
SPARKS, MD 21152

COPYRIGHT JOHNSON CONTROLS, INC. 1998

Full Spreadsheet		Software				Digital Controller Information					Panel Information				Intermediate Device				Field Device				Ref Detail	Comment				
Tag	Point Type	System Name	Object Name	Expanded ID	Display Units	DC Type	N2 Trunk	N2 Addr	Cable Destination Bay/Terminal	Module Type	Termination	Panel	Panel Location	Slot Number	Reference Drawing	Cable Number	Wiring/Ubung	Termination In	Device	Termination Out	Location	Wiring/Ubung	Terminations	Device	Location	Ref Detail	Comment	
		AHU-4				AHU						EN-AHU-4	Press Lev MER D		M.3-12												Power to Controller N2 Trunk	
		AHU-4				AHU	1	1				EN-AHU-4	Press Lev MER D		0IM.3-12													
BO-1		AHU-4	MIN-DPR	Min OA Damper Control	Closed Open	AHU	1	1	BO-1		BO# 24V	EN-AHU-4	Press Lev MER D		0IM.3-12	AH-1-BO-1		V11HGA-100			2/18	2-Wire	SAV-24VAC		A50			
BO-2		AHU-4	SF-C	Supply Fan Control	Off On	AHU	1	1	BO-2	RLY	BO# 24V.BICOM	EN-AHU-4	Press Lev MER D		0IM.3-12	AH-1-BO-2	3/18	A.COILS.COM	RELAY-A	COM.14C	2/14	See starter detail	Starter (NO)		A53			
BO-3		AHU-4	RF-C	Return Fan Control	Off On	AHU	1	1	BO-3	RLY	BO# 24V.BICOM	EN-AHU-4	Press Lev MER D		0IM.3-12	AH-1-BO-3	3/18	B.COILS.COM	RELAY-B	COM.14C	2/14	See starter detail	Starter (NO)		A53			
BO-4		AHU-4	CCP-C	Clg Coil Pump Control	Off On	AHU	1	1	BO-4	RLY	BO# 24V.BICOM	EN-AHU-4	Press Lev MER D		0IM.3-12	AH-1-BO-4	3/18	A.COILS.COM	RELAY-A	COM.14C	2/14	See starter detail	Starter (NO)		A50			
BO-5		AHU-4	TEF-C	Toilet Exh Fan Control	Off On	AHU	1	1	BO-5		BO# 24V	EN-AHU-4	Press Lev MER D		0IM.3-12	AH-1-BO-5			PD-109-51		2/18	Device dependent	24VAC OUT		A50			
BO-6		AHU-4				AHU	1	1	BO-6			EN-AHU-4	Press Lev MER D		0IM.3-12	AH-1-BO-6												
BO-7		AHU-4				AHU	1	1	BO-7			EN-AHU-4	Press Lev MER D		0IM.3-12	AH-1-BO-7												
BO-8		AHU-4				AHU	1	1	BO-8			EN-AHU-4	Press Lev MER D		0IM.3-12	AH-1-BO-8												
BO-9		AHU-4				AHU	1	1	BO-9			EN-AHU-4	Press Lev MER D		0IM.3-12	AH-1-BO-9												
BO-10		AHU-4				AHU	1	1	BO-10			EN-AHU-4	Press Lev MER D		0IM.3-12	AH-1-BO-10												
AO-1		AHU-4	DPR-C	Damper Control	% Open	AHU	1	1	AO-1		AO# AOCOM	EN-AHU-4	Press Lev MER D		0IM.3-12	AH-1-AO-1	2/18	+-	EP-8000-4	SUPPL_Y_O	1/4"	Barb Fitting	EP-PNEU.		A28			
AO-2		AHU-4	H-VLV	Heating Coil Valve	% Open	AHU	1	1	AO-2		AO# AOCOM	EN-AHU-4	Press Lev MER D		0IM.3-12	AH-1-AO-2	2/18	+-	EP-8000-4	SUPPL_Y_O	1/4"	Barb Fitting	EP-PNEU.		A28			
AO-3		AHU-4	C-VLV	Clg Coil Valve	% Open	AHU	1	1	AO-3		AO# AOCOM	EN-AHU-4	Press Lev MER D		0IM.3-12	AH-1-AO-3	2/18	+-	EP-8000-4	SUPPL_Y_O	1/4"	Barb Fitting	EP-PNEU.		A28			
AC-4		AHU-4	SF-VSD	Sup Fan Var Spd Drive	%	AHU	1	1	AC-4		AO# AOCOM	EN-AHU-4	Press Lev MER D		0IM.3-12	AH-1-AO-4					2/18	Device dependent	0-20mA OUT		A21			
AC-5		AHU-4	RF-VSD	Ret Fan Var Spd Drive	%	AHU	1	1	AC-5		AO# AOCOM	EN-AHU-4	Press Lev MER D		0IM.3-12	AH-1-AO-5					2/18	Device dependent	0-20mA OUT		A21			
AO-6		AHU-4				AHU	1	1	AO-6			EN-AHU-4	Press Lev MER D		0IM.3-12	AH-1-AO-6												
BI-1		AHU-4	SF-S	Supply Fan Status	Off On	AHU	1	1	BI-1		BI# BICOM	EN-AHU-4	Press Lev MER D		0IM.3-12	AH-1-BI-1					2/22	Device dependent	Aux Contact (NO)		A40			
BI-2		AHU-4	RF-S	Return Fan Status	Off On	AHU	1	1	BI-2		BI# BICOM	EN-AHU-4	Press Lev MER D		0IM.3-12	AH-1-BI-2					2/22	Device dependent	Aux Contact (NO)		A40			
BI-3		AHU-4	SMK-DET	Smoke Detectors	Normal Alarm	AHU	1	1	BI-3		BI# BICOM	EN-AHU-4	Press Lev MER D		0IM.3-12	AH-1-BI-3					2/22	Device dependent	Contact (NO)		A40			
BI-4		AHU-4	LT-S	Low Temperature Stat	Normal Alarm	AHU	1	1	BI-4		BI# BICOM	EN-AHU-4	Press Lev MER D		0IM.3-12	AH-1-BI-4					2/22	NO M1	A70 (NC)		A41			
BI-5		AHU-4	CCP-S	Clg Coil Pump Status	Off On	AHU	1	1	BI-5		BI# BICOM	EN-AHU-4	Press Lev MER D		0IM.3-12	AH-1-BI-5					2/22	Device dependent	Aux Contact (NO)		A40			
BI-6		AHU-4	SA-HSP	Supply Air Static Press	Normal Alarm	AHU	1	1	BI-6		BI# BICOM	EN-AHU-4	Press Lev MER D		0IM.3-12	AH-1-BI-6					2/22	Device dependent	AFS-460 & Relay		A40			
BI-7		AHU-4	RA-HSP	Return Air Static Press	Normal Alarm	AHU	1	1	BI-7		BI# BICOM	EN-AHU-4	Press Lev MER D		0IM.3-12	AH-1-BI-7					2/22	Device dependent	AFS-460 & Relay		A40			
BI-8		AHU-4				AHU	1	1	BI-8			EN-AHU-4	Press Lev MER D		0IM.3-12	AH-1-BI-8												
AI-1		AHU-4	RA-VP	Return Air Vel Pressure	In. Wg	AHU	1	1	AI-1		AI# +VDC	EN-AHU-4	Press Lev MER D		0IM.3-12	AH-1-AI-1					2/18	+-	DPT-2641		A2			
AI-2		AHU-4	RA-T	Return Air Temperature	Deg F	AHU	1	1	AI-2		AI# AICM	EN-AHU-4	Press Lev MER D		0IM.3-12	AH-1-AI-2					2/18	2-Wire	TE-8316P-1		A4			
AI-3		AHU-4	DA-T	Disch Air Temperature	Deg F	AHU	1	1	AI-3		AI# AICM	EN-AHU-4	Press Lev MER D		0IM.3-12	AH-1-AI-3					2/18	2-Wire	TE-8316P-1		A4			
AI-4		AHU-4	MA-T	Mixed Air Temperature	Deg F	AHU	1	1	AI-4		AI# AICM	EN-AHU-4	Press Lev MER D		0IM.3-12	AH-1-AI-4					2/18	2-Wire	TE-8316P-1		A4			
AI-5		AHU-4				AHU	1	1	AI-5			EN-AHU-4	Press Lev MER D		0IM.3-12	AH-1-AI-5												
AI-6		AHU-4				AHU	1	1	AI-6			EN-AHU-4	Press Lev MER D		0IM.3-12	AH-1-AI-6												
AI-7		AHU-4	S-SP	Supply Static Pressure	In. Wg	AHU	1	1	AI-7		AI# +VDC	EN-AHU-4	Press Lev MER D		0IM.3-12	AH-1-AI-7					2/18	+-	DPT-2641		A2			
AI-8		AHU-4	S-VP	Supply Vel Pressure	In. Wg	AHU	1	1	AI-8		AI# +VDC	EN-AHU-4	Press Lev MER D		0IM.3-12	AH-1-AI-8					2/18	+-	DPT-2641		A2			

Full Spreadsheet		Software				Digital Controller Information					Panel Information				Intermediate Device				Field Device				Ref Detail	Comment				
Tag	Point Type	System Name	Object Name	Expanded ID	Display Units	DC Type	N2 Trunk	N2 Addr	Cable Bay/Terminal	Destination	Module Type	Termination	Panel	Panel Location	Slot Number	Reference Drawing	Cable Number	Wiring/Tubing	Termination In	Device	Termination Out	Location	Wiring/Tubing	Terminations	Device	Location	Ref Detail	Comment
		HEATING				VAV							EN-DPS-4	Press Lev MER D														Power to Controller
		HEATING				VAV	1	2					EN-DPS-4	Press Lev MER D	0													N2 Trunk
IAI-1	HEATING	IHS4-T	HW Sup Temp At AHU-4		Deg F	VAV	1	2IAI-1		AI#.AICM			EN-DPS-4	Press Lev MER D	0		DPS-2-AI-1					2/18	2-Wire	TE-631AP-1	U1			
IAI-2	HEATING	IHW4-DP	HW Diff Press At AHU-4		PSI	VAV	1	2IAI-2		AI#.AICM,+15VDC			EN-DPS-4	Press Lev MER D	0		DPS-2-AI-2					3/18	Device dependent	Rob/Hal 252C	U5			4-20ma with 500 OHM Resistor
IAI-3	COOLING	IHS4-T	CW Sup Temp At AHU-4		Deg F	VAV	1	2IAI-3		AI#.AICM			EN-DPS-4	Press Lev MER D	0		DPS-2-AI-3					2/18	2-Wire	TE-631AP-1	U1			
IAI-4	COOLING	IHW4-DP	CW Diff Press At AHU-4		PSI	VAV	1	2IAI-4		AI#.AICM,+15VDC			EN-DPS-4	Press Lev MER D	0		DPS-2-AI-4					3/18	Device dependent	Rob/Hal 252C	U5			4-20ma with 500 OHM Resistor
IAI-5	HEATING					VAV	1	2IAI-5					EN-DPS-4	Press Lev MER D	0		DPS-2-AI-5											
IAI-6	HEATING					VAV	1	2IAI-6					EN-DPS-4	Press Lev MER D	0		DPS-2-AI-6											
IBI-1	HEATING					VAV	1	2IBI-1					EN-DPS-4	Press Lev MER D	0		DPS-2-BI-1											
IBI-2	HEATING					VAV	1	2IBI-2					EN-DPS-4	Press Lev MER D	0		DPS-2-BI-2											
IBI-3	HEATING					VAV	1	2IBI-3					EN-DPS-4	Press Lev MER D	0		DPS-2-BI-3											
IBI-4	HEATING					VAV	1	2IBI-4					EN-DPS-4	Press Lev MER D	0		DPS-2-BI-4											
IBO-1	HEATING					VAV	1	2IBO-1					EN-DPS-4	Press Lev MER D	0		DPS-2-BO-1											
IBO-2	HEATING					VAV	1	2IBO-2					EN-DPS-4	Press Lev MER D	0		DPS-2-BO-2											
IBO-3	HEATING					VAV	1	2IBO-3					EN-DPS-4	Press Lev MER D	0		DPS-2-BO-3											
IBO-4	HEATING					VAV	1	2IBO-4					EN-DPS-4	Press Lev MER D	0		DPS-2-BO-4											
IBO-5	HEATING					VAV	1	2IBO-5					EN-DPS-4	Press Lev MER D	0		DPS-2-BO-5											
IBO-6	HEATING					VAV	1	2IBO-6					EN-DPS-4	Press Lev MER D	0		DPS-2-BO-6											
IAO-1	HEATING					VAV	1	2IAO-1					EN-DPS-4	Press Lev MER D	0		DPS-2-AO-1											
IAO-2	HEATING					VAV	1	2IAO-2					EN-DPS-4	Press Lev MER D	0		DPS-2-AO-2											

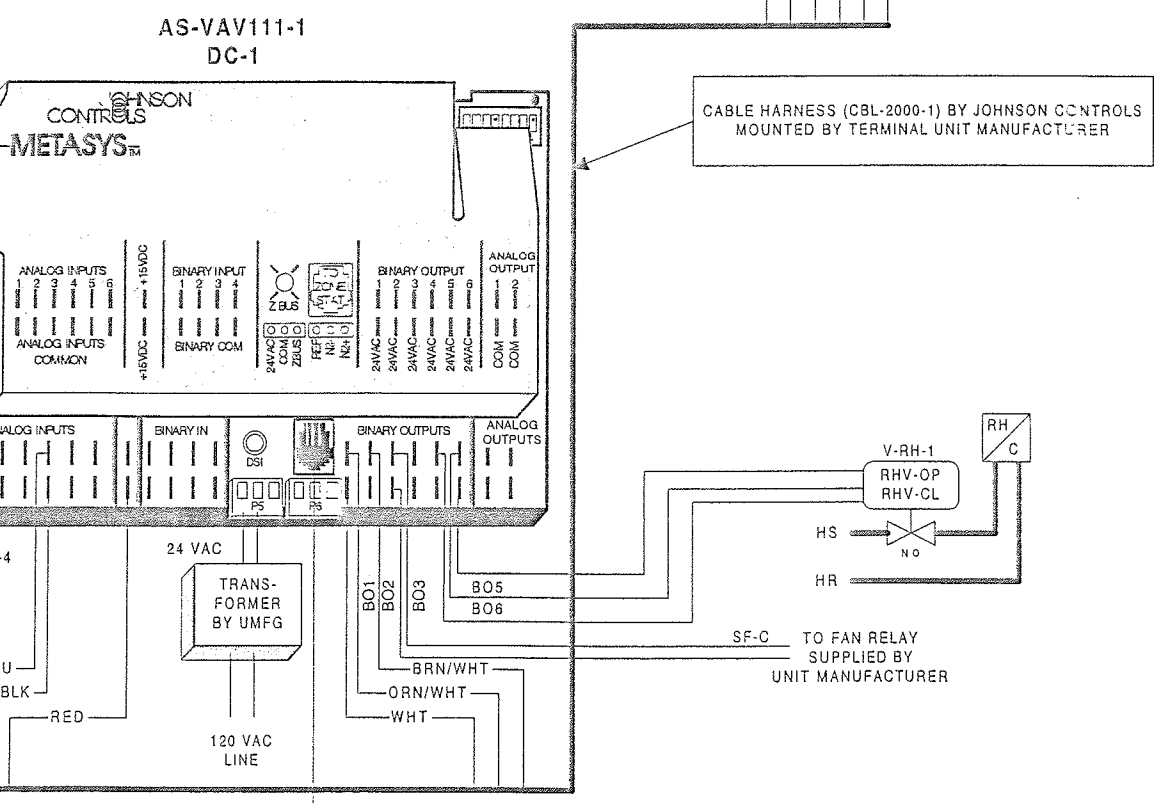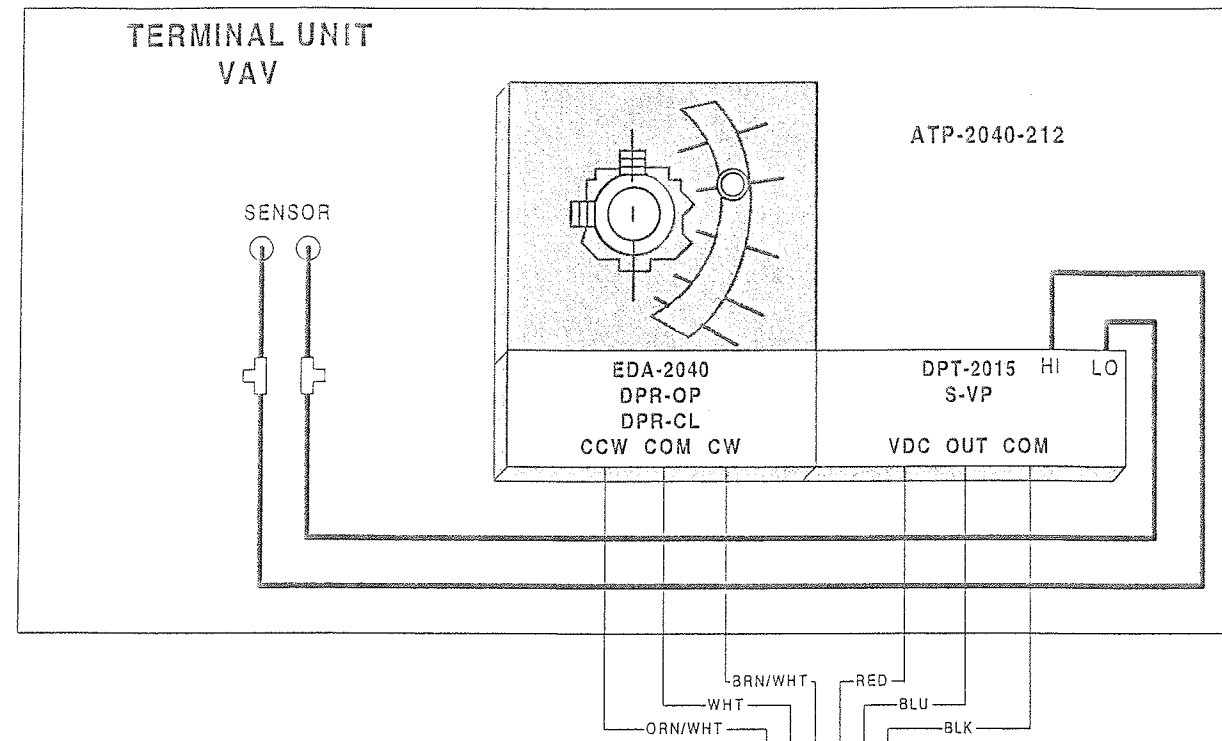

CABLE HARNESS (CBL-2000-1) BY JOHNSON CONTROLS MOUNTED BY TERMINAL UNIT MANUFACTURER


NOTE: BO-1 = DAMPER OPEN (CCW)
BO-2 = DAMPER CLOSED (CW)
IF DAMPER ROTATION REVERSED, MAKE CORRESPONDING WIRING CHANGE

CABLE HARNESS 8C#24 WIRE WITH RJ45 JACKS

BILL OF MATERIALS

Estimate: quad d vavbox 70520098.pre

Desig.	Qty	Part #	Description
Field Devices:			
DC-1	46	AS-VAV110-1	VAV 6AI, 4BI, 8BO, 8K
V-RH-1	46	--	SEE VALVE SCHEDULE
VAV	46	ATP-2040-212	ACT, 2MIN+1.5"DP, 1/2"CPLG
ZN-T	28	TE-6410W-1600	MSTAT, NI, BOX, JACK

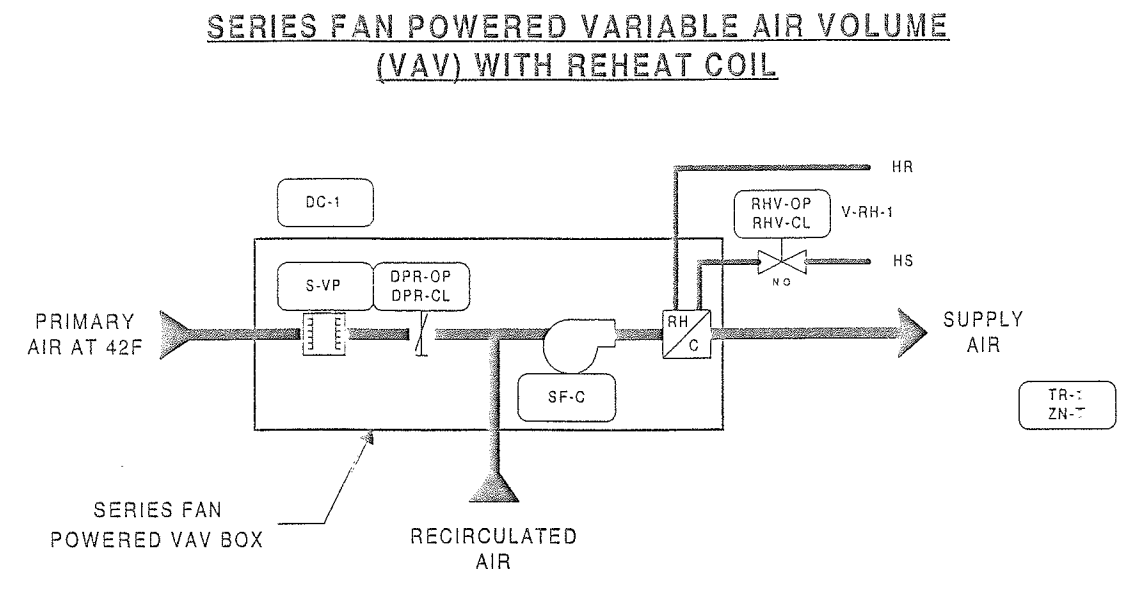


NOTE: VAV CONTROLLER (AS-VAV111-1) DAMPER ACTUATOR & DIFFERENTIAL PRESSURE TRANSMITTER (ATP-2040-212) ARE FACTORY MOUNTED BY TITUS

DESCRIPTION OF OPERATION


PRIMARY AIR VALVE WILL OPEN TO THEIR MINIMUM POSITION AND TERMINAL UNIT FAN WILL START AND RUN CONTINUOUSLY WHENEVER AIR HANDLING UNIT IS RUNNING. TERMINAL UNIT FANS WILL START THIRTY (30) SECONDS BEFORE OPENING OF AIR VALVES TO PREVENT BACK SPINNING OF FAN. FANS WILL ALSO BE OPERATED AS DEFINED IN THE UNOCCUPIED MODES. PRIMARY AIR VALVES WILL BE CLOSED DURING UNOCCUPIED HEATING MODE. ROOM SENSOR TR-1 WILL ON A RISE IN TEMPERATURE GRADUALLY MODULATE REHEAT COIL VALVE V-RH-1 CLOSED AND ON A CONTINUED RISE WILL GRADUALLY MODULATE PRIMARY AIR VALVE FROM IT'S MINIMUM TO MAXIMUM SETTING TO MAINTAIN IT'S SETTING OF SEVENTY-FIVE (75F). ON A FALL IN TEMPERATURE, THIS CYCLE IS REVERSED. DURING OPERATION OF THE WARM-UP MODE ALL PRIMARY AIR VALVES OPEN TO THEIR MAXIMUM POSITION AND TERMINAL FANS START TO PERMIT FULL AIR FLOW TO THE SPACES. REHEAT COIL VALVE V-RH-1 IS MODULATED IN RESPONSE TO ROOM SENSOR TO MAINTAIN SPACE TEMPERATURE.

REVISION INFORMATION	IN CONSIDERATION OF THE RECEIPT OF THIS DOCUMENT, THE RECIPIENT AGREES NOT TO REPRODUCE, COPY, USE OR TRANSMIT THIS DOCUMENT AND/OR THE INFORMATION THEREIN CONTAINED, IN WHOLE OR IN PART, OR TO SUFFER SUCH ACTION BY OTHERS, FOR ANY PURPOSE, EXCEPT WITH THE WRITTEN PERMISSION OF JOHNSON CONTROLS, INC. AND FURTHER AGREES TO SURRENDER SAME TO JOHNSON CONTROLS, INC. UPON DEMAND. COPYRIGHT JOHNSON CONTROLS, INC. 1998	DRAWING TITLE	AS-BUILT			7/18/00	CME		
NUMBER		FAN POWERED TERMINAL REHEAT UNITS							
DATE		07/18/00	QUAD D	REFERENCE DRAWING	NO.	REVISION-LOCATION	ECN	DATE	
TIME		02:54 PM	BALTIMORE NFL STADIUM AT CAMDEN YARDS	Sales Engineer	JDP	Project Manager	WJT	Application Engineer	RTS
FILE NAME		VAVBOX-D.vsd	BALTIMORE, MARYLAND	BY	RTS	DATE	08/28/97	BY	DATE
					Johnson Controls, Inc. 60 Loveton Circle Sparks, MD 21152		CONTRACT NUMBER 7052-0098 DRAWING NUMBER BL-6559-11		

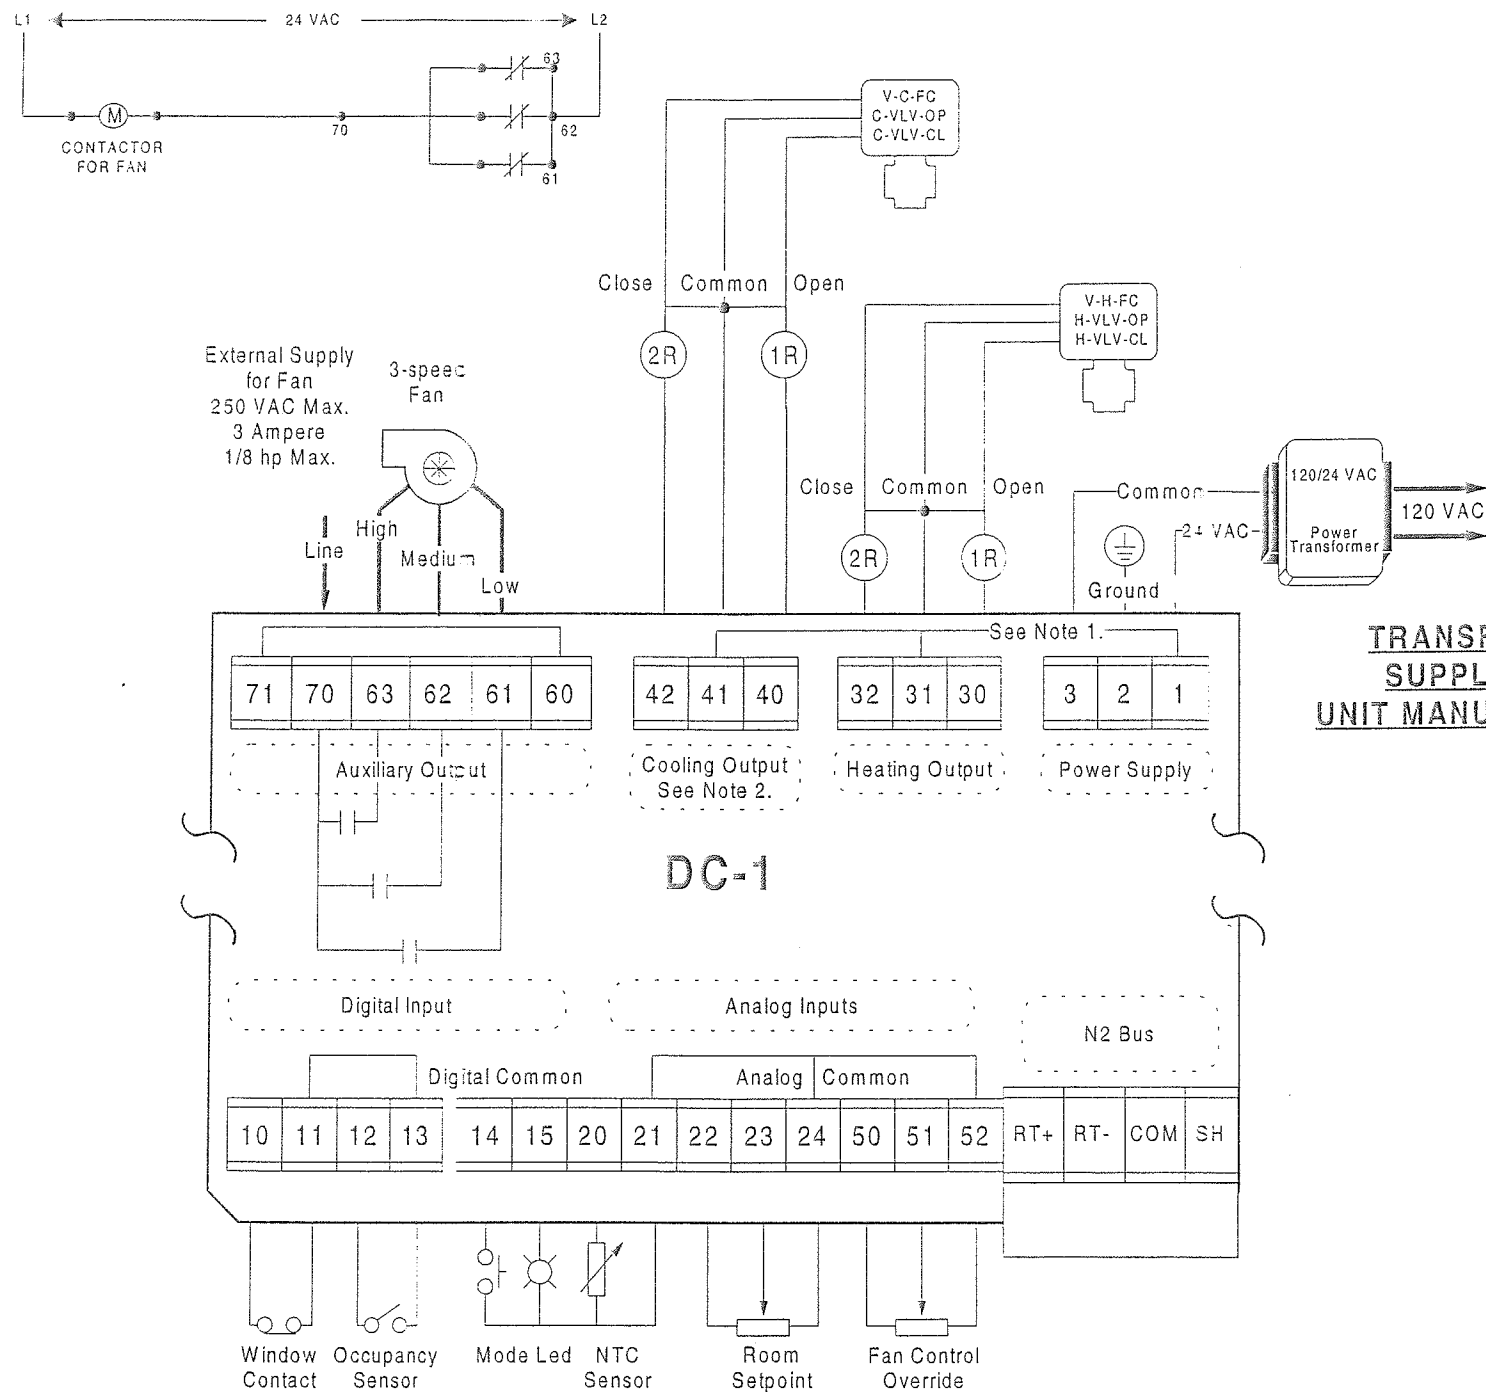

**TRANSFORMER
SUPPLIED BY
UNIT MANUFACTURER**

BILL OF MATERIALS			
Estimate:	quad d fcu	70520098.pre	
Desig.	Qty	Part #	Description
Field Devices:			
DC-1	27	TC-9102-0332	FAN CONT3-SPEED 2-STG H/C
V-H-FC	54	--	SEE VALVE SCHEDULE
V-C-FC	27	TM-9161-5002	MSTAT P/TC-9100 55-85F PSC

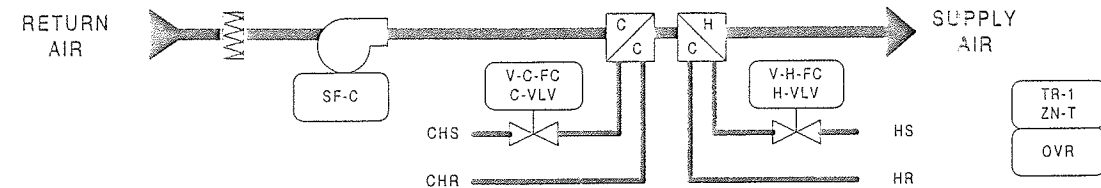

**NOTE: FCU CONTROLLER (TC-9102-0322)
ARE FACTORY MOUNTED BY TRANE**

DESCRIPTION OF OPERATION

THE METASYS SYSTEM WILL DETERMINE THE "OCCUPIED AND UNOCCUPIED" MODES OF OPERATION. OCCUPIED MODE GENERALLY OCCURS DURING THE NORMAL WORK WEEK AND STADIUM EVENTS, BUT MANUAL OVERRIDE THROUGH THE METASYS SYSTEM ON INDIVIDUAL UNITS WILL FREQUENTLY BE REQUIRED. SUITE OWNERS WILL HAVE THE ABILITY TO UTILIZE SUITES FOR PRIVATE FUNCTIONS AT ANYTIME. WHEN FAN COIL UNITS ARE DE-ENERGIZED, COOLING COIL VALVE V-C-FC AND HEATING COIL VALVE V-H-FC WILL BE CLOSED TO COILS.

OCCUPIED MODE - FAN COIL UNIT SUPPLY FAN WILL BE STARTED THROUGH ITS FAN SPEED SWITCH AND RUN CONTINUOUSLY. STARTING OF THE FAN COIL UNIT WILL INITIATE THE START OF THE RELATED EXHAUST FAN. THE EXHAUST AIR VOLUME INDUCES THE NATURAL VENTILATION OF THE SUITE AND MUST THEREFORE BE ENERGIZED WHENEVER THE SUITE IS OCCUPIED. ROOM SENSOR TR-1 WILL MODULATE HEATING COIL VALVE V-H-FC AND COOLING COIL VALVE V-C-FC IN SEQUENCE TO MAINTAIN ITS SETTING OF SEVENTY-FIVE (75F).

UNOCCUPIED MODE - ROOM SENSOR TR-1 WILL ON A FALL IN TEMPERATURE TO ITS SETTING OF FIFTY (50F) ACTIVATE SYSTEM TO RUN IN THE OCCUPIED MODE AS HEREINBEFORE DESCRIBED. ON A RISE IN TEMPERATURE TO FIFTY-FIVE (55F), FAN COIL UNIT WILL BE DE-ENERGIZED AND HEATING COIL VALVE WILL CLOSE.

Note 1: For PAT, DAT, and On-Off outputs, terminals 1, 31, and 41 are internally connected.

REVISION INFORMATION	IN CONSIDERATION OF THE RECEIPT OF THIS DOCUMENT, THE RECIPIENT AGREES NOT TO REPRODUCE, COPY, USE OR TRANSMIT THIS DOCUMENT AND/OR THE INFORMATION THEREIN CONTAINED, IN WHOLE OR IN PART, OR TO SUFFER SUCH ACTION BY OTHERS, FOR ANY PURPOSE, EXCEPT WITH THE WRITTEN PERMISSION OF JOHNSON CONTROLS, INC. AND FURTHER AGREES TO SURRENDER SAME TO JOHNSON CONTROLS, INC. UPON DEMAND. COPYRIGHT JOHNSON CONTROLS, INC. 1998	DRAWING TITLE	SUITE FAN COIL UNITS		DATE	7/18/00	BY	CME	
NUMBER		QUAD D	AS-BUILT						
DATE		07/18/00	PROJECT TITLE	BALTIMORE NFL STADIUM AT CAMDEN YARDS		REFERENCE DRAWING	NO	REVISION-LOCATION	ECN
TIME		03:03 PM	BALTIMORE, MARYLAND	JOHNSON CONTROLS Controls Group		SALES ENGINEER	JDP	PROJECT MANAGER	WJT
FILE NAME	FANCOILD.vsd				APPLICATION ENGINEER	RTS	DRAWN	BY	
					DATE	08/28/97	DATE		
					CONTRACT NUMBER	7052-0098			
					DRAWING NUMBER	BL-6559-12			

Full Spreadsheet		Software				Digital Controller Information						Panel Information				Intermediate Device				Field Device				Ref Detail	Comment		
Tag	Point Type	System Name	Object Name	Expanded ID	Display Units	DC Type	N2 Trunk	N2 Addr	Cable Destination Bay/Terminal	Module Type	Termination	Panel	Panel Location	Slot Number	Reference Drawing	Cable Number	Wiring/Tubing	Termination In	Device	Termination Out	Location	Wiring/Tubing	Terminations	Device	Location	Ref Detail	Comment
		FCU-D				TC						EN-FCU	AI FCU														Power to Controller N2 Trunk
		FCU-D				TC	1	Y				EN-FCU	AI FCU	0													
BO-1		FCU-D	H-VLV-OP	Htg Valve Open	Off On	TC	1	Y	BO-1		32,31/COM,30	EN-FCU	AI FCU	0		FCU-x-BO-1					3/18	BLK,WHT,RED	VA-7150 (Heating)				
BO-2		FCU-D	H-VLV-CL	Htg Valve Close	Off On	TC	1	Y	BO-2		32,31/COM,30	EN-FCU	AI FCU	0		FCU-x-BO-2					3/18	BLK,WHT,RED	VA-7150 (Heating)				
BO-3		FCU-D	C-VLV-OP	Cig Valve Open	Off On	TC	1	Y	BO-3		42,41/COM,40	EN-FCU	AI FCU	0		FCU-x-BO-3					3/18	BLK,WHT,RED	VA-7150 (Cooling)				
BO-4		FCU-D	C-VLV-CL	Cig Valve Close	Off On	TC	1	Y	BO-4		42,41/COM,40	EN-FCU	AI FCU	0		FCU-x-BO-4					3/18	BLK,WHT,RED	VA-7150 (Cooling)				
BO-5		FCU-D	F-SPD-1	Fan (Speed 1)	Off On	TC	1	Y	BO-5		71,70 LINE/63,62,61	EN-FCU	AI FCU	0		FCU-x-BO-5					4/14	HI,MED,LOW,NEU	Starter Coil (3 spd fan)				
BO-6		FCU-D	F-SPD-2	Fan (Speed 2)	Off On	TC	1	Y	BO-6		71,70 LINE/63,62,61	EN-FCU	AI FCU	0		FCU-x-BO-6					4/14	HI,MED,LOW,NEU	Starter Coil (3 spd fan)				
BO-7		FCU-D	F-SPD-3	Fan (Speed 3)	Off On	TC	1	Y	BO-7		71,70 LINE/63,62,61	EN-FCU	AI FCU	0		FCU-x-BO-7					4/14	HI,MED,LOW,NEU	Starter Coil (3 spd fan)				
BI-1		FCU-D				TC	1	Y	BI-1			EN-FCU	AI FCU	0		FCU-x-BI-1											
BI-2		FCU-D				TC	1	Y	BI-2			EN-FCU	AI FCU	0		FCU-x-BI-2											
BI-3		FCU-D				TC	1	Y	BI-3			EN-FCU	AI FCU	0		FCU-x-BI-3											
AI-1		FCU-D	ZN-T	Zone Temperature	Deg F	TC	1	Y	AI-1		14 MODE,15 LED,2	EN-FCU	AI FCU	0		FCU-x-AI-1					3/22	14 MODE,15 LED,2	TM-9100 (Mode & LED)				
AI-2		FCU-D	ZN-SET	Zone Temp Set Point	Deg F	TC	1	Y	AI-2		22,23,21/24	EN-FCU	AI FCU	0		FCU-x-AI-2					3/22	22,23,21/24	TM-9100 (Setpoint)				
AI-4		FCU-D	OVR	Fan Override	Lo-Md-Hi	TC	1	Y	AI-4		51,21/24	EN-FCU	AI FCU	0		FCU-x-AI-4					2/22	51,21/24	TM-9100 (Fan Override)				


Estimate: ahu-9
Desig. QtyPart # Description

Field Devices:


C-1	1	C-5226-3	SIGNAL TRANSMITTER
D-9-1, D-9-2, 3	---	---	SEE DAMPER SCHEDULE
D-9-3	3	D-3153-1	DMPR ACT, 8-13#, W/PILOT
DPR-C	3	G-2010-11	GAGE, 2", 0-30 PSIG, STEM
FZ-9	1	A70HA-1C	STAT, LL, 20', EL, MAN, 15/55F
H-VLV, C-VLV	1	---	SEE VALVE SCHEDULE
MA-T, DA-T, RA-T	3	TE-6316P-1	SENS, T-Ni, 0.18, 17' AVG
SPC-9-1	1	R-317-1	CNTRLR DP, 0.05-1" WG
SPC-9-2	1	R-317-7	CNTRLR DP, 0.6-12" WG
T-3	1	T-3610-1001	STAT, LOW VOL, .8' AVG, DCT
TEF-C5	1	BZ-1000-11	ENCL, 4-5/8X 5-1/8 X 3-3/8
	1	PD-101-35	RLY BASE, 3PDT, 11PIN, 10A
	1	PD-109-51	RELAY PLUG-IN 3PDT 24VAC

Panel Devices:


EN-AHU-9	1	AS-AHU103-300	AHU TERM BD IN ENC35
	1	EN-EXP101-0	UNIV PKG MOD, CVR & BACKEN
EP-1, 2, 3, 4	4	EP-8000-4	XDUCR, EP, 4-20ma, HI VOL
PI-1, 2, 3, 4	4	G-2010-11	GAGE, 2", 0-30 PSIG, STEM
RLY-1, 2	2	AS-RLY002-0	RELAY; 2SPDT 5 AMP 240VAC

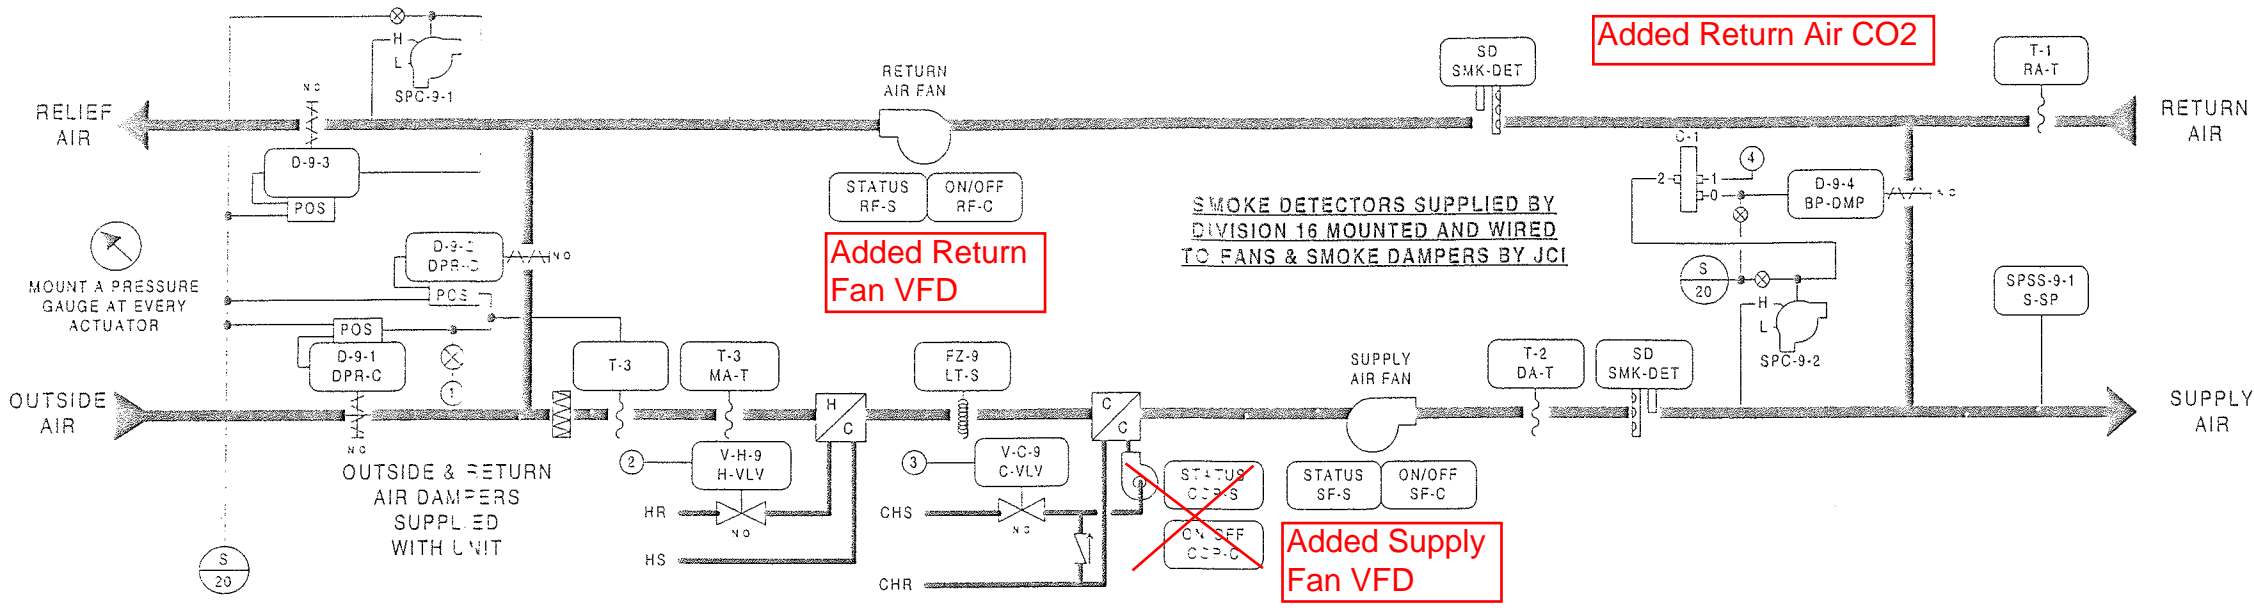


SUPPLY FAN WIRING DIAGRAM

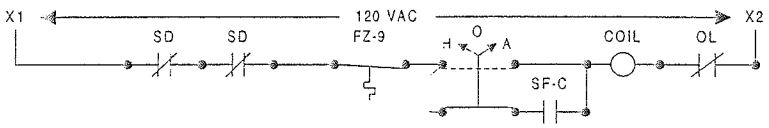


RETURN FAN WIRING DIAGRAM

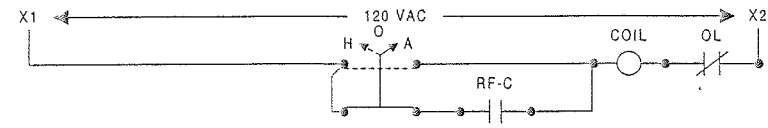



~~COOLING COIL PUMP DIAGRAM~~

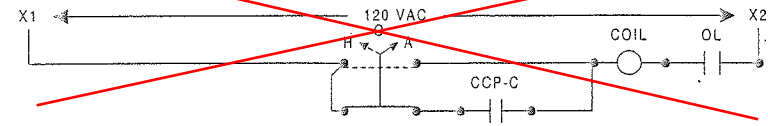

TOILET EXHAUST FAN DIAGRAM

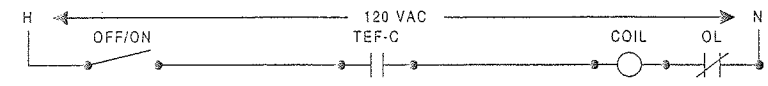

FAN	LOCATION	ELEC PANEL	CIRCUIT	LOCATION
TEF-C5	PRESS LEV	PRPPRC	63	PRESS LEV

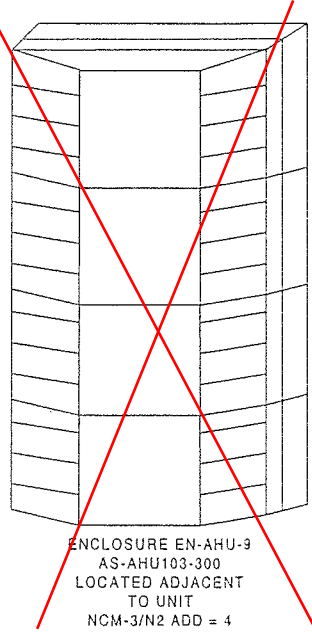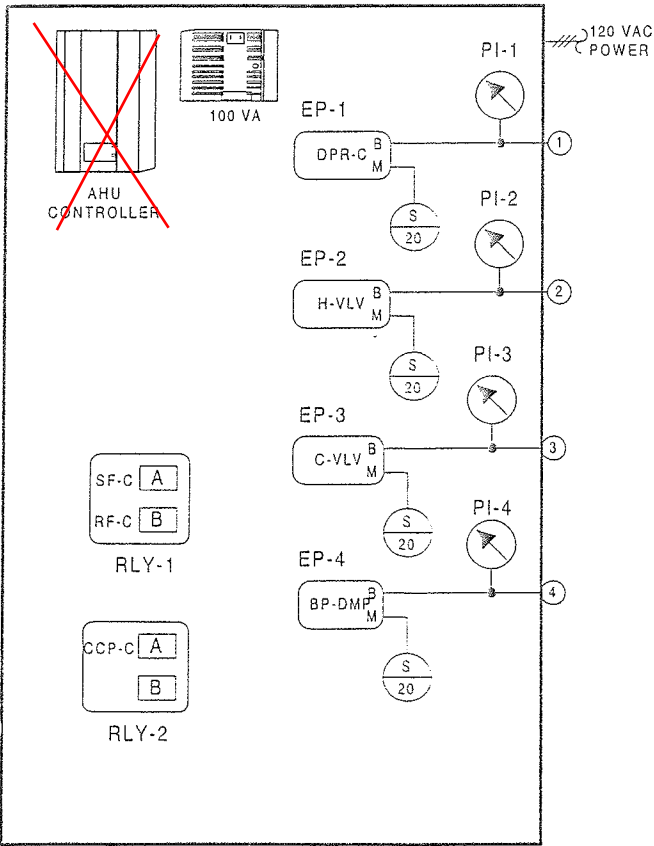

ENCLOSURE EN-AHU-9
AS-AHU103-300
LOCATED ADJACENT
TO UNIT
NCM-3/N2 ADD = 4

DESCRIPTION OF OPERATION

THE METASYS SYSTEM WILL DETERMINE THE "OCCUPIED AND UNOCCUPIED" MODES OF OPERATION. OCCUPIED MODES GENERALLY OCCUR DURING STAGNATION EVENTS, BUT MANUAL OVERRIDE THROUGH THE METASYS SYSTEM ON SELECTED UNITS WILL FREQUENTLY BE REQUIRED. WHEN THE UNIT IS DE-ENERGIZED, OUTSIDE AND RELIEF AIR DAMPERS D-9-1, D-9-3 AND COOLING COIL VALVE V-C-9 WILL CLOSE; COOLING COIL PUMP WILL BE OFF; RETURN AIR DAMPER D-9-2 WILL BE OPEN AND HEATING COIL VALVE V-H-9 WILL BE CLOSED TO THE COIL.

WARM-UP MODE - SUPPLY AND RETURN FANS WILL START AS DETERMINED BY THE OPTIMAL START PROGRAM OF THE METASYS SYSTEM. ON THE START OF THE UNIT, HEATING COIL VALVE V-H-9 WILL OPEN FULL TO COIL AND RETURN AIR DAMPER D-9-2 WILL BE FULLY OPEN WITH THE OUTSIDE AIR DAMPERS D-9-1, AND RELIEF AIR DAMPER D-9-3 CLOSED. DURATION OF THE WARM-UP MODE IS DETERMINED BY THE METASYS SYSTEM AND WILL BE DYNAMICALLY UPDATED TO END FIFTEEN (15) MINUTES PRIOR TO OCCUPANCY TIME. WARM-UP MODE IS STOPPED WHEN RETURN AIR TEMPERATURE REACHES THE SETTING OF T-1 (70F).

OCCUPIED HEATING MODE - SUPPLY AND RETURN FANS WILL BE RUNNING, RETURN AIR DAMPER D-9-2 IS OPEN. OUTSIDE AIR DAMPER D-9-1 WILL OPEN ITS MINIMUM OPEN POSITION AFTER THE WARM-UP MODE IS STOPPED. DISCHARGE SENSOR T-2, THROUGH THE METASYS SYSTEM CONTROL UNIT, WILL ON A RISE IN TEMPERATURE ABOVE ITS SETTING OF FORTY-FIVE (45F) MODULATE V-H-9 CLOSED TO THE HEATING COIL. ON A FURTHER RISE, T-2 WILL GRADUALLY MODULATE DAMPER D-9-1 OPEN WHILE SIMULTANEOUSLY CLOSING D-9-2. STATIC PRESSURE CONTROLLER SPC-9-1 LOCATED IN THE ENTERING SIDE OF THE RELIEF DAMPER WILL OVERRIDE THE CONTROL AND MODULATE D-9-3 TO MAINTAIN ITS SETTING TO ENSURE A POSITIVE BUILDING PRESSURE. LOW LIMIT THERMOSTAT T-3, SENSITIVE TO THE COLDEST SPOT IN THE AIR STREAM, WILL OVERRIDE T-2 TO PREVENT MIXED AIR FROM FALLING BELOW ITS SETTING OF FORTY (40F). ON A FALL IN TEMPERATURE, THE REVERSE WILL OCCUR. COOLING COIL VALVE V-C-9 WILL BE CLOSED TO THE COIL AND COIL CIRCULATION PUMP WILL BE OFF DURING THE HEATING MODE.

UNOCCUPIED HEATING MODE - IN THE UNOCCUPIED MODE ALL AIR HANDLING UNIT DAMPERS AND CONTROLS WILL RETURN TO THEIR NORMAL POSITION READY FOR RESTARTING.

OCCUPIED COOLING MODE - SUPPLY AND RETURN FANS AND COOLING COIL CIRCULATING PUMP START AND RUN CONTINUOUSLY. OUTSIDE DAMPER D-9-1 AND RETURN DAMPER D-9-2 WILL, THROUGH THE METASYS SYSTEM CONTROL UNIT, BE UNDER FLOATING DRY BULB DIFFERENTIAL CONTROL WHICH WILL COMPARE THE TEMPERATURE OF THE RETURN AND OUTSIDE AIR STREAMS. THE OUTSIDE AIR WILL BE UTILIZED WHENEVER IT IS GREATER THAN SEVEN (7F) LESS THAN THE RETURN AIR TEMPERATURE. WHEN THE DIFFERENTIAL FALLS BELOW SEVEN (7F), OUTSIDE AIR DAMPERS D-9-1 WILL CLOSE, OPENING RETURN AIR DAMPER D-9-2. DISCHARGE SENSOR T-2, THROUGH THE METASYS SYSTEM CONTROL UNIT, WILL IN SEQUENCE MODULATE OUTSIDE AND RETURN DAMPERS D-9-1 AND D-9-2 AND CHILLED WATER VALVE V-C-9 TO MAINTAIN ITS SETTING OF FORTY-FIVE (45F). HEATING COIL VALVE V-H-9 WILL REMAIN CLOSED TO THE COIL.

UNOCCUPIED COOLING MODE - SYSTEM IS DE-ENERGIZED AND THE FANS ARE OFF.

SMOKE CONTROL - SMOKE DETECTORS WILL, ON THE DETECTION OF PRODUCTS OF COMBUSTION, SHUT DOWN THE SUPPLY AND RETURN FANS AND CLOSE ALL SYSTEM DAMPERS.

FAN CONTROL - SYSTEM STATIC PRESSURE SENSING STATION SPSS-9-1 THROUGH A STATIC PRESSURE TRANSMITTER AND THE METASYS CONTROLLER WILL MODULATE THE BYPASS DAMPER D-9-4 TO MAINTAIN ITS SETTING. ON A RISE IN STATIC AS SENSED BY SPSS-9-1 DAMPER D-9-4 WILL GRADUALLY MODULATE OPEN TO ITS MAXIMUM POSITION TO MAINTAIN ITS SETTING. HIGH LIMIT STATIC PRESSURE CONTROLLER SPC-9-2 WHICH WILL OVERRIDE SPSS-9-1 AND OPEN D-9-4 TO PREVENT THE DISCHARGE FROM RISING ABOVE ITS SET POINT.



TOILET EXHAUST FAN TEF-C5 - THE FAN WILL START WHEN AHU SUPPLY FAN STARTS AND THE SYSTEM IS IN THE "OCCUPIED" MODE.

<p>REVISION INFORMATION</p> <p>NUMBER</p> <p>DATE 07/18/00</p> <p>TIME 03:08 PM</p> <p>FILE NAME AHU-9.vsd</p>	<p>IN CONSIDERATION OF THE RECEIPT OF THIS DOCUMENT, THE RECIPIENT AGREES NOT TO REPRODUCE, COPY, USE OR TRANSMIT THIS DOCUMENT AND/OR THE INFORMATION THEREIN CONTAINED, IN WHOLE OR IN PART, OR TO SUFFER SUCH ACTION BY OTHERS, FOR ANY PURPOSE, EXCEPT WITH THE WRITTEN PERMISSION OF JOHNSON CONTROLS, INC. AND FURTHER AGREES TO SURRENDER SAME TO JOHNSON CONTROLS, INC. UPON DEMAND.</p> <p>COPYRIGHT JOHNSON CONTROLS, INC. 1998</p>	<p>DRAWING TITLE</p> <p>AIR HANDLING UNIT AHU-9 PRESS LEVEL QUAD B & C</p> <p>PRESS LEVEL QUAD C</p> <p>PROJECT TITLE</p> <p>BALTIMORE NFL STADIUM AT CAMDEN YARDS</p> <p>BALTIMORE, MARYLAND</p>	<p>AS-BUILT</p> <p>7/18/00 CME</p> <p>REFERENCE DRAWING NO. REVISION-LOCATION EGN DATE BY</p> <p>Sales Engineer JDP Project Manager WJT Application Specialist RTS DRAWN BY RTS DATE 08/29/97 BY DATE</p> <p>Branch Information</p> <p>JOHNSON CONTROLS</p> <p>JOHNSON CONTROLS 60 LOVETON CIRCLE SPARKS, MD 21152</p> <p>CONTRACT NUMBER 7052-0098</p> <p>DRAWING NUMBER BL-6559-13</p>
--	---	---	---


Full Spreadsheet		Software				Digital Controller Information					Panel Information				Intermediate Device				Field Device				Ref Detail	Comment			
Tag	Point Type	System Name	Object Name	Expanded ID	Display Units	DC Type	N2 Trunk	N2 Addr	Cable Destination Bgt/Terminal	Module Type	Termination	Panel	Panel Location	Slot Number	Reference Drawing	Cable Number	Wiring/Tubing	Termination In	Device	Termination Out	Location	Wiring/Tubing	Terminations	Device	Location	Ref Detail	Comment
		AHU-9				AHU		4				EV-AHU-9	Press Level MER	0IM.3-13													Power to Controller N2 Trunk
BO-1		AHU-9	SF-C	Supply Fan Control	Off On	AHU		4 BO-1	RLY	BO#.24V.BICOM		EV-AHU-9	Press Level MER	0IM.3-13	AHU-9-4-BO-1	3/18	A.COILS.COM	RELAY-A	COM.NO		2/14	See starter detail	Starter (NO)		A53		
BO-2		AHU-9	RF-C	Return Fan Control	Off On	AHU		4 BO-2	RLY	BO#.24V.BICOM		EV-AHU-9	Press Level MER	0IM.3-13	AHU-9-4-BO-2	3/18	B.COILS.COM	RELAY-B	COM.NO		2/14	See starter detail	Starter (NO)		A53		
BO-3		AHU-9				AHU		4 BO-3				EV-AHU-9	Press Level MER	0IM.3-13	AHU-9-4-BO-3												
BO-4		AHU-9	CCP-C	Clg Coil Pump 9 Control	Off On	AHU		4 BO-4	RLY	BO#.24V.BICOM		EV-AHU-9	Press Level MER	0IM.3-13	AHU-9-4-BO-4	3/18	A.COILS.COM	RELAY-A	COM.NO		2/14	See starter detail	Starter (NO)		A53		
BO-5		AHU-9	TEFS-C	Toilet Exh Fan C5 Control	Off On	AHU		4 BO-5		BO#.24V		EV-AHU-9	Press Level MER	0IM.3-13	AHU-9-4-BO-5						2/18	Device dependent	24VAC OUT		A50		
BO-6		AHU-9				AHU		4 BO-6				EV-AHU-9	Press Level MER	0IM.3-13	AHU-9-4-BO-6												
BO-7		AHU-9				AHU		4 BO-7				EV-AHU-9	Press Level MER	0IM.3-13	AHU-9-4-BO-7												
BO-8		AHU-9				AHU		4 BO-8				EV-AHU-9	Press Level MER	0IM.3-13	AHU-9-4-BO-8												
BO-9		AHU-9				AHU		4 BO-9				EV-AHU-9	Press Level MER	0IM.3-13	AHU-9-4-BO-9												
BO-10		AHU-9				AHU		4 BO-10				EV-AHU-9	Press Level MER	0IM.3-13	AHU-9-4-BO-10												
AO-1		AHU-9	DPR-C	Damper Control	% Open	AHU		4 AO-1		AO#.AOCOM		EV-AHU-9	Press Level MER	0IM.3-13	AHU-9-4-AO-1	2/18	+-	EP-8000-4	SUPPLY.O		1/4*	Barb Fitting	EP-PNEU.		A28		
AO-2		AHU-9	H-VLV	Heating Coil Valve	% Open	AHU		4 AO-2		AO#.AOCOM		EV-AHU-9	Press Level MER	0IM.3-13	AHU-9-4-AO-2	2/18	+-	EP-8000-4	SUPPLY.O		1/4*	Barb Fitting	EP-PNEU.		A28		
AO-3		AHU-9	C-VLV	Clg Coil Valve	% Open	AHU		4 AO-3		AO#.AOCOM		EV-AHU-9	Press Level MER	0IM.3-13	AHU-9-4-AO-3	2/18	+-	EP-8000-4	SUPPLY.O		1/4*	Barb Fitting	EP-PNEU.		A28		
AO-4		AHU-9	BP-DMP	Bypass Damper	% Open	AHU		4 AO-4		AO#.AOCOM		EV-AHU-9	Press Level MER	0IM.3-13	AHU-9-4-AO-4	2/18	+-	EP-8000-4	SUPPLY.O		1/4*	Barb Fitting	EP-PNEU.		A28		
AO-5		AHU-9				AHU		4 AO-5				EV-AHU-9	Press Level MER	0IM.3-13	AHU-9-4-AO-5												
AO-6		AHU-9				AHU		4 AO-6				EV-AHU-9	Press Level MER	0IM.3-13	AHU-9-4-AO-6												
BI-1		AHU-9	SF-S	Supply Fan Status	Off On	AHU		4 BI-1		BI#.BICOM		EV-AHU-9	Press Level MER	0IM.3-13	AHU-9-4-BI-1						2/22	Device dependent	Aux Contact (NO)		A40		
BI-2		AHU-9	RF-S	Return Fan Status	Off On	AHU		4 BI-2		BI#.BICOM		EV-AHU-9	Press Level MER	0IM.3-13	AHU-9-4-BI-2						2/22	Device dependent	Aux Contact (NO)		A40		
BI-3		AHU-9	SMK-DET	Smoke Detectors	Normal Alarm	AHU		4 BI-3		BI#.BICOM		EV-AHU-9	Press Level MER	0IM.3-13	AHU-9-4-BI-3						2/22	Device dependent	Contact (NO)		A40		
BI-4		AHU-9	LT-S	Low Temperature Stat	Normal Alarm	AHU		4 BI-4		BI#.BICOM		EV-AHU-9	Press Level MER	0IM.3-13	AHU-9-4-BI-4						2/22	NO,M1	A70 (NC)		A41		
BI-5		AHU-9	CCP-S	Clg Coil Pump 9 Status	Off On	AHU		4 BI-5		BI#.BICOM		EV-AHU-9	Press Level MER	0IM.3-13	AHU-9-4-BI-5						2/22	Device dependent	Aux Contact (NO)		A40		
BI-6		AHU-9	SA-HSP	Supply Air Static Press	Normal Alarm	AHU		4 BI-6		BI#.BICOM		EV-AHU-9	Press Level MER	0IM.3-13	AHU-9-4-BI-6						2/22	Device dependent	Contact (NO)		A40		
BI-7		AHU-9				AHU		4 BI-7				EV-AHU-9	Press Level MER	0IM.3-13	AHU-9-4-BI-7												
BI-8		AHU-9				AHU		4 BI-8				EV-AHU-9	Press Level MER	0IM.3-13	AHU-9-4-BI-8												
AI-1		AHU-9				AHU		4 AI-1				EV-AHU-9	Press Level MER	0IM.3-13	AHU-9-4-AI-1												
AI-2		AHU-9	IRA-T	Return Air Temperature	Deg F	AHU		4 AI-2		AI#.AICM		EV-AHU-9	Press Level MER	0IM.3-13	AHU-9-4-AI-2						2/18	2-Wire	TE-6315P-1		A4		
AI-3		AHU-9	DA-T	Disch Air Temperature	Deg F	AHU		4 AI-3		AI#.AICM		EV-AHU-9	Press Level MER	0IM.3-13	AHU-9-4-AI-3						2/18	2-Wire	TE-6315P-1		A4		
AI-4		AHU-9	MA-T	Mixed Air Temperature	Deg F	AHU		4 AI-4		AI#.AICM		EV-AHU-9	Press Level MER	0IM.3-13	AHU-9-4-AI-4						2/18	2-Wire	TE-6315P-1		A4		
AI-5		AHU-9				AHU		4 AI-5				EV-AHU-9	Press Level MER	0IM.3-13	AHU-9-4-AI-5												
AI-6		AHU-9				AHU		4 AI-6				EV-AHU-9	Press Level MER	0IM.3-13	AHU-9-4-AI-6												
AI-7		AHU-9	S-SP	Supply Static Pressure	In. Wg	AHU		4 AI-7		AI#+VDC		EV-AHU-9	Press Level MER	0IM.3-13	AHU-9-4-AI-7						2/18	+-	DPT-2641		A2		
AI-8		AHU-9				AHU		4 AI-8				EV-AHU-9	Press Level MER	0IM.3-13	AHU-9-4-AI-8												

BILL OF MATERIALS

Estimate:	ahu-9 vavbox	70520098.pre
Desig.	QtyPart #	Description
Field Devices:		
DC-1	30 AS-VAV110-1	VAV 6AI, 4BI, 8BO, 8K
V-RH-1	30 --	SEE VALVE SCHEDULE
VAV	30 ATP-2040-212	ACT, 2MIN+1.5"DP, 1/2"CPLG
ZN-T	21 TE-6410W-1300	HSTAT, NI, BOX, JACK

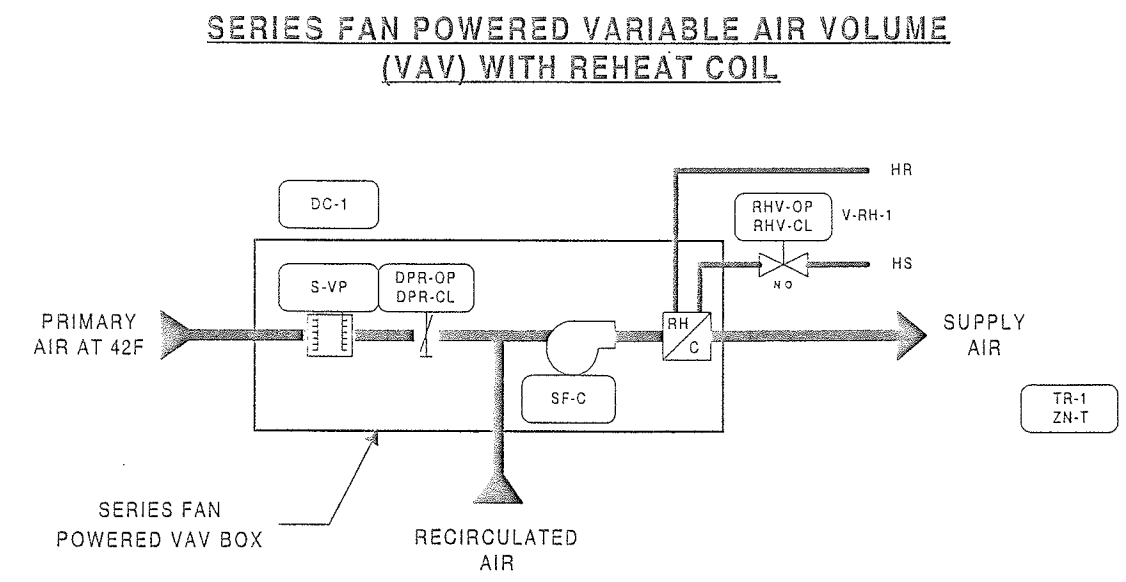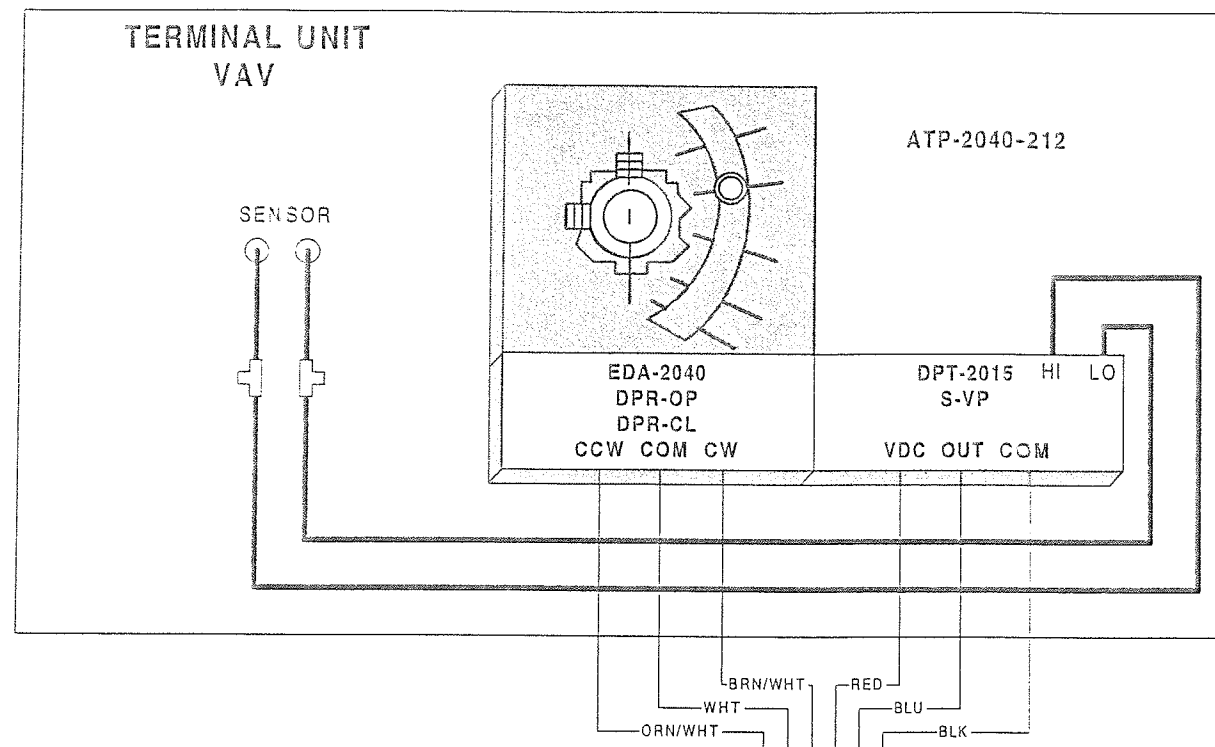

NOTE: VAV CONTROLLER (AS-VAV111-1) DAMPER ACTUATOR & DIFFERENTIAL PRESSURE TRANSMITTER (ATP-2040-212) ARE FACTORY MOUNTED BY TITUS

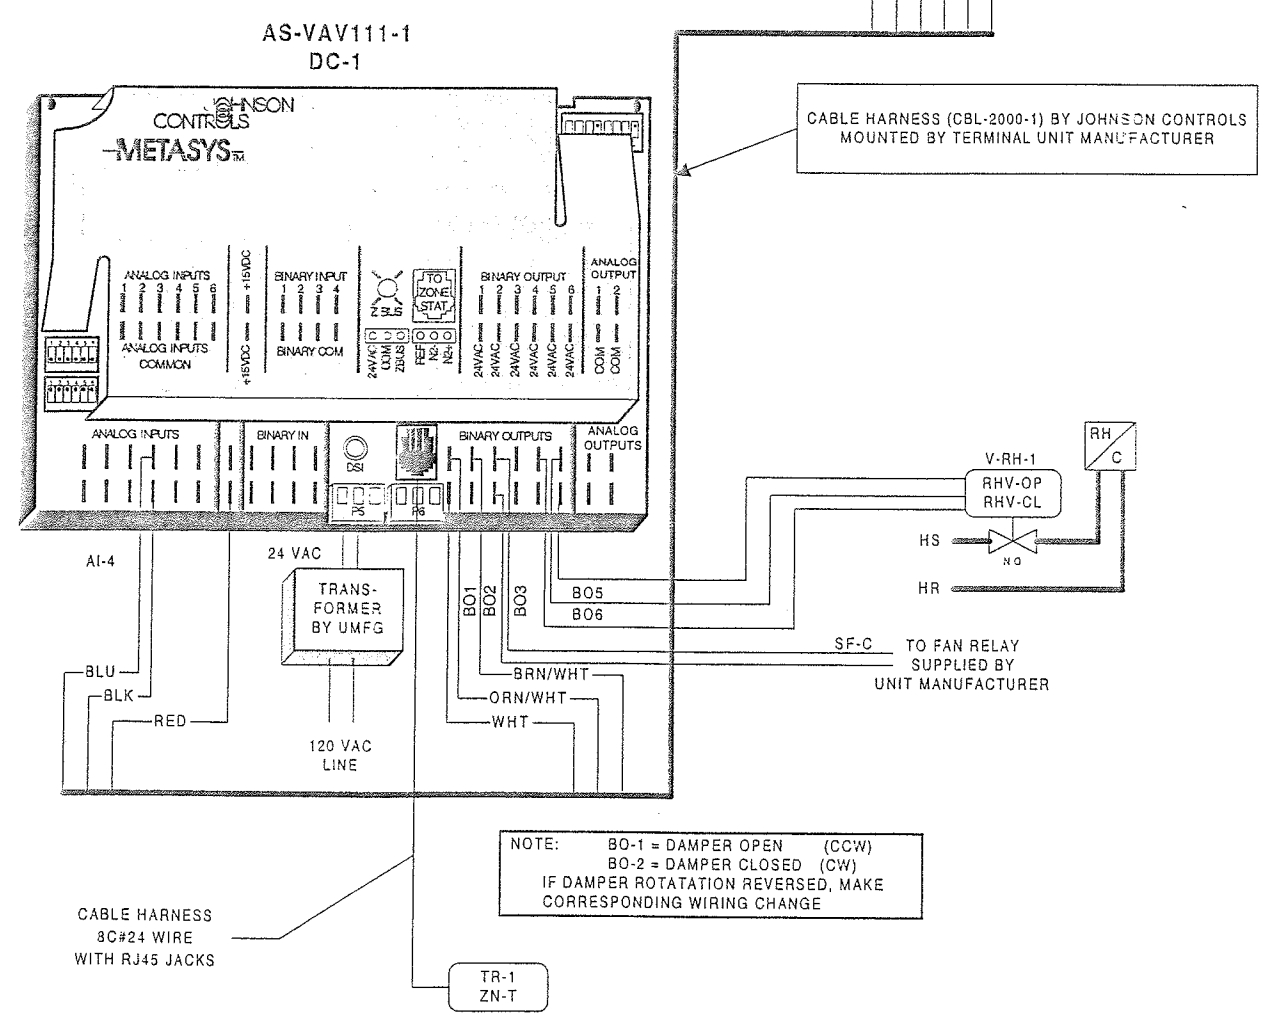


DESCRIPTION OF OPERATION

PRIMARY AIR VALVE WILL OPEN TO THEIR MINIMUM POSITION AND TERMINAL UNIT FAN WILL START AND RUN CONTINUOUSLY WHENEVER AIR HANDLING UNIT IS RUNNING. TERMINAL UNIT FANS WILL START THIRTY (30) SECONDS BEFORE OPENING OF AIR VALVES TO PREVENT BACK SPINNING OF FAN. FANS WILL ALSO BE OPERATED AS DEFINED IN THE UNOCCUPIED MODES. PRIMARY AIR VALVES WILL BE CLOSED DURING UNOCCUPIED HEATING MODE. ROOM SENSOR TR-1 WILL ON A RISE IN TEMPERATURE GRADUALLY MODULATE REHEAT COIL VALVE V-RH-1 CLOSED AND ON A CONTINUED RISE WILL GRADUALLY MODULATE PRIMARY AIR VALVE FROM IT'S MINIMUM TO MAXIMUM SETTING TO MAINTAIN IT'S SETTING OF SEVENTY-FIVE (75F). ON A FALL IN TEMPERATURE, THIS CYCLE IS REVERSED. DURING OPERATION OF THE WARM-UP MODE ALL PRIMARY AIR VALVES OPEN TO THEIR MAXIMUM POSITION AND TERMINAL FANS START TO PERMIT FULL AIR FLOW TO THE SPACES. REHEAT COIL VALVE V-RH-1 IS MODULATED IN RESPONSE TO ROOM SENSOR TO MAINTAIN SPACE TEMPERATURE.

REVISION INFORMATION	IN CONSIDERATION OF THE RECEIPT OF THIS DOCUMENT, THE RECIPIENT AGREES NOT TO REPRODUCE, COPY, USE OR TRANSMIT THIS DOCUMENT AND/OR THE INFORMATION THEREIN CONTAINED, IN WHOLE OR IN PART, OR TO SUFFER SUCH ACTION BY OTHERS, FOR ANY PURPOSE, EXCEPT WITH THE WRITTEN PERMISSION OF JOHNSON CONTROLS, INC. AND FURTHER AGREES TO SURRENDER SAME TO JOHNSON CONTROLS, INC. UPON DEMAND.	DRAWING TITLE	AS-BUILT		7/18/00	CME	
NUMBER		FAN POWERED TERMINAL REHEAT UNITS					
DATE		07/18/00	QUAD C PRESS LEVEL				
TIME		02:54 PM	BALTIMORE NFL STADIUM AT CAMDEN YARDS				
FILE NAME	VAVBOX-E.vsd	BALTIMORE, MARYLAND					
COPYRIGHT JOHNSON CONTROLS, INC. 1998				Johnson Controls, Inc. 50 Loveton Circle Sparks, MD 21152		CONTRACT NUMBER 7052-0098 DRAWING NUMBER BL-6559-14	

Full Spreadsheet		Software				Digital Controller Information					Panel Information				Intermachine Device				Field Device				Ref Detail	Comment				
Tag	Point Type	System Name	Object Name	Expansion ID	Display Units	DC Type	N2 Trunk	N2 Addr	Cable Destination Brg/Terminal	Module Type	Termination	Panel	Panel Location	Slot Number	Reference Drawing	Cable Number	Wiring/Tubing	Termination In	Device	Termination Out	Location	Wiring/Tubing	Terminations	Device	Location	Ref Detail	Comment	
		FP-VAV-C9				VAV						EN-FPVAV	AI VAVBOX														Power to Controller N2 Trunk	
AI-1		FP-VAV-C9	ZN-T	Zone Temperature	Deg F	VAV			Z:AI-1		PHONE JACK	EN-FPVAV	AI VAVBOX	01		FPVAV-x-AI-1					3/26	PHONE JACK	Metastat-Ph Jack			U2		
AI-2		FP-VAV-C9				VAV			Z:AI-2			EN-FPVAV	AI VAVBOX	01		FPVAV-x-AI-2												
AI-3		FP-VAV-C9				VAV			Z:AI-3			EN-FPVAV	AI VAVBOX	01		FPVAV-x-AI-3												
AI-4		FP-VAV-C9	SVP	Supply Val Pressure	In. Wg	VAV			Z:AI-4		AI#,AICM,+15VDC	EN-FPVAV	AI VAVBOX	01		FPVAV-x-AI-4					3/18	OUT.COM,+VDC	DPT-2000			U9		
AI-5		FP-VAV-C9				VAV			Z:AI-5			EN-FPVAV	AI VAVBOX	01		FPVAV-x-AI-5												
AI-6		FP-VAV-C9				VAV			Z:AI-6			EN-FPVAV	AI VAVBOX	01		FPVAV-x-AI-6												
BI-1		FP-VAV-C9				VAV			Z:BI-1			EN-FPVAV	AI VAVBOX	01		FPVAV-x-BI-1												
BI-2		FP-VAV-C9				VAV			Z:BI-2			EN-FPVAV	AI VAVBOX	01		FPVAV-x-BI-2												
BI-3		FP-VAV-C9				VAV			Z:BI-3			EN-FPVAV	AI VAVBOX	01		FPVAV-x-BI-3												
BI-4		FP-VAV-C9				VAV			Z:BI-4			EN-FPVAV	AI VAVBOX	01		FPVAV-x-BI-4												
BO-1		FP-VAV-C9	DPR-OP	Damper Open	Off On	VAV			Z:BO-1		BO-a,BO-b,24VAC	EN-FPVAV	AI VAVBOX	01		FPVAV-x-BO-1					3/18	CW,CCW,COM	EDA-2040			U54		
BO-2		FP-VAV-C9	DPR-CL	Damper Close	Off On	VAV			Z:BO-2		BO-a,BO-b,24VAC	EN-FPVAV	AI VAVBOX	01		FPVAV-x-BO-2					3/18	CW,CCW,COM	EDA-2040			U54		
BO-3		FP-VAV-C9	SF-C	Supply Fan Control	Off On	VAV			Z:BO-3		BO#,24VAC	EN-FPVAV	AI VAVBOX	01		FPVAV-x-BO-3	2/18	COIL	RELAY	NO,COM		2/14	See starter detail	Starter (NO)			U51	
BO-4		FP-VAV-C9				VAV			Z:BO-4			EN-FPVAV	AI VAVBOX	01		FPVAV-x-BO-4												
BO-5		FP-VAV-C9	RHV-OP	Reheat Valve Open	Off On	VAV			Z:BO-5		BO-a,BO-b,24VAC	EN-FPVAV	AI VAVBOX	01		FPVAV-x-BO-5					3/18	BLK,RED,WHT	VA-7150			U58		
BO-6		FP-VAV-C9	RHV-CL	Reheat Valve Close	Off On	VAV			Z:BO-6		BO-a,BO-b,24VAC	EN-FPVAV	AI VAVBOX	01		FPVAV-x-BO-6					3/18	BLK,RED,WHT	VA-7150			U58		
AO-1		FP-VAV-C9				VAV			Z:AO-1			EN-FPVAV	AI VAVBOX	01		FPVAV-x-AO-1												
AO-2		FP-VAV-C9				VAV			Z:AO-2			EN-FPVAV	AI VAVBOX	01		FPVAV-x-AO-2												

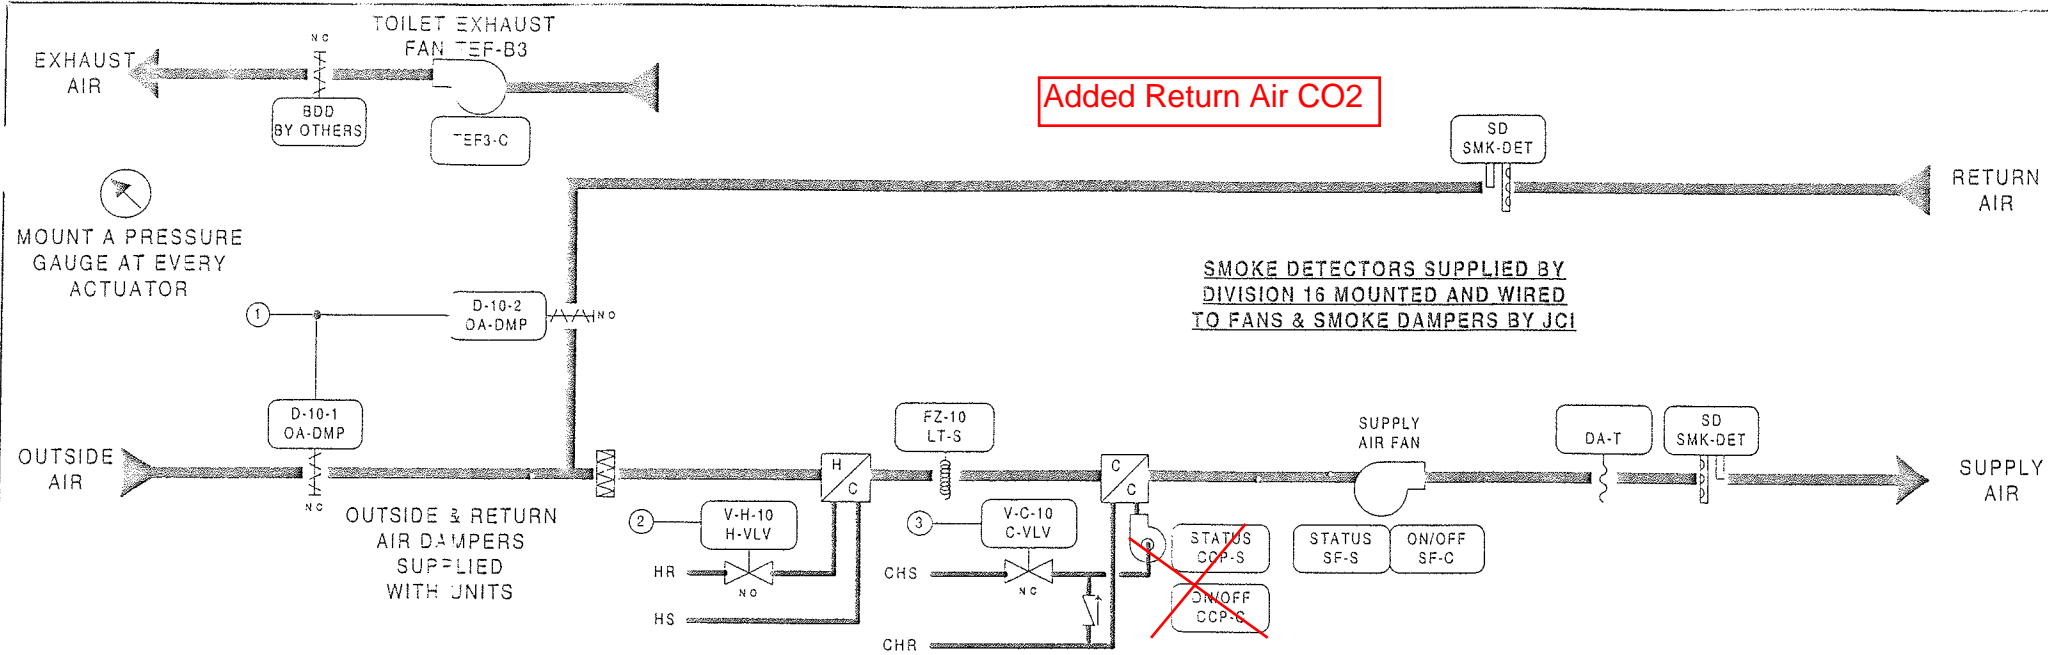

BILL OF MATERIALS

Estimate: ah-10 70520098.pre
 Desig. QtyPart # Description


Field Devices:

DA-T	1	TE-6315P-1	SENS, T-Ni, 0.13, 8' AVG
FZ-10	1	A70HA-1C	STAT, LL, 20', EL, MAN, 15/55F
H-VLV, C-VLV	1	--	SEE VALVE SCHEDULE
OA-DMP	2	D-3153-2	DMPR ACT, 8-13#
	2	G-2010-11	GAGE, 2", 0-30 PSIG, STEM
TEF-B3	1	BZ-1000-11	ENCL, 4-5/8X 5-1/8 X 3-3/8
	1	PD-101-35	RLY BASE, 3PDT, 11PIN, 10A
	1	PD-109-51	RELAY PLUG-IN 3PDT 24VAC
ZN-T	1	TE-6410W-1000	MSTAT, NI, BOX, JACK


Panel Devices:

EN-AHU-10	1	AS-UNT111-101	UNT111 MTD IN UPM, W/50VA
	2	EN-EXP101-0	UNIV PKG MOD, CVR & BACKBN
EP-1, 2	2	EP-8000-2	XDUCR, EP, 0/10V, HI VOL
EP-3	1	V11HGA-100	3-W SOLENOID, W/OV, 24 VAC
PI-1, 2, 3	3	G-2010-11	GAGE, 2", 0-30 PSIG, STEM
RLY-1	1	AS-RLY002-0	RELAY; 2SPDT 5 AMP 240VAC


SUPPLY FAN WIRING DIAGRAM

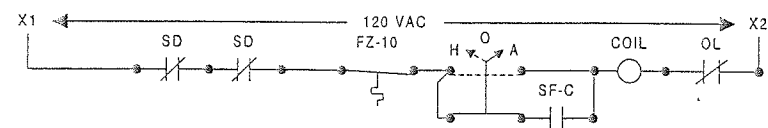

~~**COOLING COIL PUMP DIAGRAM**~~

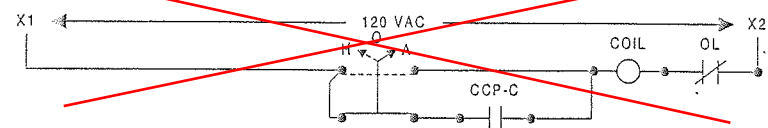

TOILET EXHAUST FAN DIAGRAM

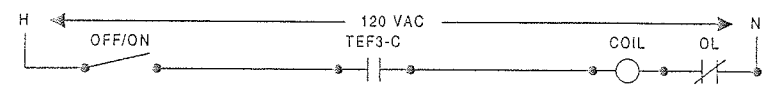

FAN	LOCATION	ELEC PANEL	CIRCUIT	LOCATION
TEF-B3	M CONCOURSE	STARTER		M CONCOURSE

DESCRIPTION OF OPERATION

THE METASYS SYSTEM WILL DETERMINE THE "OCCUPIED AND UNOCCUPIED" MODES OF OPERATION. OCCUPIED MODES GENERALLY OCCUR DURING STADIUM EVENTS, BUT MANUAL OVERRIDE THROUGH THE METASYS SYSTEM ON SELECTED UNITS WILL FREQUENTLY BE REQUIRED. WHEN THE UNIT IS DE-ENERGIZED, OUTSIDE AIR DAMPER D-10-1, AND COOLING COIL VALVE V-C-10, WILL CLOSE; COOLING COIL PUMP WILL BE OFF; RETURN AIR DAMPER D-10-2 WILL BE OPEN AND HEATING COIL VALVE V-H-10 WILL BE CLOSED TO THE COIL.

WARM-UP MODE - SUPPLY FAN WILL START AS DETERMINED BY THE OPTIMAL START PROGRAM OF THE METASYS SYSTEM. ON THE START OF THE UNIT, HEATING COIL VALVE V-H-10 WILL OPEN FULL TO COIL AND RETURN AIR DAMPER D-10-2 WILL BE FULLY OPEN WITH THE OUTSIDE AIR DAMPER D-10-1 CLOSED. EXHAUST FAN TEF-B3 WILL BE OFF AND EXHAUST AIR DAMPER D-10-3 (BDD) WILL BE CLOSED DURING THE WARM-UP MODE. DURATION OF THE WARM-UP MODE IS DETERMINED BY THE METASYS SYSTEM AND WILL BE DYNAMICALLY UPDATED TO END FIFTEEN (15) MINUTES PRIOR TO OCCUPANCY TIME. WARM-UP MODE IS STOPPED WHEN THE ZONE AIR TEMPERATURE REACHES THE SETTING OF TR-10 (70F).

OCCUPIED HEATING MODE - SUPPLY FAN WILL BE RUNNING, RETURN AIR DAMPER D-10-2 WILL CLOSE. OUTSIDE AIR DAMPER D-10-1 WILL OPEN AND EXHAUST FAN TEF-B3 WILL START AND RUN CONTINUOUSLY CAUSING EXHAUST AIR DAMPER D-10-3 (BDD) TO OPEN AFTER THE WARM-UP MODE IS STOPPED. ROOM SENSOR TR-10 THROUGH THE METASYS SYSTEM CONTROL UNIT, WILL ON A RISE IN TEMPERATURE ABOVE ITS SETTING OF FIFTY-FIVE (75F) MODULATE V-H-10 CLOSED TO THE HEATING COIL. COOLING COIL VALVE V-C-10, WILL BE CLOSED TO THE COIL AND COIL CIRCULATION PUMP WILL BE OFF DURING THE HEATING MODE.



UNOCCUPIED HEATING MODE - ROOM SENSOR TR-10, WILL ON A FALL IN TEMPERATURE TO ITS SETTING OF FIFTY (50F). ACTIVATE THE SYSTEM TO RUN IN THE WARM-UP MODE AS HEREIN BEFORE DESCRIBED. ON A RISE IN TEMPERATURE TO FIFTY-FIVE (55F), THE SYSTEM WILL BE DE-ENERGIZED. IN THE UNOCCUPIED MODE ALL AIR HANDLING UNIT DAMPERS AND CONTROLS WILL RETURN TO THEIR NORMAL POSITION READY FOR RESTARTING.

OCCUPIED COOLING MODE - SUPPLY AND EXHAUST FAN TEF-B3 AND COOLING COIL CIRCULATING PUMP START AND RUN CONTINUOUSLY. OUTSIDE DAMPER D-10-1 AND EXHAUST AIR DAMPER D-10-3 (BDD) WILL OPEN. ROOM SENSOR TR-10 THROUGH THE METASYS SYSTEM CONTROL UNIT, WILL MODULATE CHILLED WATER VALVE V-C-10 TO MAINTAIN ITS SETTING OF SEVENTY-FIVE (75F). THE HEATING COIL VALVE V-H-10, WILL BE CLOSED TO THE COIL.

UNOCCUPIED COOLING MODE - SYSTEM IS DE-ENERGIZED AND THE FANS ARE OFF.

SMOKE CONTROL - SMOKE DETECTORS WILL, ON THE DETECTION OF PRODUCTS OF COMBUSTION, SHUT DOWN THE SUPPLY AND EXHAUST FANS AND CLOSE ALL SYSTEM DAMPERS.

TOILET EXHAUST FAN TEF-B3 - THE FAN WILL START WHEN THE AHU SUPPLY FAN STARTS AND THE SYSTEM IS IN THE "OCCUPIED" MODE.

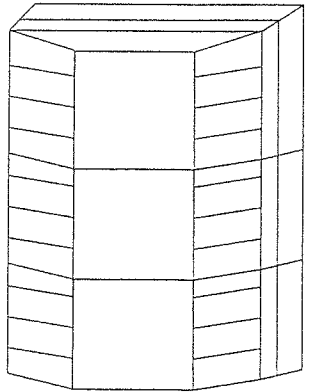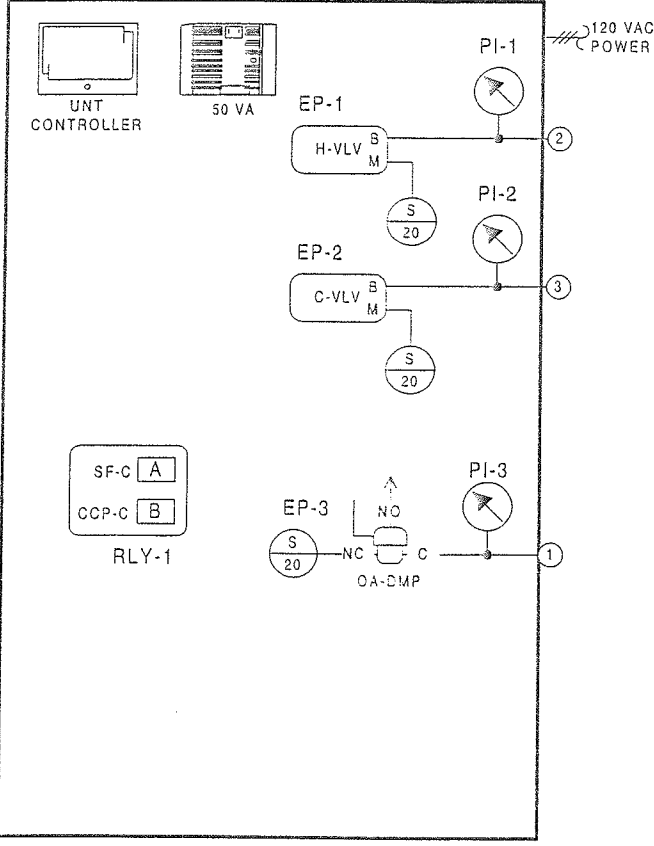


ENCLOSURE EN-AHU-10
 AS-UNT111-101
 LOCATED ADJACENT
 TO UNIT
 NCM-5/N2 ADD = 1

REVISION INFORMATION NUMBER DATE 07/18/00 TIME 03:09 PM FILE NAME AHU-10.vsd	IN CONSIDERATION OF THE RECEIPT OF THIS DOCUMENT, THE RECIPIENT AGREES NOT TO REPRODUCE, COPY, USE OR TRANSMIT THIS DOCUMENT AND/OR THE INFORMATION THEREIN CONTAINED, IN WHOLE OR IN PART, OR TO SUFFER SUCH ACTION BY OTHERS, FOR ANY PURPOSE, EXCEPT WITH THE WRITTEN PERMISSION OF JOHNSON CONTROLS, INC. AND FURTHER AGREES TO SURRENDER SAME TO JOHNSON CONTROLS, INC. UPON DEMAND. COPYRIGHT JOHNSON CONTROLS, INC. 1998	DRAWING TITLE AIR HANDLING UNIT AHU-10 GAME DAY SERVICES SERVICE LEVEL QUAD B PROJECT TITLE BALTIMORE NFL STADIUM AT CAMDEN YARDS BALTIMORE, MARYLAND	AS-BUILT REFERENCE DRAWING NO. REVISION-LOCATION ECN DATE BY Status Engineer JDP Project Manager WJT Application Engineer RTS DRAWN BY RTS DATE 09/02/97 APPROVED BY DATE Branch Information JOHNSON CONTROLS Systems & Services Division JOHNSON CONTROLS 60 LOVETON CIRCLE SPARKS, MD 21152 CONTRACT NUMBER 7052-0098 DRAWING NUMBER BL-6559-15
--	--	--	--

Full Spreadsheet		Software				Digital Controller Information					Panel Information				Intermediate Device				Field Device								
Tag	Point Type	System Name	Object Name	Expanded ID	Display Units	DC Type	N2 Trunk	N2 Addr	Cable Destination Bay/Terminal	Module Type	Termination	Panel	Panel Location	Slot Number	Reference Drawing	Cable Number	Wiring/Ubung	Termination In	Device	Termination Out	Location	Wiring/Ubung	Terminations	Device	Location	Ref Detail	Comment
		AHU-10				UNT						EN-AHU10	Service Level B		IM.2-01B												Power to Controller
		AHU-10				UNT	1	1				EN-AHU10	Service Level B		0IM.2-01B												N2 Trunk
AI-1		AHU-10	DA-T	Disch Air Temperature	Deg F	UNT		1	AI-1		AIR,AICM	EN-AHU10	Service Level B		0IM.2-01B	AHU10-1-AI-1					2/18	2-Wire	TE-6315P-1		U1		
AI-2		AHU-10				UNT		1	AI-2			EN-AHU10	Service Level B		0IM.2-01B	AHU10-1-AI-2											
AI-3		AHU-10				UNT		1	AI-3			EN-AHU10	Service Level B		0IM.2-01B	AHU10-1-AI-3											
AI-4		AHU-10	ZN-T	Zone Temperature	Deg F	UNT		1	AI-4		PHONE JACK	EN-AHU10	Service Level B		0IM.2-01B	AHU10-1-AI-4					8/26	TE-6410W-1000	TE-6410-		U2		
AI-5		AHU-10				UNT		1	AI-5			EN-AHU10	Service Level B		0IM.2-01B	AHU10-1-AI-5											
AI-6		AHU-10				UNT		1	AI-6			EN-AHU10	Service Level B		0IM.2-01B	AHU10-1-AI-6											
BI-1		AHU-10	SF-S	Supply Fan Status	Off On	UNT		1	BI-1		BI#,24VAC	EN-AHU10	Service Level B		0IM.2-01B	AHU10-1-BI-1					2/22	Device dependent	Aux Contact (NO)		U70		
BI-2		AHU-10	SMK-DET	Smoke Detectors	Normal Alarm	UNT		1	BI-2		BI#,24VAC	EN-AHU10	Service Level B		0IM.2-01B	AHU10-1-BI-2					2/22	Device dependent	Contact (NO)		U70		
BI-3		AHU-10	LT-S	Low Temperature Stat	Normal Alarm	UNT		1	BI-3		BI#,24VAC	EN-AHU10	Service Level B		0IM.2-01B	AHU10-1-BI-3					2/22	NOM1	A70 (NC)		U71		
BI-4		AHU-10	CCP-S	Clg Coil Pump 10 Status	Off On	UNT		1	BI-4		BI#,24VAC	EN-AHU10	Service Level B		0IM.2-01B	AHU10-1-BI-4					2/22	Device dependent	Aux Contact (NO)		U70		
BO-1		AHU-10	SF-C	Supply Fan Control	Off On	UNT		1	BO-1	RLY	BO#,24V,COM	EN-AHU10	Service Level B		0IM.2-01B	AHU10-1-BO-1	3/18	A.COILS.COM	RELAY-A	NO,COM		2/14	See starter detail	Starter (NO)-(sw lo)	U60		
BO-2		AHU-10	TEF3-C	Toilet Exh Fan B3 Cntrl	Off On	UNT		1	BO-2		BO#,24VAC	EN-AHU10	Service Level B		0IM.2-01B	AHU10-1-BO-2			PD-109-51			2/18	Device dependent	24VAC OUT (sw lo)	U51		
BO-3		AHU-10	OA-DMP	Outside Air Dampnr	Closed Open	UNT		1	BO-3		BO#,24VAC	EN-AHU10	Service Level B		0IM.2-01B	AHU10-1-BO-3			V11H3A-100			2/18	2-Wire	SAV-24VAC (sw lo)	U51		
BO-4		AHU-10	CCP-C	Clg Coil Pump 10 Control	Off On	UNT		1	BO-4	RLY	BO#,24V,COM	EN-AHU10	Service Level B		0IM.2-01B	AHU10-1-BO-4	3/18	B.COILS.COM	RELAY-B	NO,COM		2/14	See starter detail	Starter (NO)-(sw lo)	U60		
BO-5		AHU-10				UNT		1	BO-5			EN-AHU10	Service Level B		0IM.2-01B	AHU10-1-BO-5											
BO-6		AHU-10				UNT		1	BO-6			EN-AHU10	Service Level B		0IM.2-01B	AHU10-1-BO-6											
AO-1		AHU-10	H-VLV	Heating Coil Valve	% Open	UNT		1	AO-1		AO#,AOCM,24V	EN-AHU10	Service Level B		0IM.2-01B	AHU10-1-AO-1	2/18	+-	EP-6300-2	SUPPLY, O		3/18	Device dependent	0-10V OUT	U23		
AO-2		AHU-10	IC-VLV	Cooling Coil Valve	% Open	UNT		1	AO-2		AO#,AOCM,24V	EN-AHU10	Service Level B		0IM.2-01B	AHU10-1-AO-2	2/18	+-	EP-6300-2	SUPPLY, O		3/18	Device dependent	0-10V OUT	U23		


Estimate:	Qty	Part #	Description
ahu-11			
Desig.			
Field Devices:			
DA-T, RA-T	2	TE-6315P-1	SENS, T-NI, 0.1%, 8' AVG
DPR-C	3	D-3153-1	DMPR ACT, 8-13#, W/PILOT
	3	G-2010-11	GAGE, 2", 0-30 PSIG, STEM
FZ-11	1	A70HA-1C	STAT, LL, 20', EL, M/N, 15/55F
H-VLV, C-VLV	1	--	SEE VALVE SCHEDULE
SPC-11-1	1	R-317-1	CNTRLR DP, 0.05-1" WG
T-2	1	T-3610-10C1	STAT, LOW VOL, 8' AVG, DCT
TEF-B1	1	EZ-1000-11	ENCL, 4-5/8X 5-1/8 X 3-3/8
	1	PD-101-35	RLY BASE, 3PDT, 11PIN, 10A
	1	PD-109-51	RELAY PLUG-IN 3PDT 24VAC
ZN-T	1	TE-6410W-1000	MSTAT, NI, BOX, JACK
Panel Devices:			
EN-AHU-11	1	AS-AHU103-300	AHU TERM BD IN EWC35
	1	EN-EXP101-0	UNIV PKG MOD, CVR & BACKEN
EP-1, 2, 3	3	EP-8000-4	XDUCR, EP, 4-20ma, HI VOL
PI-1, 2, 3	3	G-2010-11	GAGE, 2", 0-30 PSIG, STEM
RLY-1	1	AS-RLY002-0	RELAY; 2SPDT 5 AMP 240VAC

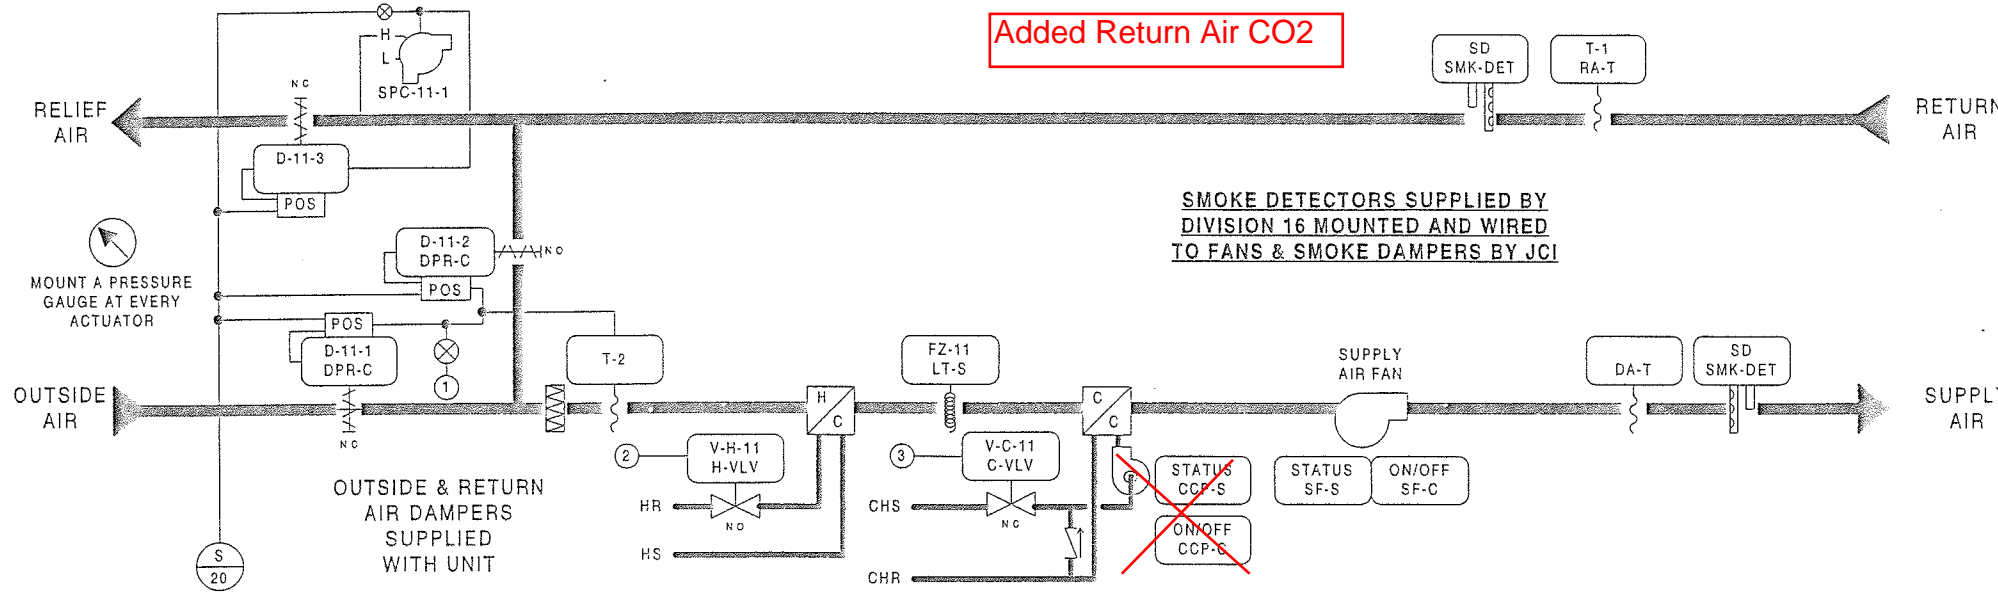


Added Return Air CO2

SMOKE DETECTORS SUPPLIED BY DIVISION 16 MOUNTED AND WIRED TO FANS & SMOKE DAMPERS BY JCI


SUPPLY FAN WIRING DIAGRAM

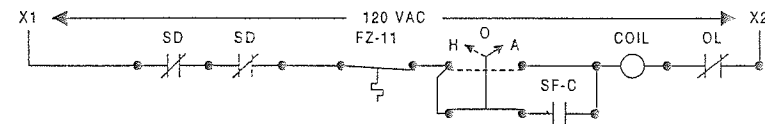

COOLING COIL PUMP DIAGRAM

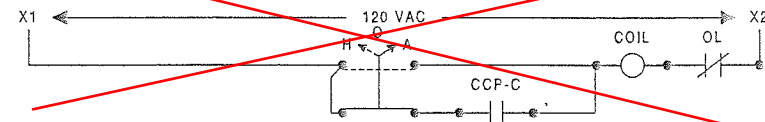

TOILET EXHAUST FAN DIAGRAM

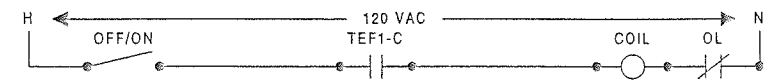

DESCRIPTION OF OPERATION

THE METASYS SYSTEM WILL DETERMINE THE "OCCUPIED AND UNOCCUPIED" MODES OF OPERATION. OCCUPIED MODES GENERALLY OCCUR DURING STADIUM EVENTS, BUT MANUAL OVERRIDE THROUGH THE METASYS SYSTEM ON SELECTED UNITS WILL FREQUENTLY BE REQUIRED. WHEN THE UNIT IS DE-ENERGIZED, OUTSIDE AND RELIEF AIR DAMPERS D-11-1, D-11-3 AND COOLING COIL VALVE V-C-11 WILL CLOSE; COOLING COIL PUMP WILL BE OFF; RETURN AIR DAMPER D-11-2 WILL BE OPEN AND HEATING COIL VALVE V-H-11 WILL BE CLOSED TO THE COIL.

WARM-UP MODE - SUPPLY FAN WILL START AS DETERMINED BY THE OPTIMAL START PROGRAM OF THE METASYS SYSTEM. ON THE START OF THE UNIT, HEATING COIL VALVE V-H-11 WILL OPEN FULL TO COIL AND RETURN AIR DAMPER D-11-2 WILL BE FULLY OPEN WITH THE OUTSIDE AIR DAMPERS D-11-1, AND RELIEF AIR DAMPER D-11-3 CLOSED. DURATION OF THE WARM-UP MODE IS DETERMINED BY THE METASYS SYSTEM AND WILL BE DYNAMICALLY UPDATED TO END FIFTEEN (15) MINUTES PRIOR TO OCCUPANCY TIME. WARM-UP MODE IS STOPPED WHEN RETURN AIR TEMPERATURE REACHES THE SETTING OF T-1 (70F).

OCCUPIED HEATING MODE - SUPPLY FAN WILL BE RUNNING, RETURN AIR DAMPER D-11-2 IS OPEN. OUTSIDE AIR DAMPER D-11-1 WILL OPEN ITS MINIMUM OPEN POSITION AFTER THE WARM-UP MODE IS STOPPED. ROOM SENSOR TR-11, THROUGH THE METASYS SYSTEM CONTROL UNIT, WILL ON A RISE IN TEMPERATURE ABOVE ITS SETTING OF SEVENTY-FIVE (75F) MODULATE V-H-11 CLOSED TO THE HEATING COIL. ON A FURTHER RISE, TR-11 WILL GRADUALLY MODULATE DAMPER D-11-1 OPEN WHILE SIMULTANEOUSLY CLOSING D-11-2. STATIC PRESSURE CONTROLLER SPC-11-1 LOCATED IN THE ENTERING SIDE OF THE RELIEF DAMPER WILL OVERRIDE THE CONTROL AND MODULATE D-11-3 TO MAINTAIN ITS SETTING TO ENSURE A POSITIVE BUILDING PRESSURE. LOW LIMIT THERMOSTAT T-2, SENSITIVE TO THE COLDEST SPOT IN THE AIR STREAM, WILL OVERRIDE TR-11 TO PREVENT MIXED AIR FROM FALLING BELOW ITS SETTING OF FORTY (40F). ON A FALL IN TEMPERATURE, THE REVERSE WILL OCCUR. COOLING COIL VALVE V-C-11 WILL BE CLOSED TO THE COIL AND COIL CIRCULATION PUMP WILL BE OFF DURING THE HEATING MODE.



UNOCCUPIED HEATING MODE - ROOM SENSOR TR-11 WILL ON A FALL IN TEMPERATURE TO ITS SETTING OF FIFTY (50) ACTIVATE SYSTEM TO RUN IN THE WARM-UP MODE AS HEREINBEFORE DESCRIBED. ON A RISE IN TEMPERATURE TO FIFTY-FIVE (55), THE SYSTEM WILL BE DE-ENERGIZED. IN THE UNOCCUPIED MODE ALL AIR HANDLING UNIT DAMPERS AND CONTROLS WILL RETURN TO THEIR NORMAL POSITION READY FOR RESTARTING.

OCCUPIED COOLING MODE - SUPPLY FAN AND COOLING COIL CIRCULATING PUMP START AND RUN CONTINUOUSLY. OUTSIDE DAMPER D-11-1 AND RETURN DAMPER D-11-2 WILL, THROUGH THE METASYS SYSTEM CONTROL UNIT, BE UNDER FLOATING DRY BULB DIFFERENTIAL CONTROL WHICH WILL COMPARE THE TEMPERATURE OF THE RETURN AND OUTSIDE AIR STREAMS. THE OUTSIDE AIR WILL BE UTILIZED WHENEVER IT IS GREATER THAN SEVEN (7F) LESS THAN THE RETURN AIR TEMPERATURE. WHEN THE DIFFERENTIAL FALLS BELOW SEVEN (7F), OUTSIDE AIR DAMPERS D-11-1 WILL CLOSE, OPENING RETURN AIR DAMPER D-11-2. ROOM SENSOR TR-11, THROUGH THE METASYS SYSTEM CONTROL UNIT, WILL IN SEQUENCE MODULATE OUTSIDE AND RETURN DAMPERS D-11-1 AND D-11-2 AND CHILLED WATER VALVE V-C-11 TO MAINTAIN ITS SETTING OF FORTY-FIVE (45F). HEATING COIL VALVE V-H-11 WILL REMAIN CLOSED TO THE COIL.

UNOCCUPIED COOLING MODE - SYSTEM IS DE-ENERGIZED AND THE FANS ARE OFF.

SMOKE CONTROL - SMOKE DETECTORS WILL, ON THE DETECTION OF PRODUCTS OF COMBUSTION, SHUT DOWN THE SUPPLY FAN AND CLOSE ALL SYSTEM DAMPERS.

TOILET EXHAUST FAN TEF-B1 - FAN WILL START WHEN THE AHU SUPPLY FAN IS STARTED AND THE SYSTEM IS IN THE "OCCUPIED" MODE.

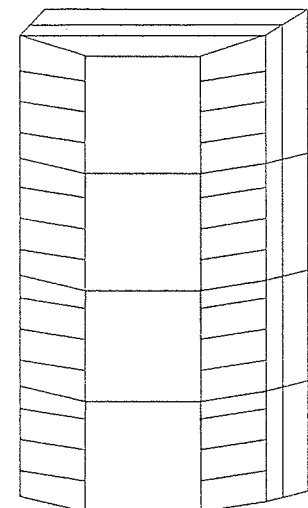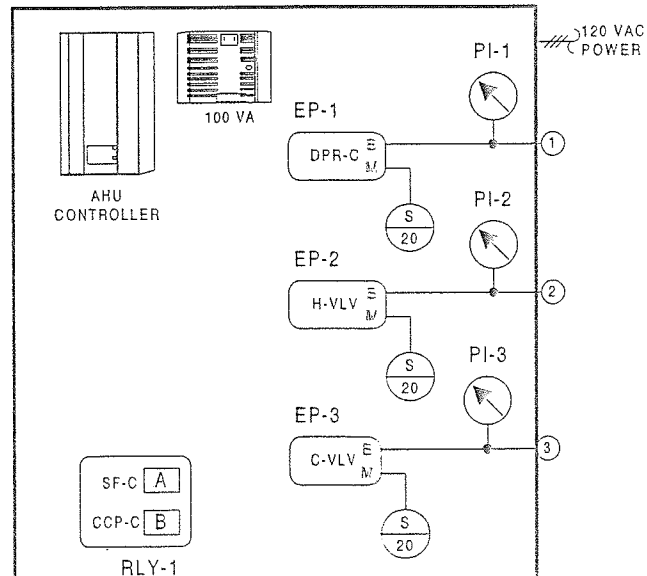

ENCLOSURE EN-AHU-11 AS-AHU103-300 LOCATED ADJACENT TO UNIT NCM-5/N2 ADD = 2

FAN	LOCATION	ELEC PANEL	CIRCUIT	LOCATION
TEF-B1	SERVICE LEVEL	RP2SRB	51	SERVICE LEVEL

<p>REVISION INFORMATION</p> <p>NUMBER</p> <p>DATE 07/18/00</p> <p>TIME 03:10 PM</p> <p>FILE NAME AHU-11.VSD</p>	<p>IN CONSIDERATION OF THE RECEIPT OF THIS DOCUMENT, THE RECIPIENT AGREES NOT TO REPRODUCE, COPY, USE OR TRANSMIT THIS DOCUMENT AND/OR THE INFORMATION THEREIN CONTAINED, IN WHOLE OR IN PART, OR TO SUFFER SUCH ACTION BY OTHERS, FOR ANY PURPOSE, EXCEPT WITH THE WRITTEN PERMISSION OF JOHNSON CONTROLS, INC. AND FURTHER AGREES TO SURRENDER SAME TO JOHNSON CONTROLS, INC. UPON DEMAND.</p> <p>COPYRIGHT JOHNSON CONTROLS, INC. 1999</p>	<p>DRAWING TITLE</p> <p>AIR HANDLING UNIT AHU-11 STADIUM OPERATIONS</p> <p>SERVICE LEVEL QUAD B</p> <p>PROJECT TITLE</p> <p>BALTIMORE NFL STADIUM AT CAMDEN YARDS</p> <p>BALTIMORE, MARYLAND</p>	<p>AS-BUILT</p> <p>7/18/00 CME</p> <p>REFERENCE DRAWING</p> <p>NO</p> <p>REVISION LOCATION</p> <p>ECN DATE BY</p> <p>SALES ENGINEER JDP PROJECT MANAGER WJT APPLICATION ENGINEER RTS</p> <p>BY RTS DATE 09/02/97</p> <p>APPROVED</p> <p>DATE</p> <p>BRAND INFORMATION</p> <p>CONTRACT NUMBER</p> <p>7052-0098</p> <p>DRAWING NUMBER</p> <p>BL-0559-16</p>
---	---	--	---


Full Spreadsheet		Software				Digital Controller Information					Panel Information				Intermediate Device				Field Device			Ref Detail	Comment				
Tag	Point Type	System Name	Object Name	Expanded ID	Display Units	DC Type	N2 Trunk	N2 Addr	Cable Destination Bay/Terminal	Module Type	Termination	Panel	Panel Location	Slot Number	Reference Drawing	Cable Number	Wiring/ tubing	Termination In	Device	Termination Out	Location	Wiring/ tubing	Terminations	Device	Location	Ref Detail	Comment
		AHU-12				AHU		3				EN-AHU12	Service Level B		IM.2-01B												Power to Controller
		AHU-12				AHU	1	3				EN-AHU12	Service Level B		0IM.2-01B												N2 Trunk
BO-1	AHU-12	SF-C	Supply Fan Control		Off On	AHU	1	3	BO-1	RLY	BO#,24V,BICOM	EN-AHU12	Service Level B		0IM.2-01B	AHU12-3-BO-1	3/18	A.COILS.COM	RELAY-A	COM,NO		12/14	See starter detail	Starter (NO)		A53	
BO-2	AHU-12	TEF2-C	Toilet Exh Fan B2 Control		Off On	AHU	1	3	BO-2		BO#,24V	EN-AHU12	Service Level B		0IM.2-01B	AHU12-3-BO-2			PD-109-51			12/18	Device dependent	24VAC OUT		A50	
BO-3	AHU-12	CCP-C	Clg Coil Pump 12 Control		Off On	AHU	1	3	BO-3	RLY	BO#,24V,BICOM	EN-AHU12	Service Level B		0IM.2-01B	AHU12-3-BO-3	3/18	B.COILS.COM	RELAY-E	COM,NO		12/14	See starter detail	Starter (NO)		A53	
BO-4	AHU-12					AHU	1	3	BO-4			EN-AHU12	Service Level B		0IM.2-01B	AHU12-3-BO-4											
BO-5	AHU-12					AHU	1	3	BO-5			EN-AHU12	Service Level B		0IM.2-01B	AHU12-3-BO-5											
BO-6	AHU-12					AHU	1	3	BO-6			EN-AHU12	Service Level B		0IM.2-01B	AHU12-3-BO-6											
BO-7	AHU-12					AHU	1	3	BO-7			EN-AHU12	Service Level B		0IM.2-01B	AHU12-3-BO-7											
BO-8	AHU-12					AHU	1	3	BO-8			EN-AHU12	Service Level B		0IM.2-01B	AHU12-3-BO-8											
BO-9	AHU-12					AHU	1	3	BO-9			EN-AHU12	Service Level B		0IM.2-01B	AHU12-3-BO-9											
BO-10	AHU-12					AHU	1	3	BO-10			EN-AHU12	Service Level B		0IM.2-01B	AHU12-3-BO-10											
AO-1	AHU-12	DPR-C	Damper Control		% Open	AHU	1	3	AO-1		AO#,AOCOM	EN-AHU12	Service Level B		0IM.2-01B	AHU12-3-AO-1	2/18	+	EP-8000-4	SUPPLY,O		1/4"	Barb Fitting	EP-PNEU.		A28	
AO-2	AHU-12	H-VLV	Heating Coil Valve		% Open	AHU	1	3	AO-2		AO#,AOCOM	EN-AHU12	Service Level B		0IM.2-01B	AHU12-3-AO-2	2/18	+	EP-8000-4	SUPPLY,O		1/4"	Barb Fitting	EP-PNEU.		A28	
AO-3	AHU-12	C-VLV	Cooling Coil Valve		% Open	AHU	1	3	AO-3		AO#,AOCOM	EN-AHU12	Service Level B		0IM.2-01B	AHU12-3-AO-3	2/18	+	EP-8000-4	SUPPLY,O		1/4"	Barb Fitting	EP-PNEU.		A28	
AO-4	AHU-12					AHU	1	3	AO-4			EN-AHU12	Service Level B		0IM.2-01B	AHU12-3-AO-4											
AO-5	AHU-12					AHU	1	3	AO-5			EN-AHU12	Service Level B		0IM.2-01B	AHU12-3-AO-5											
AO-6	AHU-12					AHU	1	3	AO-6			EN-AHU12	Service Level B		0IM.2-01B	AHU12-3-AO-6											
BI-1	AHU-12	SF-S	Supply Fan Status		Off On	AHU	1	3	BI-1		BI#,BICOM	EN-AHU12	Service Level B		0IM.2-01B	AHU12-3-BI-1						2/22	Device dependent	Aux Contact (NO)		A40	
BI-2	AHU-12	SMK-DET	Smoke Detectors		Normal Alarm	AHU	1	3	BI-2		BI#,BICOM	EN-AHU12	Service Level B		0IM.2-01B	AHU12-3-BI-2						2/22	Device dependent	Contact (NO)		A40	
BI-3	AHU-12	LT-S	Low Temperature Stat		Normal Alarm	AHU	1	3	BI-3		BI#,BICOM	EN-AHU12	Service Level B		0IM.2-01B	AHU12-3-BI-3						2/22	NO,M1	A70 (NC)		A41	
BI-4	AHU-12	CCP-S	Clg Coil Pump 12 Status		Off On	AHU	1	3	BI-4		BI#,BICOM	EN-AHU12	Service Level B		0IM.2-01B	AHU12-3-BI-4						2/22	Device dependent	Aux Contact (NO)		A40	
BI-5	AHU-12					AHU	1	3	BI-5			EN-AHU12	Service Level B		0IM.2-01B	AHU12-3-BI-5											
BI-6	AHU-12					AHU	1	3	BI-6			EN-AHU12	Service Level B		0IM.2-01B	AHU12-3-BI-6											
BI-7	AHU-12					AHU	1	3	BI-7			EN-AHU12	Service Level B		0IM.2-01B	AHU12-3-BI-7											
BI-8	AHU-12					AHU	1	3	BI-8			EN-AHU12	Service Level B		0IM.2-01B	AHU12-3-BI-8											
AI-1	AHU-12	DA-T	Disch Air Temperature		Deg F	AHU	1	3	AI-1		AI#,AICM	EN-AHU12	Service Level B		0IM.2-01B	AHU12-3-AI-1						2/18	2-Wire	TE-6315P-1		A4	
AI-2	AHU-12	RA-T	Return Air Temperature		Deg F	AHU	1	3	AI-2		AI#,AICM	EN-AHU12	Service Level B		0IM.2-01B	AHU12-3-AI-2						2/18	2-Wire	TE-6315P-1		A4	
AI-3	AHU-12					AHU	1	3	AI-3			EN-AHU12	Service Level B		0IM.2-01B	AHU12-3-AI-3											
AI-4	AHU-12	ZN-T	Zone Temperature		Deg F	AHU	1	3	AI-4		PHONE JACK	EN-AHU12	Service Level B		0IM.2-01B	AHU12-3-AI-4						8/26	PHONE JACK	TE-6410W-1000		A5	
AI-5	AHU-12					AHU	1	3	AI-5			EN-AHU12	Service Level B		0IM.2-01B	AHU12-3-AI-5											
AI-6	AHU-12					AHU	1	3	AI-6			EN-AHU12	Service Level B		0IM.2-01B	AHU12-3-AI-6											
AI-7	AHU-12					AHU	1	3	AI-7			EN-AHU12	Service Level B		0IM.2-01B	AHU12-3-AI-7											
AI-8	AHU-12					AHU	1	3	AI-8			EN-AHU12	Service Level B		0IM.2-01B	AHU12-3-AI-8											

Estimate: ahu-13
Desig. QtyPart # Description 70520096.pre


Field Devices:

DA-T,RA-T	2	TE-6315P-1	SENS,T-Ni,0.1%,8' AVG
DPR-C	3	D-3153-1	DMPR ACT,8-13#,W/PILOT
FZ-13	1	G-2010-11	GAGE,2",0-30 PSIG,STEM
H-VLV,C-VLV	1	A70HA-1C	STAT,LL,20",EL,MAN,15/55F
SPC-13-1	1	F-317-1	SEE VALVE SCHEDULE
T-2	1	T-3610-1001	CNTRLR DP,0.05-1"WG
TEF-B4,SEF-3	3	EZ-1000-11	STAT,LOW VOL,8' AVG, DCT
SEF-4	3	PD-101-35	ENCL,4-5/8X 5-1/8 X 3-3/8
	3	PD-109-51	FLY BASE,3PDT,11PIN,10A
ZN-T	1	TE-6410W-1000	RELAY PLUG-IN 3PDT 24VAC
			MSTAT,NI,BOX,JACK
Panel Devices:			
EN-AHU-13	1	AS-AHU103-300	AHU TERM BD IN ENC35
	1	EN-EXP101-0	UNIV PKG MOD,CVR & BACKBN
EP-1,2,3	3	EP-8000-4	XDUCR,EP,4-20ma,HI VOL
PI-1,2,3	3	G-2010-11	GAGE,2",0-30 PSIG,STEM
RLY-1	1	AS-RLY002-0	RELAY; 2SPDT 5 AMP 240VAC


SMOKE DETECTORS SUPPLIED BY DIVISION 16 MOUNTED AND WIRED TO FANS & SMOKE DAMPERS BY JCI

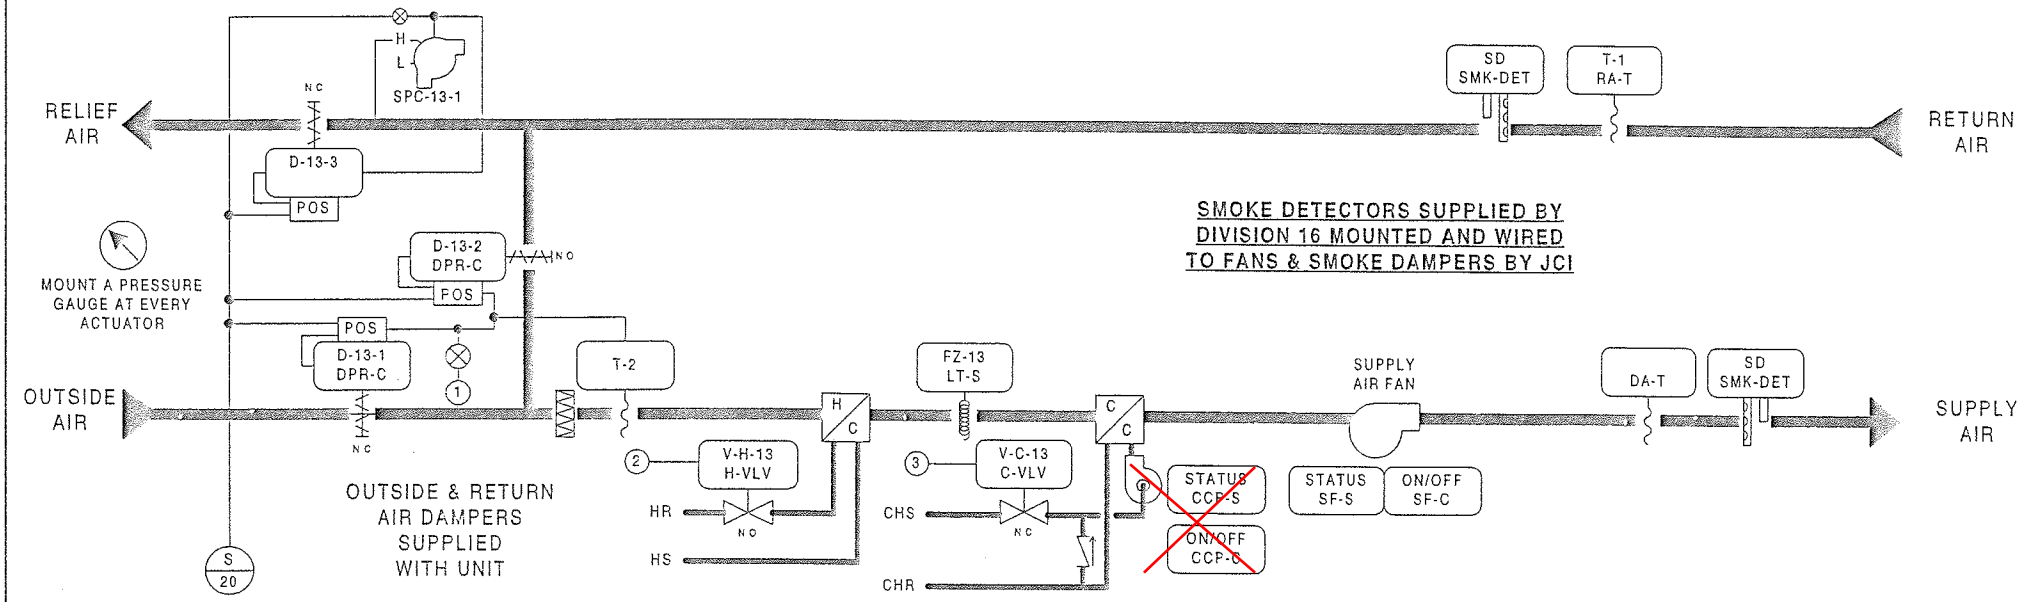


SUPPLY FAN WIRING DIAGRAM

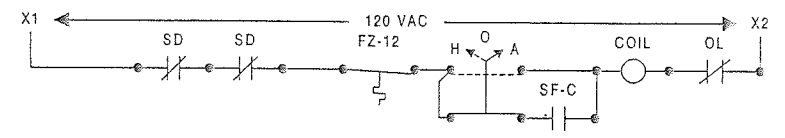

~~COOLING COIL PUMP DIAGRAM~~

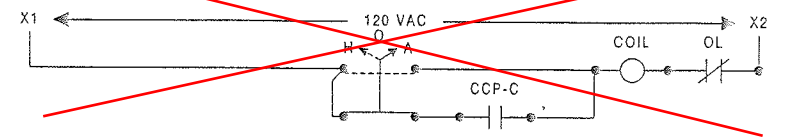

TOILET EXHAUST FAN DIAGRAM

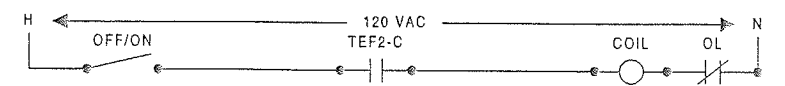

DESCRIPTION OF OPERATION

THE METASYS SYSTEM WILL DETERMINE THE "OCCUPIED AND UNOCCUPIED" MODES OF OPERATION. OCCUPIED MODES GENERALLY OCCUR DURING STADIUM EVENTS, BUT MANUAL OVERRIDE THROUGH THE METASYS SYSTEM ON SELECTED UNITS WILL FREQUENTLY BE REQUIRED. WHEN THE UNIT IS DE-ENERGIZED, OUTSIDE AND RELIEF AIR DAMPERS D-13-1, D-13-3 AND COOLING COIL VALVE V-C-13 WILL CLOSE; COOLING COIL PUMP WILL BE OFF; RETURN AIR DAMPER D-13-2 WILL BE OPEN AND HEATING COIL VALVE V-H-13 WILL BE CLOSED TO THE COIL.

WARM-UP MODE - SUPPLY FAN WILL START AS DETERMINED BY THE OPTIMAL START PROGRAM OF THE METASYS SYSTEM. ON THE START OF THE UNIT, HEATING COIL VALVE V-H-13 WILL OPEN FULL TO COIL AND RETURN AIR DAMPER D-13-2 WILL BE FULLY OPEN WITH THE OUTSIDE AIR DAMPERS D-13-1, AND RELIEF AIR DAMPER D-13-3 CLOSED. DURATION OF THE WARM-UP MODE IS DETERMINED BY THE METASYS SYSTEM AND WILL BE DYNAMICALLY UPDATED TO END FIFTEEN (15) MINUTES PRIOR TO OCCUPANCY TIME. WARM-UP MODE IS STOPPED WHEN RETURN AIR TEMPERATURE REACHES THE SETTING OF T-1 (70F).

OCCUPIED HEATING MODE - SUPPLY FAN WILL BE RUNNING, RETURN AIR DAMPER D-13-2 IS OPEN. OUTSIDE AIR DAMPER D-13-1 WILL OPEN ITS MINIMUM OPEN POSITION AFTER THE WARM-UP MODE IS STOPPED. ROOM SENSOR TR-13, THROUGH THE METASYS SYSTEM CONTROL UNIT, WILL ON A RISE IN TEMPERATURE ABOVE ITS SETTING OF SEVENTY-FIVE (75F) MODULATE V-H-13 CLOSED TO THE HEATING COIL. ON A FURTHER RISE, TR-13 WILL GRADUALLY MODULATE DAMPER D-13-1 OPEN WHILE SIMULTANEOUSLY CLOSING D-13-2. STATIC PRESSURE CONTROLLER SPC-13-1 LOCATED IN THE ENTERING SIDE OF THE RELIEF DAMPER WILL OVERRIDE THE CONTROL AND MODULATE D-13-3 TO MAINTAIN ITS SETTING TO ENSURE A POSITIVE BUILDING PRESSURE. LOW LIMIT THERMOSTAT T-2, SENSITIVE TO THE COLDEST SPOT IN THE AIR STREAM, WILL OVERRIDE TR-13 TO PREVENT MIXED AIR FROM FALLING BELOW ITS SETTING OF FORTY (40F). ON A FALL IN TEMPERATURE, THE REVERSE WILL OCCUR. COOLING COIL VALVE V-C-13 WILL BE CLOSED TO THE COIL AND COIL CIRCULATION PUMP WILL BE OFF DURING THE HEATING MODE.

UNOCCUPIED HEATING MODE - ROOM SENSOR TR-13 WILL ON A FALL IN TEMPERATURE TO ITS SETTING OF FIFTY (50) ACTIVATE SYSTEM TO RUN IN THE WARM-UP MODE AS HEREINBEFORE DESCRIBED. ON A RISE IN TEMPERATURE TO FIFTY-FIVE (55), THE SYSTEM WILL BE DE-ENERGIZED. IN THE UNOCCUPIED MODE ALL AIR HANDLING UNIT DAMPERS AND CONTROLS WILL RETURN TO THEIR NORMAL POSITION READY FOR RESTARTING.



OCCUPIED COOLING MODE - SUPPLY FAN AND COOLING COIL CIRCULATING PUMP START AND RUN CONTINUOUSLY. OUTSIDE DAMPER D-13-1 AND RETURN DAMPER D-13-2 WILL, THROUGH THE METASYS SYSTEM CONTROL UNIT, BE UNDER FLOATING DRY BULB DIFFERENTIAL CONTROL WHICH WILL COMPARE THE TEMPERATURE OF THE RETURN AND OUTSIDE AIR STREAMS. THE OUTSIDE AIR WILL BE UTILIZED WHENEVER IT IS GREATER THAN SEVEN (7F) LESS THAN THE RETURN AIR TEMPERATURE. WHEN THE DIFFERENTIAL FALLS BELOW SEVEN (7F), OUTSIDE AIR DAMPERS D-13-1 WILL CLOSE, OPENING RETURN AIR DAMPER D-13-2. ROOM SENSOR TR-13, THROUGH THE METASYS SYSTEM CONTROL UNIT, WILL IN SEQUENCE MODULATE OUTSIDE AND RETURN DAMPERS D-13-1 AND D-13-2 AND CHILLED WATER VALVE V-C-13 TO MAINTAIN ITS SETTING OF FORTY-FIVE (45F). HEATING COIL VALVE V-H-13 WILL REMAIN CLOSED TO THE COIL.

UNOCCUPIED COOLING MODE - SYSTEM IS DE-ENERGIZED AND THE FANS ARE OFF.

SMOKE CONTROL - SMOKE DETECTORS WILL, ON THE DETECTION OF PRODUCTS OF COMBUSTION, SHUT DOWN THE SUPPLY FAN AND CLOSE ALL SYSTEM DAMPERS.

TOILET EXHAUST FAN TEF-B4 - FAN WILL START WHEN THE AHU SUPPLY FAN IS STARTED AND THE SYSTEM IS IN THE "OCCUPIED" MODE.

SMOKE EXHAUST FANS SEF-3,SEF-4 - LEAD FAN WILL START WHEN HVU-11, HVU-12 OR HVU-13 SUPPLY FANS ARE STARTED. SEE DRAWINGS FOR INDIVIDUAL HVU CONTROLS.

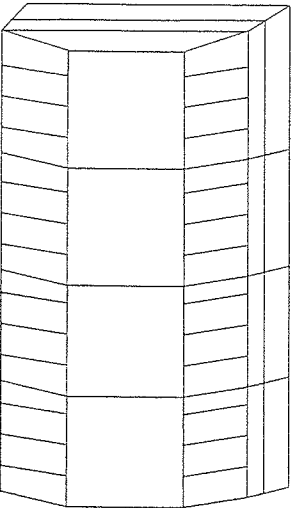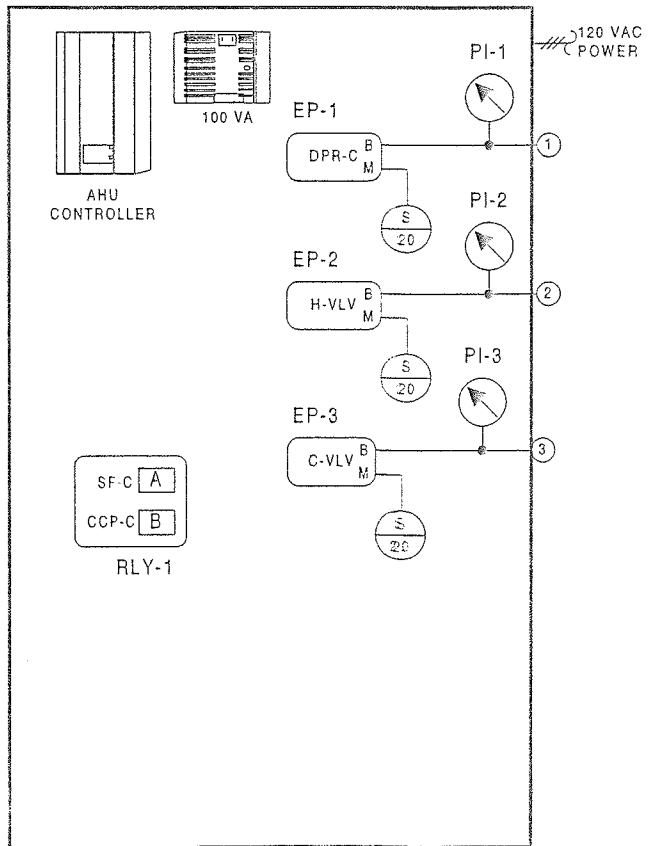


ENCLOSURE EN-AHU-13 AS-AHU103-300 LOCATED ADJACENT TO UNIT NCM-5/N2 ADD = 4

FAN	LOCATION	ELEC PANEL	CIRCUIT	LOCATION
TEF-B4	SERVICE LEVEL	RP2SRB	45	SERVICE LEVEL
SEF-3	SERVICE LEVEL	STARTER		SERVICE LEVEL
SEF-4	SERVICE LEVEL	STARTER		SERVICE LEVEL

<p>REVISION INFORMATION</p> <p>NUMBER</p> <p>DATE 07/18/00</p> <p>TIME 03:15 PM</p> <p>FILE NAME AHU-13.vsd</p>	<p>IN CONSIDERATION OF THE RECEIPT OF THIS DOCUMENT, THE RECIPIENT AGREES NOT TO REPRODUCE, COPY, USE OR TRANSMIT THIS DOCUMENT AND/OR THE INFORMATION THEREIN CONTAINED, IN WHOLE OR IN PART, OR TO SUFFER SUCH ACTION BY OTHERS, FOR ANY PURPOSE, EXCEPT WITH THE WRITTEN PERMISSION OF JOHNSON CONTROLS, INC. AND FURTHER AGREES TO SURRENDER SAME TO JOHNSON CONTROLS, INC. UPON DEMAND.</p> <p>COPYRIGHT JOHNSON CONTROLS, INC. 1999</p>	<p>DRAWING TITLE</p> <p>AIR HANDLING UNIT AHU-13 SECURITY</p> <p>SERVICE LEVEL QUAD B</p> <p>PROJECT TITLE</p> <p>BALTIMORE NFL STADIUM AT CAMDEN YARDS</p> <p>BALTIMORE, MARYLAND</p>	<p>AS-BUILT</p> <p>7/18/00 CME</p> <p>REFERENCE DRAWING NO. REVISION/LOCATION ECA DATE</p> <p>Sales Engineer JDP Project Manager WJT Application Engineer RTS</p> <p>BY DATE 09/02/97</p> <p>APPROVE</p> <p>JOHNSON CONTROLS</p> <p>Systems & Services Division</p> <p>JOHNSON CONTROLS 60 LOVETON CIRCLE SPARKS, MD 21152</p> <p>CONTRACT NUMBER 7052-0098</p> <p>DRAWING NUMBER EL-6559-18</p>
---	---	--	--

Full Spreadsheet		Software				Digital Controller Information					Panel Information				Intermediate Device				Field Device				Ref Detail	Comment			
Tag	Point Type	System Name	Object Name	Expanded ID	Display Units	DC Type	N2 Trunk	N2 Addr	Cable Destination Bay/Terminal	Module Type	Termination	Panel	Panel Location	Slot Number	Reference Drawing	Cable Number	Wiring/ubing	Termination In	Device	Termination Out	Location	Wiring/ubing	Terminations	Device	Location	Ref Detail	Comment
		AHU-13				AHU						EN-AHU13	Service Level B		IM.2-01B												Power to Controller
		AHU-13				AHU		4				EN-AHU13	Service Level B		0:M.2-01B												N2 Trunk
BO-1		AHU-13	SF-C	Supply Fan Control	Off On	AHU		4	BO-1	RLY	BO#,24V,BICOM	EN-AHU13	Service Level B		0:M.2-01B	AHU13-4-BO-1	13/18	A,COILS,COM	RELAY-A	COM,NO		2/14	See starter detail	Starter (NO)		A53	
BO-2		AHU-13	TEF4-C	Toilet Exh Fan B4 Control	Off On	AHU		4	BO-2		BO#,24V	EN-AHU13	Service Level B		0:M.2-01B	AHU13-4-BO-2			PD-109-51			2/18	Device dependent	24VAC OUT		A50	
BO-3		AHU-13	CCP-C	Cig Coil Pump 13 Control	Off On	AHU		4	BO-3	RLY	BO#,24V,BICOM	EN-AHU13	Service Level B		0:M.2-01B	AHU13-4-BO-3	13/18	A,COILS,COM	RELAY-A	COM,NO		2/14	See starter detail	Starter (NO)		A53	
BO-4		AHU-13	SEF3-C	Smoke Exh Fan 3 Control	Off On	AHU		4	BO-4		BO#,24V	EN-AHU13	Service Level B		0:M.2-01B	AHU13-4-BO-4			PD-109-51			2/18	Device dependent	24VAC OUT		A50	
BO-5		AHU-13	SEF4-C	Smoke Exh Fan 4 Control	Off On	AHU		4	BO-5		BO#,24V	EN-AHU13	Service Level B		0:M.2-01B	AHU13-4-BO-5			PD-109-51			2/18	Device dependent	24VAC OUT		A50	
BO-6		AHU-13				AHU		4	BO-6			EN-AHU13	Service Level B		0:M.2-01B	AHU13-4-BO-6											
BO-7		AHU-13				AHU		4	BO-7			EN-AHU13	Service Level B		0:M.2-01B	AHU13-4-BO-7											
BO-8		AHU-13				AHU		4	BO-8			EN-AHU13	Service Level B		0:M.2-01B	AHU13-4-BO-8											
BO-9		AHU-13				AHU		4	BO-9			EN-AHU13	Service Level B		0:M.2-01B	AHU13-4-BO-9											
BO-10		AHU-13				AHU		4	BO-10			EN-AHU13	Service Level B		0:M.2-01B	AHU13-4-BO-10											
AO-1		AHU-13	DPR-C	Damper Control	% Open	AHU		4	AO-1		AO#,AOCOM	EN-AHU13	Service Level B		0:M.2-01B	AHU13-4-AO-1	12/18	+,	EP-8000-4	SUPPLY,O		1/4"	Barb Fitting	EP-PNEU.		A28	
AO-2		AHU-13	H-VLV	Heating Coil Valve	% Open	AHU		4	AO-2		AO#,AOCOM	EN-AHU13	Service Level B		0:M.2-01B	AHU13-4-AO-2	12/18	+,	EP-8000-4	SUPPLY,O		1/4"	Barb Fitting	EP-PNEU.		A28	
AO-3		AHU-13	C-VLV	Cooling Coil Valve	% Open	AHU		4	AO-3		AO#,AOCOM	EN-AHU13	Service Level B		0:M.2-01B	AHU13-4-AO-3	12/18	+,	EP-8000-4	SUPPLY,O		1/4"	Barb Fitting	EP-PNEU.		A28	
AO-4		AHU-13				AHU		4	AO-4			EN-AHU13	Service Level B		0:M.2-01B	AHU13-4-AO-4											
AO-5		AHU-13				AHU		4	AO-5			EN-AHU13	Service Level B		0:M.2-01B	AHU13-4-AO-5											
AO-6		AHU-13				AHU		4	AO-6			EN-AHU13	Service Level B		0:M.2-01B	AHU13-4-AO-6											
BI-1		AHU-13	SF-S	Supply Fan Status	Off On	AHU		4	BI-1		BI#,BICOM	EN-AHU13	Service Level B		0:M.2-01B	AHU13-4-BI-1						2/22	Device dependent	Aux Contact (NO)		A40	
BI-2		AHU-13	SMK-DET	Smoke Detectors	Normal Alarm	AHU		4	BI-2		BI#,BICOM	EN-AHU13	Service Level B		0:M.2-01B	AHU13-4-BI-2						2/22	Device dependent	Contact (NO)		A40	
BI-3		AHU-13	LT-S	Low Temperature Stat	Normal Alarm	AHU		4	BI-3		BI#,BICOM	EN-AHU13	Service Level B		0:M.2-01B	AHU13-4-BI-3						2/22	NO,M1	A70 (NC)		A41	
BI-4		AHU-13	CCP-S	Cig Coil Pump 13 Status	Off On	AHU		4	BI-4		BI#,BICOM	EN-AHU13	Service Level B		0:M.2-01B	AHU13-4-BI-4						2/22	Device dependent	Aux Contact (NO)		A40	
BI-5		AHU-13				AHU		4	BI-5			EN-AHU13	Service Level B		0:M.2-01B	AHU13-4-BI-5											
BI-6		AHU-13				AHU		4	BI-6			EN-AHU13	Service Level B		0:M.2-01B	AHU13-4-BI-6											
BI-7		AHU-13				AHU		4	BI-7			EN-AHU13	Service Level B		0:M.2-01B	AHU13-4-BI-7											
BI-8		AHU-13				AHU		4	BI-8			EN-AHU13	Service Level B		0:M.2-01B	AHU13-4-BI-8											
AI-1		AHU-13	DA-T	Disch Air Temperature	Deg F	AHU		4	AI-1		AI#,AICM	EN-AHU13	Service Level B		0:M.2-01B	AHU13-4-AI-1						2/18	2-Wire	TE-6315P-1		A4	
AI-2		AHU-13	RA-T	Return Air Temperature	Deg F	AHU		4	AI-2		AI#,AICM	EN-AHU13	Service Level B		0:M.2-01B	AHU13-4-AI-2						2/18	2-Wire	TE-6315P-1		A4	
AI-3		AHU-13				AHU		4	AI-3			EN-AHU13	Service Level B		0:M.2-01B	AHU13-4-AI-3											
AI-4		AHU-13	ZN-T	Zone Temperature	Deg F	AHU		4	AI-4		PHONE JACK	EN-AHU13	Service Level B		0:M.2-01B	AHU13-4-AI-4						8/26	PHONE JACK	TE-6410W-1000		A5	
AI-5		AHU-13				AHU		4	AI-5			EN-AHU13	Service Level B		0:M.2-01B	AHU13-4-AI-5											
AI-6		AHU-13				AHU		4	AI-6			EN-AHU13	Service Level B		0:M.2-01B	AHU13-4-AI-6											
AI-7		AHU-13				AHU		4	AI-7			EN-AHU13	Service Level B		0:M.2-01B	AHU13-4-AI-7											
AI-8		AHU-13				AHU		4	AI-8			EN-AHU13	Service Level B		0:M.2-01B	AHU13-4-AI-8											

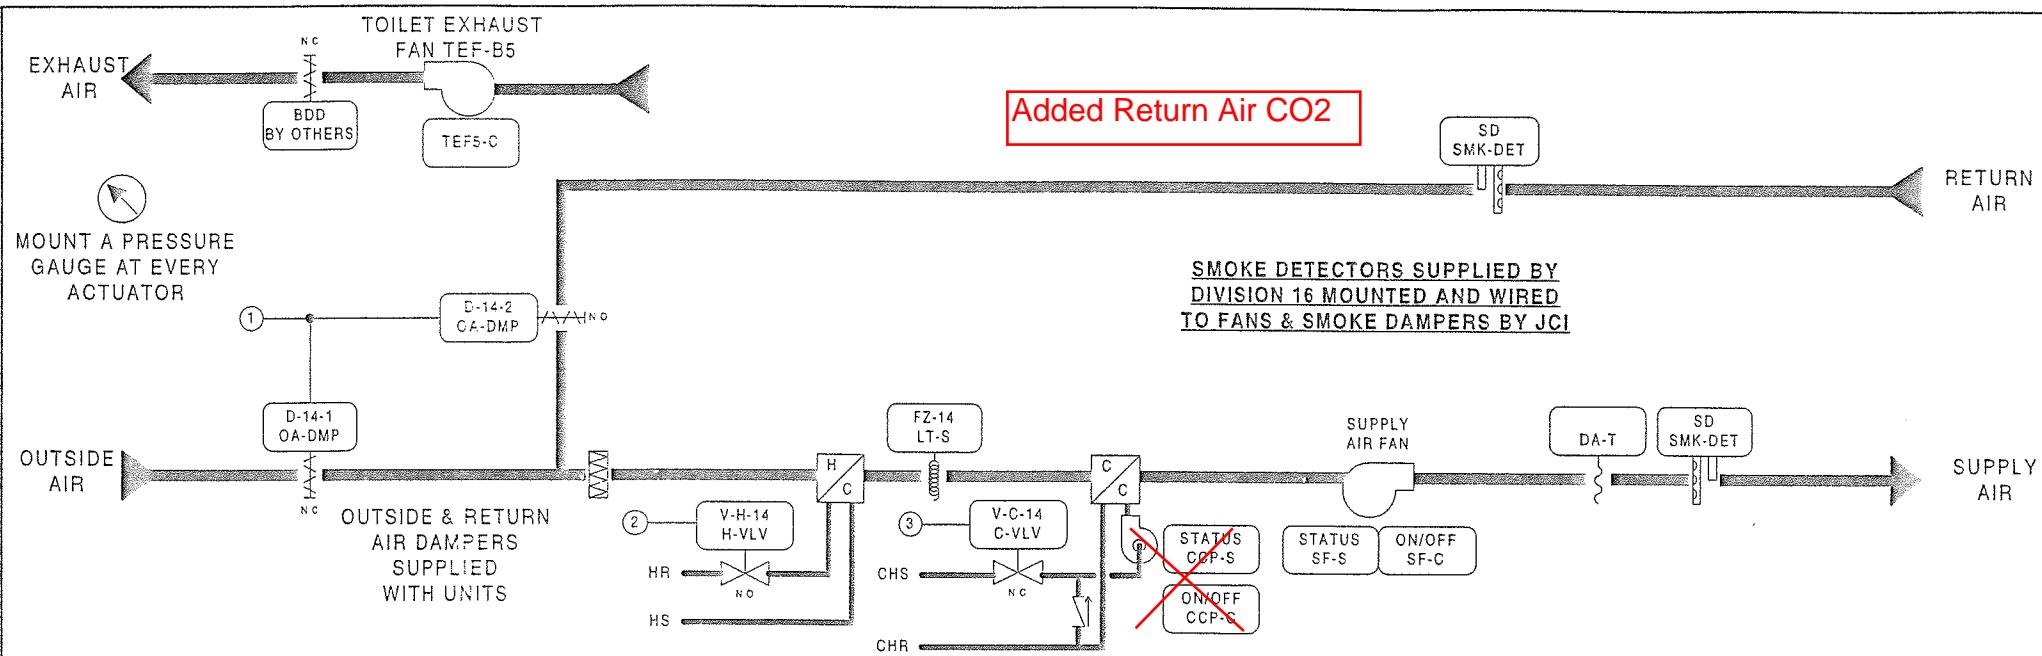

Estimate: ahu-14
Desig. QtyPart # Description 70520098.pre

BILL OF MATERIALS

Field Devices:


DA-T	1	TE-6315P-1	SENS, T-Ni, 0.1%, 8' AVG
FZ-14	1	A70HA-1C	STAT, LL, 20' EL, MAN, 15/55F
H-VLV, C-VLV	1	--	SEE VALVE SCHEDULE
OA-DMP	2	D-3153-2	DMPR ACT, 8-13#
	2	G-2010-11	GAGE, 2", 0-30 PSIG, STEM
TEF-B5	1	EZ-1000-11	ENCL, 4-5/8X 5-1/8 X 3-3/8
	1	PD-101-35	FLY BASE, 3PDT, 11PIN, 10A
	1	PD-109-51	RELAY PLUG-IN 3PDT 24VAC
ZN-T	1	TE-6410W-1000	MSTAT, HI, BOX, JACK

Panel Devices:


EN-AHU-14	1	AS-UNT111-101	UNT111 MTD IN UPM, W/50VA
	2	EN-EXP101-0	UNIV PKG MOD, CVR & BACKEN
EP-1, 2	2	EP-8000-2	XDUCR, EP, 0/10V, HI VOL
EP-3	1	V11HGA-100	3-W SOLENOID, W/OV, 24 VAC
PI-1, 2, 3	3	G-2010-11	GAGE, 2", 0-30 PSIG, STEM
RLY-1	1	AS-RLY002-0	RELAY; 2SPDT 5 AMP 240VAC

SMOKE DETECTORS SUPPLIED BY DIVISION 16 MOUNTED AND WIRED TO FANS & SMOKE DAMPERS BY JCI


SUPPLY FAN WIRING DIAGRAM

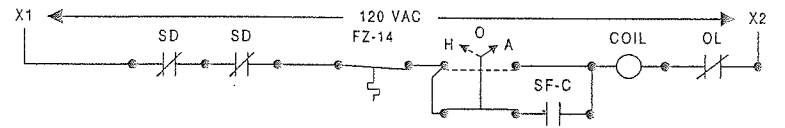

~~COOLING COIL PUMP DIAGRAM~~

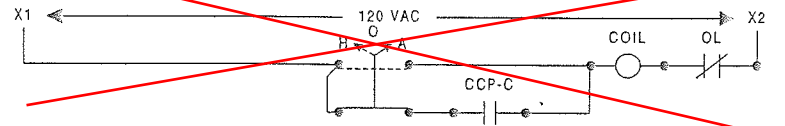

TOILET EXHAUST FAN DIAGRAM

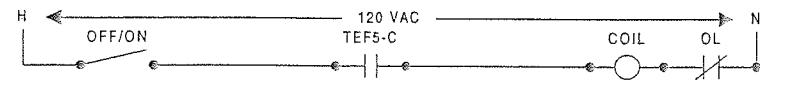

FAN	LOCATION	ELEC PANEL	CIRCUIT	LOCATION
TEF-B5	SERVICE LEVEL	STARTER		SERVICE LEVEL

DESCRIPTION OF OPERATION

THE METASYS SYSTEM WILL DETERMINE THE "OCCUPIED AND UNOCCUPIED" MODES OF OPERATION. OCCUPIED MODES GENERALLY OCCUR DURING STADIUM EVENTS, BUT MANUAL OVERRIDE THROUGH THE METASYS SYSTEM ON SELECTED UNITS WILL FREQUENTLY BE REQUIRED. WHEN THE UNIT IS DE-ENERGIZED, OUTSIDE AIR DAMPER D-14-1, AND COOLING COIL VALVE V-C-14 WILL CLOSE; COOLING COIL PUMP WILL BE OFF; RETURN AIR DAMPER D-14-2 WILL BE OPEN AND HEATING COIL VALVE V-H-14 WILL BE CLOSED TO THE COIL.

WARM-UP MODE - SUPPLY FAN WILL START AS DETERMINED BY THE OPTIMAL START PROGRAM OF THE METASYS SYSTEM. ON THE START OF THE UNIT, HEATING COIL VALVE V-H-14 WILL OPEN FULL TO COIL AND RETURN AIR DAMPER D-14-2 WILL BE FULLY OPEN WITH THE OUTSIDE AIR DAMPER D-14-1 CLOSED. EXHAUST FAN TEF-B5 WILL BE OFF AND EXHAUST AIR DAMPER D-14-3 (BDD) WILL BE CLOSED DURING THE WARM-UP MODE. DURATION OF THE WARM-UP MODE IS DETERMINED BY THE METASYS SYSTEM AND WILL BE DYNAMICALLY UPDATED TO END FIFTEEN (15) MINUTES PRIOR TO OCCUPANCY TIME. WARM-UP MODE IS STOPPED WHEN THE ZONE AIR TEMPERATURE REACHES THE SETTING OF TR-14 (70F).

OCCUPIED HEATING MODE - SUPPLY FAN WILL BE RUNNING. RETURN AIR DAMPER D-14-2 WILL CLOSE. OUTSIDE AIR DAMPER D-14-1 WILL OPEN AND EXHAUST FAN TEF-B5 WILL START AND RUN CONTINUOUSLY CAUSING EXHAUST AIR DAMPER D-14-3 (BDD) TO OPEN AFTER THE WARM-UP MODE IS STOPPED. ROOM SENSOR TR-14 THROUGH THE METASYS SYSTEM CONTROL UNIT, WILL ON A RISE IN TEMPERATURE ABOVE ITS SETTING OF SEVENTY-FIVE (75F) MODULATE V-H-14 CLOSED TO THE HEATING COIL. COOLING COIL VALVE V-C-14 WILL BE CLOSED TO THE COIL AND COIL CIRCULATION PUMP WILL BE OFF DURING THE HEATING MODE.



UNOCCUPIED HEATING MODE - ROOM SENSOR TR-14, WILL ON A FALL IN TEMPERATURE TO ITS SETTING OF FIFTY (50F), ACTIVATE THE SYSTEM TO RUN IN THE WARM-UP MODE AS HEREINBEFORE DESCRIBED. ON A RISE IN TEMPERATURE TO FIFTY-FIVE (55F), THE SYSTEM WILL BE DE-ENERGIZED. IN THE UNOCCUPIED MODE ALL AIR HANDLING UNIT DAMPERS AND CONTROLS WILL RETURN TO THEIR NORMAL POSITION READY FOR RESTARTING.

OCCUPIED COOLING MODE - SUPPLY AND EXHAUST FAN TEF-B5 AND COOLING COIL CIRCULATING PUMP START AND RUN CONTINUOUSLY. OUTSIDE DAMPER D-14-1 AND EXHAUST AIR DAMPER D-14-3 (BDD) WILL OPEN. ROOM SENSOR TR-14 THROUGH THE METASYS SYSTEM CONTROL UNIT, WILL MODULATE CHILLED WATER VALVE V-C-14 TO MAINTAIN ITS SETTING OF SEVENTY-FIVE (75F). THE HEATING COIL VALVE V-H-14 WILL BE CLOSED TO THE COIL.

UNOCCUPIED COOLING MODE - SYSTEM IS DE-ENERGIZED AND THE FANS ARE OFF.

SMOKE CONTROL - SMOKE DETECTORS WILL, ON THE DETECTION OF PRODUCTS OF COMBUSTION, SHUT DOWN THE SUPPLY AND EXHAUST FANS AND CLOSE ALL SYSTEM DAMPERS.


TOILET EXHAUST FAN TEF-B5 - THE FAN WILL START WHEN THE AHU SUPPLY FAN STARTS AND THE SYSTEM IS IN THE "OCCUPIED" MODE.

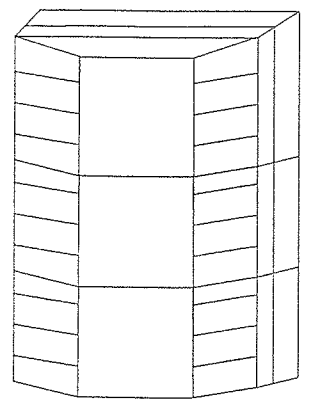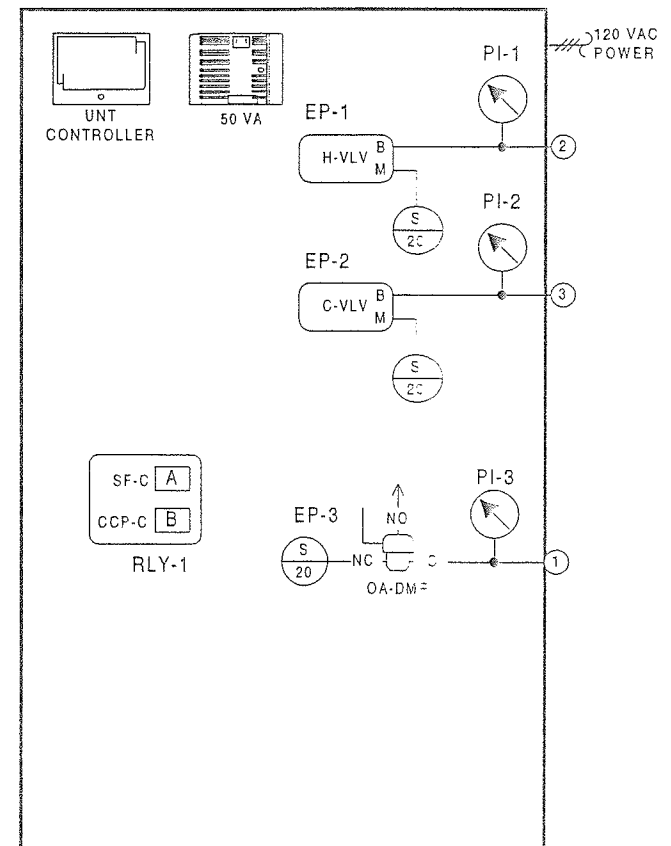

ENCLOSURE EN-AHU-14
AS-UNT111-101
LOCATED ADJACENT
TO UNIT
NCM-5/N2 ADD = 5

<p>REVISION INFORMATION</p> <p>NUMBER</p> <p>DATE 07/18/00</p> <p>TIME 03:16 PM</p> <p>FILE NAME AHU-14.vsd</p>	<p>IN CONSIDERATION OF THE RECEIPT OF THIS DOCUMENT, THE RECIPIENT AGREES NOT TO REPRODUCE, COPY, USE OR TRANSMIT THIS DOCUMENT AND/OR THE INFORMATION THEREIN CONTAINED, IN WHOLE OR IN PART, OR TO SUFFER SUCH ACTION BY OTHERS, FOR ANY PURPOSE, EXCEPT WITH THE WRITTEN PERMISSION OF JOHNSON CONTROLS, INC. AND FURTHER AGREES TO SURRENDER SAME TO JOHNSON CONTROLS, INC. UPON DEMAND.</p> <p>COPYRIGHT JOHNSON CONTROLS, INC. 1999</p>	<p>DRAWING TITLE</p> <p>AIR HANDLING UNIT AHU-14 OFFICIALS</p> <p>SERVICE LEVEL QUAD B</p> <p>PROJECT TITLE</p> <p>BALTIMORE NFL STADIUM AT CAMDEN YARDS</p> <p>BALTIMORE, MARYLAND</p>	<table border="1"> <tr> <td>AS-BUILT</td> <td>7/16/00</td> <td>CME</td> </tr> <tr> <td>REFERENCE DRAWING</td> <td>NO</td> <td>REVISION-LOCATION</td> </tr> <tr> <td>Sales Engineer JDP</td> <td>Project Manager WJT</td> <td>Application Engineer RTS</td> </tr> <tr> <td colspan="2">DRAWN BY RTS DATE 09/03/97</td> <td>APPROVED DATE</td> </tr> <tr> <td colspan="2">BRANCH INFORMATION</td> <td>CONTRACT NUMBER</td> </tr> <tr> <td colspan="2">JOHNSON CONTROLS</td> <td>7052-0098</td> </tr> <tr> <td colspan="2">Systems & Services Division</td> <td>BL-6559-19</td> </tr> </table>	AS-BUILT	7/16/00	CME	REFERENCE DRAWING	NO	REVISION-LOCATION	Sales Engineer JDP	Project Manager WJT	Application Engineer RTS	DRAWN BY RTS DATE 09/03/97		APPROVED DATE	BRANCH INFORMATION		CONTRACT NUMBER	JOHNSON CONTROLS		7052-0098	Systems & Services Division		BL-6559-19
AS-BUILT	7/16/00	CME																						
REFERENCE DRAWING	NO	REVISION-LOCATION																						
Sales Engineer JDP	Project Manager WJT	Application Engineer RTS																						
DRAWN BY RTS DATE 09/03/97		APPROVED DATE																						
BRANCH INFORMATION		CONTRACT NUMBER																						
JOHNSON CONTROLS		7052-0098																						
Systems & Services Division		BL-6559-19																						

Full Spreadsheet		Software				Digital Controller Information					Panel Information				Intermediate Device				Field Device				Ref Detail	Comment			
Tag	Point Type	System Name	Object Name	Expanded ID	Display Units	DC Type	N2 Trunk	N2 Addr	Cable Destination Bay/Terminal	Module Type	Termination	Panel	Panel Location	Slot Number	Reference Drawing	Cable Number	Wiring/ ubing	Termination In	Device	Termination Out	Location	Wiring/ ubing	Terminations	Device	Location	Ref Detail	Comment
		AHU-14				UNT						EN-AHU14	Service Level B		IM.2-01B												Power to Controller
		AHU-14				UNT	1	5				EN-AHU14	Service Level B		0IM.2-01B												N2 Trunk
AI-1		AHU-14	DA-T	Disch Air Temperature	Deg F	UNT	1	5	AI-1			EN-AHU14	Service Level B		0IM.2-01B	AHU14-5-AI-1					2/18	2-Wire	TE-6315P-1		U1		
AI-2		AHU-14				UNT	1	5	AI-2			EN-AHU14	Service Level B		0IM.2-01B	AHU14-5-AI-2											
AI-3		AHU-14				UNT	1	5	AI-3			EN-AHU14	Service Level B		0IM.2-01B	AHU14-5-AI-3											
AI-4		AHU-14	ZN-T	Zone Temperature	Deg F	UNT	1	5	AI-4		PHONE JACK	EN-AHU14	Service Level B		0IM.2-01B	AHU14-5-AI-4						8/26	PHONE JACK	TE-6410W-1000		U2	
AI-5		AHU-14				UNT	1	5	AI-5			EN-AHU14	Service Level B		0IM.2-01B	AHU14-5-AI-5											
AI-6		AHU-14				UNT	1	5	AI-6			EN-AHU14	Service Level B		0IM.2-01B	AHU14-5-AI-6											
BI-1		AHU-14	SF-S	Supply Fan Status	Off On	UNT	1	5	BI-1		BI#, 24VAC	EN-AHU14	Service Level B		0IM.2-01B	AHU14-5-BI-1						2/22	Device dependent	Aux Contact (NO)		U70	
BI-2		AHU-14	SMK-DET	Smoke Detectors	Normal Alarm	UNT	1	5	BI-2		BI#, 24VAC	EN-AHU14	Service Level B		0IM.2-01B	AHU14-5-BI-2						2/22	Device dependent	Contact (NO)		U70	
BI-3		AHU-14	LT-S	Low Temperature Stat	Normal Alarm	UNT	1	5	BI-3		BI#, 24VAC	EN-AHU14	Service Level B		0IM.2-01B	AHU14-5-BI-3						2/22	NO,M1	A70 (NC)		U71	
BI-4		AHU-14	CCP-S	Cig Coil Pump 14 Status	Off On	UNT	1	5	BI-4		BI#, 24VAC	EN-AHU14	Service Level B		0IM.2-01B	AHU14-5-BI-4						2/22	Device dependent	Aux Contact (NO)		U70	
BO-1		AHU-14	SF-C	Supply Fan Control	Off On	UNT	1	5	BO-1	RLY	BO#, 24V,COM	EN-AHU14	Service Level B		0IM.2-01B	AHU14-5-BO-1	3/18	A,COILS,COM	RELAY-A	NO,COM		2/14	See starter detail	Starter (NO)-(sw lo)		U60	
BO-2		AHU-14	TEF5-C	Toilet Exh Fan B5 Control	Off On	UNT	1	5	BO-2		BO#, 24VAC	EN-AHU14	Service Level B		0IM.2-01B	AHU14-5-BO-2						2/18	Device dependent	24VAC OUT (sw lo)		U51	
BO-3		AHU-14	OA-DMP	Outside Air Damper	Closed Open	UNT	1	5	BO-3		BO#, 24VAC	EN-AHU14	Service Level B		0IM.2-01B	AHU14-5-BO-3						2/18	Device dependent	24VAC OUT (sw lo)		U51	
BO-4		AHU-14	CCP-C	Cig Coil Pump 14 Control	Off On	UNT	1	5	BO-4	RLY	BO#, 24V,COM	EN-AHU14	Service Level B		0IM.2-01B	AHU14-5-BO-4	3/18	B,COILS,COM	RELAY-B	NO,COM		2/14	See starter detail	Starter (NO)-(sw lo)		U60	
BO-5		AHU-14				UNT	1	5	BO-5			EN-AHU14	Service Level B		0IM.2-01B	AHU14-5-BO-5											
BO-6		AHU-14				UNT	1	5	BO-6			EN-AHU14	Service Level B		0IM.2-01B	AHU14-5-BO-6											
AO-1		AHU-14	H-VLV	Heating Coil Valve	% Open	UNT	1	5	AO-1		AO#, AOCM, 24VAC	EN-AHU14	Service Level B		0IM.2-01B	AHU14-5-AO-1	2/18	+-	EP-8000-2	SUPPLY, O		3/18	Device dependent	0-10V OUT		U23	
AO-2		AHU-14	C-VLV	Cooling Coil Valve	% Open	UNT	1	5	AO-2		AO#, AOCM, 24VAC	EN-AHU14	Service Level B		0IM.2-01B	AHU14-5-AO-2	2/18	+-	EP-8000-2	SUPPLY, O		3/18	Device dependent	0-10V OUT		U23	

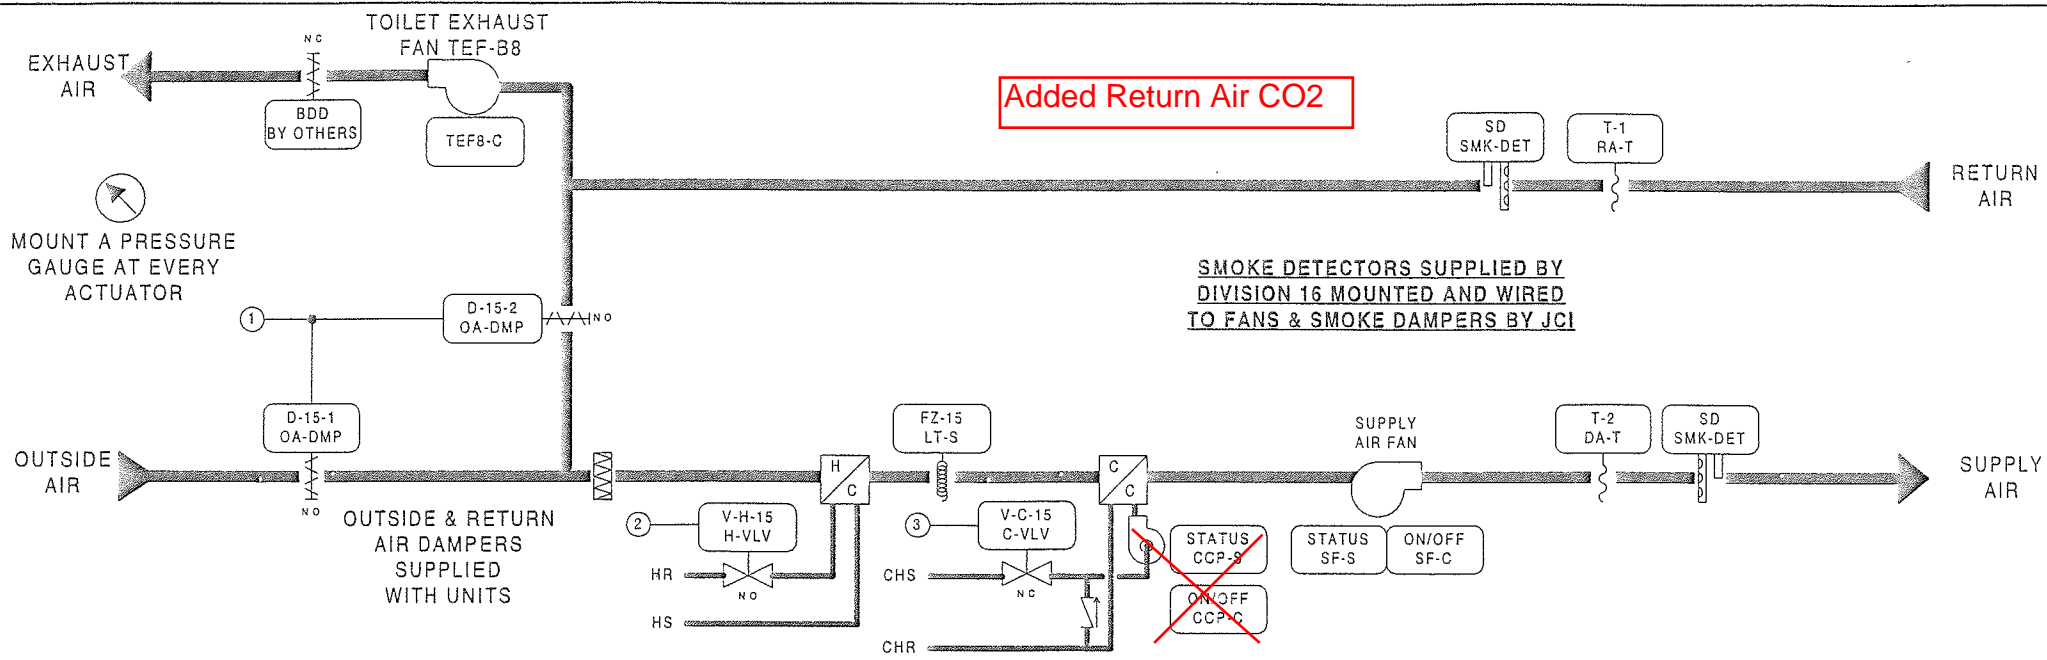

BILL OF MATERIALS

Estimate: ahu-15
Desig. QTY Part # Description

70520098.pre

Field Devices:


DA-T, RA-T	2	TE-6315P-1	SENS, T-Ni, 0.1%, 8' AVG
FZ-15	1	A70HA-1C	STAT, LL, 20' EL, MAM, 15/55F
H-VLV, C-VLV	1	--	SEE VALVE SCHEDULE
OA-DMP	2	D-3153-2	DMPR ACT, 8-13#
	2	G-2010-11	GAGE, 2", 0-30 PSIG, STEM
TEF-B8	1	BZ-1000-11	ENCL, 4-5/8X 5-1/8 X 3-3/8
	1	PD-101-35	RLY BASE, 3PDT, 11PIN, 1GA
	1	PD-109-51	RELAY PLUG-IN 3PDT 24VAC
ZN-T	1	TE-6410W-1030	NSTAT, NI, BOX, JACK

Panel Devices:


EN-AHU-15	1	AS-UNT111-101	UNT111 MTD IN UPM, W/50VA
	2	EN-EXP101-C	UNIV PKG MOD, CVR & BACKBN
EP-1, 2	2	EP-8000-2	XDUCR, EP, 0/10V, HI VOL
EP-3	1	V11HGA-100	3-H SOLENOID, W/OV, 24 VAC
PI-1, 2, 3	3	G-2010-11	GAGE, 2", 0-30 PSIG, STEM
RLY-1	1	AS-RLY002-C	RELAY; 2SPDT 5 AMP 240VAC

SMOKE DETECTORS SUPPLIED BY DIVISION 16 MOUNTED AND WIRED TO FANS & SMOKE DAMPERS BY JCI


SUPPLY FAN WIRING DIAGRAM

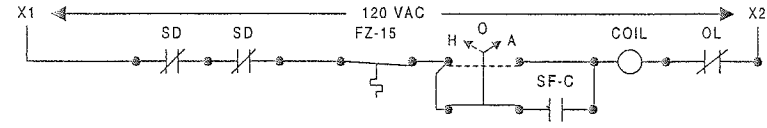

~~COOLING COIL PUMP DIAGRAM~~

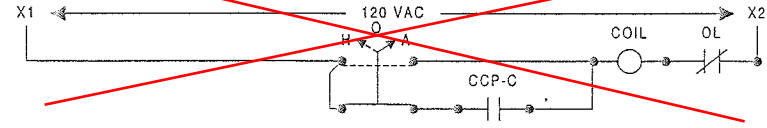

TOILET EXHAUST FAN DIAGRAM

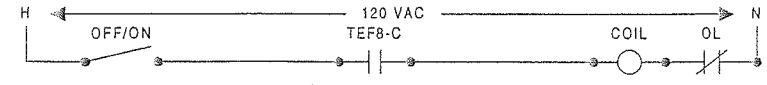

FAN	LOCATION	ELEC PANEL	CIRCUIT	LOCATION
TEF-B8	SERVICE LEVEL	STARTER		SERVICE LEVEL

DESCRIPTION OF OPERATION

THE METASYS SYSTEM WILL DETERMINE THE "OCCUPIED AND UNOCCUPIED" MODES OF OPERATION. OCCUPIED MODES GENERALLY OCCUR DURING STADIUM EVENTS, BUT MANUAL OVERRIDE THROUGH THE METASYS SYSTEM ON SELECTED UNITS WILL FREQUENTLY BE REQUIRED. WHEN THE UNIT IS DE-ENERGIZED, OUTSIDE AIR DAMPER D-15-1 AND COOLING COIL VALVE V-C-15 WILL CLOSE. COOLING COIL PUMP WILL BE OFF; RETURN AIR DAMPER D-15-2 WILL BE OPEN AND HEATING COIL VALVE V-H-15 WILL BE CLOSED TO THE COIL.

WARM-UP MODE - SUPPLY FAN WILL START AS DETERMINED BY THE OPTIMAL START PROGRAM OF THE METASYS SYSTEM. ON THE START OF THE UNIT, HEATING COIL VALVE V-H-15 WILL OPEN FULL TO COIL AND RETURN AIR DAMPER D-15-2 WILL BE FULLY OPEN WITH THE OUTSIDE AIR DAMPER D-15-1 CLOSED. EXHAUST FAN TEF-B8 WILL BE OFF AND EXHAUST AIR DAMPER D-15-3 (BDD) WILL BE CLOSED DURING THE WARM-UP MODE. DURATION OF THE WARM-UP MODE IS DETERMINED BY THE METASYS SYSTEM AND WILL BE DYNAMICALLY UPDATED TO END FIFTEEN (15) MINUTES PRIOR TO OCCUPANCY TIME. WARM-UP MODE IS STOPPED WHEN THE RETURN AIR TEMPERATURE REACHES THE SETTING OF T-1 (70F).

OCCUPIED HEATING MODE - SUPPLY FAN WILL BE RUNNING, RETURN AIR DAMPER D-15-2 WILL CLOSE. OUTSIDE AIR DAMPER D-15-1 WILL OPEN AND EXHAUST FAN TEF-B8 WILL START AND RUN CONTINUOUSLY CAUSING EXHAUST AIR DAMPER D-15-3 (BDD) TO OPEN AFTER THE WARM-UP MODE IS STOPPED. DISCHARGE AIR SENSOR T-2 THROUGH THE METASYS SYSTEM CONTROL UNIT, WILL ON A RISE IN TEMPERATURE ABOVE ITS SETTING OF FIFTY-FIVE (55F) MODULATE V-H-15 CLOSED TO THE HEATING COIL. ON A FALL IN TEMPERATURE, THIS CYCLE IS REVERSED. COOLING COIL VALVE V-C-15 WILL BE CLOSED TO THE COIL AND COIL CIRCULATION PUMP WILL BE OFF DURING THE HEATING MODE.



UNOCCUPIED HEATING MODE - ROOM SENSOR TR-15 WILL ON A FALL IN TEMPERATURE TO ITS SETTING OF FIFTY (50F). ACTIVATE THE SYSTEM TO RUN IN THE WARM-UP MODE AS HEREIN BEFORE DESCRIBED. ON A RISE IN TEMPERATURE TO FIFTY-FIVE (55F), THE SYSTEM WILL BE DE-ENERGIZED. IN THE UNOCCUPIED MODE ALL AIR HANDLING UNIT DAMPERS AND CONTROLS WILL RETURN TO THEIR NORMAL POSITION READY FOR RESTARTING.

OCCUPIED COOLING MODE - SUPPLY AND EXHAUST FAN TEF-B8 AND COOLING COIL CIRCULATING PUMP START AND RUN CONTINUOUSLY. OUTSIDE DAMPER D-15-1 AND EXHAUST AIR DAMPER D-15-3 (BDD) WILL OPEN. DISCHARGE AIR SENSOR T-2 THROUGH THE METASYS SYSTEM CONTROL UNIT, WILL MODULATE CHILLED WATER VALVE V-C-15 TO MAINTAIN ITS SETTING OF FIFTY-FIVE (55F). THE HEATING COIL VALVE V-H-15 WILL BE CLOSED TO THE COIL.

UNOCCUPIED COOLING MODE - SYSTEM IS DE-ENERGIZED AND THE FANS ARE OFF.

SMOKE CONTROL - SMOKE DETECTORS WILL, ON THE DETECTION OF PRODUCTS OF COMBUSTION, SHUT DOWN THE SUPPLY AND EXHAUST FANS AND CLOSE ALL SYSTEM DAMPERS.


TOILET EXHAUST FAN TEF-B8 - THE FAN WILL START WHEN THE AHU SUPPLY FAN STARTS AND THE SYSTEM IS IN THE "OCCUPIED" MODE.

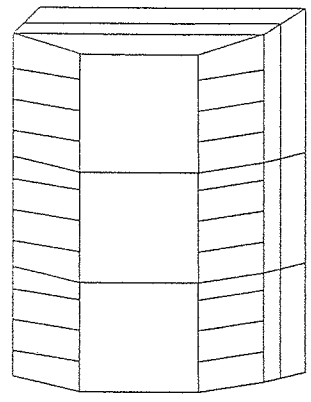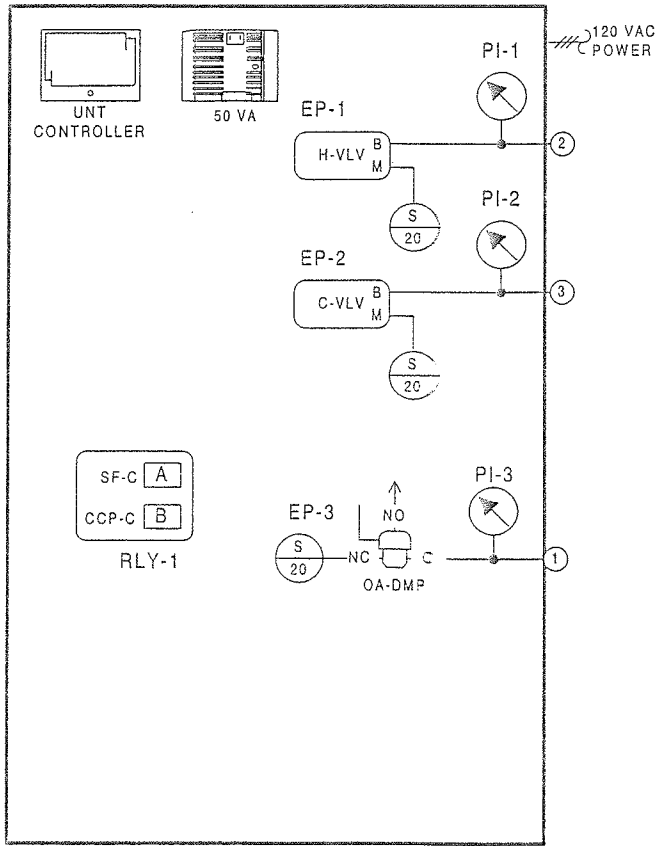

ENCLOSURE EN-AHU-15
AS-UNT111-101
LOCATED ADJACENT
TO UNIT
NCM-5/N2 ADD = 6

<p>REVISION INFORMATION</p> <p>NUMBER</p> <p>DATE 07/18/00</p> <p>TIME 03:16 PM</p> <p>FILE NAME AHU-15.vsd</p>	<p>IN CONSIDERATION OF THE RECEIPT OF THIS DOCUMENT, THE RECIPIENT AGREES NOT TO REPRODUCE, COPY, USE OR TRANSMIT THIS DOCUMENT AND/OR THE INFORMATION THEREIN CONTAINED, IN WHOLE OR IN PART, OR TO SUFFER SUCH ACTION BY OTHERS, FOR ANY PURPOSE, EXCEPT WITH THE WRITTEN PERMISSION OF JOHNSON CONTROLS, INC. AND FURTHER AGREES TO SURRENDER SAME TO JOHNSON CONTROLS, INC. UPON DEMAND.</p> <p>COPYRIGHT JOHNSON CONTROLS, INC. 1998</p>	<p>DRAWING TITLE</p> <p>AIR HANDLING UNIT AHU-15 VISITING LOCKER NO. 1</p> <p>SERVICE LEVEL QUAD B</p> <p>PROJECT TITLE</p> <p>BALTIMORE NFL STADIUM AT CAMDEN YARDS</p> <p>BALTIMORE, MARYLAND</p>	<table border="1"> <tr> <td>AS-BUILT</td> <td>7/18/00</td> <td>CME</td> </tr> <tr> <td>REFERENCE DRAWING NO.</td> <td>REVISION LOCATION</td> <td>ECN DATE BY</td> </tr> <tr> <td>SALES ENGINEER JDP</td> <td>PROJECT MANAGER WJT</td> <td>APPLICATION ENGINEER RTS</td> </tr> <tr> <td colspan="2">DRAWN BY RTS</td> <td>DATE 09/03/97</td> </tr> <tr> <td colspan="2">APPROVED BY</td> <td>DATE</td> </tr> <tr> <td colspan="2">BRANCH INFORMATION</td> <td>CONTRACT NUMBER</td> </tr> <tr> <td colspan="2">JOHNSON CONTROLS SYSTEMS & SERVICES DIVISION</td> <td>7052-0098</td> </tr> <tr> <td colspan="2">JOHNSON CONTROLS 50 LOVETON CIRCLE SPARKS, MD 21152</td> <td>DRAWING NUMBER BL-6559-20</td> </tr> </table>	AS-BUILT	7/18/00	CME	REFERENCE DRAWING NO.	REVISION LOCATION	ECN DATE BY	SALES ENGINEER JDP	PROJECT MANAGER WJT	APPLICATION ENGINEER RTS	DRAWN BY RTS		DATE 09/03/97	APPROVED BY		DATE	BRANCH INFORMATION		CONTRACT NUMBER	JOHNSON CONTROLS SYSTEMS & SERVICES DIVISION		7052-0098	JOHNSON CONTROLS 50 LOVETON CIRCLE SPARKS, MD 21152		DRAWING NUMBER BL-6559-20
AS-BUILT	7/18/00	CME																									
REFERENCE DRAWING NO.	REVISION LOCATION	ECN DATE BY																									
SALES ENGINEER JDP	PROJECT MANAGER WJT	APPLICATION ENGINEER RTS																									
DRAWN BY RTS		DATE 09/03/97																									
APPROVED BY		DATE																									
BRANCH INFORMATION		CONTRACT NUMBER																									
JOHNSON CONTROLS SYSTEMS & SERVICES DIVISION		7052-0098																									
JOHNSON CONTROLS 50 LOVETON CIRCLE SPARKS, MD 21152		DRAWING NUMBER BL-6559-20																									

Full Spreadsheet		Software				Digital Controller Information					Panel Information					Intermediate Device					Field Device						
Tag	Point Type	System Name	Object Name	Expanded ID	Display Units	DC Type	N2 Trunk	N2 Addr	Cable Destination Bay/Terminal	Module Type	Termination	Panel	Panel Location	Slot Number	Reference Drawing	Cable Number	Wiring/Tubing	Termination In	Device	Termination Out	Location	Wiring/Tubing	Terminations	Device	Location	Ref Detail	Comment
		AHU-15				IUNT						EN-AHU15:Service Level B		0M.2-01B													Power to Controller
		AHU-15				IUNT	1	6				EN-AHU15:Service Level B		0M.2-01B													N2 Trunk
AI-1		AHU-15	RA-T	Return Air Temperature	Deg F	IUNT	1	6	AI-1	AI#,AICM		EN-AHU15:Service Level B		0M.2-01B	AHU15-6-AI-1						2/18	2-Wire	TE-6315P-1			U1	
AI-2		AHU-15				IUNT	1	6	AI-2			EN-AHU15:Service Level B		0M.2-01B	AHU15-6-AI-2												
AI-3		AHU-15	DA-T	Disch Air Temperature	Deg F	IUNT	1	6	AI-3	AI#,AICM		EN-AHU15:Service Level B		0M.2-01B	AHU15-6-AI-3						2/18	2-Wire	TE-6315P-1			U1	
AI-4		AHU-15	ZN-T	Zone Temperature	Deg F	IUNT	1	6	AI-4	PHONE JACK		EN-AHU15:Service Level B		0M.2-01B	AHU15-6-AI-4						8/26	PHONE JACK	TE-6410W-1000			U2	
AI-5		AHU-15				IUNT	1	6	AI-5			EN-AHU15:Service Level B		0M.2-01B	AHU15-6-AI-5												
AI-6		AHU-15				IUNT	1	6	AI-6			EN-AHU15:Service Level B		0M.2-01B	AHU15-6-AI-6												
BI-1		AHU-15	SF-S	Supply Fan Status	Off On	IUNT	1	6	BI-1			EN-AHU15:Service Level B		0M.2-01B	AHU15-6-BI-1						2/22	Device dependent	Aux Contact (NO)			U70	
BI-2		AHU-15	SMK-DET	Smoke Detectors	Normal Alarm	IUNT	1	6	BI-2			EN-AHU15:Service Level B		0M.2-01B	AHU15-6-BI-2						2/22	Device dependent	Contact (NO)			U70	
BI-3		AHU-15	LT-S	Low Temperature Stat	Normal Alarm	IUNT	1	6	BI-3			EN-AHU15:Service Level B		0M.2-01B	AHU15-6-BI-3						2/22	NO,M1	A70 (NC)			U71	
BI-4		AHU-15	CCP-S	Clg Coil Pump 15 Status	Off On	IUNT	1	6	BI-4			EN-AHU15:Service Level B		0M.2-01B	AHU15-6-BI-4						2/22	Device dependent	Aux Contact (NO)			U70	
BO-1		AHU-15	SF-C	Supply Fan Control	Off On	IUNT	1	6	BO-1	RLY	BO#,24V,COM	EN-AHU15:Service Level B		0M.2-01B	AHU15-6-BO-1	3/18	A,COILS,COM	RELAY-A	NO,COM		2/14	See starter detail	Starter (NO)-(sw lo)			U60	
BO-2		AHU-15	TEF8-C	Toilet Exh Fan B8 Control	Off On	IUNT	1	6	BO-2		BO#,24VAC	EN-AHU15:Service Level B		0M.2-01B	AHU15-6-BO-2				PD-109-51		2/18	Device dependent	24VAC OUT (sw lo)			U51	
BO-3		AHU-15	OA-DMP	Outside Air Damper	Closed Open	IUNT	1	6	BO-3		BO#,24VAC	EN-AHU15:Service Level B		0M.2-01B	AHU15-6-BO-3			V11HGA-100			2/18	Device dependent	24VAC OUT (sw lo)			U51	
BO-4		AHU-15	CCP-C	Clg Coil Pump 15 Control	Off On	IUNT	1	6	BO-4	RLY	BO#,24V,COM	EN-AHU15:Service Level B		0M.2-01B	AHU15-6-BO-4	3/18	B,COILS,COM	RELAY-B	NO,COM		2/14	See starter detail	Starter (NO)-(sw lo)			U60	
BO-5		AHU-15				IUNT	1	6	BO-5			EN-AHU15:Service Level B		0M.2-01B	AHU15-6-BO-5												
BO-6		AHU-15				IUNT	1	6	BO-6			EN-AHU15:Service Level B		0M.2-01B	AHU15-6-BO-6												
AO-1		AHU-15	H-VLV	Heating Coil Valve	% Open	IUNT	1	6	AO-1		AO#,AOCM,24VA	EN-AHU15:Service Level B		0M.2-01B	AHU15-6-AO-1	2/18	+-	EP-8000-2	SUPPLY, O		3/18	Device dependent	0-10V OUT			U23	
AO-2		AHU-15	C-VLV	Cooling Coil Valve	% Open	IUNT	1	6	AO-2		AO#,AOCM,24VA	EN-AHU15:Service Level B		0M.2-01B	AHU15-6-AO-2	2/18	+-	EP-8000-2	SUPPLY, O		3/18	Device dependent	0-10V OUT			U23	

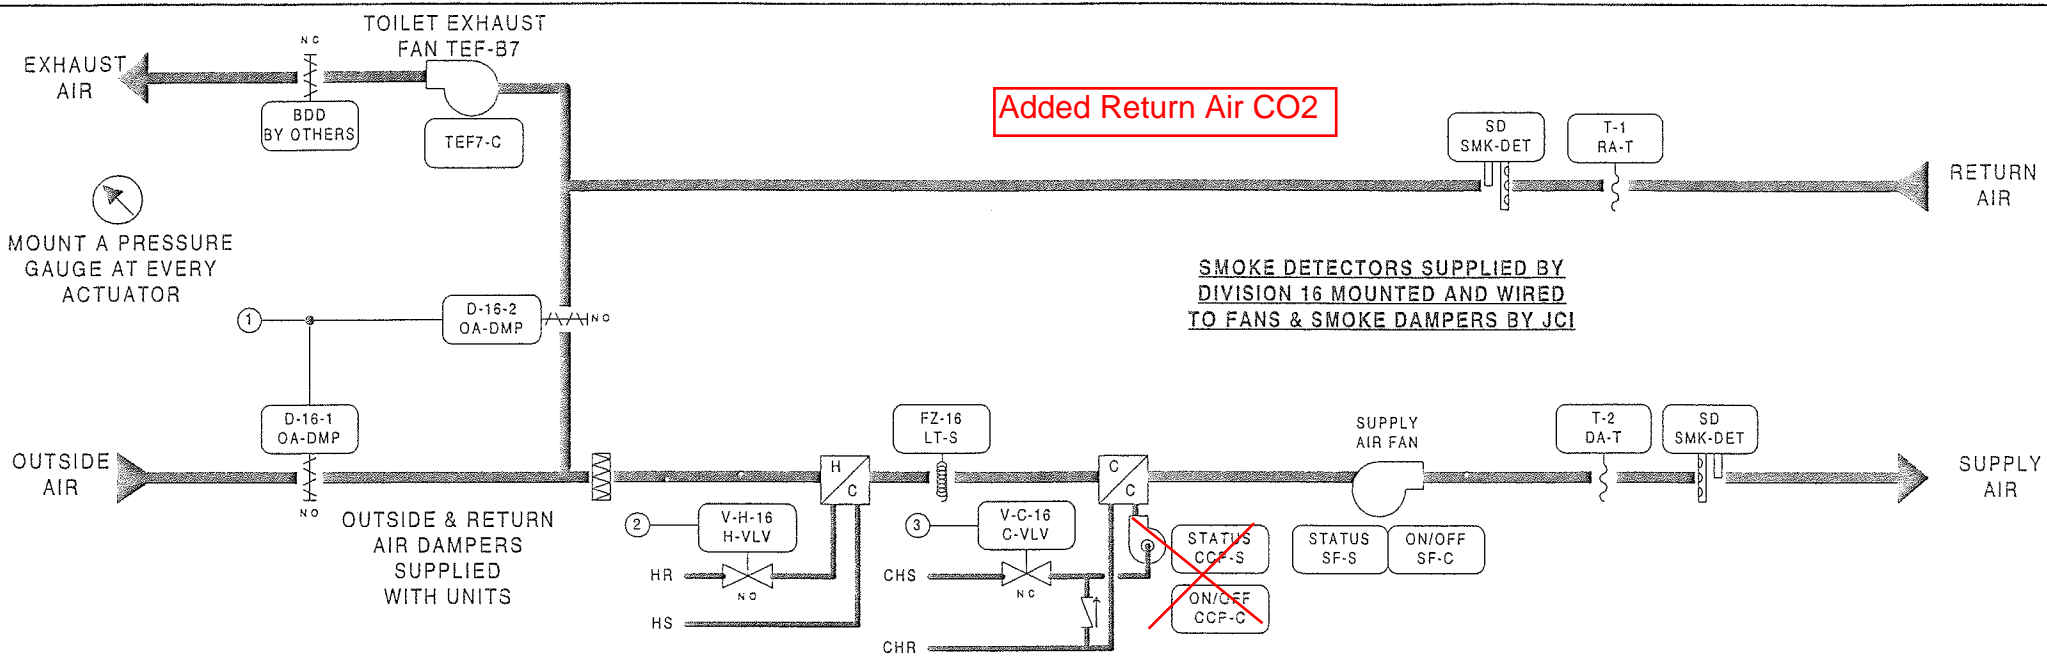


BILL OF MATERIALS

Estimate: ahu-16 70520098.pre


Desig.	Qty	Part #	Description
Field Devices:			
DA-T, RA-T	2	TE-6315P-1	SENS, T-Ni, 0.1%, 8' AVG
FZ-16	1	A70HA-1C	STAT, LL, 20', EL, MAN, 15/55F
H-VLV, C-VLV	1	--	SEE VALVE SCHEDULE
OA-DMP	2	D-3153-2	DMPR ACT, 8-13#
	2	G-2010-11	GAGE, 2", 0-30 PSIG, STEM
TEF-B7	1	BZ-1000-11	ENCL, 4-5/8X 5-1/8 X 3-3/8
	1	PD-101-35	RLY BASE, 3PDT, 11PIN, 10A
	1	PD-109-51	RELAY PLUG-IN 3PDT 24VAC
ZN-T	1	TE-6410W-1000	MSTAT, NI, BOX, JACK
Panel Devices:			
EN-AHU-16	1	AS-UNT111-101	UNT111 MTD IN UPM, W/50VA
	2	EN-EXP101-0	UNIV PKG MOD, CVR & BACKBN
EP-1, 2	2	EP-8000-2	MDUCR, EP, 0/10V, HI VOL
EP-3	1	V11HGA-100	3-W SOLENOID, W/OV, 24 VAC
PI-1, 2, 3	3	G-2010-11	GAGE, 2", 0-30 PSIG, STEM
RLY-1	1	AS-RLY002-0	RELAY; 2SPDT 5 AMP 240VAC

SMOKE DETECTORS SUPPLIED BY DIVISION 16 MOUNTED AND WIRED TO FANS & SMOKE DAMPERS BY JCI


SUPPLY FAN WIRING DIAGRAM

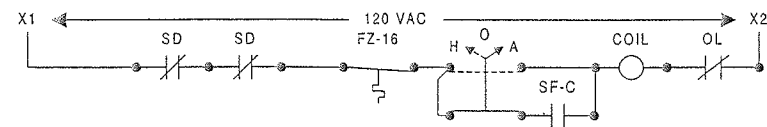

COOLING COIL PUMP DIAGRAM

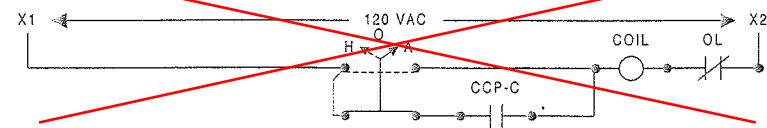

TOILET EXHAUST FAN DIAGRAM

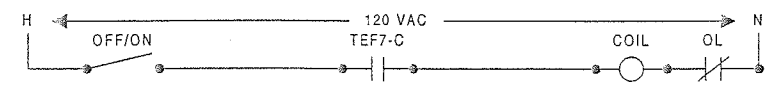

DESCRIPTION OF OPERATION

THE METASYS SYSTEM WILL DETERMINE THE "OCCUPIED AND UNOCCUPIED" MODES OF OPERATION. OCCUPIED MODES GENERALLY OCCUR DURING STADIUM EVENTS, BUT MANUAL OVERRIDE THROUGH THE METASYS SYSTEM ON SELECTED UNITS WILL FREQUENTLY BE REQUIRED. WHEN THE UNIT IS DE-ENERGIZED, OUTSIDE AIR DAMPER D-16-1, AND COOLING COIL VALVE V-C-16, WILL CLOSE; COOLING COIL PUMP WILL BE OFF; RETURN AIR DAMPER D-16-2 WILL BE OPEN AND HEATING COIL VALVE V-H-16 WILL BE CLOSED TO THE COIL.

WARM-UP MODE - SUPPLY FAN WILL START AS DETERMINED BY THE OPTIMAL START PROGRAM OF THE METASYS SYSTEM. ON THE START OF THE UNIT, HEATING COIL VALVE V-H-16 WILL OPEN FULL TO COIL AND RETURN AIR DAMPER D-16-2 WILL BE FULLY OPEN WITH THE OUTSIDE AIR DAMPER D-16-1 CLOSED. EXHAUST FAN TEF-B7 WILL BE OFF AND EXHAUST AIR DAMPER D-16-3 (BDD) WILL BE CLOSED DURING THE WARM-UP MODE. DURATION OF THE WARM-UP MODE IS DETERMINED BY THE METASYS SYSTEM AND WILL BE DYNAMICALLY UPDATED TO END FIFTEEN (15) MINUTES PRIOR TO OCCUPANCY TIME. WARM-UP MODE IS STOPPED WHEN THE RETURN AIR TEMPERATURE REACHES THE SETTING OF T-1 (70F).

OCCUPIED HEATING MODE - SUPPLY FAN WILL BE RUNNING, RETURN AIR DAMPER D-16-2, WILL CLOSE. OUTSIDE AIR DAMPER D-16-1 WILL OPEN AND EXHAUST FAN TEF-B7 WILL START AND RUN CONTINUOUSLY CAUSING EXHAUST AIR DAMPER D-16-3 (BDD) TO OPEN AFTER THE WARM-UP MODE IS STOPPED. DISCHARGE AIR SENSOR T-2 THROUGH THE METASYS SYSTEM CONTROL UNIT, WILL ON A RISE IN TEMPERATURE ABOVE ITS SETTING OF FIFTY-FIVE (55F) MODULATE V-H-16 CLOSED TO THE HEATING COIL. ON A FALL IN TEMPERATURE, THIS CYCLE IS REVERSED. COOLING COIL VALVE V-C-16 WILL BE CLOSED TO THE COIL AND COIL CIRCULATION PUMP WILL BE OFF DURING THE HEATING MODE.

UNOCCUPIED HEATING MODE - ROOM SENSOR TR-16, WILL ON A FALL IN TEMPERATURE TO ITS SETTING OF FIFTY (50F). ACTIVATE THE SYSTEM TO RUN IN THE WARM-UP MODE AS HEREIN BEFORE DESCRIBED. ON A RISE IN TEMPERATURE TO FIFTY-FIVE (55F), THE SYSTEM WILL BE DE-ENERGIZED. IN THE UNOCCUPIED MODE ALL AIR HANDLING UNIT DAMPERS AND CONTROLS WILL RETURN TO THEIR NORMAL POSITION READY FOR RESTARTING.



OCCUPIED COOLING MODE - SUPPLY AND EXHAUST FAN TEF-B7 AND COOLING COIL CIRCULATING PUMP START AND RUN CONTINUOUSLY. OUTSIDE DAMPER D-16-1 AND EXHAUST AIR DAMPER D-16-3 (BDD) WILL OPEN. DISCHARGE AIR SENSOR T-2 THROUGH THE METASYS SYSTEM CONTROL UNIT, WILL MODULATE CHILLED WATER VALVE V-C-16 TO MAINTAIN ITS SETTING OF FIFTY-FIVE (55F). THE HEATING COIL VALVE V-H-16 WILL BE CLOSED TO THE COIL.

UNOCCUPIED COOLING MODE - SYSTEM IS DE-ENERGIZED AND THE FANS ARE OFF.

SMOKE CONTROL - SMOKE DETECTORS WILL, ON THE DETECTION OF PRODUCTS OF COMBUSTION, SHUT DOWN THE SUPPLY AND EXHAUST FANS AND CLOSE ALL SYSTEM DAMPERS.

TOILET EXHAUST FAN TEF-B7 - THE FAN WILL START WHEN THE AHU SUPPLY FAN STARTS AND THE SYSTEM IS IN THE "OCCUPIED" MODE.


FAN	LOCATION	ELEC PANEL	CIRCUIT	LOCATION
TEF-B7	SERVICE LEVEL	STARTER		SERVICE LEVEL

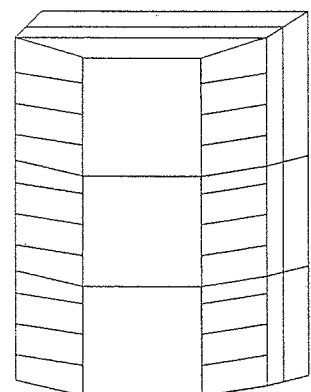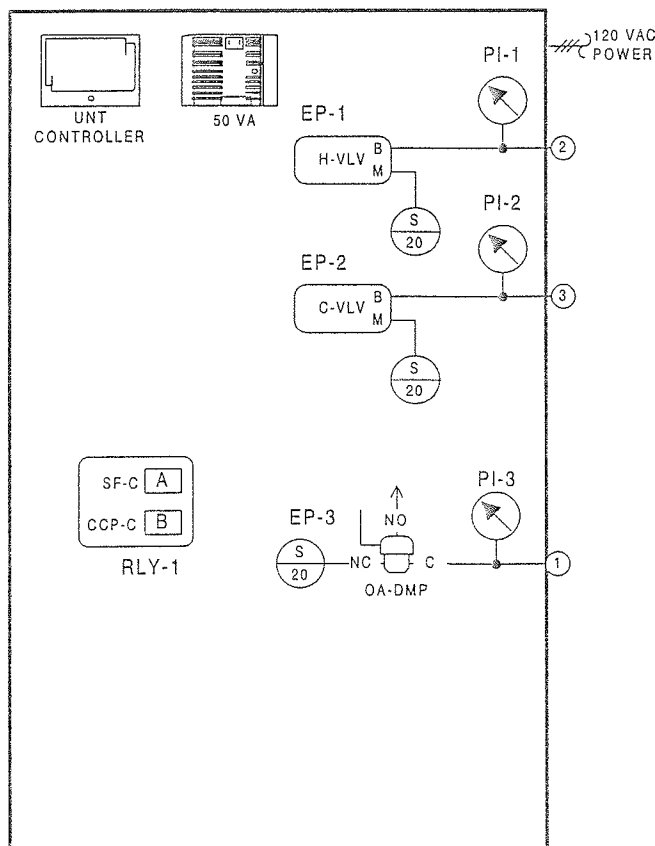

ENCLOSURE EN-AHU-16
AS-UNT111-101
LOCATED ADJACENT
TO UNIT
NCM-5/N2 ADD = 7

<p>REVISION INFORMATION</p> <p>NUMBER</p> <p>DATE 07/18/00</p> <p>TIME 03:17 PM</p> <p>FILE NAME AHU-16.vsd</p>	<p>IN CONSIDERATION OF THE RECEIPT OF THIS DOCUMENT, THE RECIPIENT AGREES NOT TO REPRODUCE, COPY, USE OR TRANSMIT THIS DOCUMENT AND/OR THE INFORMATION THEREIN CONTAINED, IN WHOLE OR IN PART, OR TO SUFFER SUCH ACTION BY OTHERS, FOR ANY PURPOSE, EXCEPT WITH THE WRITTEN PERMISSION OF JOHNSON CONTROLS, INC. AND FURTHER AGREES TO SURRENDER SAME TO JOHNSON CONTROLS, INC. UPON DEMAND.</p> <p>COPYRIGHT JOHNSON CONTROLS, INC. 1998</p>	<p>DRAWING TITLE</p> <p>AIR HANDLING UNIT AHU-16 VISITING LOCKER NO. 2</p> <p>SERVICE LEVEL QUAD B</p> <p>PROJECT TITLE</p> <p>BALTIMORE NFL STADIUM AT CAMDEN YARDS</p> <p>BALTIMORE, MARYLAND</p>	<table border="1"> <tr> <td>AS-BUILT</td> <td>NO.</td> <td>REVISION LOCATION</td> <td>EDN</td> <td>DATE</td> <td>CME</td> </tr> <tr> <td></td> <td></td> <td></td> <td></td> <td>7/18/00</td> <td></td> </tr> <tr> <td> <p>REFERENCE DRAWING</p> <p>Series Engineer JDP</p> </td> <td> <p>Project Manager</p> <p>WJT</p> </td> <td> <p>Application Engineer</p> <p>RTS</p> </td> <td> <p>DRAWN</p> <p>B* RTS</p> </td> <td> <p>DATE</p> <p>09/04/97</p> </td> <td> <p>APPROVED</p> <p>DATE</p> </td> </tr> <tr> <td colspan="3"> <p>PROJECT NUMBER</p> <p>7052-0098</p> </td> <td colspan="3"> <p>CONTRACT NUMBER</p> <p>BL-6559-21</p> </td> </tr> </table>	AS-BUILT	NO.	REVISION LOCATION	EDN	DATE	CME					7/18/00		<p>REFERENCE DRAWING</p> <p>Series Engineer JDP</p>	<p>Project Manager</p> <p>WJT</p>	<p>Application Engineer</p> <p>RTS</p>	<p>DRAWN</p> <p>B* RTS</p>	<p>DATE</p> <p>09/04/97</p>	<p>APPROVED</p> <p>DATE</p>	<p>PROJECT NUMBER</p> <p>7052-0098</p>			<p>CONTRACT NUMBER</p> <p>BL-6559-21</p>		
AS-BUILT	NO.	REVISION LOCATION	EDN	DATE	CME																						
				7/18/00																							
<p>REFERENCE DRAWING</p> <p>Series Engineer JDP</p>	<p>Project Manager</p> <p>WJT</p>	<p>Application Engineer</p> <p>RTS</p>	<p>DRAWN</p> <p>B* RTS</p>	<p>DATE</p> <p>09/04/97</p>	<p>APPROVED</p> <p>DATE</p>																						
<p>PROJECT NUMBER</p> <p>7052-0098</p>			<p>CONTRACT NUMBER</p> <p>BL-6559-21</p>																								

Full Spreadsheet		Software				Digital Controller Information						Panel Information				Intermediate Device					Field Device				Ref Detail	Comment	
Tag	Point Type	System Name	Object Name	Expanded ID	Display Units	DC Type	N2 Trunk	N2 Addr	Cable Destination Bay/Terminal	Module Type	Termination	Panel	Panel Location	Slot Number	Reference Drawing	Cable Number	Wiring/Tubing	Termination In	Device	Termination Out	Location	Wiring/Tubing	Terminations	Device	Location	Ref Detail	Comment
		AHU-16				IUNT						EN-AHU16 Service Level B			M.2-01B												Power to Controller
		AHU-16				IUNT	1	7				EN-AHU16 Service Level B			01M.2-01B												N2 Trunk
AI-1		AHU-16	RA-T	Return Air Temperature	Deg F	IUNT	1	7	AI-1			AI#,AICM	EN-AHU16 Service Level B		01M.2-01B	AHU16-7-AI-1					2/18	2-Wire	TE-6315P-1			U1	
AI-2		AHU-16				IUNT	1	7	AI-2				EN-AHU16 Service Level B		01M.2-01B	AHU16-7-AI-2											
AI-3		AHU-16	DA-T	Disch Air Temperature	Deg F	IUNT	1	7	AI-3			AI#,AICM	EN-AHU16 Service Level B		01M.2-01B	AHU16-7-AI-3					2/18	2-Wire	TE-6315P-1			U1	
AI-4		AHU-16	ZN-T	Zone Temperature	Deg F	IUNT	1	7	AI-4			PHONE JACK	EN-AHU16 Service Level B		01M.2-01B	AHU16-7-AI-4					8/26	PHONE JACK	TE-6410W-1000			U2	
AI-5		AHU-16				IUNT	1	7	AI-5				EN-AHU16 Service Level B		01M.2-01B	AHU16-7-AI-5											
AI-6		AHU-16				IUNT	1	7	AI-6				EN-AHU16 Service Level B		01M.2-01B	AHU16-7-AI-6											
BI-1		AHU-16	SF-S	Supply Fan Status	Off On	IUNT	1	7	BI-1			BI#,24VAC	EN-AHU16 Service Level B		01M.2-01B	AHU16-7-BI-1					2/22	Device dependent	Aux Contact (NO)			U70	
BI-2		AHU-16	SMK-DET	Smoke Detectors	Normal Alarm	IUNT	1	7	BI-2			BI#,24VAC	EN-AHU16 Service Level B		01M.2-01B	AHU16-7-BI-2					2/22	Device dependent	Contact (NO)			U70	
BI-3		AHU-16	LT-S	Low Temperature Stat	Normal Alarm	IUNT	1	7	BI-3			BI#,24VAC	EN-AHU16 Service Level B		01M.2-01B	AHU16-7-BI-3					2/22	NO,M1	A70 (NC)			U71	
BI-4		AHU-16	CCP-S	Clq Coil Pump 16 Status	Off On	IUNT	1	7	BI-4			BI#,24VAC	EN-AHU16 Service Level B		01M.2-01B	AHU16-7-BI-4					2/22	Device dependent	Aux Contact (NO)			U70	
BO-1		AHU-16	SF-C	Supply Fan Control	Off On	IUNT	1	7	BO-1	RLY		BO#,24V,COM	EN-AHU16 Service Level B		01M.2-01B	AHU16-7-BO-1	3/18	A,COILS,COM	RELAY-A	NO,COM		2/14	See starter detail	Starter (NO)-(sw lo)		U60	
BO-2		AHU-16	TEF7-C	Toilet Exh Fan 67 Control	Off On	IUNT	1	7	BO-2			BO#,24VAC	EN-AHU16 Service Level B		01M.2-01B	AHU16-7-BO-2					2/18	Device dependent	24VAC OUT (sw lo)			U51	
BO-3		AHU-16	OA-DMP	Outside Air Damper	Closed Open	IUNT	1	7	BO-3			BO#,24VAC	EN-AHU16 Service Level B		01M.2-01B	AHU16-7-BO-3					2/18	Device dependent	24VAC OUT (sw lo)			U51	
BO-4		AHU-16	CCP-C	Clq Coil Pump 16 Control	Off On	IUNT	1	7	BO-4	RLY		BO#,24V,COM	EN-AHU16 Service Level B		01M.2-01B	AHU16-7-BO-4	3/18	B,COILS,COM	RELAY-B	NO,COM		2/14	See starter detail	Starter (NO)-(sw lo)		U60	
BO-5		AHU-16				IUNT	1	7	BO-5				EN-AHU16 Service Level B		01M.2-01B	AHU16-7-BO-5											
BO-6		AHU-16				IUNT	1	7	BO-6				EN-AHU16 Service Level B		01M.2-01B	AHU16-7-BO-6											
AO-1		AHU-16	H-VLV	Heating Coil Valve	% Open	IUNT	1	7	AO-1			AO#,AOCM,24VA	EN-AHU16 Service Level B		01M.2-01B	AHU16-7-AO-1	2/18	+-	EP-8000-2	SUPPLY, O		3/18	Device dependent	0-10V OUT		U23	
AO-2		AHU-16	C-VLV	Cooling Coil Valve	% Open	IUNT	1	7	AO-2			AO#,AOCM,24VA	EN-AHU16 Service Level B		01M.2-01B	AHU16-7-AO-2	2/18	+-	EP-8000-2	SUPPLY, O		3/18	Device dependent	0-10V OUT		U23	

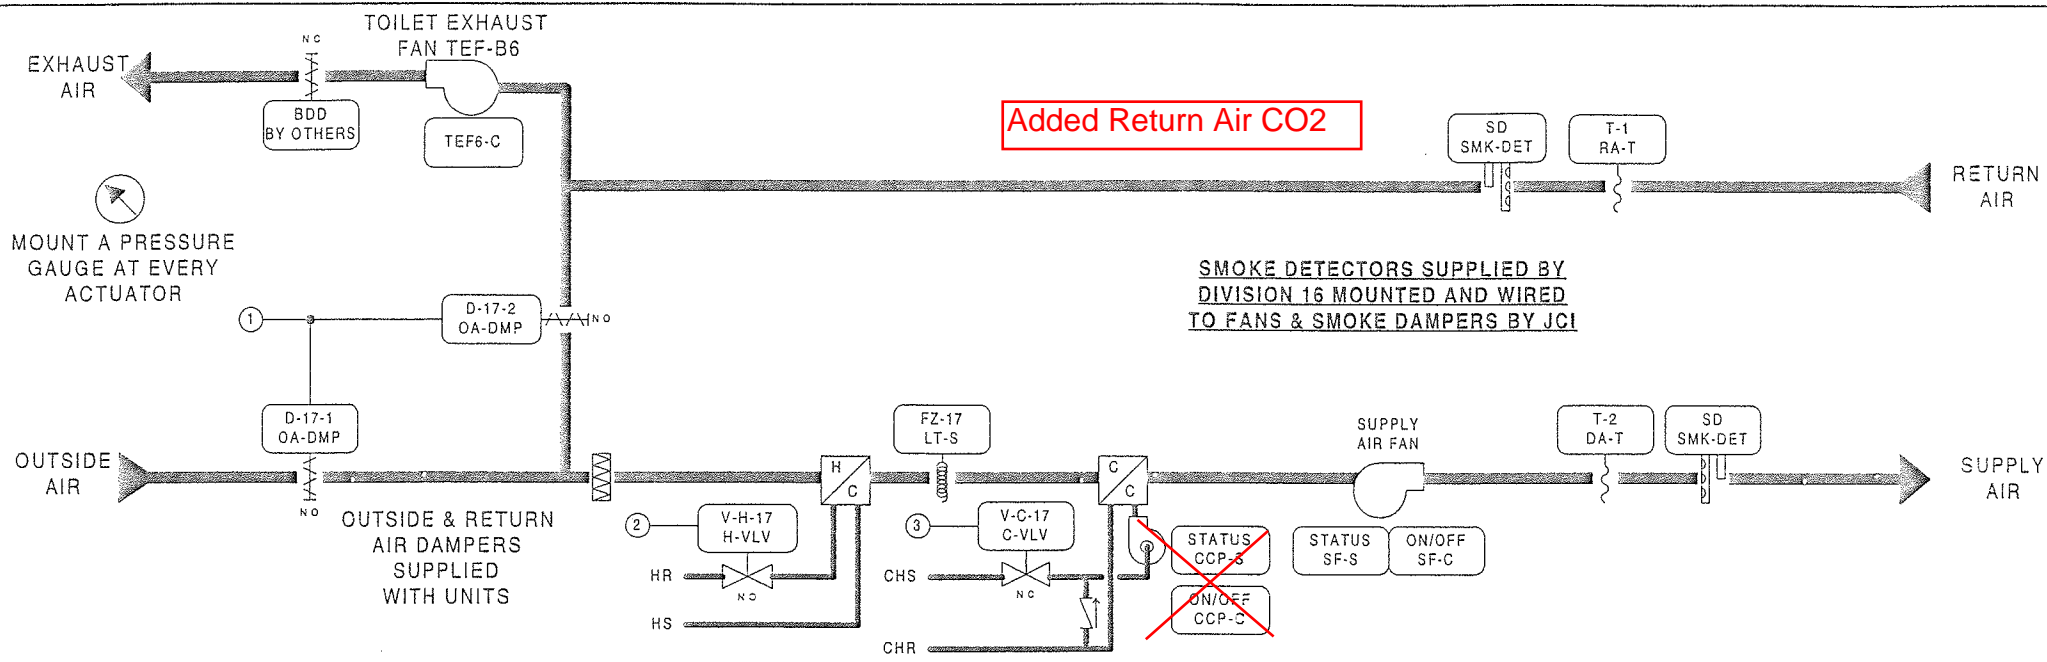


BILL OF MATERIALS


Estimate: ahu-17 70520098.pre

Desig.	Qty	Part #	Description
Field Devices:			
DA-T, RA-T	2	TE-6315P-1	SENS, T-Ni, 0.1%, 8' AVG
FZ-17	1	A70HA-1C	STAT, LL, 20', EL, MAN, 15/55F
H-VLV, C-VLV	1	--	SEE VALVE SCHEDULE
OA-DMP	2	D-3153-2	DMPR ACT, 8-13#
	2	G-2010-11	GAGE, 2", 0-30 PSIG, STEM
TEF-B6	1	BZ-1000-11	ENCL, 4-5/8X 5-1/8 X 3-3/8
	1	PD-101-35	RLY BASE, 3PDT, 11PIN, 10A
	1	PD-109-51	RELAY PLUG-IN 3PDT 24VAC
ZN-T	1	TE-6410W-1000	MSTAT, NI, BOX, JACK
Panel Devices:			
EN-AHU-17	1	AS-UNT111-101	UNT111 MTD IN UPM, W/50VA
	2	EN-EXP101-0	UNIV PKG MOD, CVR & BACKEN
EP-1, 2	2	EP-8000-2	NDUCR, EP, 0/10V, HI VOL
EP-3	1	V11HGR-100	3-W SOLENOID, W/OV, 24 VAC
PI-1, 2, 3	3	G-2010-11	GAGE, 2", 0-30 PSIG, STEM
RLY-1	1	AS-RLY002-0	RELAY; 2SPDT 5 AMP 240VAC


SUPPLY FAN WIRING DIAGRAM

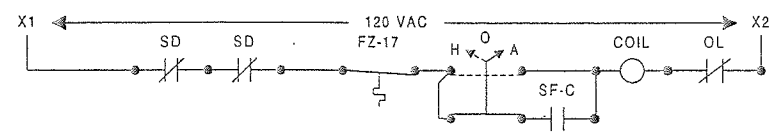

~~COOLING COIL PUMP DIAGRAM~~

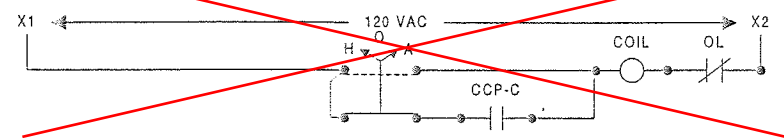

TOILET EXHAUST FAN DIAGRAM

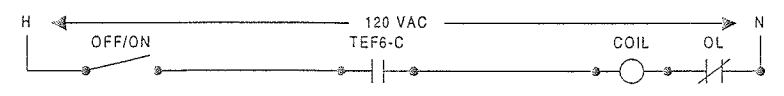

FAN	LOCATION	ELEC PANEL	CIRCUIT	LOCATION
TEF-B6	M CONCOURSE	STARTER		M CONCOURSE

DESCRIPTION OF OPERATION

THE METASYS SYSTEM WILL DETERMINE THE "OCCUPIED AND UNOCCUPIED" MODES OF OPERATION. OCCUPIED MODES GENERALLY OCCUR DURING STADIUM EVENTS, BUT MANUAL OVERRIDE THROUGH THE METASYS SYSTEM ON SELECTED UNITS WILL FREQUENTLY BE REQUIRED. WHEN THE UNIT IS DE-ENERGIZED, OUTSIDE AIR DAMPER D-17-1, AND COOLING COIL VALVE V-C-17, WILL CLOSE. COOLING COIL PUMP WILL BE OFF; RETURN AIR DAMPER D-17-2 WILL BE OPEN AND HEATING COIL VALVE V-H-17 WILL BE CLOSED TO THE COIL.

WARM-UP MODE - SUPPLY FAN WILL START AS DETERMINED BY THE OPTIMAL START PROGRAM OF THE METASYS SYSTEM. ON THE START OF THE UNIT, HEATING COIL VALVE V-H-17 WILL OPEN FULL TO COIL AND RETURN AIR DAMPER D-17-2 WILL BE FULLY OPEN WITH THE OUTSIDE AIR DAMPER D-17-1 CLOSED. EXHAUST FAN TEF-B6 WILL BE OFF AND EXHAUST AIR DAMPER D-17-3 (BDD) WILL BE CLOSED DURING THE WARM-UP MODE. DURATION OF THE WARM-UP MODE IS DETERMINED BY THE METASYS SYSTEM AND WILL BE DYNAMICALLY UPDATED TO END FIFTEEN (15) MINUTES PRIOR TO OCCUPANCY TIME. WARM-UP MODE IS STOPPED WHEN THE RETURN AIR TEMPERATURE REACHES THE SETTING OF T-1 (70F).

OCCUPIED HEATING MODE - SUPPLY FAN WILL BE RUNNING, RETURN AIR DAMPER D-17-2 WILL CLOSE, OUTSIDE AIR DAMPER D-17-1 WILL OPEN AND EXHAUST FAN TEF-B6 WILL START AND RUN CONTINUOUSLY CAUSING EXHAUST AIR DAMPER D-17-3 (BDD) TO OPEN AFTER THE WARM-UP MODE IS STOPPED. DISCHARGE AIR SENSOR T-2 THROUGH THE METASYS SYSTEM CONTROL UNIT, WILL ON A RISE IN TEMPERATURE ABOVE ITS SETTING OF FIFTY-FIVE (55F) MODULATE V-H-17 CLOSED TO THE HEATING COIL. ON A FALL IN TEMPERATURE, THIS CYCLE IS REVERSED. COOLING COIL VALVE V-C-17 WILL BE CLOSED TO THE COIL AND COIL CIRCULATION PUMP WILL BE OFF DURING THE HEATING MODE.



UNOCCUPIED HEATING MODE - ROOM SENSOR TR-17, WILL ON A FALL IN TEMPERATURE TO ITS SETTING OF FIFTY (50F), ACTIVATE THE SYSTEM TO RUN IN THE WARM-UP MODE AS HEREINBEFORE DESCRIBED. ON A RISE IN TEMPERATURE TO FIFTY-FIVE (55F), THE SYSTEM WILL BE DE-ENERGIZED. IN THE UNOCCUPIED MODE ALL AIR HANDLING UNIT DAMPERS AND CONTROLS WILL RETURN TO THEIR NORMAL POSITION READY FOR RESTARTING.

OCCUPIED COOLING MODE - SUPPLY AND EXHAUST FAN TEF-B6 AND COOLING COIL CIRCULATING PUMP START AND RUN CONTINUOUSLY. OUTSIDE DAMPER D-17-1 AND EXHAUST AIR DAMPER D-17-3 (BDD) WILL OPEN. DISCHARGE AIR SENSOR T-2 THROUGH THE METASYS SYSTEM CONTROL UNIT, WILL MODULATE CHILLED WATER VALVE V-C-17 TO MAINTAIN ITS SETTING OF FIFTY-FIVE (55F). THE HEATING COIL VALVE V-H-17 WILL BE CLOSED TO THE COIL.

UNOCCUPIED COOLING MODE - SYSTEM IS DE-ENERGIZED AND THE FANS ARE OFF.

SMOKE CONTROL - SMOKE DETECTORS WILL, ON THE DETECTION OF PRODUCTS OF COMBUSTION, SHUT DOWN THE SUPPLY AND EXHAUST FANS AND CLOSE ALL SYSTEM DAMPERS.

TOILET EXHAUST FAN TEF-B6 - THE FAN WILL START WHEN THE AHU SUPPLY FAN STARTS AND THE SYSTEM IS IN THE "OCCUPIED" MODE.

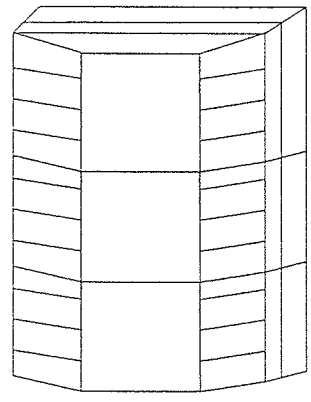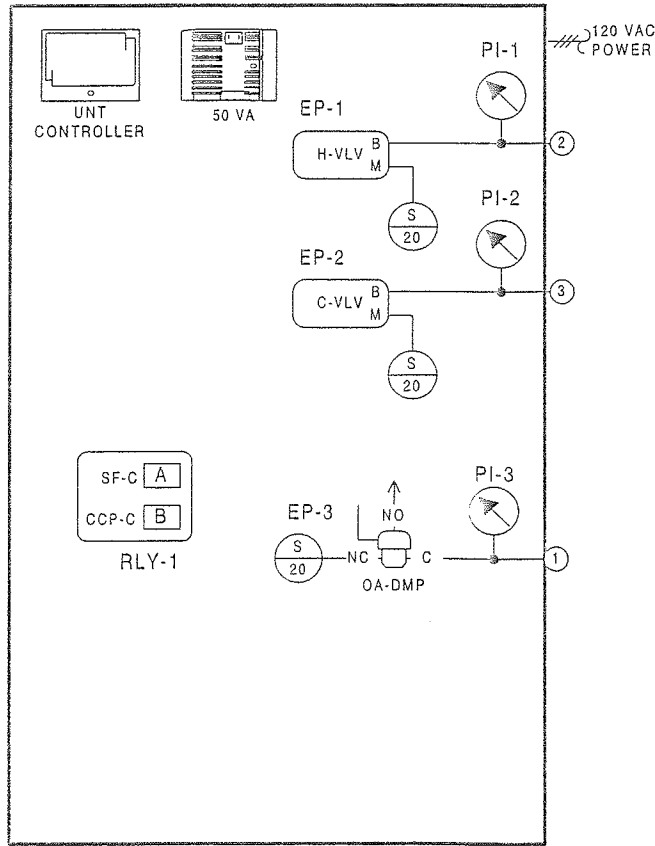

ENCLOSURE EN-AHU-17
AS-UNT111-101
LOCATED ADJACENT
TO UNIT
NCM-5/N2 ADD = 8

REVISION INFORMATION	DRAWING TITLE	AS-BUILT	DATE	BY
NUMBER	AIR HANDLING UNIT AHU-17 HOME TEAM AREA		7/18/06	CME
DATE	SERVICE LEVEL QUAD B	REFERENCE DRAWING	NO	REV SIGN-LOCATION
TIME		Sales Engineer	JDP	Project Manager
FILE NAME		Application Engineer	RTS	Application Engineer
AHU-17.vsd		PROJECT TITLE	B BALTIMORE NFL STADIUM AT CAMDEN YARDS	DATE
		PROJECT TITLE	B BALTIMORE, MARYLAND	DATE
		CONTRACT NUMBER	7052-0098	DATE
		DRAWING NUMBER	BL-6559-22	DATE

IN CONSIDERATION OF THE RECEIPT OF THIS DOCUMENT, THE RECIPIENT AGREES NOT TO REPRODUCE, COPY, USE OR TRANSMIT THIS DOCUMENT AND/OR THE INFORMATION THEREIN CONTAINED, IN WHOLE OR IN PART, OR TO SUFFER SUCH ACTION BY OTHERS, FOR ANY PURPOSE, EXCEPT WITH THE WRITTEN PERMISSION OF JOHNSON CONTROLS, INC. AND FURTHER AGREES TO SURRENDER SAME TO JOHNSON CONTROLS, INC. UPON DEMAND.


JOHNSON CONTROLS, INC. 1998

JOHNSON CONTROLS
Systems & Services Division


JOHNSON CONTROLS
60 LLOYDTON CIRCLE
SPARKS, MD 21152

BILL OF MATERIALS




Estimate:	ah-24	70520098.pre
Desig.	QtyPart #	Description
Field Devices:		
D-24-1	1 ---	SEE DAMPER SCHEDULE
FZ-24	1 A70HA-1C	STAT, LL, 20', EL, MAN, 15/55F
H-VLV, C-VLV	1 --	SEE VALVE SCHEDULE
OA-DMP	1 D-3153-2	DMPR ACT, S-13#
	1 G-2010-11	GAGE, 2", 0-30 PSIG, STEM
ZN-T	1 TE-6410W-1000	MSTAT, NI, BOX, JACK
Panel Devices:		
EN-AHU-24	1 AS-UNT111-101	UNT111 MTD IN UPM, W/50VA
	2 EN-EXP101-0	UNIV PKG MOD, CVR & BACKBN
EP-1, 2	2 EP-8000-2	XDUCR, EP, 0, 10V, HI VOL
EP-3	1 V11HGA-100	3-W SOLENOID, W/OV, 24 VAC
PI-1, 2, 3	3 G-2010-11	GAGE, 2", 0-30 PSIG, STEM
RLY-1	1 AS-RLY002-0	RELAY; 2SPDT 5 AMP 240VAC

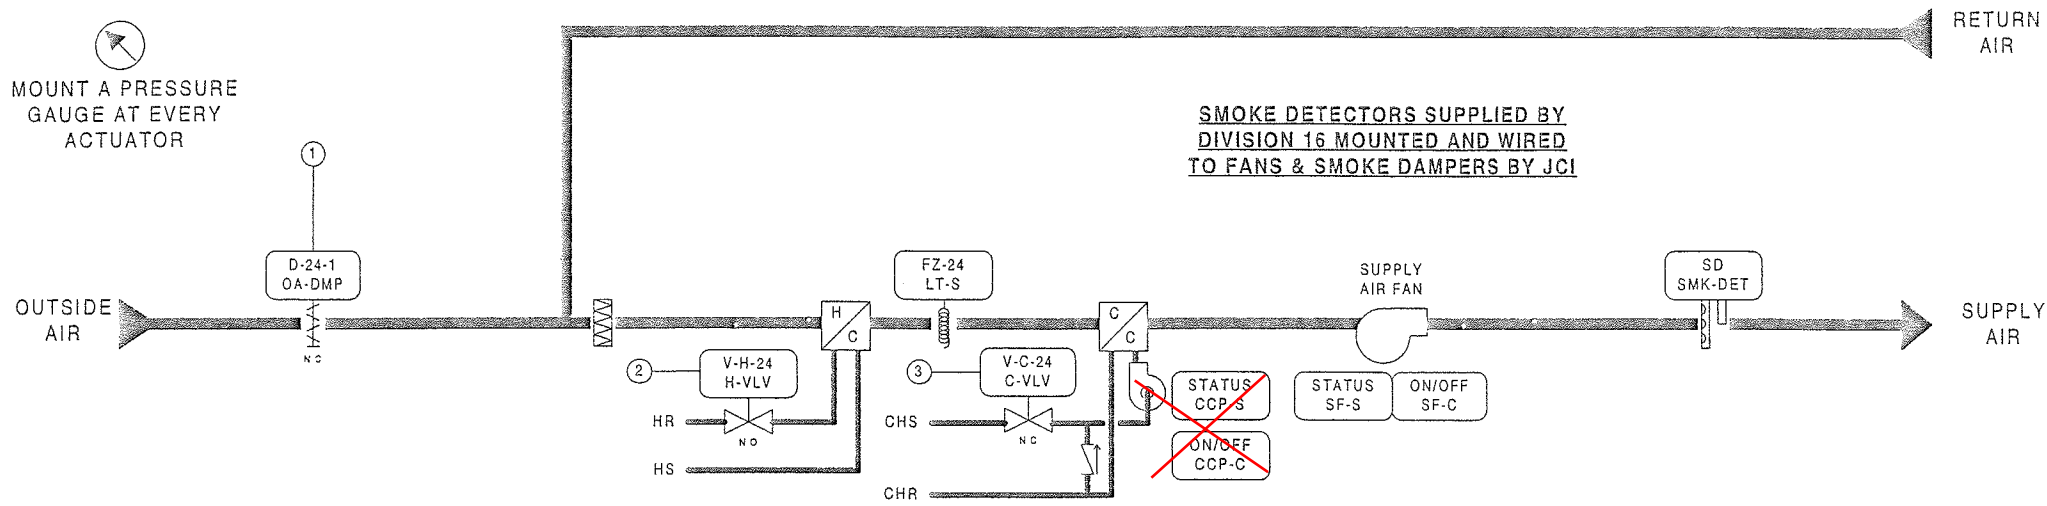

SUPPLY FAN WIRING DIAGRAM

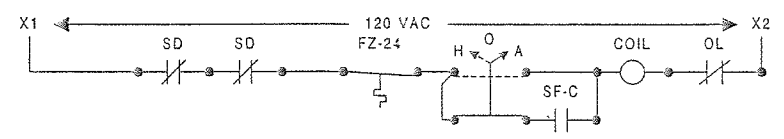

~~**COOLING COIL PUMP DIAGRAM**~~

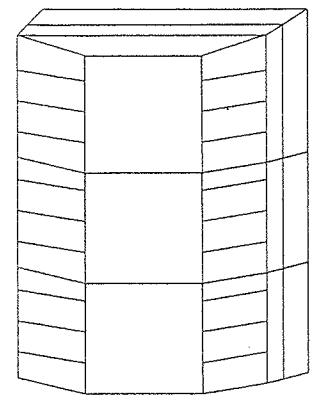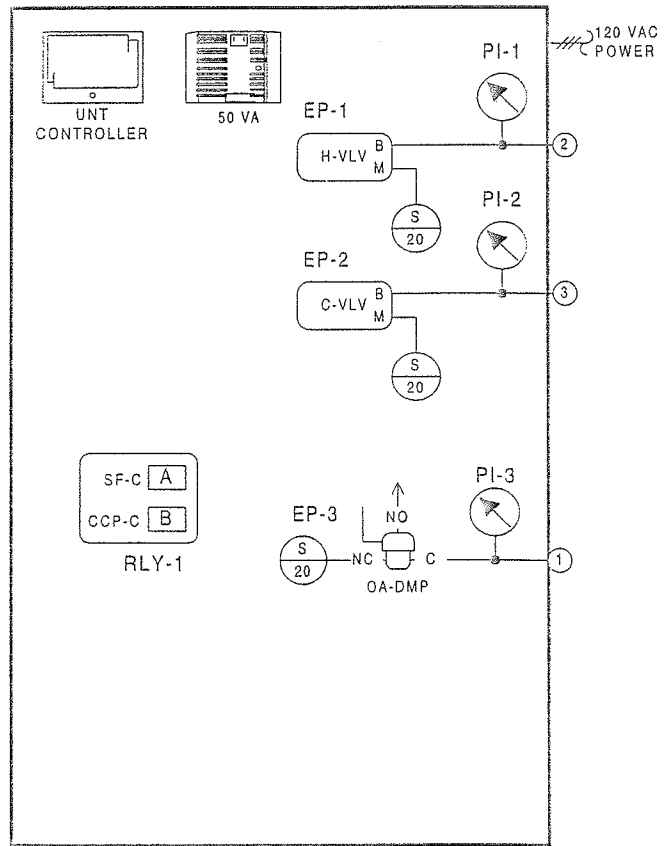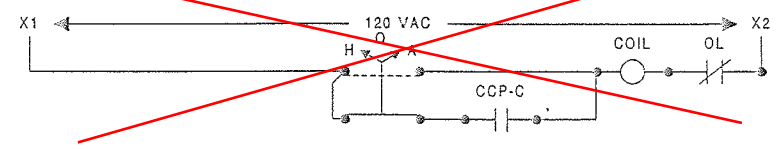

ENCLOSURE EN-AHU-24
AS-UNT111-101
LOCATED ADJACENT TO UNIT
NCM-3/N2 ADD = 5

DESCRIPTION OF OPERATION

THE METASYS SYSTEM WILL DETERMINE THE "OCCUPIED AND UNOCCUPIED" MODES OF OPERATION. OCCUPIED MODES GENERALLY OCCUR DURING STADIUM EVENTS, BUT MANUAL OVERRIDE THROUGH THE METASYS SYSTEM ON SELECTED UNITS WILL FREQUENTLY BE REQUIRED. WHEN THE UNIT IS DE-ENERGIZED, OUTSIDE AIR DAMPER D-24-1, AND COOLING COIL VALVE V-C-24 WILL CLOSE; COOLING COIL PUMP WILL BE OFF, AND HEATING COIL VALVE V-H-24 WILL BE CLOSED TO THE COIL.

OCCUPIED MODE - SUPPLY FAN WILL BE RUNNING, OUTSIDE AIR DAMPER D-24-1 WILL OPEN. ROOM SENSOR TR-24 THROUGH THE METASYS SYSTEM CONTROL UNIT WILL MODULATE HEATING COIL VALVE V-H-24 AND COOLING COIL VALVE V-C-24 IN SEQUENCE TO MAINTAIN ITS SETTING OF SEVENTY-FIVE (75F). COOLING COIL PUMP WILL START AND RUN CONTINUOUSLY WHENEVER THE COOLING COIL VALVE V-C-24 IS MODULATED OPEN.

UNOCCUPIED MODE - ROOM SENSOR TR-24 WILL ON A FALL IN TEMPERATURE TO ITS SETTING OF FIFTY (50F). ACTIVATE THE SYSTEM TO RUN IN THE OCCUPIED MODE AS HEREINBEFORE DESCRIBED EXCEPT OUTSIDE AIR DAMPER D-24-1 WILL REMAIN CLOSED. ON A RISE IN TEMPERATURE TO FIFTY-FIVE (55F), THE SYSTEM WILL BE DE-ENERGIZED. IN THE UNOCCUPIED MODE ALL AIR HANDLING UNIT DAMPERS AND CONTROLS WILL RETURN TO THEIR NORMAL POSITION READY FOR RESTARTING.

SMOKE CONTROL - SMOKE DETECTORS WILL, ON THE DETECTION OF PRODUCTS OF COMBUSTION, SHUT DOWN THE SUPPLY AND EXHAUST FANS AND CLOSE ALL SYSTEM DAMPERS.


REVISION INFORMATION NUMBER: _____ DATE: 07/18/00 TIME: 03:25 PM FILE NAME: AHU-21.vsd	IN CONSIDERATION OF THE RECEIPT OF THIS DOCUMENT, THE RECIPIENT AGREES NOT TO REPRODUCE, COPY, USE OR TRANSMIT THIS DOCUMENT AND/OR THE INFORMATION THEREIN CONTAINED, IN WHOLE OR IN PART, OR TO SUFFER SUCH ACTION BY OTHERS, FOR ANY PURPOSE, EXCEPT WITH THE WRITTEN PERMISSION OF JOHNSON CONTROLS, INC. AND FURTHER AGREES TO SURRENDER SAME TO JOHNSON CONTROLS, INC. UPON DEMAND. COPYRIGHT JOHNSON CONTROLS, INC. 1998	DRAWING TITLE AIR HANDLING UNIT AHU-24 TICKET OFFICE MAIN CONOURSE QUAD C PROJECT TITLE BALTIMORE NFL STADIUM AT CAMDEN YARDS BALTIMORE, MARYLAND	<table border="1"> <tr> <td>AS-BUILT</td> <td>NO</td> <td>REVISION/DESCRIPTION</td> <td>EDN</td> <td>DATE</td> <td>BY</td> </tr> <tr> <td></td> <td></td> <td></td> <td></td> <td></td> <td></td> </tr> </table> <p> JOHNSON CONTROLS Systems & Services Division JOHNSON CONTROLS 60 LOVETON CIRCLE SPARKS, MD 21152 CONTRACT NUMBER 7052-0098 DRAWN BY BL-6589-26 </p>	AS-BUILT	NO	REVISION/DESCRIPTION	EDN	DATE	BY						
AS-BUILT	NO	REVISION/DESCRIPTION	EDN	DATE	BY										

Full Spreadsheet		Software				Digital Controller Information						Panel Information				Intermediate Device				Field Device								
Tag	Point Type	System Name	Object Name	Expanded ID	Display Units	DC Type	N2 Trunk	N2 Addr	Cable Destination Bay/Terminal	Module Type	Termination	Panel	Panel Location	Slot Number	Reference Drawing	Cable Number	Wiring/Tubing	Termination In	Device	Termination Out	Location	Wiring/Tubing	Terminations	Device	Location	Ref Detail	Comment	
		AHU-24				UNT						EN-AHU24	IAT UNIT														Power to Controller	
		AHU-24				UNT		5				EN-AHU24	IAT UNIT	0													N2 Trunk	
AI-1		AHU-24				UNT		5	AI-1			EN-AHU24	IAT UNIT	0		AHU24-5-AI-1												
AI-2		AHU-24				UNT		5	AI-2			EN-AHU24	IAT UNIT	0		AHU24-5-AI-2												
AI-3		AHU-24				UNT		5	AI-3			EN-AHU24	IAT UNIT	0		AHU24-5-AI-3												
AI-4		AHU-24	ZN-T	Zone Temperature	Deg F	UNT		5	AI-4		PHONE JACK	EN-AHU24	IAT UNIT	0		AHU24-5-AI-4					8/26	PHONE JACK	TE-6410W-1000		U2			
AI-5		AHU-24				UNT		5	AI-5			EN-AHU24	IAT UNIT	0		AHU24-5-AI-5												
AI-6		AHU-24				UNT		5	AI-6			EN-AHU24	IAT UNIT	0		AHU24-5-AI-6												
BI-1		AHU-24	SF-S	Supply Fan Status	Off On	UNT		5	BI-1		BI#,24VAC	EN-AHU24	IAT UNIT	0		AHU24-5-BI-1					2/22	Device dependent	Aux Contact (NO)		U70			
BI-2		AHU-24	SMK-DET	Smoke Detectors	Normal Alarm	UNT		5	BI-2		BI#,24VAC	EN-AHU24	IAT UNIT	0		AHU24-5-BI-2					2/22	Device dependent	Contact (NO)		U70			
BI-3		AHU-24	LT-S	Low Temperature Stat	Normal Alarm	UNT		5	BI-3		BI#,24VAC	EN-AHU24	IAT UNIT	0		AHU24-5-BI-3					2/22	NO,M1	A70 (NC)		U71			
BI-4		AHU-24	CCP-S	Clg Coil Pump Status	Off On	UNT		5	BI-4		BI#,24VAC	EN-AHU24	IAT UNIT	0		AHU24-5-BI-4					2/22	Device dependent	Aux Contact (NO)		U70			
BO-1		AHU-24	SF-C	Supply Fan Control	Off On	UNT		5	BO-1	RLY	BO#,24V,COM	EN-AHU24	IAT UNIT	0		AHU24-5-BO-1	3/18	A.COILS.COM	RELAY-A	NO,COM		2/14	See starter detail	Starter (NO)-(sw lo)		U60		
BO-2		AHU-24				UNT		5	BO-2			EN-AHU24	IAT UNIT	0		AHU24-5-BO-2												
BO-3		AHU-24	OA-DMP	Outside Air Damper	Closed Open	UNT		5	BO-3		BO#,24VAC	EN-AHU24	IAT UNIT	0		AHU24-5-BO-3			V11HGA-100		2/18	Device dependent	24VAC OUT (sw lo)		U51			
BO-4		AHU-24	CCP-C	Clg Coil Pump Control	Off On	UNT		5	BO-4	RLY	BO#,24V,COM	EN-AHU24	IAT UNIT	0		AHU24-5-BO-4	3/18	B.COILS.COM	RELAY-B	NO,COM		2/14	See starter detail	Starter (NO)-(sw lo)		U60		
BO-5		AHU-24				UNT		5	BO-5			EN-AHU24	IAT UNIT	0		AHU24-5-BO-5												
BO-6		AHU-24				UNT		5	BO-6			EN-AHU24	IAT UNIT	0		AHU24-5-BO-6												
AO-1		AHU-24	H-VLV	Heating Coil Valve	% Open	UNT		5	AO-1		AO#,AOCCM,24VAC	EN-AHU24	IAT UNIT	0		AHU24-5-AO-1	2/18	+-	EP-8000-2	SUPPLY_O		3/18	Device dependent	0-10V OUT		U23		
AO-2		AHU-24	C-VLV	Cooling Coil Valve	% Open	UNT		5	AO-2		AO#,AOCCM,24VAC	EN-AHU24	IAT UNIT	0		AHU24-5-AO-2	2/18	+-	EP-8000-2	SUPPLY_O		3/18	Device dependent	0-10V OUT		U23		


BILL OF MATERIALS

Estimate: ahu-25 70520098.pre




Desig.	Qty	Part #	Description
Field Devices:			
D-25-1	1	---	SEE DAMPER SCHEDULE
FZ-25	1	A70HA-1C	STAT, LL, 20', EL, MAN, 15/55F
H-VLV, C-VLV	1	--	SEE VALVE SCHEDULE
OA-DMP	1	D-3153-2	DMPR ACT, S-13#
	1	G-2010-11	GAGE, 2", 0-30 PSIG, STEM
ZN-T	1	TE-6410W-1000	MSTAT, NI, BOX, JACK
Panel Devices:			
EN-AHU-25	1	AS-UNT111-101	UNT111 MTD IN UPM, W/50VA
	2	EN-EXP101-0	UNIV PKG MOD, CVR & BACKBN
EP-1, 2	2	EP-8000-2	XDUCR, EP, 0' 10V, HI VOL
EP-3	1	V11HGA-100	3-W SOLENOID, W/OV, 24 VAC
PI-1, 2, 3	3	G-2010-11	GAGE, 2", 0-30 PSIG, STEM
RLY-1	1	AS-RLY002-0	RELAY; 2SPDT 5 AMP 240VAC

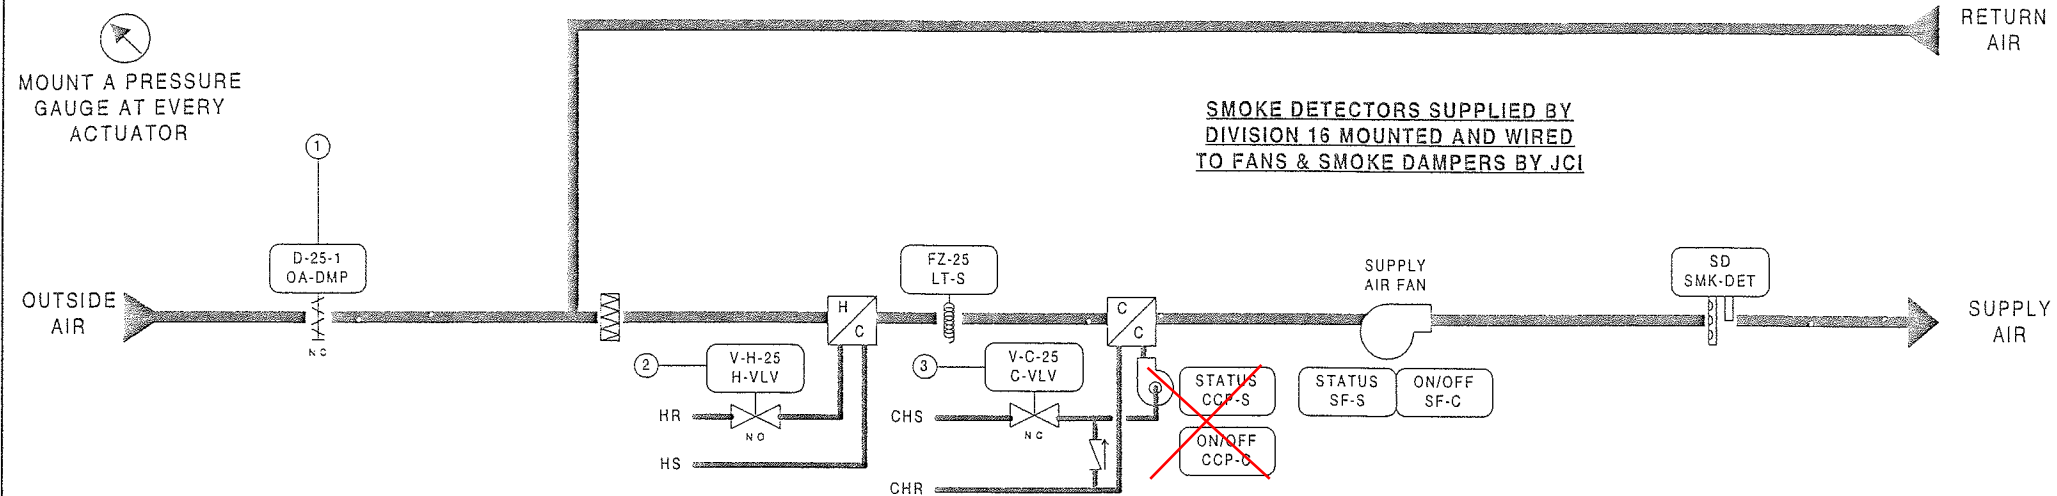

SUPPLY FAN WIRING DIAGRAM

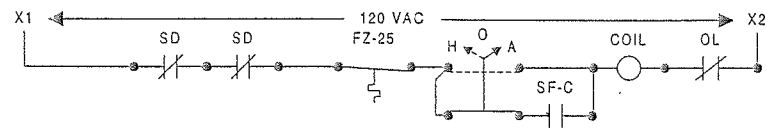

COOLING COIL PUMP DIAGRAM

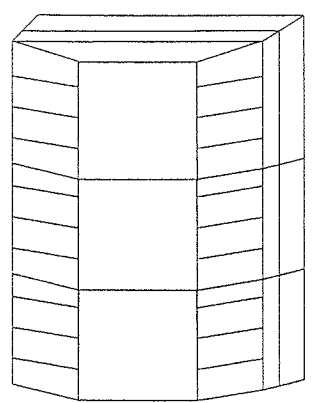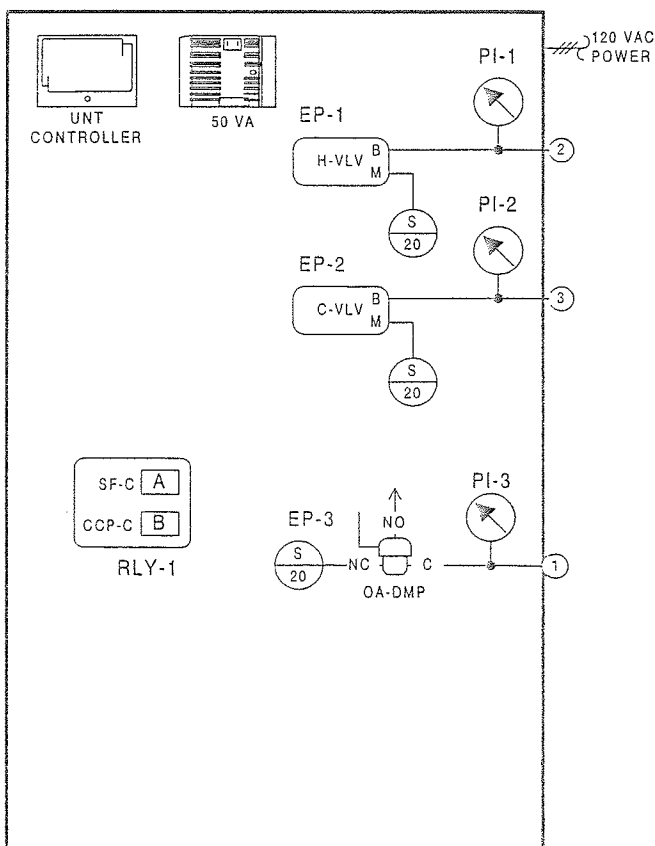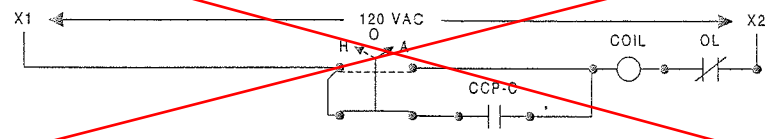

ENCLOSURE EN-AHU-25
AS-UNT111-101
LOCATED ADJACENT
TO UNIT
NCM-4/N2 ADD = 3

DESCRIPTION OF OPERATION

THE METASYS SYSTEM WILL DETERMINE THE "OCCUPIED AND UNOCCUPIED" MODES OF OPERATION. OCCUPIED MODES GENERALLY OCCUR DURING STADIUM EVENTS, BUT MANUAL OVERRIDE THROUGH THE METASYS SYSTEM ON SELECTED UNITS WILL FREQUENTLY BE REQUIRED. WHEN THE UNIT IS DE-ENERGIZED, OUTSIDE AIR DAMPER D-25-1, AND COOLING COIL VALVE V-C-25, WILL CLOSE; COOLING COIL PUMP WILL BE OFF, AND HEATING COIL VALVE V-H-25 WILL BE CLOSED TO THE COIL.

OCCUPIED MODE - SUPPLY FAN WILL BE RUNNING, OUTSIDE AIR DAMPER D-25-1 WILL OPEN. ROOM SENSOR TR-25 THROUGH THE METASYS SYSTEM CONTROL UNIT, WILL MODULATE HEATING COIL VALVE V-H-25 AND COOLING COIL VALVE V-C-25, IN SEQUENCE TO MAINTAIN ITS SETTING OF SEVENTY-FIVE (75F). COOLING COIL PUMP WILL START AND RUN CONTINUOUSLY WHENEVER THE COOLING COIL VALVE V-C-25 IS MODULATED OPEN.


UNOCCUPIED MODE - ROOM SENSOR TR-25, WILL ON A FALL IN TEMPERATURE TO ITS SETTING OF FIFTY (50F), ACTIVATE THE SYSTEM TO RUN IN THE OCCUPIED MODE AS HEREINBEFORE DESCRIBED EXCEPT OUTSIDE AIR DAMPER D-25-1 WILL REMAIN CLOSED. ON A RISE IN TEMPERATURE TO FIFTY-FIVE (55F), THE SYSTEM WILL BE DE-ENERGIZED. IN THE UNOCCUPIED MODE ALL AIR HANDLING UNIT DAMPERS AND CONTROLS WILL RETURN TO THEIR NORMAL POSITION READY FOR RESTARTING.

SMOKE CONTROL - SMOKE DETECTORS WILL, ON THE DETECTION OF PRODUCTS OF COMBUSTION, SHUT DOWN THE SUPPLY AND EXHAUST FANS AND CLOSE ALL SYSTEM DAMPERS.

<p>REVISION INFORMATION</p> <p>NUMBER</p> <p>DATE 07/18/00</p> <p>TIME 03:24 PM</p> <p>FILE NAME AHU-25.vsd</p>	<p>IN CONSIDERATION OF THE RECEIPT OF THIS DOCUMENT, THE RECIPIENT AGREES NOT TO REPRODUCE, COPY, USE OR TRANSMIT THIS DOCUMENT AND/OR THE INFORMATION THEREIN CONTAINED, IN WHOLE OR IN PART, OR TO SUFFER SUCH ACTION BY OTHERS, FOR ANY PURPOSE, EXCEPT WITH THE WRITTEN PERMISSION OF JOHNSON CONTROLS, INC. AND FURTHER AGREES TO SURRENDER SAME TO JOHNSON CONTROLS, INC. UPON DEMAND.</p> <p>COPYRIGHT JOHNSON CONTROLS, INC. 1999</p>	<p>DRAWING TITLE</p> <p>AIR HANDLING UNIT AHU-25 TICKET OFFICE</p> <p>MAIN CONOURSE QUAD D</p> <p>PROJECT TITLE</p> <p>BALTIMORE NFL STADIUM AT CAMDEN YARDS</p> <p>BALTIMORE, MARYLAND</p>	<table border="1"> <tr> <td>AS-BUILT</td> <td>7/18/00</td> <td>CVE</td> </tr> <tr> <td>REFERENCE DRAWING</td> <td>NO.</td> <td>REVISION-LOCATION</td> </tr> <tr> <td>Sales Eng. JDP</td> <td>Project Manager WJT</td> <td>Application Engineer RTS</td> </tr> <tr> <td>BY RTS</td> <td>DATE 09/05/97</td> <td>BY DATE</td> </tr> </table> <p>Branch Information</p> <p>JOHNSON CONTROLS Systems & Services Division</p> <p>JOHNSON CONTROLS 60 LOVETON CIRCLE SPARKS, MD 21152</p> <p>CONTRACT NUMBER 7052-0098</p> <p>DRAWING NUMBER BL-6559-27</p>	AS-BUILT	7/18/00	CVE	REFERENCE DRAWING	NO.	REVISION-LOCATION	Sales Eng. JDP	Project Manager WJT	Application Engineer RTS	BY RTS	DATE 09/05/97	BY DATE
AS-BUILT	7/18/00	CVE													
REFERENCE DRAWING	NO.	REVISION-LOCATION													
Sales Eng. JDP	Project Manager WJT	Application Engineer RTS													
BY RTS	DATE 09/05/97	BY DATE													

Full Spreadsheet		Software				Digital Controller Information						Panel Information					Intermediate Device				Field Device				Ref Detail	Comment		
Tag	Point Type	System Name	Object Name	Expanded ID	Display Units	DC Type	N2 Trunk	N2 Addr	Cable Destination Bay/Terminal	Module Type	Termination	Panel	Panel Location	Slot Number	Reference Drawing	Cable Number	Wiring/Tubing	Termination In	Device	Termination Out	Location	Wiring/Tubing	Terminations	Device	Location	Ref Detail	Comment	
		AHU-25				UNT						EN-AHU25	AT UNIT														Power to Controller	
		AHU-25				UNT	1	3				EN-AHU25	AT UNIT	0													N2 Trunk	
AI-1		AHU-25				UNT	1	3	AI-1			EN-AHU25	AT UNIT	0		AHU25-3-AI-1												
AI-2		AHU-25				UNT	1	3	AI-2			EN-AHU25	AT UNIT	0		AHU25-3-AI-2												
AI-3		AHU-25				UNT	1	3	AI-3			EN-AHU25	AT UNIT	0		AHU25-3-AI-3												
AI-4		AHU-25	ZN-T	Zone Temperature	Deg F	UNT	1	3	AI-4		PHONE JACK	EN-AHU25	AT UNIT	0		AHU25-3-AI-4					8/26	PHONE JACK	TE-6410W-1000		U2			
AI-5		AHU-25				UNT	1	3	AI-5			EN-AHU25	AT UNIT	0		AHU25-3-AI-5												
AI-6		AHU-25				UNT	1	3	AI-6			EN-AHU25	AT UNIT	0		AHU25-3-AI-6												
BI-1		AHU-25	SF-S	Supply Fan Status	Off On	UNT	1	3	BI-1		BI#,24VAC	EN-AHU25	AT UNIT	0		AHU25-3-BI-1						2/22	Device dependent	Aux Contact (NO)		U70		
BI-2		AHU-25	SMK-DET	Smoke Detectors	Normal Alarm	UNT	1	3	BI-2		BI#,24VAC	EN-AHU25	AT UNIT	0		AHU25-3-BI-2						2/22	Device dependent	Contact (NO)		U70		
BI-3		AHU-25	LT-S	Low Temperature Stat	Normal Alarm	UNT	1	3	BI-3		BI#,24VAC	EN-AHU25	AT UNIT	0		AHU25-3-BI-3						2/22	NO,M1	A70 (NC)		U71		
BI-4		AHU-25	CCP-S	Cig Coil Pump Status	Off On	UNT	1	3	BI-4		BI#,24VAC	EN-AHU25	AT UNIT	0		AHU25-3-BI-4						2/22	Device dependent	Aux Contact (NO)		U70		
BO-1		AHU-25	SF-C	Supply Fan Control	Off On	UNT	1	3	BO-1	RLY	BO#,24V.COM	EN-AHU25	AT UNIT	0		AHU25-3-BO-13/18	A,COILS.COM	RELAY-A	NO.COM			2/14	See starter detail	Starter (NO)-(sw lo)		U60		
BO-2		AHU-25				UNT	1	3	BO-2			EN-AHU25	AT UNIT	0		AHU25-3-BO-2												
BO-3		AHU-25	OA-DMP	Outside Air Damper	Closed Open	UNT	1	3	BO-3		BO#,24VAC	EN-AHU25	AT UNIT	0		AHU25-3-BO-3			V11HGA-100			2/18	Device dependent	24VAC OUT (sw lo)		U51		
BO-4		AHU-25	CCP-C	Cig Coil Pump Control	Off On	UNT	1	3	BO-4	RLY	BO#,24V.COM	EN-AHU25	AT UNIT	0		AHU25-3-BO-43/18	B,COILS.COM	RELAY-B	NO.COM			2/14	See starter detail	Starter (NO)-(sw lo)		U60		
BO-5		AHU-25				UNT	1	3	BO-5			EN-AHU25	AT UNIT	0		AHU25-3-BO-5												
BO-6		AHU-25				UNT	1	3	BO-6			EN-AHU25	AT UNIT	0		AHU25-3-BO-6												
AO-1		AHU-25	H-VLV	Heating Coil Valve	% Open	UNT	1	3	AO-1		AO#,AOCM,24VAC	EN-AHU25	AT UNIT	0		AHU25-3-AO-12/18	+-	EP-8000-2	SUPPLY, O			3/18	Device dependent	0-10V OUT		U23		
AO-2		AHU-25	C-VLV	Cooling Coil Valve	% Open	UNT	1	3	AO-2		AO#,AOCM,24VAC	EN-AHU25	AT UNIT	0		AHU25-3-AO-22/18	+-	EP-8000-2	SUPPLY, O			3/18	Device dependent	0-10V OUT		U23		

MOUNT A PRESSURE GAUGE AT EVERY ACTUATOR

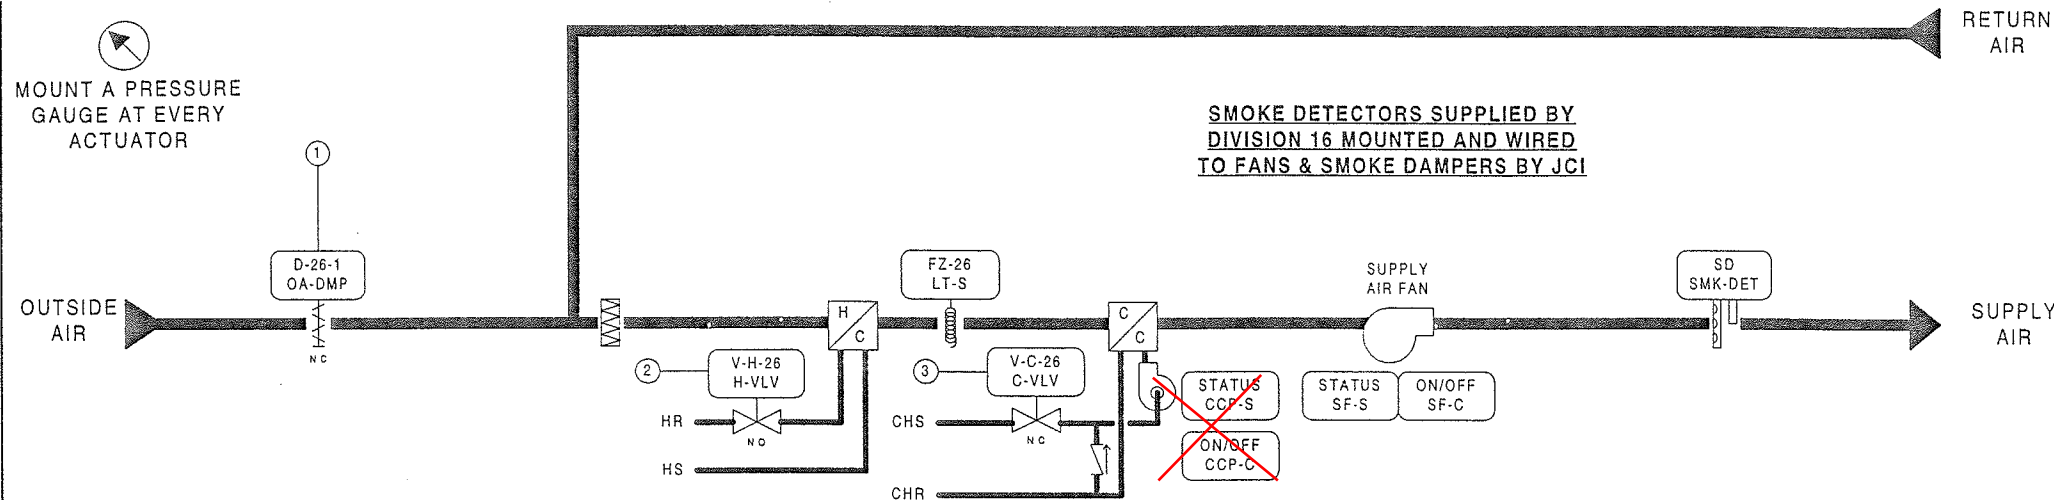


SMOKE DETECTORS SUPPLIED BY DIVISION 16 MOUNTED AND WIRED TO FANS & SMOKE DAMPERS BY JCI




BILL OF MATERIALS

Estimate:	ahu-26	70520098.pre
Desig.	QtyPart #	Description
Field Devices:		
D-26-1	1 ---	SEE DAMPER SCHEDULE
FZ-26	1 A70HA-1C	STAT,LL,20',EL,MAN,15/55F
H-VLV,C-VLV	1 --	SEE VALVE SCHEDULE
OA-DMP	1 D-3153-2	DMPR ACT,8-13#
	1 G-2010-11	GAGE,2",0-30 PSIG,STEM
ZN-T	1 TE-6410W-1000	MSTAT,NI,BOX,JACK
Panel Devices:		
EN-AHU-26	1 AS-UNT111-101	UNT111 MTD IN UPM, W/50VA
	2 EN-EXP101-0	UNIV PRG MOD,CVR & BACKBN
EP-1,2	2 EP-8000-2	XDUCR,EP,0.10V,HI VOL
EP-3	1 V11HGA-100	3-W SOLENOID,W/OV,24 VAC
PI-1,2,3	3 G-2010-11	GAGE,2",0-30 PSIG,STEM
RLY-1	1 AS-RLY002-0	RELAY; 2SPDT 5 AMP 240VAC

SUPPLY FAN WIRING DIAGRAM

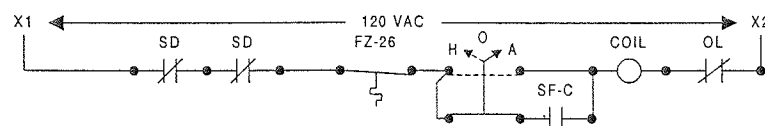

~~COOLING COIL PUMP DIAGRAM~~

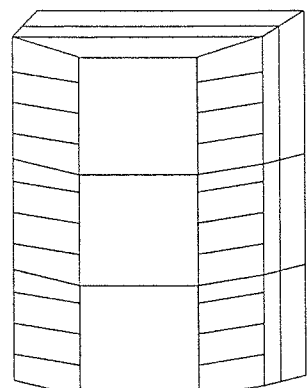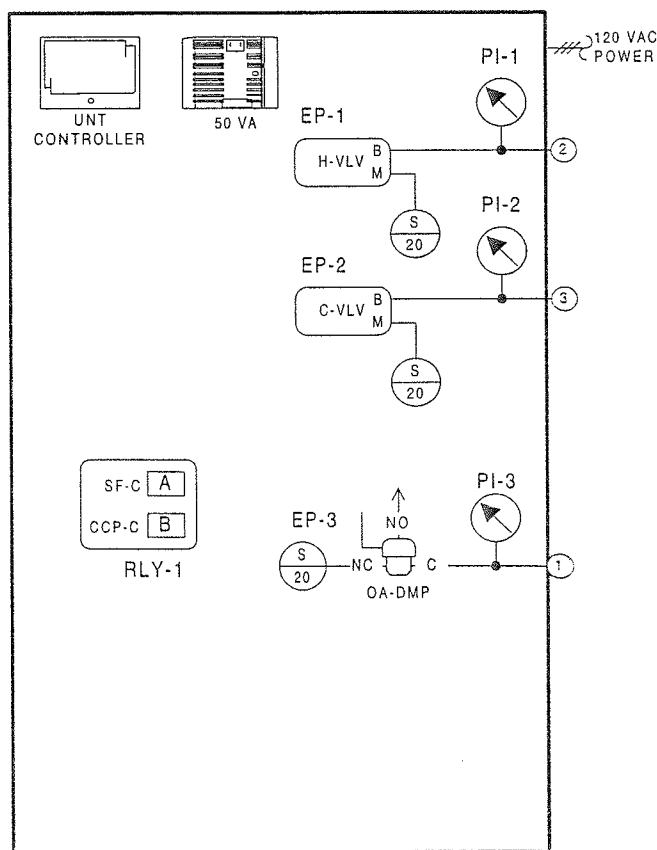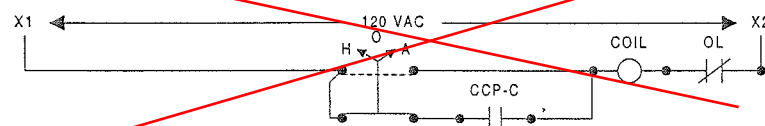

ENCLOSURE EN-AHU-26
AS-UNT111-101
LOCATED ADJACENT TO UNIT
NCM-2/N2 ADD = 2

DESCRIPTION OF OPERATION:

THE METASYS SYSTEM WILL DETERMINE THE "OCCUPIED AND UNOCCUPIED" MODES OF OPERATION. OCCUPIED MODES GENERALLY OCCUR DURING STADIUM EVENTS, BUT MANUAL OVERRIDE THROUGH THE METASYS SYSTEM ON SELECTED UNITS WILL FREQUENTLY BE REQUIRED. WHEN THE UNIT IS DE-ENERGIZED, OUTSIDE AIR DAMPER D-26-1, AND COOLING COIL VALVE V-C-26 WILL CLOSE; COOLING COIL PUMP WILL BE OFF, AND HEATING COIL VALVE V-H-26 WILL BE CLOSED TO THE COIL.


OCCUPIED MODE - SUPPLY FAN WILL BE RUNNING, OUTSIDE AIR DAMPER D-26-1 WILL OPEN. ROOM SENSOR TR-26 THROUGH THE METASYS SYSTEM CONTROL UNIT, WILL MODULATE HEATING COIL VALVE V-H-26 AND COOLING COIL VALVE V-C-26 IN SEQUENCE TO MAINTAIN ITS SETTING OF SEVENTY-FIVE (75F). COOLING COIL PUMP WILL START AND RUN CONTINUOUSLY WHENEVER THE COOLING COIL VALVE V-C-26 IS MODULATED OPEN.

UNOCCUPIED MODE - ROOM SENSOR TR-26, WILL ON A FALL IN TEMPERATURE TO ITS SETTING OF FIFTY (50F). ACTIVATE THE SYSTEM TO RUN IN THE OCCUPIED MODE AS HEREINBEFORE DESCRIBED EXCEPT OUTSIDE AIR DAMPER D-26-1 WILL REMAIN CLOSED. ON A RISE IN TEMPERATURE TO FIFTY-FIVE (55F), THE SYSTEM WILL BE DE-ENERGIZED. IN THE UNOCCUPIED MODE ALL AIR HANDLING UNIT DAMPERS AND CONTROLS WILL RETURN TO THEIR NORMAL POSITION READY FOR RESTARTING.

SMOKE CONTROL - SMOKE DETECTORS WILL, ON THE DETECTION OF PRODUCTS OF COMBUSTION, SHUT DOWN THE SUPPLY AND EXHAUST FANS AND CLOSE ALL SYSTEM DAMPERS.

REVISION INFORMATION NUMBER: _____ DATE: 07/18/00 TIME: 03:25 PM FILE NAME: AHU-26.vsd	IN CONSIDERATION OF THE RECEIPT OF THIS DOCUMENT, THE RECIPIENT AGREES NOT TO REPRODUCE, COPY, USE OR TRANSMIT THIS DOCUMENT AND/OR THE INFORMATION THEREIN CONTAINED, IN WHOLE OR IN PART, OR TO SUFFER SUCH ACTION BY OTHERS, FOR ANY PURPOSE, EXCEPT WITH THE WRITTEN PERMISSION OF JOHNSON CONTROLS, INC. AND FURTHER AGREES TO SURRENDER SAME TO JOHNSON CONTROLS, INC. UPON DEMAND. COPYRIGHT JOHNSON CONTROLS, INC. 1999	DRAWING TITLE AIR HANDLING UNIT AHU-26 TICKET OFFICE MAIN CONOURSE QUAD B PROJECT TITLE BALTIMORE NFL STADIUM AT CAMDEN YARDS BALTIMORE, MARYLAND	<table border="1"> <tr> <td>AS-BUILT</td> <td>NO</td> <td>REVISION-LOCATION</td> <td>ECN</td> <td>DATE</td> <td>BY</td> </tr> <tr> <td>7/18/00</td> <td>CME</td> <td></td> <td></td> <td></td> <td></td> </tr> </table> <table border="1"> <tr> <td>SALES ENGINEER</td> <td>PROJECT MANAGER</td> <td>APPLICATION ENGINEER</td> <td>DRAWN</td> <td>APPROVED</td> </tr> <tr> <td>JDP</td> <td>WJT</td> <td>RTS</td> <td></td> <td></td> </tr> </table> <table border="1"> <tr> <td>BY</td> <td>DATE</td> <td>BY</td> <td>DATE</td> </tr> <tr> <td>RTS</td> <td>9/05/97</td> <td></td> <td></td> </tr> </table>	AS-BUILT	NO	REVISION-LOCATION	ECN	DATE	BY	7/18/00	CME					SALES ENGINEER	PROJECT MANAGER	APPLICATION ENGINEER	DRAWN	APPROVED	JDP	WJT	RTS			BY	DATE	BY	DATE	RTS	9/05/97			<table border="1"> <tr> <td>CONTRACT NUMBER</td> <td>7052-0098</td> </tr> <tr> <td>DRAWING NUMBER</td> <td>BL-6559-28</td> </tr> </table>	CONTRACT NUMBER	7052-0098	DRAWING NUMBER	BL-6559-28
AS-BUILT	NO	REVISION-LOCATION	ECN	DATE	BY																																	
7/18/00	CME																																					
SALES ENGINEER	PROJECT MANAGER	APPLICATION ENGINEER	DRAWN	APPROVED																																		
JDP	WJT	RTS																																				
BY	DATE	BY	DATE																																			
RTS	9/05/97																																					
CONTRACT NUMBER	7052-0098																																					
DRAWING NUMBER	BL-6559-28																																					

Full Spreadsheet	Software					Digital Controller Information						Panel Information					Intermediate Device					Field Device				Ref Detail	Comment			
	Tag	Point Type	System Name	Object Name	Expanded ID	Display Units	DC Type	N2 Trunk	N2 Addr	Cable Destination Bay/Terminal	Module Type	Termination	Panel	Panel Location	Slot Number	Reference Drawing	Cable Number	Wiring/Termination In	Termination In	Device	Termination Out	Location	Wiring/Termination In	Termination In	Device			Location	Ref Detail	Comment
		AHU-26										EN-AHU26	AT UNIT																Power to Controller	
		AHU-26						1	2			EN-AHU26	AT UNIT	0															N2 Trunk	
AI-1		AHU-26							2AI-1			EN-AHU26	AT UNIT	0		AHU26-2-AI-1														
AI-2		AHU-26							2AI-2			EN-AHU26	AT UNIT	0		AHU26-2-AI-2														
AI-3		AHU-26							2AI-3			EN-AHU26	AT UNIT	0		AHU26-2-AI-3														
AI-4		AHU-26	ZN-T	Zone Temperature	Deg F				2AI-4		PHONE JACK	EN-AHU26	AT UNIT	0		AHU26-2-AI-4						8/26	PHONE JACK	TE-6410W-1000		U2				
AI-5		AHU-26							2AI-5			EN-AHU26	AT UNIT	0		AHU26-2-AI-5														
AI-6		AHU-26							2AI-6			EN-AHU26	AT UNIT	0		AHU26-2-AI-6														
BI-1		AHU-26	SF-S	Supply Fan Status	Off On				2BI-1		BI#,24VAC	EN-AHU26	AT UNIT	0		AHU26-2-BI-1						2/22	Device dependent	Aux Contact (NO)		U70				
BI-2		AHU-26	SMK-DET	Smoke Detectors	Normal Alarm				2BI-2		BI#,24VAC	EN-AHU26	AT UNIT	0		AHU26-2-BI-2						2/22	Device dependent	Contact (NO)		U70				
BI-3		AHU-26	LT-S	Low Temperature Stat	Normal Alarm				2BI-3		BI#,24VAC	EN-AHU26	AT UNIT	0		AHU26-2-BI-3						2/22	NO,M1	A70 (NC)		U71				
BI-4		AHU-26	CCP-S	Cig Coil Pump Status	Off On				2BI-4		BI#,24VAC	EN-AHU26	AT UNIT	0		AHU26-2-BI-4						2/22	Device dependent	Aux Contact (NO)		U70				
BO-1		AHU-26	SF-C	Supply Fan Control	Off On				2BO-1		RLY BO#,24V,COM	EN-AHU26	AT UNIT	0		AHU26-2-BO-1	3/18	A,COILS,COM	RELAY-A	NO,COM		2/14	See starter detail	Starter (NO)-(sw lo)		U60				
BO-2		AHU-26							2BO-2			EN-AHU26	AT UNIT	0		AHU26-2-BO-2														
BO-3		AHU-26	OA-DMP	Outside Air Damper	Closed Open				2BO-3		BO#,24VAC	EN-AHU26	AT UNIT	0		AHU26-2-BO-3						2/18	Device dependent	24VAC OUT (sw lo)		U51				
BO-4		AHU-26	CCP-C	Cig Coil Pump Control	Off On				2BO-4		RLY BO#,24V,COM	EN-AHU26	AT UNIT	0		AHU26-2-BO-4	3/18	B,COILS,COM	RELAY-B	NO,COM		2/14	See starter detail	Starter (NO)-(sw lo)		U60				
BO-5		AHU-26							2BO-5			EN-AHU26	AT UNIT	0		AHU26-2-BO-5														
BO-6		AHU-26							2BO-6			EN-AHU26	AT UNIT	0		AHU26-2-BO-6														
AO-1		AHU-26	H-VLV	Heating Coil Valve	% Open				2AO-1		AO#,AO,CM,24VA	EN-AHU26	AT UNIT	0		AHU26-2-AO-1	2/18	+-	EP-8000-2	SUPPLY, O		3/18	Device dependent	0-10V OUT		U23				
AO-2		AHU-26	C-VLV	Cooling Coil Valve	% Open				2AO-2		AO#,AO,CM,24VA	EN-AHU26	AT UNIT	0		AHU26-2-AO-2	2/18	+-	EP-8000-2	SUPPLY, O		3/18	Device dependent	0-10V OUT		U23				

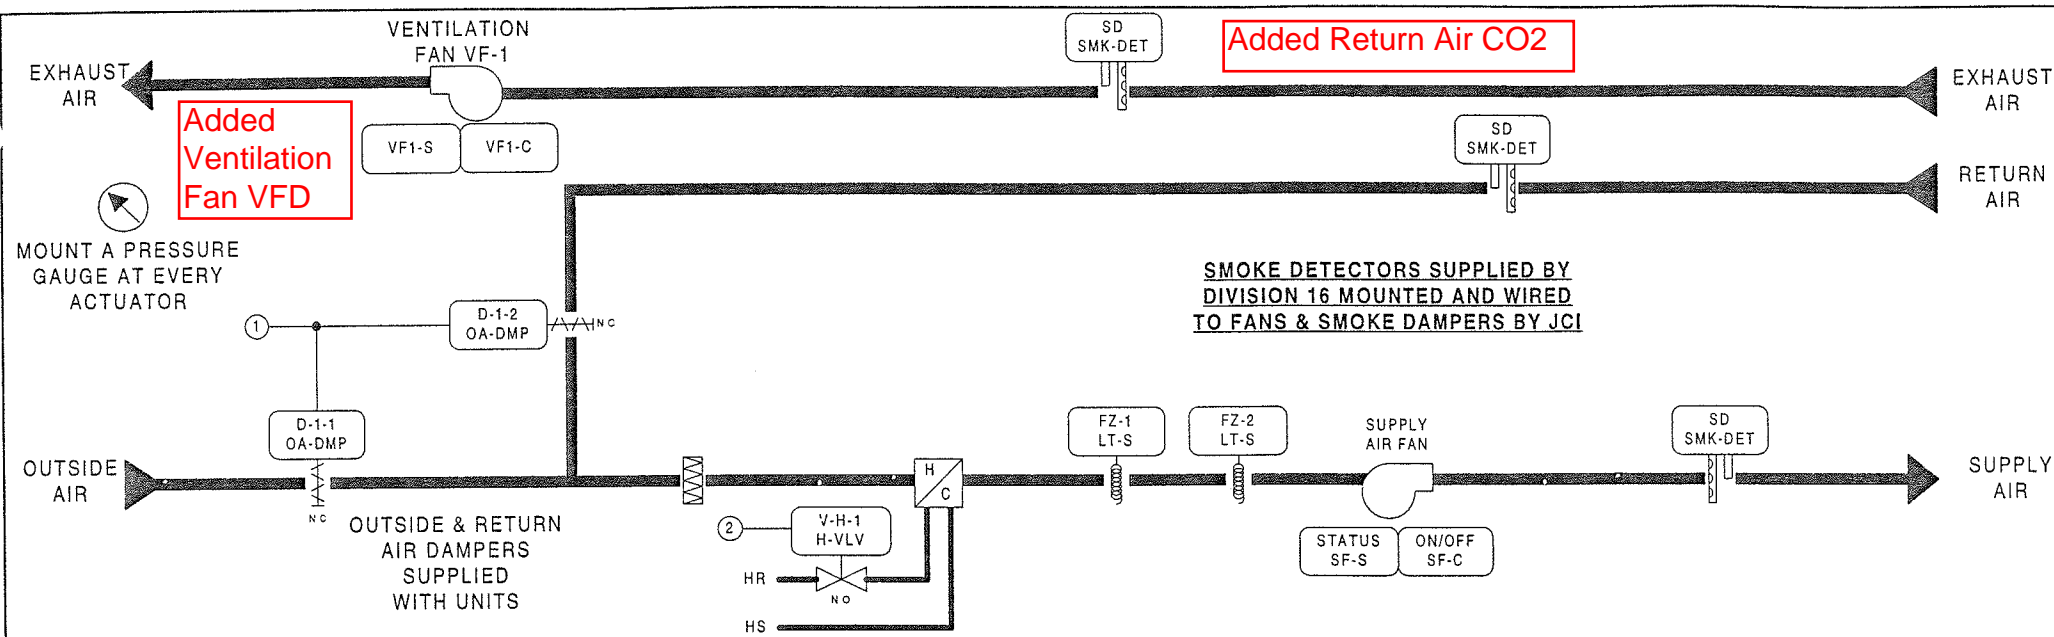

Estimate: hvu-1
Desig. QtyPart # Description 70520098.pre


Field Devices:

FZ-1	1	A70HA-1C	STAT,LL,20',EL,MAN,15/55F
H-VLV	1	--	SEE VALVE SCHEDULE
OA-DMP	2	D-3153-2	DMPR ACT,8-13#
	2	G-2010-11	GAGE,2",0-30 PSIG,STEM
VF-1,TEF-A1	2	BZ-1000-11	ENCL,4-5/8X 5-1/8 X 3-3/8
	2	PD-101-35	RLY BASE,3PDT,11PIN,10A
	2	PD-109-51	RELAY PLUG-IN 3PDT 24VAC
ZN-T	1	TE-6410W-1000	MSTAT,NI,BOX,JACK


Panel Devices:

EN-HVU-1	1	AS-UNT111-101	UNT111 MTD IN UPM, W/50VA
	1	EN-EXP101-0	UNIV PKG MOD,CVR & BACKBN
EP-1	1	EP-8000-2	XDUCR,EP,0/10V,HI VOL
EP-2	1	V11HGA-100	3-W SOLENOID,W/OV,24 VAC
PI-1,2	2	G-2010-11	GAGE,2",0-30 PSIG,STEM
RLY-1	1	AS-RLY002-0	RELAY; 2SPDT 5 AMP 240VAC


SUPPLY FAN WIRING DIAGRAM

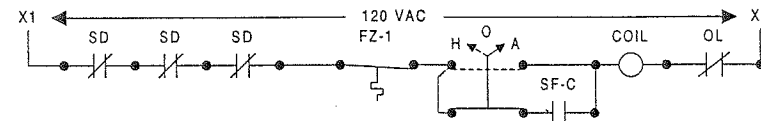

~~VENT FAN VF-1 DIAGRAM~~

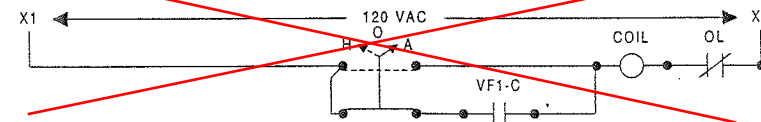

TOILET EXHAUST FAN DIAGRAM

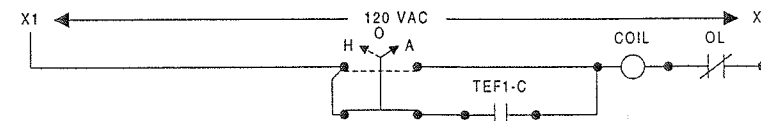

DESCRIPTION OF OPERATION

THE METASYS SYSTEM WILL DETERMINE THE "OCCUPIED AND UNOCCUPIED" MODES OF OPERATION. OCCUPIED MODES GENERALLY OCCUR DURING STADIUM EVENTS, BUT MANUAL OVERRIDE THROUGH THE METASYS SYSTEM ON SELECTED UNITS WILL FREQUENTLY BE REQUIRED. WHEN THE UNIT AND VENTILATION FAN ARE DE-ENERGIZED, OUTSIDE AIR DAMPER D-1-1, WILL CLOSE. UNOCCUPIED RETURN AIR DAMPER D-1-2 WILL BE OPEN AND HEATING COIL VALVE V-H-1 WILL BE CLOSED TO THE COIL.

WARM-UP MODE - SUPPLY FAN WILL START AS DETERMINED BY THE OPTIMAL START PROGRAM OF THE METASYS SYSTEM. ON THE START OF THE UNIT, HEATING COIL VALVE V-H-1 WILL OPEN FULL TO COIL AND RETURN AIR DAMPER D-1-2 WILL BE FULLY OPEN WITH THE OUTSIDE AIR DAMPER D-1-1 CLOSED. VENTILATION FAN VF-1 AND EXHAUST FAN TEF-A1 WILL BE OFF DURING THE WARM-UP MODE. DURATION OF THE WARM-UP MODE IS DETERMINED BY THE METASYS SYSTEM AND WILL BE DYNAMICALLY UPDATED TO END FIFTEEN (15) MINUTES PRIOR TO OCCUPANCY TIME. WARM-UP MODE IS STOPPED WHEN THE ZONE AIR TEMPERATURE REACHES THE SETTING OF TR-1 (70F).

OCCUPIED HEATING MODE - SUPPLY FAN WILL BE RUNNING, RETURN AIR DAMPER D-1-2 WILL CLOSE. OUTSIDE AIR DAMPER D-1-1 WILL OPEN AND VENTILATION FAN VF-1 AND EXHAUST FAN TEF-A1 WILL START AND RUN CONTINUOUSLY AFTER THE WARM-UP MODE IS STOPPED. RETURN AIR DAMPER D-1-2 WILL CLOSE. ROOM SENSOR TR-1 THROUGH THE METASYS SYSTEM CONTROL UNIT, WILL ON A RISE IN TEMPERATURE ABOVE ITS SETTING OF SEVENTY-FIVE (75F) MODULATE V-H-1 CLOSED TO THE HEATING COIL. ON A FALL IN TEMPERATURE, THIS CYCLE IS REVERSED.

UNOCCUPIED HEATING MODE - ROOM SENSOR TR-1, WILL ON A FALL IN TEMPERATURE TO ITS SETTING OF FIFTY (50F), ACTIVATE THE SYSTEM TO RUN IN THE WARM-UP MODE AS HEREINBEFORE DESCRIBED. ON A RISE IN TEMPERATURE TO FIFTY-FIVE (55F), THE SYSTEM WILL BE DE-ENERGIZED. IN THE UNOCCUPIED MODE ALL AIR HANDLING UNIT DAMPERS AND CONTROLS WILL RETURN TO THEIR NORMAL POSITION READY FOR RESTARTING.



OCCUPIED VENTILATING MODE - SUPPLY AND VENTILATION FANS START AND RUN CONTINUOUSLY. OUTSIDE AIR DAMPER D-1-1 WILL OPEN AND RETURN AIR DAMPER D-1-2 WILL CLOSE. HEATING COIL VALVE V-H-1 WILL BE CLOSED TO THE COIL.

UNOCCUPIED VENTILATING MODE - SYSTEM IS DE-ENERGIZED AND FANS ARE OFF.

SMOKE CONTROL - SMOKE DETECTORS WILL, ON THE DETECTION OF PRODUCTS OF COMBUSTION, SHUT DOWN THE SUPPLY AND EXHAUST FANS AND CLOSE ALL SYSTEM DAMPERS.

TOILET EXHAUST FAN TEF-A1 - THE FAN WILL START WHEN THE HVU SUPPLY FAN STARTS AND THE SYSTEM IS IN THE "OCCUPIED" MODE.


FAN	LOCATION	ELEC PANEL	STARTER	LOCATION
HVU-1	SERVICE LEVEL		LOCAL	SERVICE LEVEL
VF-1	SERVICE LEVEL	MCC1SRA	4B	SERVICE LEVEL
TEF-A1	SERVICE LEVEL	MCC1SRA	9E	SERVICE LEVEL

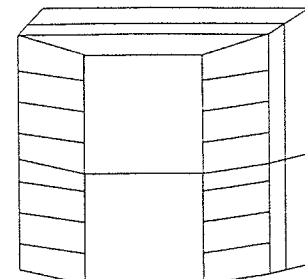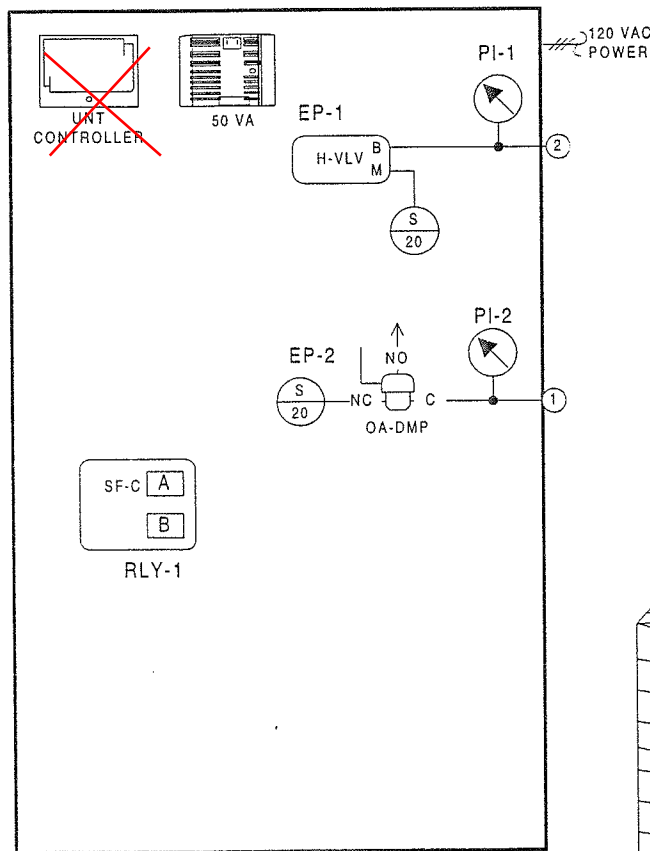

ENCLOSURE EN-HVU-1
AS-UNT111-101
LOCATED ADJACENT
TO UNIT
NCM-5/N2 ADD = 11

REVISION INFORMATION	IN CONSIDERATION OF THE RECEIPT OF THIS DOCUMENT, THE RECIPIENT AGREES NOT TO REPRODUCE, COPY, USE OR TRANSMIT THIS DOCUMENT AND/OR THE INFORMATION THEREIN CONTAINED, IN WHOLE OR IN PART, OR TO SUFFER SUCH ACTION BY OTHERS, FOR ANY PURPOSE, EXCEPT WITH THE WRITTEN PERMISSION OF JOHNSON CONTROLS, INC. UPON DEMAND. COPYRIGHT JOHNSON CONTROLS, INC. 1998	DRAWING TITLE	HEAT-VENT UNIT HVU-1 CONCESSION STO/COMMISSARY	
NUMBER		AS-BUILT		7/18/00 CME
DATE		SERVICE LEVEL QUAD A		
TIME		BALTIMORE NFL STADIUM AT CAMDEN YARDS		
FILE NAME	HVU-1.vsd	PROJECT TITLE	BALTIMORE, MARYLAND	
		SALES ENGINEER: JDP PROJECT MANAGER: WJT APPLICATION ENGINEER: RTS		REFERENCE DRAWING NO. REVISION-LOCATION EON DATE APPROVED BY
		BY: RTS DATE: 04/05/97 CONTRACT NUMBER: 7052-0098		DRAWING NUMBER: BL-6559-29
		JOHNSON CONTROLS Systems & Services Division		JOHNSON CONTROLS 60 LOVETON CIRCLE SPARKS, MD 21152

Full Spreadsheet		Software				Digital Controller Information					Panel Information					Intermediate Device					Field Device						
Tag	Point Type	System Name	Object Name	Expanded ID	Display Units	DC Type	N2 Trunk	N2 Addr	Cable Destination Bay/Terminal	Module Type	Termination	Panel	Panel Location	Slot Number	Reference Drawing	Cable Number	Wiring/Tubing	Termination In	Device	Termination Out	Location	Wiring/Tubing	Terminations	Device	Location	Ref Detail	Comment
		HVU-1				IUNT						EN-HVU-1	Service Level A		IM.2-01A												Power to Controller
		HVU-1				IUNT	1	11				EN-HVU-1	Service Level A		0IM.2-01A												N2 Trunk
AI-1		HVU-1				IUNT			11AI-1			EN-HVU-1	Service Level A		0IM.2-01A	HVU-1-11-AI-1											
AI-2		HVU-1				IUNT			11AI-2			EN-HVU-1	Service Level A		0IM.2-01A	HVU-1-11-AI-2											
AI-3		HVU-1				IUNT			11AI-3			EN-HVU-1	Service Level A		0IM.2-01A	HVU-1-11-AI-3											
AI-4		HVU-1	ZN-T	Zone Temperature	Deg F	IUNT			11AI-4		PHONE JACK	EN-HVU-1	Service Level A		0IM.2-01A	HVU-1-11-AI-4					8/26	PHONE JACK	TE-6410W-1000			U2	
AI-5		HVU-1				IUNT			11AI-5			EN-HVU-1	Service Level A		0IM.2-01A	HVU-1-11-AI-5											
AI-6		HVU-1				IUNT			11AI-6			EN-HVU-1	Service Level A		0IM.2-01A	HVU-1-11-AI-6											
BI-1		HVU-1	SF-S	Supply Fan Status	Off On	IUNT			11BI-1		BI# 24VAC	EN-HVU-1	Service Level A		0IM.2-01A	HVU-1-11-BI-1					2/22	Device dependent	Aux Contact (NO)			U70	
BI-2		HVU-1	VF1-S	Vent Fan 1 Status	Off On	IUNT			11BI-2		BI# 24VAC	EN-HVU-1	Service Level A		0IM.2-01A	HVU-1-11-BI-2					2/22	Device dependent	Aux Contact (NO)			U70	
BI-3		HVU-1	SMK-DET	Smoke Detectors	Normal Alarm	IUNT			11BI-3		BI# 24VAC	EN-HVU-1	Service Level A		0IM.2-01A	HVU-1-11-BI-3					2/22	Device dependent	Contact (NO)			U70	
BI-4		HVU-1	LT-S	Low Temperature Stat	Normal Alarm	IUNT			11BI-4		BI# 24VAC	EN-HVU-1	Service Level A		0IM.2-01A	HVU-1-11-BI-4					2/22	NO, M1	A70 (NC)			U71	
BO-1		HVU-1	SF-C	Supply Fan Control	Off On	IUNT			11BO-1	RLY	BO# 24V.COM	EN-HVU-1	Service Level A		0IM.2-01A	HVU-1-11-BO-1	3/18	A.COILS.COM	RELAY-A	NO.COM		2/14	See starter detail	Starter (NO)-(sw lo)		U60	
BO-2		HVU-1	OA-DMP	Outside Air Damper	Closed Open	IUNT			11BO-2		BO# 24VAC	EN-HVU-1	Service Level A		0IM.2-01A	HVU-1-11-BO-2			V11HGA-100		2/18	Device dependent	24VAC OUT (sw lo)		U51		
BO-3		HVU-1	VF1-C	Vent Fan 1 Control	Off On	IUNT			11BO-3		BO# 24VAC	EN-HVU-1	Service Level A		0IM.2-01A	HVU-1-11-BO-3			PD-109-51		2/18	Device dependent	24VAC OUT (sw lo)		U51		
BO-4		HVU-1	TEF1-C	Toilet Exh Fan A1 Control	Off On	IUNT			11BO-4		BO# 24VAC	EN-HVU-1	Service Level A		0IM.2-01A	HVU-1-11-BO-4			PD-109-51		2/18	Device dependent	24VAC OUT (sw lo)		U51		
BO-5		HVU-1				IUNT			11BO-5			EN-HVU-1	Service Level A		0IM.2-01A	HVU-1-11-BO-5											
BO-6		HVU-1				IUNT			11BO-6			EN-HVU-1	Service Level A		0IM.2-01A	HVU-1-11-BO-6											
AO-1		HVU-1	H-VLV	Heating Coil Valve	% Open	IUNT			11AO-1		AO# AOCM.24V	EN-HVU-1	Service Level A		0IM.2-01A	HVU-1-11-AO-1	2/18	+-	EP-8000-2	SUPPLY, O		3/18	Device dependent	0-10V OUT		U23	
AO-2		HVU-1				IUNT			11AO-2			EN-HVU-1	Service Level A		0IM.2-01A	HVU-1-11-AO-2											

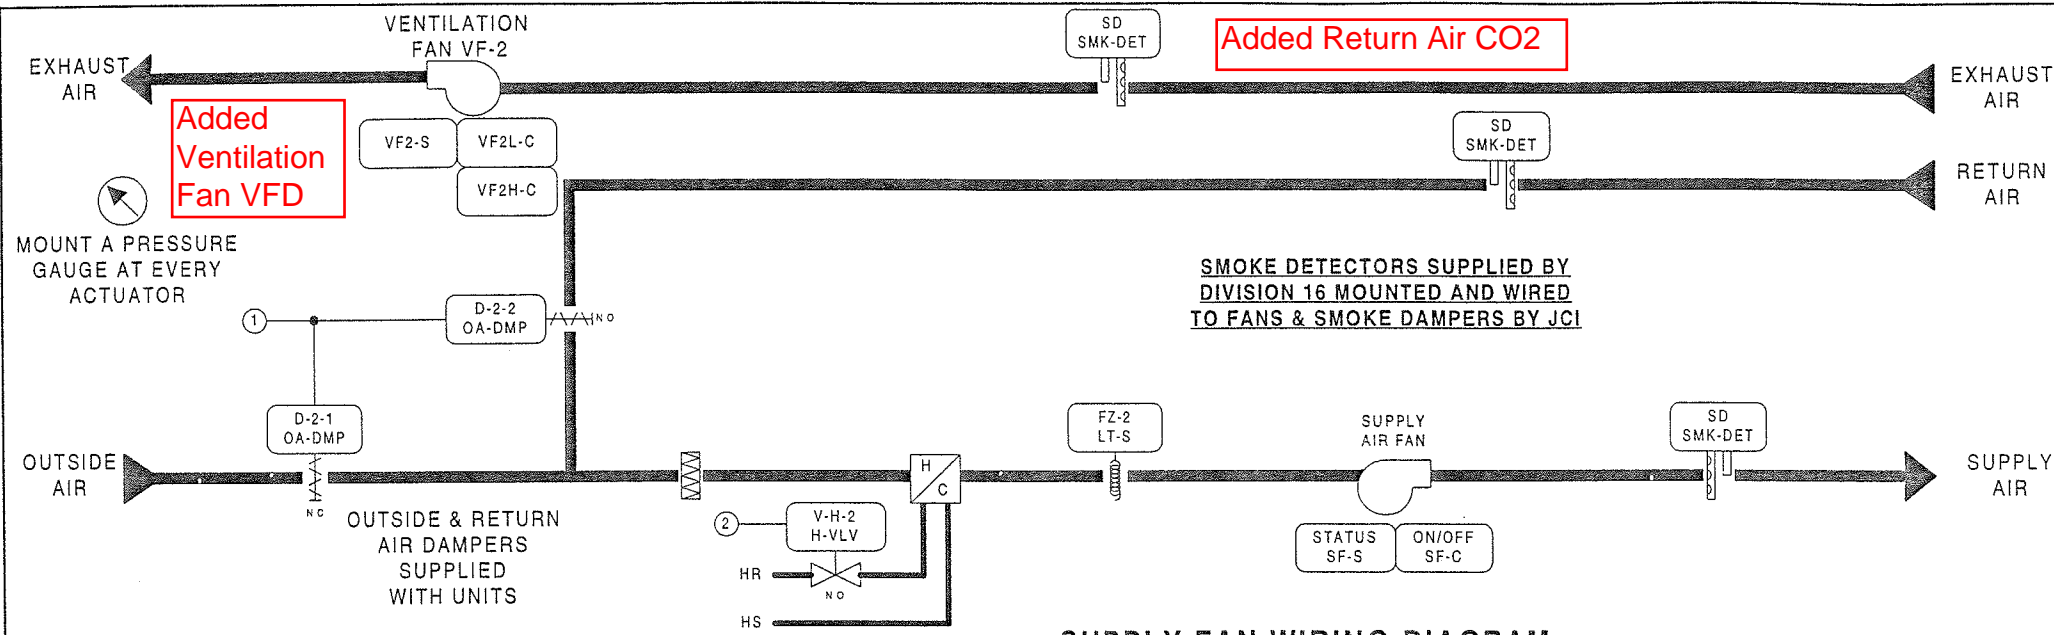

Estimate: hvu-2
Desig. QtyPart # Description 70520098.pre


Field Devices:

FZ-2	1	A70HA-1C	STAT, LL, 20', EL. MAN, 15/55F
H-VLV	1	--	SEE VALVE SCHEDULE
OA-DMP	2	D-3153-2	DMPR ACT, 8-13*
	2	G-2010-11	GAGE, 2", 0-30 PSIG, STEM
VF-2, TEF-A1	3	BZ-1000-11	ENCL, 4-5/8X 5-1 8 X 3-3/8
	3	PD-101-35	RLY BASE, 3PDT, 11PIN, 10A
	3	PD-109-51	RELAY PLUG-IN 3PDT 24VAC
ZN-T	1	TE-6410W-1000	MSTAT, NI, BOX, JACK


Panel Devices:

EN-HVU-2	1	AS-UNT111-101	UNT111 MTD IN UPM, W/50VA
	1	EN-EXP101-0	UNIV PKG MOD. CTR. & BACKBN
EP-1	1	EP-8000-2	XDUCR, EP, 0/10V, HI VOL
EP-2	1	V11HGA-100	3-W SOLENOID, W/2V, 24 VAC
PI-1, 2	2	G-2010-11	GAGE, 2", 0-30 PSIG, STEM
RLY-1	1	AS-RLY002-0	RELAY; 2SPDT 5 AMP 240VAC


SUPPLY FAN WIRING DIAGRAM

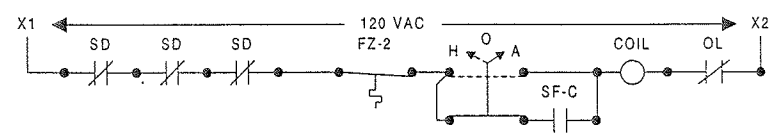

VENT FAN VF-2 DIAGRAM TWO-SPEED WIRING DIAGRAM

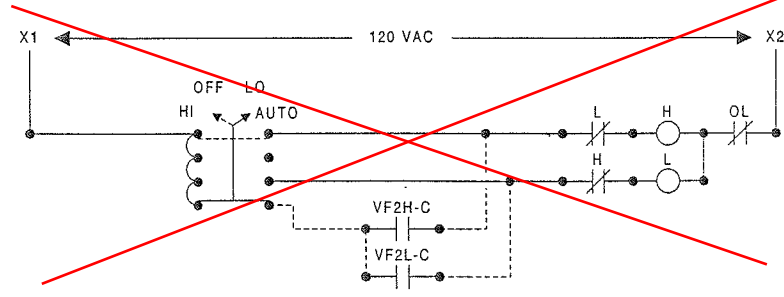

TOILET EXHAUST FAN DIAGRAM

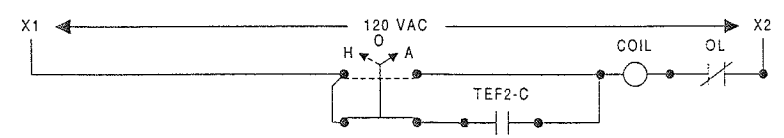

FAN	LOCATION	ELEC PANEL	STARTER	LOCATION
HVU-2	SERVICE LEVEL		LOCAL	SERVICE LEVEL
VF-2	SERVICE LEVEL	MCC1SRA	4C	SERVICE LEVEL

DESCRIPTION OF OPERATION

THE METASYS SYSTEM WILL DETERMINE THE "OCCUPIED AND UNOCCUPIED" MODES OF OPERATION. OCCUPIED MODES GENERALLY OCCUR DURING STADIUM EVENTS, BUT MANUAL OVERRIDE THROUGH THE METASYS SYSTEM ON SELECTED UNITS WILL FREQUENTLY BE REQUIRED. WHEN THE UNIT AND VENTILATION FAN ARE DE-ENERGIZED, OUTSIDE AIR DAMPER D-2-1, WILL CLOSE. UNOCCUPIED RETURN AIR DAMPER D-2-2 WILL BE OPEN AND HEATING COIL VALVE V-H-2 WILL BE CLOSED TO THE COIL.

WARM-UP MODE - SUPPLY FAN WILL START AS DETERMINED BY THE OPTIMAL START PROGRAM OF THE METASYS SYSTEM. ON THE START OF THE UNIT, HEATING COIL VALVE V-H-2 WILL OPEN FULL TO COIL AND RETURN AIR DAMPER D-2-2 WILL BE FULLY OPEN WITH THE OUTSIDE AIR DAMPER D-2-1 CLOSED. VENTILATION FAN VF-2 AND EXHAUST FAN TEF-A2 WILL BE OFF DURING THE WARM-UP MODE. DURATION OF THE WARM-UP MODE IS DETERMINED BY THE METASYS SYSTEM AND WILL BE DYNAMICALLY UPDATED TO END FIFTEEN (15) MINUTES PRIOR TO OCCUPANCY TIME. WARM-UP MODE IS STOPPED WHEN THE ZONE AIR TEMPERATURE REACHES THE SETTING OF TR-2 (70F).

OCCUPIED HEATING MODE - SUPPLY FAN WILL BE RUNNING, RETURN AIR DAMPER D-2-2 WILL CLOSE. OUTSIDE AIR DAMPER D-2-1 WILL OPEN AND VENTILATION FAN VF-2 (LOW SPEED) AND EXHAUST FAN TEF-A2 WILL START AND RUN CONTINUOUSLY AFTER THE WARM-UP MODE IS STOPPED. RETURN AIR DAMPER D-2-2 WILL CLOSE. ROOM SENSOR TR-2 THROUGH THE METASYS SYSTEM CONTROL UNIT, WILL ON A RISE IN TEMPERATURE ABOVE ITS SETTING OF SEVENTY-FIVE (75F) MODULATE V-H-2 CLOSED TO THE HEATING COIL. ON A FALL IN TEMPERATURE, THIS CYCLE IS REVERSED.



UNOCCUPIED HEATING MODE - ROOM SENSOR TR-2, WILL ON A FALL IN TEMPERATURE TO ITS SETTING OF FIFTY (50F). ACTIVATE THE SYSTEM TO RUN IN THE WARM-UP MODE AS HEREINBEFORE DESCRIBED. ON A RISE IN TEMPERATURE TO FIFTY-FIVE (55F), THE SYSTEM WILL BE DE-ENERGIZED. IN THE UNOCCUPIED MODE ALL AIR HANDLING UNIT DAMPERS AND CONTROLS WILL RETURN TO THEIR NORMAL POSITION READY FOR RESTARTING.

OCCUPIED VENTILATING MODE - SUPPLY AND VENTILATION FAN (HIGH SPEED) START AND RUN CONTINUOUSLY. OUTSIDE AIR DAMPER D-2-1 WILL OPEN AND RETURN AIR DAMPER D-2-2 WILL CLOSE. HEATING COIL VALVE V-H-2 WILL BE CLOSED TO THE COIL.

UNOCCUPIED VENTILATING MODE - SYSTEM IS DE-ENERGIZED AND FANS ARE OFF.

SMOKE CONTROL - SMOKE DETECTORS WILL, ON THE DETECTION OF PRODUCTS OF COMBUSTION, SHUT DOWN THE SUPPLY AND EXHAUST FANS AND CLOSE ALL SYSTEM DAMPERS.


TOILET EXHAUST FAN TEF-A2 - THE FAN WILL START WHEN THE HVU SUPPLY FAN STARTS AND THE SYSTEM IS IN THE "OCCUPIED" MODE.

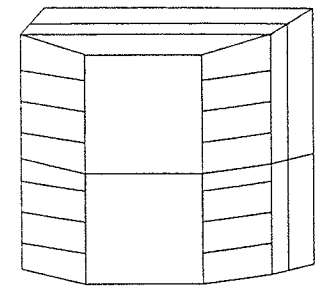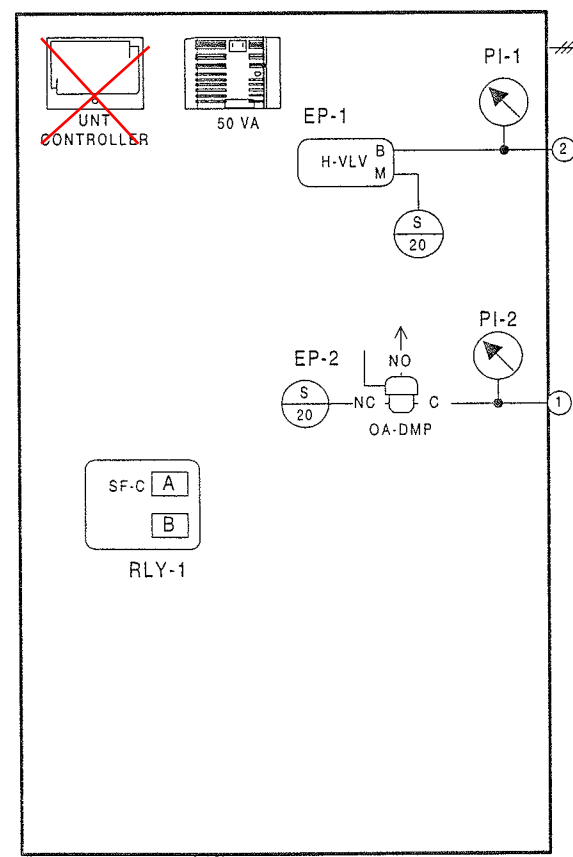

ENCLOSURE EN-HVU-2
AS-UNT111-101
LOCATED ADJACENT
TO UNIT
NCM-5.N2 ADD = 12

REVISION INFORMATION NUMBER DATE 07/18/00 TIME 03:28 PM FILE NAME HVU-2.vsd	IN CONSIDERATION OF THE RECEIPT OF THIS DOCUMENT, THE RECIPIENT AGREES NOT TO REPRODUCE, COPY, USE OR TRANSMIT THIS DOCUMENT AND/OR THE INFORMATION THEREIN CONTAINED, IN WHOLE OR IN PART, OR TO SUFFER SUCH ACTION BY OTHERS, FOR ANY PURPOSE, EXCEPT WITH THE WRITTEN PERMISSION OF JOHNSON CONTROLS, INC. AND FURTHER AGREES TO SURRENDER SAME TO JOHNSON CONTROLS, INC. UPON DEMAND. COPYRIGHT JOHNSON CONTROLS, INC. 1998	DRAWING TITLE HEAT-VENT UNIT HVU-2 CONCESSION LOCKERS SERVICE LEVEL QUAD A PROJECT TITLE BALTIMORE NFL STADIUM AT CAMDEN YARDS BALTIMORE, MARYLAND	<table border="1"> <tr> <td>AS-BUILT</td> <td>7/18/00</td> <td>CME</td> </tr> <tr> <td>REFERENCE DRAWING</td> <td>NO</td> <td>REVISION-LOCATION</td> </tr> <tr> <td>Sales Engineer JDP</td> <td>Project Manager WJT</td> <td>Application Engineer RTS</td> </tr> <tr> <td colspan="2">DRAWN BY RTS</td> <td>DATE 09/04/97</td> </tr> <tr> <td colspan="2">APPROVED BY</td> <td>DATE</td> </tr> <tr> <td colspan="2">CONTRACT NUMBER</td> <td>7052-0098</td> </tr> <tr> <td colspan="2">DRAWING NUMBER</td> <td>BL-6559-30</td> </tr> </table>	AS-BUILT	7/18/00	CME	REFERENCE DRAWING	NO	REVISION-LOCATION	Sales Engineer JDP	Project Manager WJT	Application Engineer RTS	DRAWN BY RTS		DATE 09/04/97	APPROVED BY		DATE	CONTRACT NUMBER		7052-0098	DRAWING NUMBER		BL-6559-30
AS-BUILT	7/18/00	CME																						
REFERENCE DRAWING	NO	REVISION-LOCATION																						
Sales Engineer JDP	Project Manager WJT	Application Engineer RTS																						
DRAWN BY RTS		DATE 09/04/97																						
APPROVED BY		DATE																						
CONTRACT NUMBER		7052-0098																						
DRAWING NUMBER		BL-6559-30																						

Full Spreadsheet		Software				Digital Controller Information					Panel Information					Intermediate Device					Field Device						
Tag	Point Type	System Name	Object Name	Expanded ID	Display Units	DC Type	N2 Trunk	N2 Addr	Cable Destination Bay/Terminal	Module Type	Termination	Panel	Panel Location	Slot Number	Reference Drawing	Cable Number	Wiring/Tubing	Termination In	Device	Termination Out	Location	Wiring/Tubing	Terminations	Device	Location	Ref Detail	Comment
		HVU-2				UNT						EN-HVU-2	Service Level A		M.2-01A												Power to Controller
		HVU-2				UNT	1	12				EN-HVU-2	Service Level A		0M.2-01A												N2 Trunk
AI-1		HVU-2				UNT	1	12	AI-1			EN-HVU-2	Service Level A		0M.2-01A	HVU-2-12-AI-1											
AI-2		HVU-2				UNT	1	12	AI-2			EN-HVU-2	Service Level A		0M.2-01A	HVU-2-12-AI-2											
AI-3		HVU-2				UNT	1	12	AI-3			EN-HVU-2	Service Level A		0M.2-01A	HVU-2-12-AI-3											
AI-4		HVU-2	ZN-T	Zone Temperature	Deg F	UNT	1	12	AI-4		PHONE JACK	EN-HVU-2	Service Level A		0M.2-01A	HVU-2-12-AI-4					8/26	PHONE JACK	TE-6410W-1000		U2		
AI-5		HVU-2				UNT	1	12	AI-5			EN-HVU-2	Service Level A		0M.2-01A	HVU-2-12-AI-5											
AI-6		HVU-2				UNT	1	12	AI-6			EN-HVU-2	Service Level A		0M.2-01A	HVU-2-12-AI-6											
BI-1		HVU-2	SF-S	Supply Fan Status	Off On	UNT	1	12	BI-1		BI# 24VAC	EN-HVU-2	Service Level A		0M.2-01A	HVU-2-12-BI-1					2/22		Device dependent: Aux Contact (NO)		U70		
BI-2		HVU-2	VF2-S	Vent Fan 2 Status	Off On	UNT	1	12	BI-2		BI# 24VAC	EN-HVU-2	Service Level A		0M.2-01A	HVU-2-12-BI-2					2/22		Device dependent: Aux Contact (NO)		U70		
BI-3		HVU-2	SMK-DET	Smoke Detectors	Normal Alarm	UNT	1	12	BI-3		BI# 24VAC	EN-HVU-2	Service Level A		0M.2-01A	HVU-2-12-BI-3					2/22		Device dependent: Contact (NO)		U70		
BI-4		HVU-2	LT-S	Low Temperature Stat	Normal Alarm	UNT	1	12	BI-4		BI# 24VAC	EN-HVU-2	Service Level A		0M.2-01A	HVU-2-12-BI-4					2/22		NO_M1	A70 (NC)	U71		
BO-1		HVU-2	SF-C	Supply Fan Control	Off On	UNT	1	12	BO-1	RLY	BO# 24V.COM	EN-HVU-2	Service Level A		0M.2-01A	HVU-2-12-BO-1	3/18	A.COILS.COM	RELAY-A	NO.COM		2/14		See starter detail Starter (NO)-(sw lo)	U60		
BO-2		HVU-2	OA-DMP	Outside Air Damper	Closed Open	UNT	1	12	BO-2		BO# 24VAC	EN-HVU-2	Service Level A		0M.2-01A	HVU-2-12-BO-2					2/18		Device dependent: 24VAC OUT (sw lo)	U51			
BO-3		HVU-2	VF2L-C	Vent Fan 2 Control Low	Off On	UNT	1	12	BO-3		BO# 24VAC	EN-HVU-2	Service Level A		0M.2-01A	HVU-2-12-BO-3					2/18		Device dependent: 24VAC OUT (sw lo)	U51			
BO-4		HVU-2	VF2H-C	Vent Fan 2 Control High	Off On	UNT	1	12	BO-4		BO# 24VAC	EN-HVU-2	Service Level A		0M.2-01A	HVU-2-12-BO-4					2/18		Device dependent: 24VAC OUT (sw lo)	U51			
BO-5		HVU-2				UNT	1	12	BO-5			EN-HVU-2	Service Level A		0M.2-01A	HVU-2-12-BO-5											
BO-6		HVU-2				UNT	1	12	BO-6			EN-HVU-2	Service Level A		0M.2-01A	HVU-2-12-BO-6											
AO-1		HVU-2	H-VLV	Heating Coil Valve	% Open	UNT	1	12	AO-1		AO# AOCM,24V	EN-HVU-2	Service Level A		0M.2-01A	HVU-2-12-AO-1	2/18	+-	EP-8000-2	SUPPLY, O		3/18		Device dependent: 0-10V OUT	U23		
AO-2		HVU-2				UNT	1	12	AO-2			EN-HVU-2	Service Level A		0M.2-01A	HVU-2-12-AO-2											

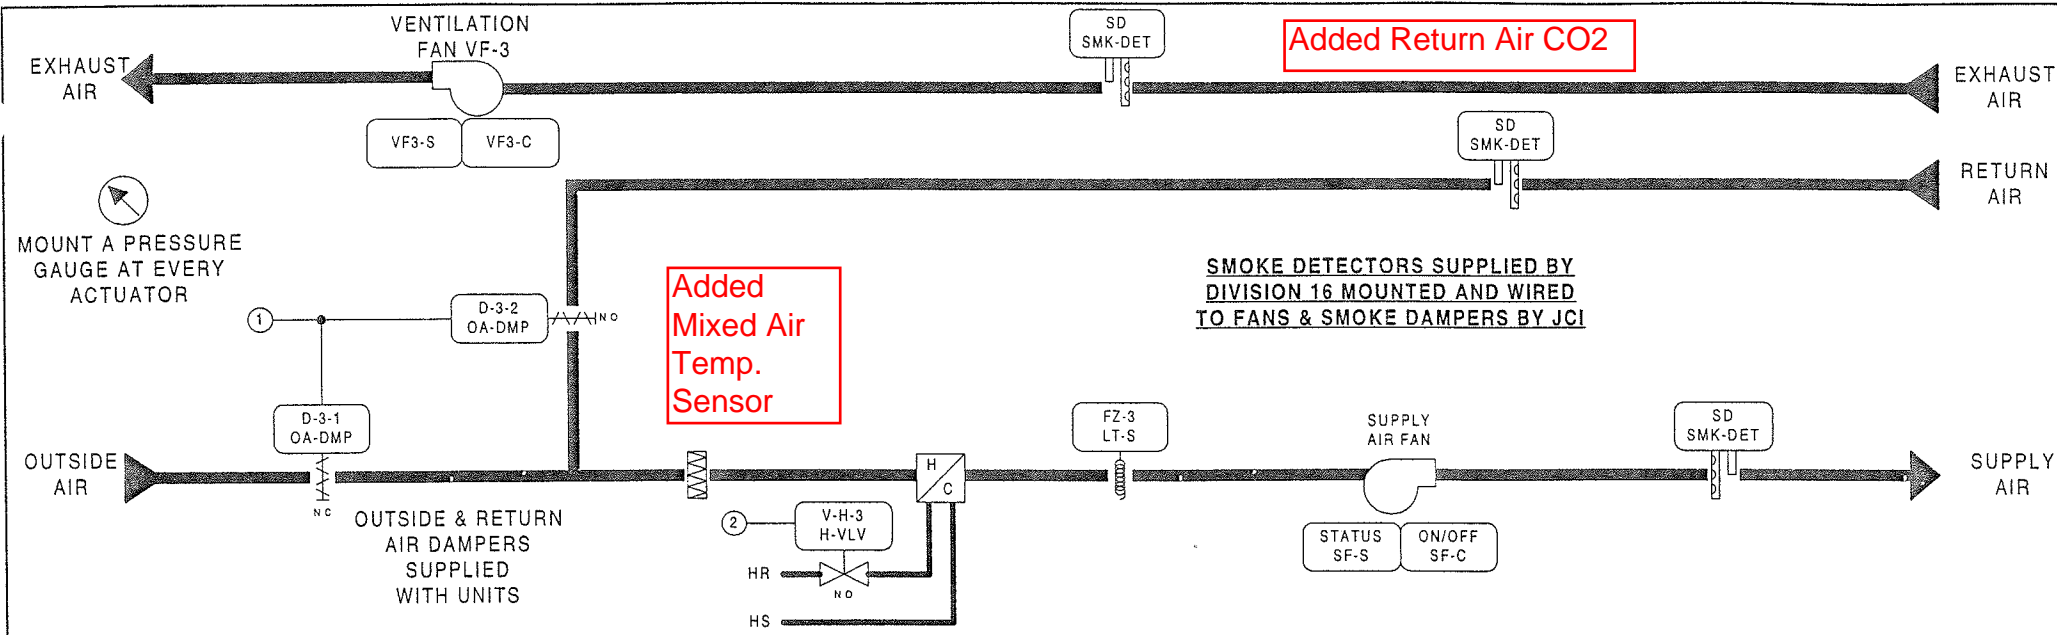

BILL OF MATERIALS

Estimate: hvu-3
Desig. QtyPart # Description 70520098.pre


Field Devices:

FZ-3	1	A70HA-1C	STAT, LL, 20', EL, MAN, 15/55F
H-VLV	1	--	SEE VALVE SCHEDULE
OA-DMP	2	D-3153-2	DMPR ACT, 8-13#
	2	G-2010-11	GAGE, 2", 0-30 PSIG, STEM
VF-3, TEF-A3	2	EZ-1000-11	ENCL, 4-5/8X 5-1 8 X 3-3/8
	2	PD-101-35	RLY BASE, 3PDT, 11PIN, 10A
	2	PD-109-51	RELAY PLUG-IN 3PDT 24VAC
ZN-T	1	TE-6410W-1000	MSTAT, NI, BOX, JACK


Panel Devices:

EN-HVU-3	1	AS-UNT111-101	UNT111 MTD IN 1PM, W/50VA
	1	EN-EXP101-0	UNIV PKG MOD, CTR & BACKBN
EP-1	1	EP-8000-2	XDUCR, EP, 0/10V, HI VOL
EP-2	1	V11HGA-100	3-W SOLENOID, W. DV, 24 VAC
PI-1, 2	2	G-2010-11	GAGE, 2", 0-30 PSIG, STEM
RLY-1	1	AS-RLY002-0	RELAY; 2SPDT 5 AMP 240VAC


SUPPLY FAN WIRING DIAGRAM

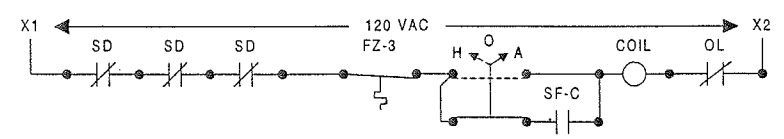

VENT FAN VF-3 DIAGRAM

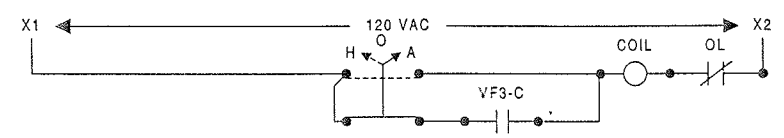

TOILET EXHAUST FAN DIAGRAM

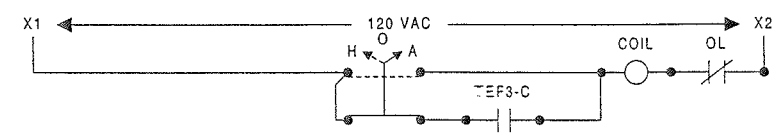

DESCRIPTION OF OPERATION

THE METASYS SYSTEM WILL DETERMINE THE "OCCUPIED AND UNOCCUPIED" MODES OF OPERATION. OCCUPIED MODES GENERALLY OCCUR DURING STADIUM EVENTS, BUT MANUAL OVERRIDE THROUGH THE METASYS SYSTEM ON SELECTED UNITS WILL FREQUENTLY BE REQUIRED. WHEN THE UNIT AND VENTILATION FAN ARE DE-ENERGIZED, OUTSIDE AIR DAMPER D-3-1, WILL CLOSE. UNOCCUPIED RETURN AIR DAMPER D-3-2 WILL BE OPEN AND HEATING COIL VALVE V-H-3 WILL BE CLOSED TO THE COIL.

WARM-UP MODE - SUPPLY FAN WILL START AS DETERMINED BY THE OPTIMAL START PROGRAM OF THE METASYS SYSTEM. ON THE START OF THE UNIT, HEATING COIL VALVE V-H-3 WILL OPEN FULL TO COIL AND RETURN AIR DAMPER D-3-2 WILL BE FULLY OPEN WITH THE OUTSIDE AIR DAMPER D-3-1 CLOSED. VENTILATION FAN VF-3 AND EXHAUST FAN TEF-A3 WILL BE OFF DURING THE WARM-UP MODE. DURATION OF THE WARM-UP MODE IS DETERMINED BY THE METASYS SYSTEM AND WILL BE DYNAMICALLY UPDATED TO END FIFTEEN (15) MINUTES PRIOR TO OCCUPANCY TIME. WARM-UP MODE IS STOPPED WHEN THE ZONE AIR TEMPERATURE REACHES THE SETTING OF TR-3 (70F).

OCCUPIED HEATING MODE - SUPPLY FAN WILL BE RUNNING, RETURN AIR DAMPER D-3-2 WILL CLOSE. OUTSIDE AIR DAMPER D-3-1 WILL OPEN AND VENTILATION FAN VF-3 AND EXHAUST FAN TEF-A3 WILL START AND RUN CONTINUOUSLY AFTER THE WARM-UP MODE IS STOPPED. RETURN AIR DAMPER D-3-2 WILL CLOSE. ROOM SENSOR TR-3 THROUGH THE METASYS SYSTEM CONTROL UNIT, WILL ON A RISE IN TEMPERATURE ABOVE ITS SETTING OF SEVENTY-FIVE (75F) MODULATE V-H-3 CLOSED TO THE HEATING COIL. ON A FALL IN TEMPERATURE, THIS CYCLE IS REVERSED.



UNOCCUPIED HEATING MODE - ROOM SENSOR TR-3, WILL ON A FALL IN TEMPERATURE TO ITS SETTING OF FIFTY (50F). ACTIVE THE SYSTEM TO RUN IN THE WARM-UP MODE AS HEREINBEFORE DESCRIBED. ON A RISE IN TEMPERATURE TO FIFTY-FIVE (55F), THE SYSTEM WILL BE DE-ENERGIZED. IN THE UNOCCUPIED MODE ALL AIR HANDLING UNIT DAMPERS AND CONTROLS WILL RETURN TO THEIR NORMAL POSITION READY FOR RESTARTING.

OCCUPIED VENTILATING MODE - SUPPLY AND VENTILATION FANS START AND RUN CONTINUOUSLY. OUTSIDE AIR DAMPER D-3-1 WILL OPEN AND RETURN AIR DAMPER D-3-2 WILL CLOSE. HEATING COIL VALVE V-H-3 WILL BE CLOSED TO THE COIL.

UNOCCUPIED VENTILATING MODE - SYSTEM IS DE-ENERGIZED AND FANS ARE OFF.

SMOKE CONTROL - SMOKE DETECTORS WILL, ON THE DETECTION OF PRODUCTS OF COMBUSTION, SHUT DOWN THE SUPPLY AND EXHAUST FANS AND CLOSE ALL SYSTEM DAMPERS.

TOILET EXHAUST FAN TEF-A3 - THE FAN WILL START WHEN THE HVU SUPPLY FAN STARTS AND THE SYSTEM IS IN THE "OCCUPIED" MODE.

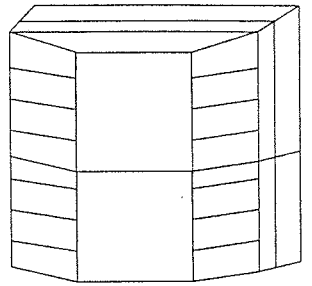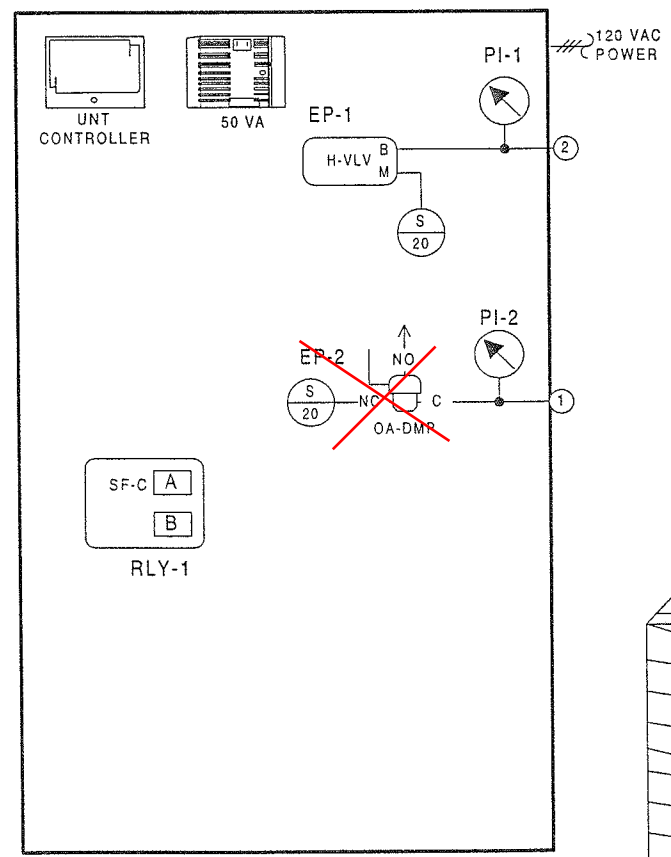


ENCLOSURE EN-HVU-3
AS-UNT111-101
LOCATED ADJACENT
TO UNIT
NCM-5/N2 ADD = 13

FAN	LOCATION	ELEC PANEL	STARTER	LOCATION
HVU-3	SERVICE LEVEL		LOCAL	SERVICE LEVEL
VF-3	SERVICE LEVEL	MCC1SRA	4D	SERVICE LEVEL

REVISION INFORMATION NUMBER DATE 07/18/00 TIME 03:29 PM FILE NAME HVU-3.vsd	IN CONSIDERATION OF THE RECEIPT OF THIS DOCUMENT, THE RECIPIENT AGREES NOT TO REPRODUCE, COPY, USE OR TRANSMIT THIS DOCUMENT AND/OR THE INFORMATION THEREIN CONTAINED, IN WHOLE OR IN PART, OR TO SUFFER SUCH ACTION BY OTHERS, FOR ANY PURPOSE, EXCEPT WITH THE WRITTEN PERMISSION OF JOHNSON CONTROLS, INC. AND FURTHER AGREES TO SURRENDER SAME TO JOHNSON CONTROLS, INC. UPON DEMAND. COPYRIGHT JOHNSON CONTROLS, INC. 1998	DRAWING TITLE HEAT-VENT UNIT HVU-3 GAME DAY LOCKERS SERVICE LEVEL QUAD A PROJECT TITLE BALTIMORE NFL STADIUM AT CAMDEN YARDS BALTIMORE, MARYLAND	<table border="1"> <tr> <td>AS-BUILT</td> <td>7/18/00</td> <td>CME</td> </tr> <tr> <td>REFERENCE DRAWING</td> <td>NO</td> <td>REVISION-LOCATION</td> </tr> <tr> <td>Sales Engineer JDP</td> <td>Project Manager WJT</td> <td>Application Engineer RTS</td> </tr> <tr> <td>BY RTS</td> <td>DATE 09/05/07</td> <td>BY</td> </tr> <tr> <td colspan="2">CONTRACT NUMBER</td> <td>7052-0098</td> </tr> <tr> <td colspan="2">DRAWING NUMBER</td> <td>BL-6559-31</td> </tr> </table>	AS-BUILT	7/18/00	CME	REFERENCE DRAWING	NO	REVISION-LOCATION	Sales Engineer JDP	Project Manager WJT	Application Engineer RTS	BY RTS	DATE 09/05/07	BY	CONTRACT NUMBER		7052-0098	DRAWING NUMBER		BL-6559-31
AS-BUILT	7/18/00	CME																			
REFERENCE DRAWING	NO	REVISION-LOCATION																			
Sales Engineer JDP	Project Manager WJT	Application Engineer RTS																			
BY RTS	DATE 09/05/07	BY																			
CONTRACT NUMBER		7052-0098																			
DRAWING NUMBER		BL-6559-31																			

Full Spreadsheet		Software				Digital Controller Information						Panel Information				Intermediate Device					Field Device						
Tag	Point Type	System Name	Object Name	Expanded ID	Display Units	DC Type	N2 Trunk	N2 Addr	Cable Destination Bay/Terminal	Module Type	Termination	Panel	Panel Location	Slot Number	Reference Drawing	Cable Number	Wiring/Tubing	Termination In	Device	Termination Out	Location	Wiring/Tubing	Terminations	Device	Location	Ref Detail	Comment
		HVU-3				UNT						EN-HVU-3	Service Level A		IM.2-01A												Power to Controller
		HVU-3				UNT	1	13				EN-HVU-3	Service Level A		0IM.2-01A												N2 Trunk
AI-1		HVU-3				UNT			13AI-1			EN-HVU-3	Service Level A		0IM.2-01A	HVU-3-13-AI-1											
AI-2		HVU-3				UNT			13AI-2			EN-HVU-3	Service Level A		0IM.2-01A	HVU-3-13-AI-2											
AI-3		HVU-3				UNT			13AI-3			EN-HVU-3	Service Level A		0IM.2-01A	HVU-3-13-AI-3											
AI-4		HVU-3	ZN-T	Zone Temperature	Deg F	UNT			13AI-4		PHONE JACK	EN-HVU-3	Service Level A		0IM.2-01A	HVU-3-13-AI-4					8/26	PHONE JACK	TE-6410W-1000			U2	
AI-5		HVU-3				UNT			13AI-5			EN-HVU-3	Service Level A		0IM.2-01A	HVU-3-13-AI-5											
AI-6		HVU-3				UNT			13AI-6			EN-HVU-3	Service Level A		0IM.2-01A	HVU-3-13-AI-6											
BI-1		HVU-3	SF-S	Supply Fan Status	Off On	UNT			13BI-1		BI#,24VAC	EN-HVU-3	Service Level A		0IM.2-01A	HVU-3-13-BI-1					2/22	Device dependent	Aux Contact (NO)			U70	
BI-2		HVU-3	VF3-S	Vent Fan 3 Status	Off On	UNT			13BI-2		BI#,24VAC	EN-HVU-3	Service Level A		0IM.2-01A	HVU-3-13-BI-2					2/22	Device dependent	Aux Contact (NO)			U70	
BI-3		HVU-3	SMK-DET	Smoke Detectors	Normal Alarm	UNT			13BI-3		BI#,24VAC	EN-HVU-3	Service Level A		0IM.2-01A	HVU-3-13-BI-3					2/22	Device dependent	Contact (NO)			U70	
BI-4		HVU-3	LT-S	Low Temperature Stat	Normal Alarm	UNT			13BI-4		BI#,24VAC	EN-HVU-3	Service Level A		0IM.2-01A	HVU-3-13-BI-4					2/22	NO.M1	IA70 (NC)			U71	
BO-1		HVU-3	SF-C	Supply Fan Control	Off On	UNT			13BO-1	RLY	BO#,24V.COM	EN-HVU-3	Service Level A		0IM.2-01A	HVU-3-13-BO-1	3/18	A.COILS.COM	RELAY-A	NO.COM		2/14	See starter detail	Starter (NO)-(sw lo)		U60	
BO-2		HVU-3	OA-DMP	Outside Air Damper	Closed Open	UNT			13BO-2		BO#,24VAC	EN-HVU-3	Service Level A		0IM.2-01A	HVU-3-13-BO-2					2/18	Device dependent	24VAC OUT (sw lo)		U51		
BO-3		HVU-3	VF3-C	Vent Fan 3 Control	Off On	UNT			13BO-3		BO#,24VAC	EN-HVU-3	Service Level A		0IM.2-01A	HVU-3-13-BO-3					2/18	Device dependent	24VAC OUT (sw lo)		U51		
BO-4		HVU-3				UNT			13BO-4			EN-HVU-3	Service Level A		0IM.2-01A	HVU-3-13-BO-4											
BO-5		HVU-3				UNT			13BO-5			EN-HVU-3	Service Level A		0IM.2-01A	HVU-3-13-BO-5											
BO-6		HVU-3				UNT			13BO-6			EN-HVU-3	Service Level A		0IM.2-01A	HVU-3-13-BO-6											
AO-1		HVU-3	H-VLV	Heating Coil Valve	% Open	UNT			13AO-1		AO#,AOCM,24V	EN-HVU-3	Service Level A		0IM.2-01A	HVU-3-13-AO-1	2/18	+-	EP-8000-2	SUPPLY, O		3/18	Device dependent	0-10V OUT		U23	
AO-2		HVU-3				UNT			13AO-2			EN-HVU-3	Service Level A		0IM.2-01A	HVU-3-13-AO-2											

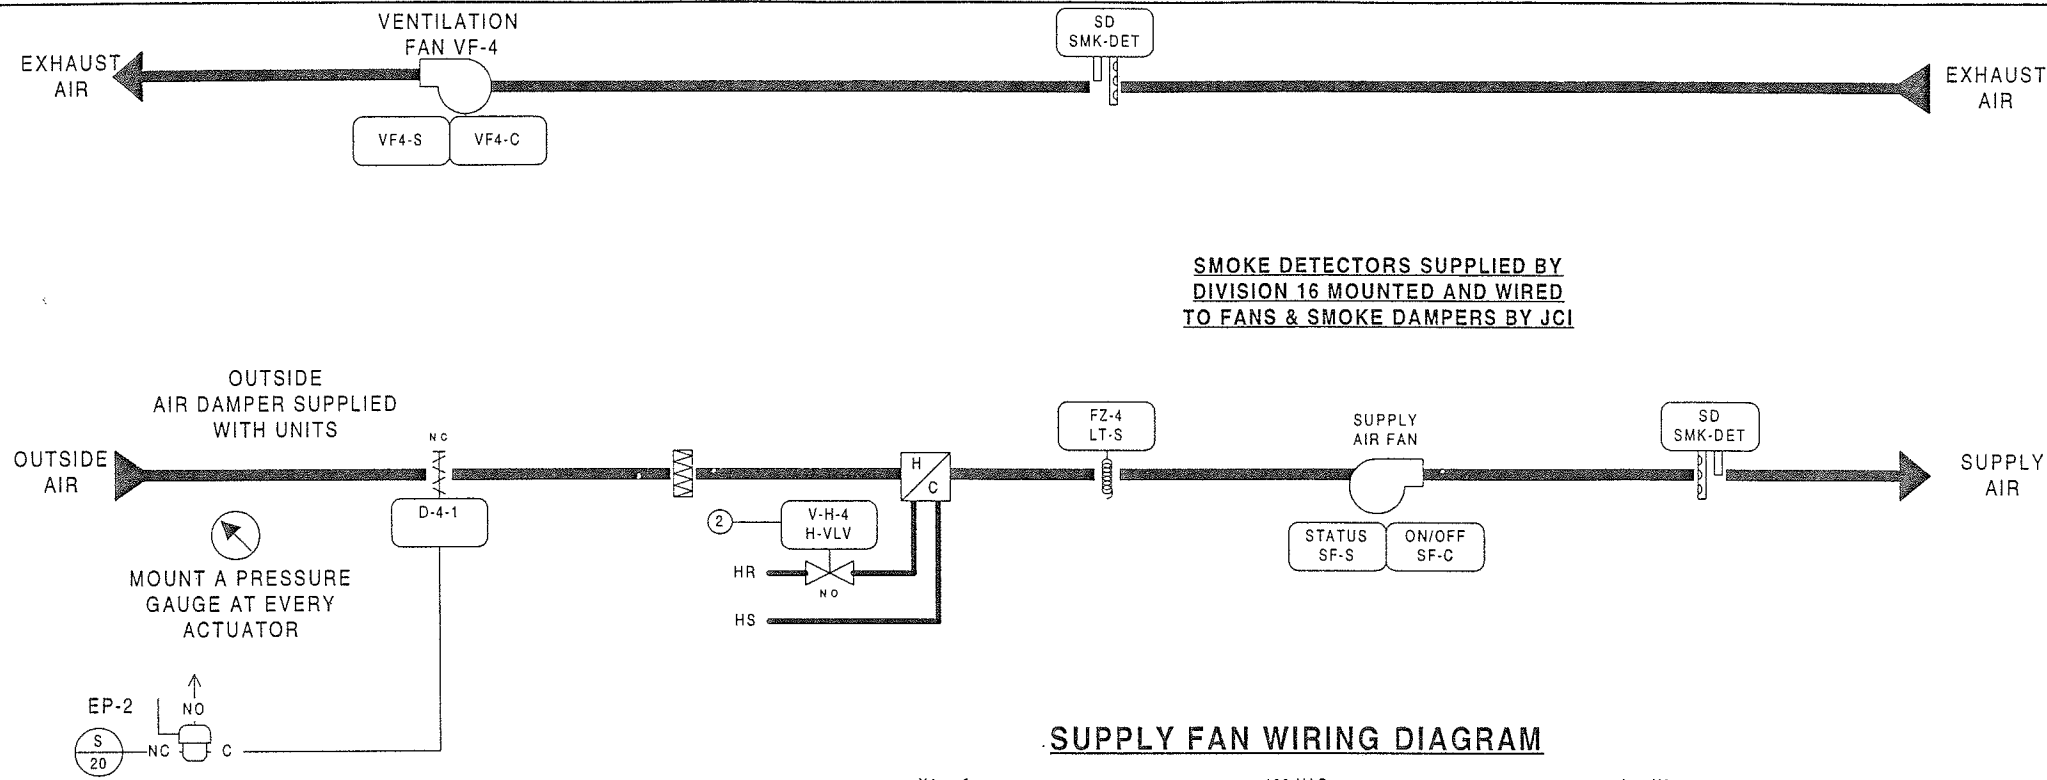


BILL OF MATERIALS

Estimate: hvu-4 70520098.pre



Desig.	Qty	Part #	Description
Field Devices:			
D-4-1	1	D-3153-2	DMPR ACT, 8-13#
	1	G-2010-11	GAGE, 2", 0-30 PSIG, STEM
EP-2	1	V11HAA-100	3-W SOLENOID, W/OV, 120VAC
FZ-4	1	A70HA-1C	STAT, LL, 20', EL, MFR, 15/55F
H-VLV	1	--	SEE VALVE SCHEDULE
VF-4	1	BZ-1000-11	ENCL, 4-5/8X 5-1/8 X 3-3/8
	1	PD-101-35	RLY BASE, 3PDT, 11PIN, 10A
	1	PD-109-51	RELAY PLUG-IN 3PDT 24VAC
ZN-T	1	TE-6410W-1000	MSTAT, NI, BOX, JACK
Panel Devices:			
EN-HVU-4	1	AS-UNT111-101	UNT111 MTD IN UPM, W/50VA
	1	EN-EXP101-0	UNIV PKG MOD, CVR & BACKBN
EP-1	1	EP-8000-2	XDUCR, EP, 0/10V, HI VOL
PI-1	1	G-2010-11	GAGE, 2", 0-30 PSIG, STEM
RLY-1	1	AS-RLY002-0	RELAY; 2SPDT 5 AMP 240VAC



SUPPLY FAN WIRING DIAGRAM

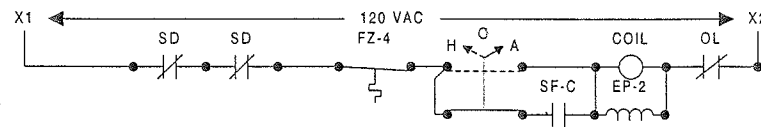

VENT FAN VF-4 DIAGRAM

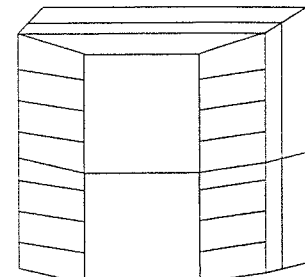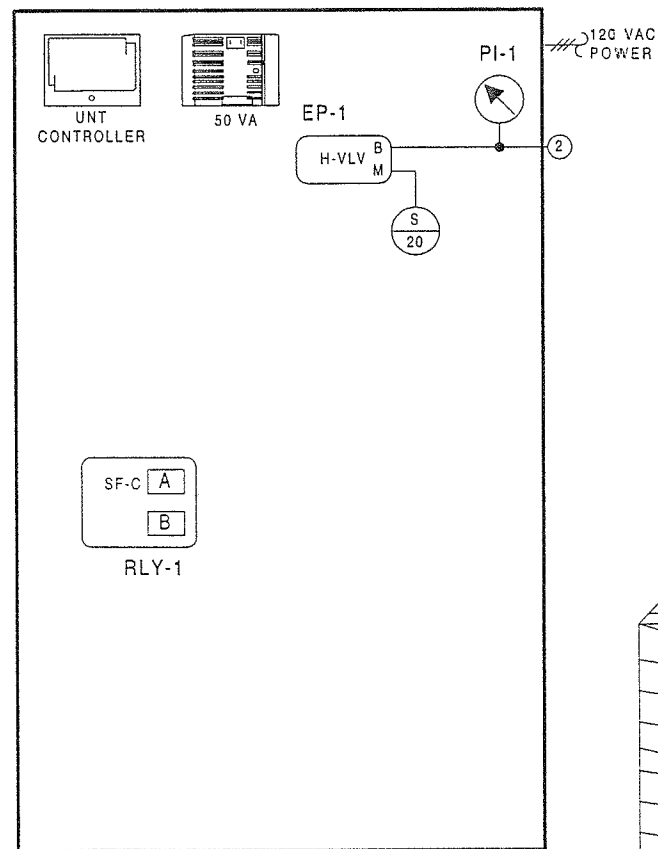

ENCLOSURE EN-HVU-4
AS-UNT111-101
LOCATED ADJACENT
TO UNIT
NCM-5/N2 ADD = 14

FAN	LOCATION	ELEC PANEL	STARTER	LOCATION
HVU-4	SERVICE LEVEL		LOCAL	SERVICE LEVEL
VF-4	SERVICE LEVEL	MCC: SRA	4E	SERVICE LEVEL

DESCRIPTION OF OPERATION

THE METASYS SYSTEM WILL DETERMINE THE "OCCUPIED AND UNOCCUPIED" MODES OF OPERATION. OCCUPIED MODES GENERALLY OCCUR DURING STADIUM EVENTS, BUT MANUAL OVERRIDE THROUGH THE METASYS SYSTEM ON SELECTED UNITS WILL FREQUENTLY BE REQUIRED. WHEN THE UNIT AND VENTILATION FAN ARE DE-ENERGIZED, OUTSIDE AIR DAMPER D-4-1, WILL CLOSE. HEATING COIL VALVE V-H-4 WILL BE CLOSED TO THE COIL.

OCCUPIED HEATING MODE - SUPPLY FAN WILL BE RUNNING. OUTSIDE AIR DAMPER D-4-1 WILL OPEN AND VENTILATION FAN VF-4 WILL START AND RUN CONTINUOUSLY. ROOM SENSOR TR-4 THROUGH THE METASYS SYSTEM CONTROL UNIT, WILL ON A RISE IN TEMPERATURE ABOVE ITS SETTING OF SEVENTY-FIVE (75F) MODULATE V-H-4 CLOSED TO THE HEATING COIL. ON A FALL IN TEMPERATURE, THIS CYCLE IS REVERSED.

UNOCCUPIED HEATING MODE - ROOM SENSOR TR-4, WILL ON A FALL IN TEMPERATURE TO ITS SETTING OF FIFTY (50F), ACTIVATE THE SYSTEM TO RUN IN THE OCCUPIED MODE AS HEREIN BEFORE DESCRIBED. ON A RISE IN TEMPERATURE TO FIFTY-FIVE (55F), THE SYSTEM WILL BE DE-ENERGIZED. IN THE UNOCCUPIED MODE ALL AIR HANDLING UNIT DAMPERS AND CONTROLS WILL RETURN TO THEIR NORMAL POSITION READY FOR RESTARTING.

OCCUPIED VENTILATING MODE - SUPPLY AND VENTILATION FANS START AND RUN CONTINUOUSLY. OUTSIDE AIR DAMPER D-4-1 WILL OPEN. HEATING COIL VALVE V-H-4 WILL BE CLOSED TO THE COIL.

UNOCCUPIED VENTILATING MODE - SYSTEM IS DE-ENERGIZED AND FANS ARE OFF.

SMOKE CONTROL - SMOKE DETECTORS WILL, ON THE DETECTION OF PRODUCTS OF COMBUSTION, SHUT DOWN THE SUPPLY AND EXHAUST FANS AND CLOSE ALL SYSTEM DAMPERS.


REVISION INFORMATION	IN CONSIDERATION OF THE RECEIPT OF THIS DOCUMENT, THE RECIPIENT AGREES NOT TO REPRODUCE, COPY, USE OR TRANSMIT THIS DOCUMENT AND/OR THE INFORMATION THEREIN CONTAINED, IN WHOLE OR IN PART, OR TO SUFFER SUCH ACTION BY OTHERS, FOR ANY PURPOSE, EXCEPT WITH THE WRITTEN PERMISSION OF JOHNSON CONTROLS, INC. AND FURTHER AGREES TO SURRENDER SAME TO JOHNSON CONTROLS, INC. UPON DEMAND.	DRAWING TITLE	HEAT-VENT UNIT HVU-4 RECYCLE	
NUMBER		AS-BUILT		
DATE		07/18/00		7/18/00
TIME		03:31 PM		

DATE: 07/18/00
TIME: 03:31 PM
FILE NAME: HVU-4.rvt
COPYRIGHT JOHNSON CONTROLS, INC. 1999

PROJECT TITLE
BALTIMORE NFL STADIUM
AT CAMDEN YARDS
BALTIMORE, MARYLAND

SALES ENGINEER	PROJECT MANAGER	APPLICATION ENGINEER	DRAWN	APPROVED
JDP	WJT	RTS	BY RTS	DATE 09/05/97
BRANCH INFORMATION			CONTRACT NUMBER	
JOHNSON CONTROLS Systems & Services Division			7052-0098	
60 LOVETON CIRCLE SPARKS, MD 21152			DRAWING NUMBER BL-6559-32	

Full Spreadsheet		Software				Digital Controller Information						Panel Information					Intermediate Device					Field Device			Ref Detail	Comment	
Tag	Point Type	System Name	Object Name	Expanded ID	Display Units	DC Type	N2 Trunk	N2 Addr	Cable Destination Bay/Terminal	Module Type	Termination	Panel	Panel Location	Slot Number	Reference Drawing	Cable Number	Wiring/Tubing	Termination In	Device	Termination Out	Location	Wiring/Tubing	Terminations	Device	Location	Ref Detail	Comment
		HVU-4				UNT						EN-HVU-4	Service Level A		M.2-01A												Power to Controller
		HVU-4				UNT	1	14				EN-HVU-4	Service Level A		0 M.2-01A												N2 Trunk
AI-1		HVU-4				UNT			14 AI-1			EN-HVU-4	Service Level A		0 M.2-01A	HVU-4-14-AI-1											
AI-2		HVU-4				UNT			14 AI-2			EN-HVU-4	Service Level A		0 M.2-01A	HVU-4-14-AI-2											
AI-3		HVU-4				UNT			14 AI-3			EN-HVU-4	Service Level A		0 M.2-01A	HVU-4-14-AI-3											
AI-4		HVU-4	ZN-T	Zone Temperature	Deg F	UNT			14 AI-4		PHONE JACK	EN-HVU-4	Service Level A		0 M.2-01A	HVU-4-14-AI-4					8/26	PHONE JACK	TE-6410W-1000			U2	
AI-5		HVU-4				UNT			14 AI-5			EN-HVU-4	Service Level A		0 M.2-01A	HVU-4-14-AI-5											
AI-6		HVU-4				UNT			14 AI-6			EN-HVU-4	Service Level A		0 M.2-01A	HVU-4-14-AI-6											
BI-1		HVU-4	SF-S	Supply Fan Status	Off On	UNT			14 BI-1		BI#,24VAC	EN-HVU-4	Service Level A		0 M.2-01A	HVU-4-14-BI-1					2/22	Device dependent	Aux Contact (NO)			U70	
BI-2		HVU-4	VF4-S	Vent Fan 4 Status	Off On	UNT			14 BI-2		BI#,24VAC	EN-HVU-4	Service Level A		0 M.2-01A	HVU-4-14-BI-2					2/22	Device dependent	Aux Contact (NO)			U70	
BI-3		HVU-4	SMK-DET	Smoke Detectors	Normal Alarm	UNT			14 BI-3		BI#,24VAC	EN-HVU-4	Service Level A		0 M.2-01A	HVU-4-14-BI-3					2/22	Device dependent	Contact (NO)			U70	
BI-4		HVU-4	LT-S	Low Temperature Stat	Normal Alarm	UNT			14 BI-4		BI#,24VAC	EN-HVU-4	Service Level A		0 M.2-01A	HVU-4-14-BI-4					2/22	NO,M1	A70 (NC)			U71	
BO-1		HVU-4	SF-C	Supply Fan Control	Off On	UNT			14 BO-1	RLY	BO#,24V,COM	EN-HVU-4	Service Level A		0 M.2-01A	HVU-4-14-BO-1	3/18	A.COILS.COM	RELAY-A	NO.COM		2/14	See starter detail	Starter (NO)-(sw lo)		U60	
BO-2		HVU-4	VF4-C	Vent Fan 4 Control	Off On	UNT			14 BO-2		BO#,24VAC	EN-HVU-4	Service Level A		0 M.2-01A	HVU-4-14-BO-2					2/18	Device dependent	24VAC OUT (sw lo)			U51	
BO-3		HVU-4				UNT			14 BO-3			EN-HVU-4	Service Level A		0 M.2-01A	HVU-4-14-BO-3											
BO-4		HVU-4				UNT			14 BO-4			EN-HVU-4	Service Level A		0 M.2-01A	HVU-4-14-BO-4											
BO-5		HVU-4				UNT			14 BO-5			EN-HVU-4	Service Level A		0 M.2-01A	HVU-4-14-BO-5											
BO-6		HVU-4				UNT			14 BO-6			EN-HVU-4	Service Level A		0 M.2-01A	HVU-4-14-BO-6											
AO-1		HVU-4	H-VLV	Heating Coil Valve	% Open	UNT			14 AO-1		AO#,AOCM,24V	EN-HVU-4	Service Level A		0 M.2-01A	HVU-4-14-AO-1	2/18	+-	EP-8000-2	SUPPLY, O		3/18	Device dependent	0-10V OUT		U23	
AO-2		HVU-4				UNT			14 AO-2			EN-HVU-4	Service Level A		0 M.2-01A	HVU-4-14-AO-2											

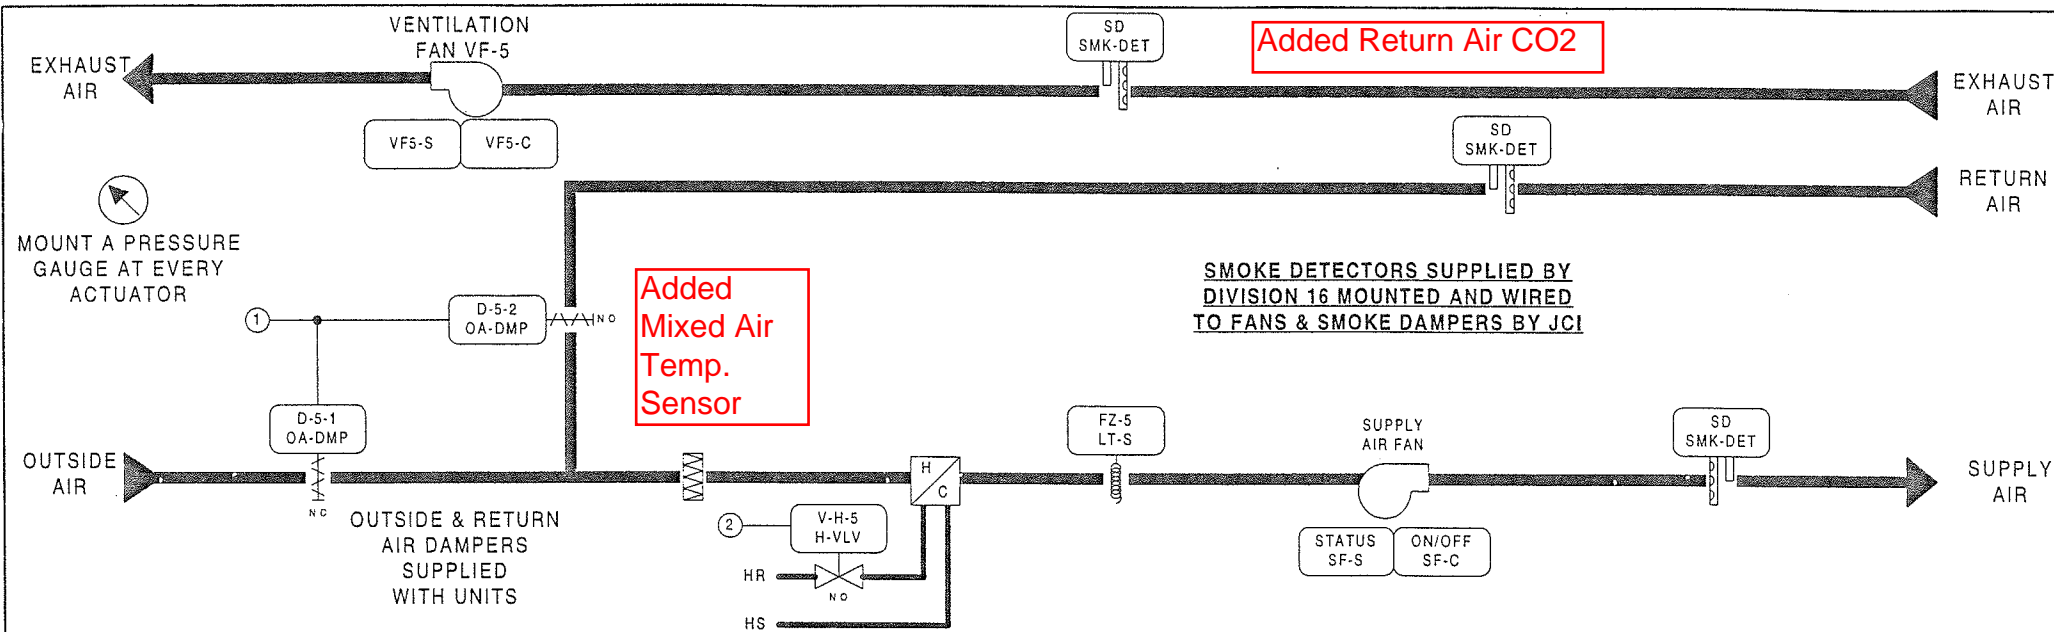

BILL OF MATERIALS

Estimate: hvu-5 70520098.pre
 Desig. QtyPart # Description


Field Devices:

FZ-5	1	A70HA-1C	STAT, LL, 20', EL, MAN, 15, 55F
H-VLV	1	--	SEE VALVE SCHEDULE
OA-DMP	2	D-3153-2	DMPR ACT, 8-13#
	2	G-2010-11	GAGE, 2", 0-30 PSIG, STEM
VF-5	1	BZ-1000-11	ENCL, 4-5/8X 5-1/8 X 3-3/8
	1	PD-101-35	RLY BASE, 3PDT, 11PIN, 10A
	1	PD-109-51	RELAY PLUG-IN 3PDT 24VAC
ZN-T	1	TE-6410W-1000	MSTAT, NI, BOX, JACK


Panel Devices:

EN-HVU-5	1	AS-UNT111-101	UNT111 MTD IN UPM, W 50VA
	1	EN-EXP101-0	UNIV PKG MOD, CVR & BACKBN
EP-1	1	EP-8000-2	XDUCR, EP, 0/10V, HI VOL
EP-2	1	V11HGA-100	3-W SOLENOID, W/OV, 24 VAC
PI-1,2	2	G-2010-11	GAGE, 2", 0-30 PSIG, STEM
RLY-1	1	AS-RLY002-0	RELAY; 2SPDT 5 AMP 240VAC

SUPPLY FAN WIRING DIAGRAM

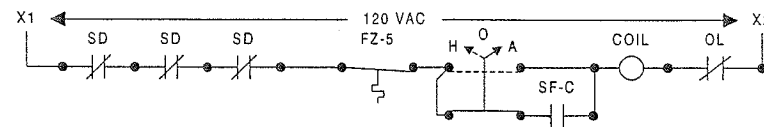

VENT FAN VF-5 DIAGRAM

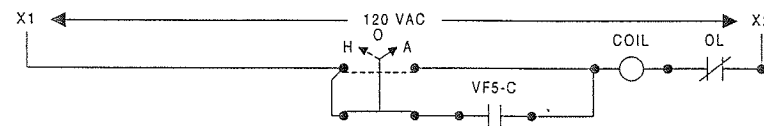

DESCRIPTION OF OPERATION

THE METASYS SYSTEM WILL DETERMINE THE "OCCUPIED AND UNOCCUPIED" MODES OF OPERATION. OCCUPIED MODES GENERALLY OCCUR DURING STADIUM EVENTS, BUT MANUAL OVERRIDE THROUGH THE METASYS SYSTEM ON SELECTED UNITS WILL FREQUENTLY BE REQUIRED. WHEN THE UNIT AND VENTILATION FAN ARE DE-ENERGIZED, OUTSIDE AIR DAMPER D-5-1, WILL CLOSE. UNOCCUPIED RETURN AIR DAMPER D-5-2 WILL BE OPEN AND HEATING COIL VALVE V-H-5 WILL BE CLOSED TO THE COIL.

WARM-UP MODE - SUPPLY FAN WILL START AS DETERMINED BY THE OPTIMAL START PROGRAM OF THE METASYS SYSTEM. ON THE START OF THE UNIT, HEATING COIL VALVE V-H-5 WILL OPEN FULL TO COIL AND RETURN AIR DAMPER D-5-2 WILL BE FULLY OPEN WITH THE OUTSIDE AIR DAMPER D-5-1 CLOSED. VENTILATION FAN VF-5 WILL BE OFF DURING THE WARM-UP MODE. DURATION OF THE WARM-UP MODE IS DETERMINED BY THE METASYS SYSTEM AND WILL BE DYNAMICALLY UPDATED TO END FIFTEEN (15) MINUTES PRIOR TO OCCUPANCY TIME. WARM-UP MODE IS STOPPED WHEN THE ZONE AIR TEMPERATURE REACHES THE SETTING OF TR-5 (70F).



OCCUPIED HEATING MODE - SUPPLY FAN WILL BE RUNNING. RETURN AIR DAMPER D-5-2 WILL CLOSE. OUTSIDE AIR DAMPER D-5-1 WILL OPEN AND VENTILATION FAN VF-5 WILL START AND RUN CONTINUOUSLY AFTER THE WARM-UP MODE IS STOPPED. RETURN AIR DAMPER D-5-2 WILL CLOSE. ROOM SENSOR TR-5 THROUGH THE METASYS SYSTEM CONTROL UNIT, WILL ON A RISE IN TEMPERATURE ABOVE ITS SETTING OF SEVENTY-FIVE (75F) MODULATE V-H-5 CLOSED TO THE HEATING COIL. ON A FALL IN TEMPERATURE, THIS CYCLE IS REVERSED.

UNOCCUPIED HEATING MODE - ROOM SENSOR TR-5 WILL ON A FALL IN TEMPERATURE TO ITS SETTING OF FIFTY (50F). ACTIVATE THE SYSTEM TO RUN IN THE WARM-UP MODE AS HEREINBEFORE DESCRIBED. ON A RISE IN TEMPERATURE TO FIFTY-FIVE (55F), THE SYSTEM WILL BE DE-ENERGIZED. IN THE UNOCCUPIED MODE ALL AIR HANDLING UNIT DAMPERS AND CONTROLS WILL RETURN TO THEIR NORMAL POSITION READY FOR RESTARTING.

OCCUPIED VENTILATING MODE - SUPPLY AND VENTILATION FANS START AND RUN CONTINUOUSLY. OUTSIDE AIR DAMPER D-5-1 WILL OPEN AND RETURN AIR DAMPER D-5-2 WILL CLOSE. HEATING COIL VALVE V-H-5 WILL BE CLOSED TO THE COIL.

UNOCCUPIED VENTILATING MODE - SYSTEM IS DE-ENERGIZED AND FANS ARE OFF.

SMOKE CONTROL - SMOKE DETECTORS WILL, ON THE DETECTION OF PRODUCTS OF COMBUSTION, SHUT DOWN THE SUPPLY AND EXHAUST FANS AND CLOSE ALL SYSTEM DAMPERS.

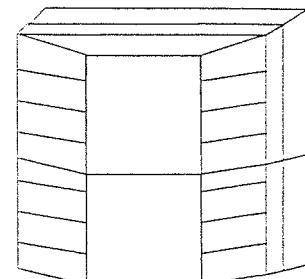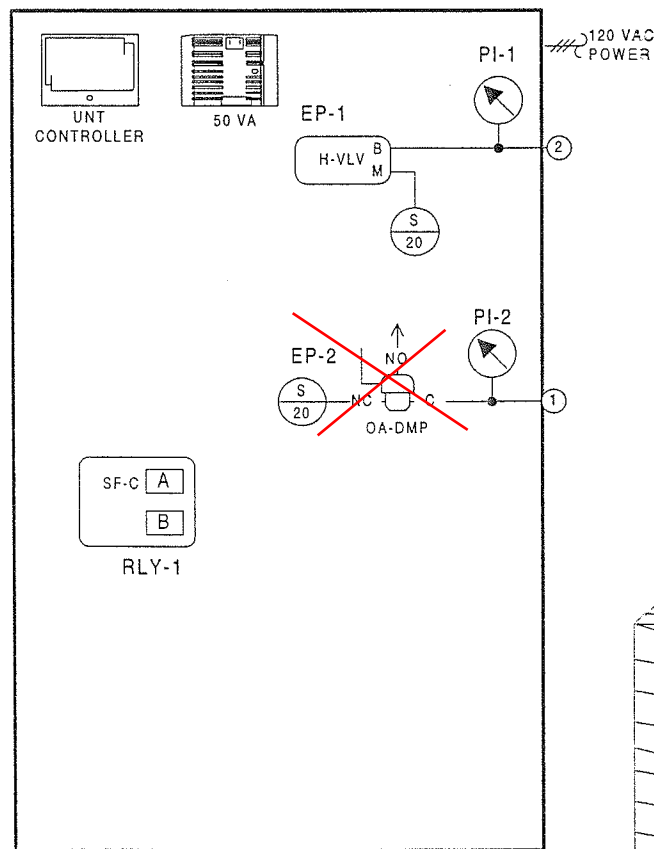

ENCLOSURE EN-HVU-5
 AS-UNT111-101
 LOCATED ADJACENT
 TO UNIT
 NCM-5.N2 ADD = 15

FAN	LOCATION	ELEC PANEL	STARTER	LOCATION
HVU-5	SERVICE LEVEL	MCC1SRA	5D	SERVICE LEVEL
VF-5	M CONCOURSE		LOCAL	M CONCOURSE

REVISION INFORMATION
NUMBER
DATE
TIME
FILE NAME

IN CONSIDERATION OF THE RECEIPT OF THIS DOCUMENT, THE RECIPIENT AGREES NOT TO REPRODUCE, COPY, USE OR TRANSMIT THIS DOCUMENT AND/OR THE INFORMATION THEREIN CONTAINED, IN WHOLE OR IN PART, OR TO SUFFER SUCH ACTION BY OTHERS, FOR ANY PURPOSE, EXCEPT WITH THE WRITTEN PERMISSION OF JOHNSON CONTROLS, INC. AND FURTHER AGREES TO SURRENDER SAME TO JOHNSON CONTROLS, INC. UPON DEMAND.

COPYRIGHT JOHNSON CONTROLS, INC. 1998

DRAWING TITLE
**HEAT-VENT UNIT HVU-5
 FIELD MAINTENANCE**


SERVICE LEVEL QUAD A

PROJECT TITLE
**BALTIMORE NFL STADIUM
 AT CAMDEN YARDS**

BALTIMORE, MARYLAND

AS-BUILT	7/18/00	CME
REFERENCE DRAWING	NO	REVISION-LOCATION
Drawn By: JDP	Project Manager: WJT	Application Engineer: RTS
By: RTS	DATE: 09/05/97	DATE
		JOHNSON CONTROLS 60 LOVETON CIRCLE SPARKS, MD 21152
Systems & Services Division		CONTRACT NUMBER 7052-0098 DRAWING NUMBER BL-6559-33

Full Spreadsheet		Software				Digital Controller Information						Panel Information				Intermediate Device				Field Device				Ref Detail	Comment		
Tag	Point Type	System Name	Object Name	Expanded ID	Display Units	DC Type	N2 Trunk	N2 Addr	Cable Destination Bay/Terminal	Module Type	Termination	Panel	Panel Location	Slot Number	Reference Drawing	Cable Number	Wiring/Termination In	Termination In	Device	Termination Out	Location	Wiring/Termination In	Terminations	Device	Location	Ref Detail	Comment
		HVU-5				UNT						EN-HVU-5	Service Level A		IM.2-01A												Power to Controller
		HVU-5				UNT	1	15				EN-HVU-5	Service Level A		0IM.2-01A												N2 Trunk
AI-1		HVU-5				UNT			AI-1			EN-HVU-5	Service Level A		0IM.2-01A	HVU-5-15-AI-1											
AI-2		HVU-5				UNT			AI-2			EN-HVU-5	Service Level A		0IM.2-01A	HVU-5-15-AI-2											
AI-3		HVU-5				UNT			AI-3			EN-HVU-5	Service Level A		0IM.2-01A	HVU-5-15-AI-3											
AI-4		HVU-5	ZN-T	Zone Temperature	Deg F	UNT			AI-4		PHONE JACK	EN-HVU-5	Service Level A		0IM.2-01A	HVU-5-15-AI-4					8/26	PHONE JACK	TE-6410W-1000		U2		
AI-5		HVU-5				UNT			AI-5			EN-HVU-5	Service Level A		0IM.2-01A	HVU-5-15-AI-5											
AI-6		HVU-5				UNT			AI-6			EN-HVU-5	Service Level A		0IM.2-01A	HVU-5-15-AI-6											
BI-1		HVU-5	SF-S	Supply Fan Status	Off On	UNT			BI-1		BI#,24VAC	EN-HVU-5	Service Level A		0IM.2-01A	HVU-5-15-BI-1					2/22	Device dependent	Aux Contact (NO)		U70		
BI-2		HVU-5	VF5-S	Vent Fan 5 Status	Off On	UNT			BI-2		BI#,24VAC	EN-HVU-5	Service Level A		0IM.2-01A	HVU-5-15-BI-2					2/22	Device dependent	Aux Contact (NO)		U70		
BI-3		HVU-5	SMK-DET	Smoke Detectors	Normal Alarm	UNT			BI-3		BI#,24VAC	EN-HVU-5	Service Level A		0IM.2-01A	HVU-5-15-BI-3					2/22	Device dependent	Contact (NO)		U70		
BI-4		HVU-5	LT-S	Low Temperature Stat	Normal Alarm	UNT			BI-4		BI#,24VAC	EN-HVU-5	Service Level A		0IM.2-01A	HVU-5-15-BI-4					2/22	NO.M1	A70 (NC)		U71		
BO-1		HVU-5	SF-C	Supply Fan Control	Off On	UNT			BO-1	RLY	BO#,24V.COM	EN-HVU-5	Service Level A		0IM.2-01A	HVU-5-15-BO-1	3/18	A.COILS.COM	RELAY-A	NO.COM		2/14	See starter detail	Starter (NO)-(sw lo)		U60	
BO-2		HVU-5	OA-DMP	Outside Air Damper	Closed Open	UNT			BO-2		BO#,24VAC	EN-HVU-5	Service Level A		0IM.2-01A	HVU-5-15-BO-2			V11HGA-100			2/18	Device dependent	24VAC OUT (sw lo)		U51	
BO-3		HVU-5	VF5-C	Vent Fan 5 Control	Off On	UNT			BO-3		BO#,24VAC	EN-HVU-5	Service Level A		0IM.2-01A	HVU-5-15-BO-3				PD-109-51			2/18	Device dependent	24VAC OUT (sw lo)		U51
BO-4		HVU-5				UNT			BO-4			EN-HVU-5	Service Level A		0IM.2-01A	HVU-5-15-BO-4											
BO-5		HVU-5				UNT			BO-5			EN-HVU-5	Service Level A		0IM.2-01A	HVU-5-15-BO-5											
BO-6		HVU-5				UNT			BO-6			EN-HVU-5	Service Level A		0IM.2-01A	HVU-5-15-BO-6											
AO-1		HVU-5	H-VLV	Heating Coil Valve	% Open	UNT			AO-1		AO#,AOCM,24VAC	EN-HVU-5	Service Level A		0IM.2-01A	HVU-5-15-AO-1	2/18	+-	EP-8000-2	SUPPLY, O			3/18	Device dependent	0-10V OUT		U23
AO-2		HVU-5				UNT			AO-2			EN-HVU-5	Service Level A		0IM.2-01A	HVU-5-15-AO-2											

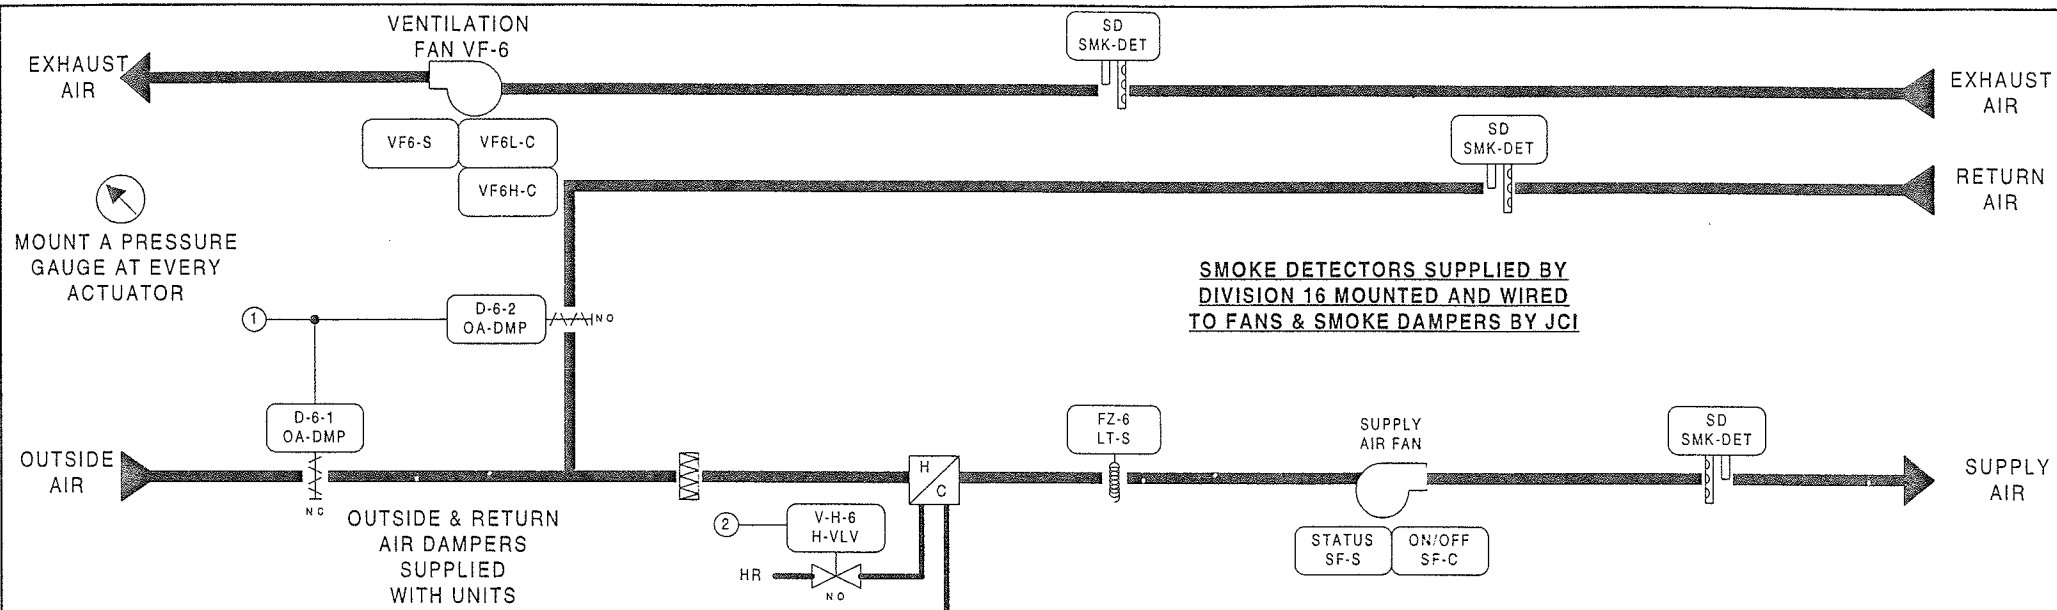


SMOKE DETECTORS SUPPLIED BY DIVISION 16 MOUNTED AND WIRED TO FANS & SMOKE DAMPERS BY JCI

BILL OF MATERIALS


Estimate: hvu-6 70520098.pre

Desig.	Qty	Part #	Description
Field Devices:			
FZ-6	1	A70HA-1C	STAT, LL, 20', EL, MAN, 15/55F
H-VLV	1	--	SEE VALVE SCHEDULE
OA-DMP	2	D-3153-2	DMPR ACT, 8-13#
	2	G-2010-11	GAGE, 2", 0-30 PSIG, STEM
VF-6	2	BZ-1000-11	ENCL, 4-5/8X 5-1/8 X 3-3/8
	2	PD-101-35	RLY BASE, 3PDT, 11PIN, 10A
	2	PD-109-51	RELAY PLUG-IN 3PDT 24VAC
ZN-T	1	TE-6410W-1000	MSTAT, NI, BOX, JACK
Panel Devices:			
EN-HVU-6	1	AS-UNT111-101	UNT111 MTD IN UPM, W/50VA
	1	EN-EXP101-0	UNIV PKG MOD, CVR & BACKEN
EP-1	1	EP-8000-2	XDUCR, EP, 0/10V, HI VOL
EP-2	1	V11HGA-100	3-W SOLENOID, W/OV, 24 VAC
PI-1,2	2	G-2010-11	GAGE, 2", 0-30 PSIG, STEM
RLY-1	1	AS-RLY002-0	RELAY; 2SPDT 5 AMP 240VAC

SUPPLY FAN WIRING DIAGRAM

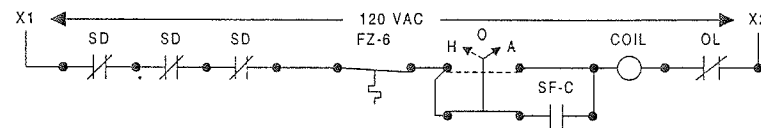

VENT FAN VF-6 DIAGRAM TWO-SPEED WIRING DIAGRAM

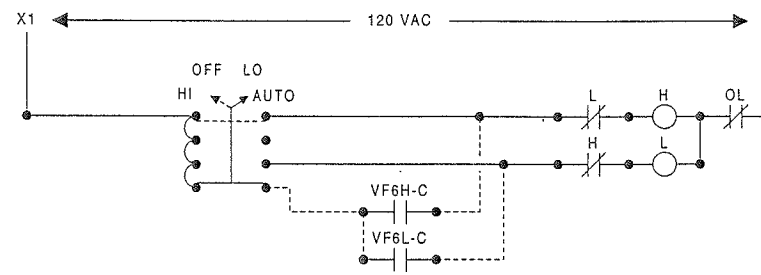

FAN	LOCATION	ELEC PANEL	STARTER	LOCATION
HVU-6	SERVICE LEVEL		LOCAL	SERVICE LEVEL
VF-6	SERVICE LEVEL		LOCAL	SERVICE LEVEL

DESCRIPTION OF OPERATION

THE METASYS SYSTEM WILL DETERMINE THE "OCCUPIED AND UNOCCUPIED" MODES OF OPERATION. OCCUPIED MODES GENERALLY OCCUR DURING STADIUM EVENTS, BUT MANUAL OVERRIDE THROUGH THE METASYS SYSTEM ON SELECTED UNITS WILL FREQUENTLY BE REQUIRED. WHEN THE UNIT AND VENTILATION FAN ARE DE-ENERGIZED, OUTSIDE AIR DAMPER D-6-1, WILL CLOSE. UNOCCUPIED RETURN AIR DAMPER D-6-2 WILL BE OPEN AND HEATING COIL VALVE V-H-6 WILL BE CLOSED TO THE COIL.

WARM-UP MODE - SUPPLY FAN WILL START AS DETERMINED BY THE OPTIMAL START PROGRAM OF THE METASYS SYSTEM. ON THE START OF THE UNIT, HEATING COIL VALVE V-H-6 WILL OPEN FULL TO COIL AND RETURN AIR DAMPER D-6-2 WILL BE FULLY OPEN WITH THE OUTSIDE AIR DAMPER D-6-1 CLOSED. VENTILATION FAN VF-6 WILL BE OFF DURING THE WARM-UP MODE. DURATION OF THE WARM-UP MODE IS DETERMINED BY THE METASYS SYSTEM AND WILL BE DYNAMICALLY UPDATED TO END FIFTEEN (15) MINUTES PRIOR TO OCCUPANCY TIME. WARM-UP MODE IS STOPPED WHEN THE ZONE AIR TEMPERATURE REACHES THE SETTING OF TR-6 (70F).



OCCUPIED HEATING MODE - SUPPLY FAN WILL BE RUNNING, RETURN AIR DAMPER D-6-2 WILL CLOSE. OUTSIDE AIR DAMPER D-6-1 WILL OPEN AND VENTILATION FAN VF-6 (LOW SPEED) WILL START AND RUN CONTINUOUSLY AFTER THE WARM-UP MODE IS STOPPED. RETURN AIR DAMPER D-6-2 WILL CLOSE. ROOM SENSOR TR-6 THROUGH THE METASYS SYSTEM CONTROL UNIT, WILL ON A RISE IN TEMPERATURE ABOVE ITS SETTING OF SEVENTY-FIVE (75F) MODULATE V-H-6 CLOSED TO THE HEATING COIL. ON A FALL IN TEMPERATURE, THIS CYCLE IS REVERSED.

UNOCCUPIED HEATING MODE - ROOM SENSOR TR-6, WILL ON A FALL IN TEMPERATURE TO ITS SETTING OF FIFTY (50F). ACTIVATE THE SYSTEM TO RUN IN THE WARM-UP MODE AS HEREINBEFORE DESCRIBED. ON A RISE IN TEMPERATURE TO FIFTY-FIVE (55F), THE SYSTEM WILL BE DE-ENERGIZED. IN THE UNOCCUPIED MODE ALL AIR HANDLING UNIT DAMPERS AND CONTROLS WILL RETURN TO THEIR NORMAL POSITION READY FOR RESTARTING.

OCCUPIED VENTILATING MODE - SUPPLY AND VENTILATION FAN (HIGH SPEED) START AND RUN CONTINUOUSLY. OUTSIDE AIR DAMPER D-6-1 WILL OPEN AND RETURN AIR DAMPER D-6-2 WILL CLOSE. HEATING COIL VALVE V-H-6 WILL BE CLOSED TO THE COIL.


UNOCCUPIED VENTILATING MODE - SYSTEM IS DE-ENERGIZED AND FANS ARE OFF.

SMOKE CONTROL - SMOKE DETECTORS WILL, ON THE DETECTION OF PRODUCTS OF COMBUSTION, SHUT DOWN THE SUPPLY AND EXHAUST FANS AND CLOSE ALL SYSTEM DAMPERS.

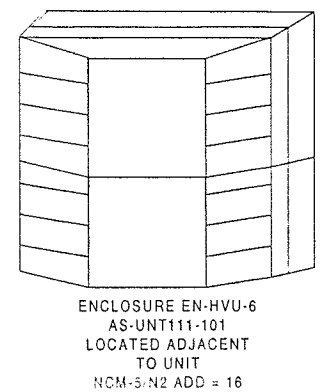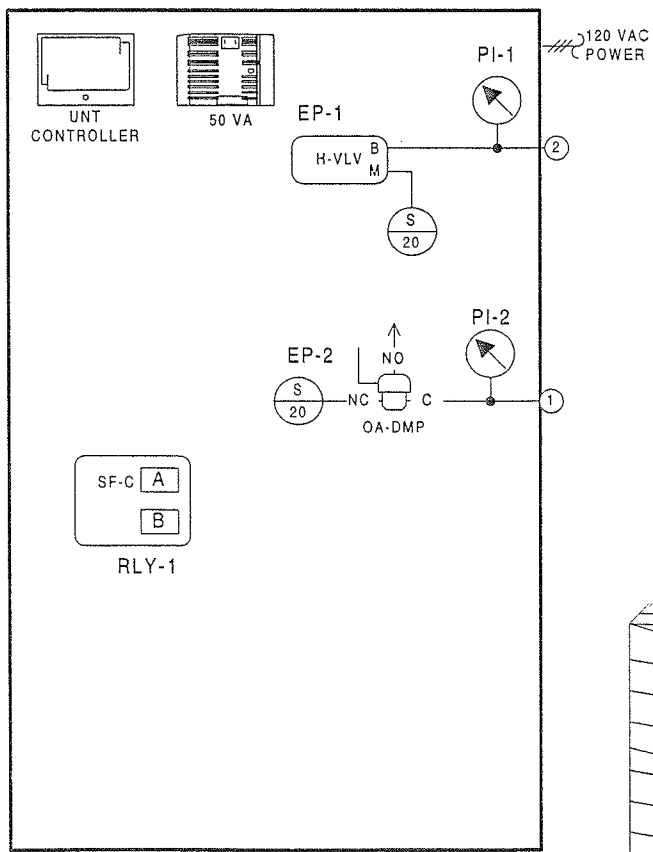

<p>REVISION INFORMATION</p> <p>NUMBER</p> <p>DATE 07/18/00</p> <p>TIME 03:33 PM</p> <p>FILE NAME HVU-6.vsd</p>	<p>IN CONSIDERATION OF THE RECEIPT OF THIS DOCUMENT, THE RECIPIENT AGREES NOT TO REPRODUCE, COPY, USE OR TRANSMIT THIS DOCUMENT AND/OR THE INFORMATION THEREIN CONTAINED, IN WHOLE OR IN PART, OR TO SUFFER SUCH ACTION BY OTHERS, FOR ANY PURPOSE, EXCEPT WITH THE WRITTEN PERMISSION OF JOHNSON CONTROLS, INC. AND FURTHER AGREES TO SURRENDER SAME TO JOHNSON CONTROLS, INC. UPON DEMAND.</p> <p>Copyright JOHNSON CONTROLS, INC. 1999</p>	<p>DRAWING TITLE</p> <p>HEAT-VENT UNIT HVU-6 SHOP EAST</p> <p>SERVICE LEVEL QUAD B</p> <p>PROJECT TITLE</p> <p>BALTIMORE NFL STADIUM AT CAMDEN YARDS</p> <p>BALTIMORE, MARYLAND</p>	<p>AS-BUILT</p> <p>7/18/00 CME</p> <p>REFERENCE DRAWING NO</p> <p>REVISION-LOCATION</p> <p>DATE</p> <p>BY</p> <p>DATE</p> <p>DATE</p> <p>DATE</p> <p>DATE</p> <p>DATE</p>	<p>JOHNSON CONTROLS</p> <p>Systems & Services Division</p> <p>JOHNSON CONTROLS</p> <p>60 LOVETON CIRCLE</p> <p>SPARKS, MD 21152</p> <p>7052-0098</p> <p>DRAWING NUMBER</p> <p>BL-6559-34</p>
--	---	---	---	--

Full Spreadsheet		Software				Digital Controller Information						Panel Information				Intermediate Device					Field Device				Ref Detail	Comment	
Tag	Point Type	System Name	Object Name	Expanded ID	Display Units	DC Type	N2 Trunk	N2 Addr	Cable Destination Bay/Terminal	Module Type	Termination	Panel	Panel Location	Slot Number	Reference Drawing	Cable Number	Wiring/Tubing	Termination In	Device	Termination Out	Location	Wiring/Tubing	Terminations	Device	Location	Ref Detail	Comment
		HVU-6				UNT						EN-HVU-6	Service Level B		M.2-01B												Power to Controller
		HVU-6	*			UNT	1	16				EN-HVU-6	Service Level B		0.M.2-01B												N2 Trunk
AI-1		HVU-6				UNT			16 AI-1			EN-HVU-6	Service Level B		0.M.2-01B	HVU-6-16-AI-1											
AI-2		HVU-6				UNT			16 AI-2			EN-HVU-6	Service Level B		0.M.2-01B	HVU-6-16-AI-2											
AI-3		HVU-6				UNT			16 AI-3			EN-HVU-6	Service Level B		0.M.2-01B	HVU-6-16-AI-3											
AI-4		HVU-6	ZN-T	Zone Temperature	Deg F	UNT			16 AI-4		PHONE JACK	EN-HVU-6	Service Level B		0.M.2-01B	HVU-6-16-AI-4					8/26	PHONE JACK	TE-6410W-1000			U2	
AI-5		HVU-6				UNT			16 AI-5			EN-HVU-6	Service Level B		0.M.2-01B	HVU-6-16-AI-5											
AI-6		HVU-6				UNT			16 AI-6			EN-HVU-6	Service Level B		0.M.2-01B	HVU-6-16-AI-6											
BI-1		HVU-6	SF-S	Supply Fan Status	Off On	UNT			16 BI-1		BI#,24VAC	EN-HVU-6	Service Level B		0.M.2-01B	HVU-6-16-BI-1					2/22	Device dependent	Aux Contact (NO)			U70	
BI-2		HVU-6	VF6-S	Vent Fan 6 Status	Off On	UNT			16 BI-2		BI#,24VAC	EN-HVU-6	Service Level B		0.M.2-01B	HVU-6-16-BI-2					2/22	Device dependent	Aux Contact (NO)			U70	
BI-3		HVU-6	SMK-DET	Smoke Detectors	Normal Alarm	UNT			16 BI-3		BI#,24VAC	EN-HVU-6	Service Level B		0.M.2-01B	HVU-6-16-BI-3					2/22	Device dependent	Contact (NO)			U70	
BI-4		HVU-6	LT-S	Low Temperature Stat	Normal Alarm	UNT			16 BI-4		BI#,24VAC	EN-HVU-6	Service Level B		0.M.2-01B	HVU-6-16-BI-4					2/22	NO.M1	A70 (NC)			U71	
BO-1		HVU-6	SF-C	Supply Fan Control	Off On	UNT			16 BO-1		RLY	EN-HVU-6	Service Level B		0.M.2-01B	HVU-6-16-BO-1	3/18	A.COILS.COM	RELAY-A	NO.COM		2/14	See starter detail	Starter (NO)-(sw lo)		U60	
BO-2		HVU-6	OA-DMP	Outside Air Damper	Closed Open	UNT			16 BO-2		BO#,24VAC	EN-HVU-6	Service Level B		0.M.2-01B	HVU-6-16-BO-2			V11HGA-100		2/18	Device dependent	24VAC OUT (sw lo)		U51		
BO-3		HVU-6	VF6L-C	Vent Fan 6 Control Low	Off On	UNT			16 BO-3		BO#,24VAC	EN-HVU-6	Service Level B		0.M.2-01B	HVU-6-16-BO-3			PD-109-51		2/18	Device dependent	24VAC OUT (sw lo)		U51		
BO-4		HVU-6	VF6H-C	Vent Fan 6 Control High	Off On	UNT			16 BO-4		BO#,24VAC	EN-HVU-6	Service Level B		0.M.2-01B	HVU-6-16-BO-4			PD-109-51		2/18	Device dependent	24VAC OUT (sw lo)		U51		
BO-5		HVU-6				UNT			16 BO-5			EN-HVU-6	Service Level B		0.M.2-01B	HVU-6-16-BO-5											
BO-6		HVU-6				UNT			16 BO-6			EN-HVU-6	Service Level B		0.M.2-01B	HVU-6-16-BO-6											
AO-1		HVU-6	H-VLV	Heating Coil Valve	% Open	UNT			16 AO-1		AO#,AOCM,24VAC	EN-HVU-6	Service Level B		0.M.2-01B	HVU-6-16-AO-1	2/18	+-	EP-8000-2	SUPPLY, O		3/18	Device dependent	0-10V OUT		U23	
AO-2		HVU-6				UNT			16 AO-2			EN-HVU-6	Service Level B		0.M.2-01B	HVU-6-16-AO-2											

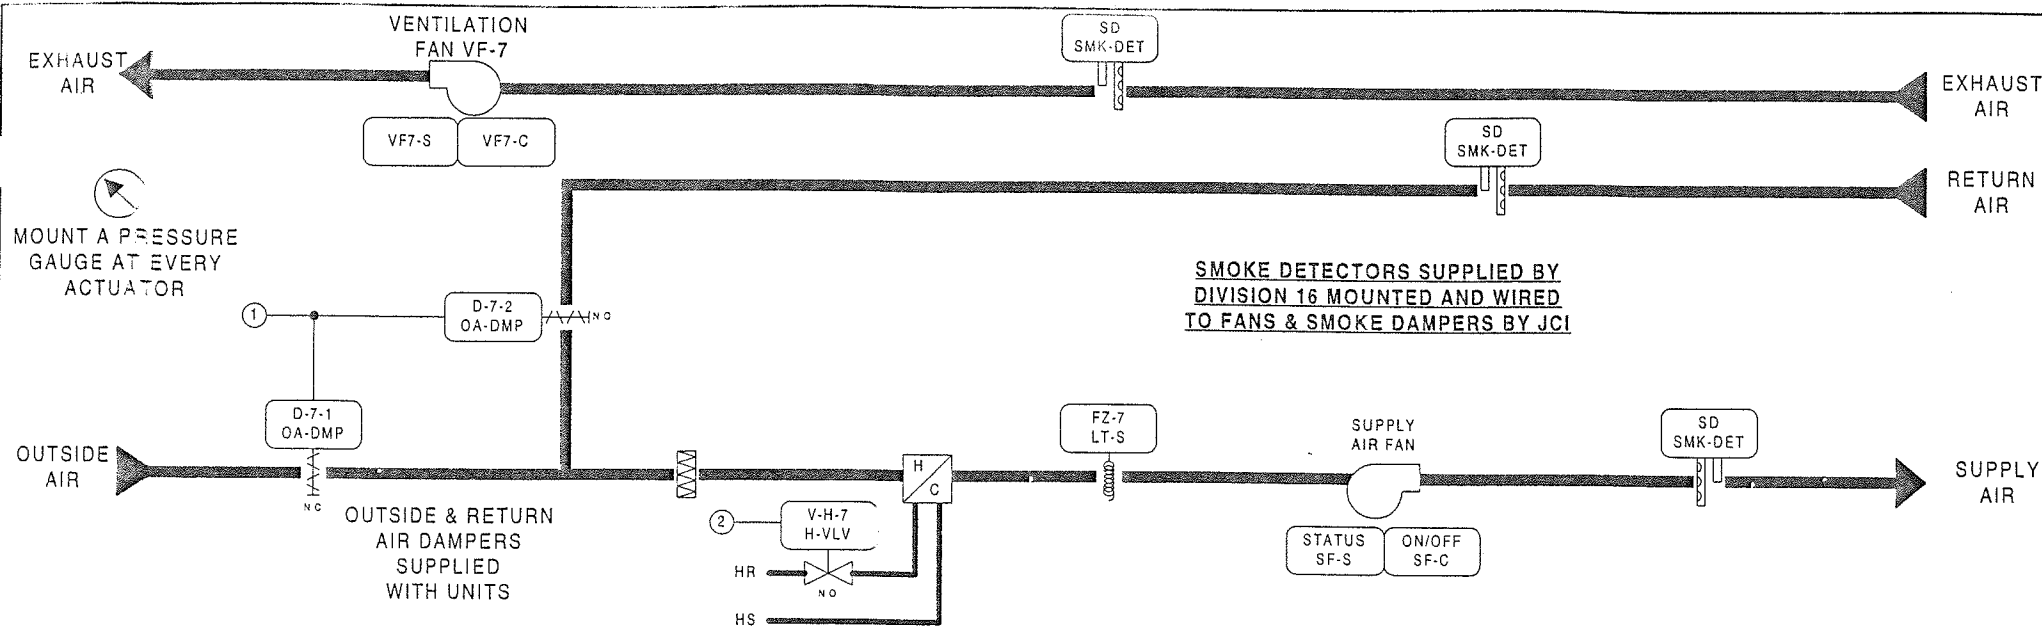


BILL OF MATERIALS

Estimate: hvu-7 70520098.pre




Desig.	Qty	Part #	Description
Field Devices:			
FZ-7	1	A70HA-1C	STAT, LL, 20', EL, MAN, 15/55F
H-VLV	1	--	SEE VALVE SCHEDULE
OA-DMP	2	D-3153-2	DMFR ACT, 8-13#
	2	G-2010-11	GAGE, 2", 0-30 PSIG, STEM
VF-7	1	BZ-1000-11	ENCL, 4-5/8X 5-1/8 X 3-3/8
	1	PD-101-35	RLY BASE, 3PDT, 11PIN, 10A
	1	PD-109-51	RELAY PLUG-IN 3PDT 24VAC
ZN-T	1	TE-6410W-1000	MSTAT, NI, BOX, JACK
Panel Devices:			
EN-HVU-7	1	AS-UNT111-101	UNT111 MTD IN UPM, W/50VA
	1	EN-EXP101-0	UNIV PRG MOD, CVR & BACKBN
EP-1	1	EP-8000-2	XDUCR, EP, 0/10V, HI VOL
EP-2	1	V11HGA-100	3-W SOLENOID, W/OV, 24 VAC
PI-1,2	2	G-2010-11	GAGE, 2", 0-30 PSIG, STEM
RLY-1	1	AS-RLY002-0	RELAY; 2SPDT 5 AMP 240VAC

SMOKE DETECTORS SUPPLIED BY DIVISION 16 MOUNTED AND WIRED TO FANS & SMOKE DAMPERS BY JCI

SUPPLY FAN WIRING DIAGRAM

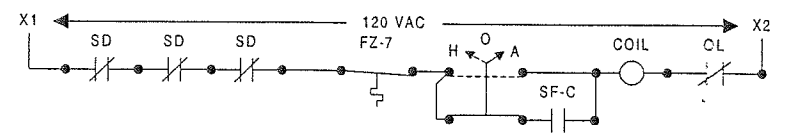

VENT FAN VF-7 DIAGRAM

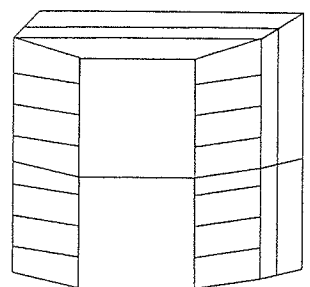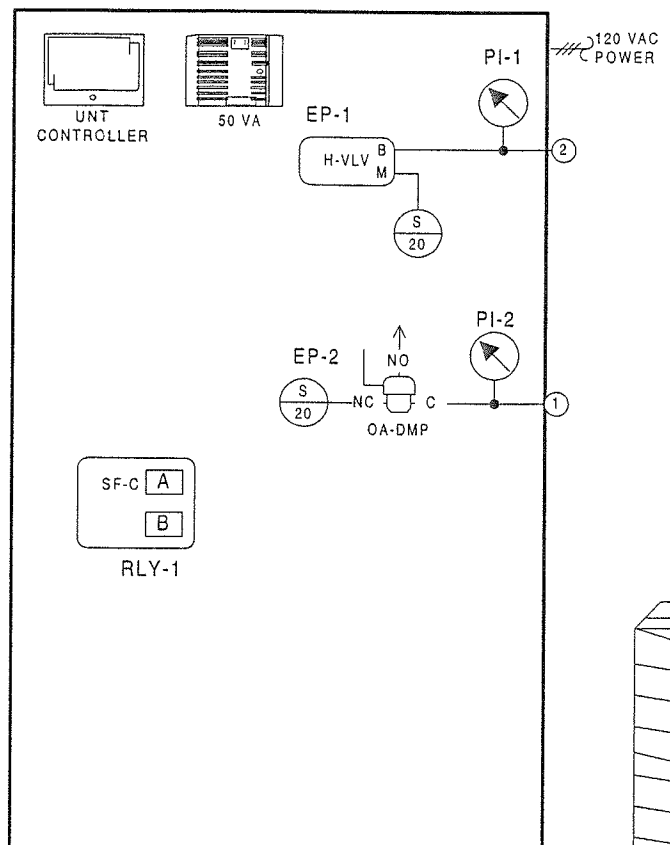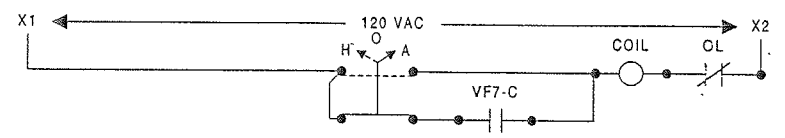

ENCLOSURE EN-HVU-7
AS-UNT111-101
LOCATED ADJACENT TO UNIT
NCM-5/N2 ADD = 17

FAN	LOCATION	ELEC PANEL	STARTER	LOCATION
HVU-7	SERVICE LEVEL		LOCAL	SERVICE LEVEL
VF-7	M CONCOURSE		LOCAL	M CONCOURSE

DESCRIPTION OF OPERATION

THE METASYS SYSTEM WILL DETERMINE THE "OCCUPIED AND UNOCCUPIED" MODES OF OPERATION. OCCUPIED MODES GENERALLY OCCUR DURING STADIUM EVENTS, BUT MANUAL OVERRIDE THROUGH THE METASYS SYSTEM ON SELECTED UNITS WILL FREQUENTLY BE REQUIRED. WHEN THE UNIT AND VENTILATION FAN ARE DE-ENERGIZED, OUTSIDE AIR DAMPER D-7-1, WILL CLOSE. UNOCCUPIED RETURN AIR DAMPER D-7-2 WILL BE OPEN AND HEATING COIL VALVE V-H-7 WILL BE CLOSED TO THE COIL.

WARM-UP MODE - SUPPLY FAN WILL START AS DETERMINED BY THE OPTIMAL START PROGRAM OF THE METASYS SYSTEM. ON THE START OF THE UNIT, HEATING COIL VALVE V-H-7 WILL OPEN FULL TO COIL AND RETURN AIR DAMPER D-7-2 WILL BE FULLY OPEN WITH THE OUTSIDE AIR DAMPER D-7-1 CLOSED. VENTILATION FAN VF-7 WILL BE OFF DURING THE WARM-UP MODE. DURATION OF THE WARM-UP MODE IS DETERMINED BY THE METASYS SYSTEM AND WILL BE DYNAMICALLY UPDATED TO END FIFTEEN (15) MINUTES PRIOR TO OCCUPANCY TIME. WARM-UP MODE IS STOPPED WHEN THE ZONE AIR TEMPERATURE REACHES THE SETTING OF TR-7 (70F).

OCCUPIED HEATING MODE - SUPPLY FAN WILL BE RUNNING, RETURN AIR DAMPER D-7-2 WILL CLOSE. OUTSIDE AIR DAMPER D-7-1 WILL OPEN AND VENTILATION FAN VF-7 WILL START AND RUN CONTINUOUSLY AFTER THE WARM-UP MODE IS STOPPED. RETURN AIR DAMPER D-7-2 WILL CLOSE. ROOM SENSOR TR-7 THROUGH THE METASYS SYSTEM CONTROL UNIT, WILL ON A RISE IN TEMPERATURE ABOVE ITS SETTING OF SEVENTY-FIVE (75F) MODULATE V-H-7 CLOSED TO THE HEATING COIL. ON A FALL IN TEMPERATURE, THIS CYCLE IS REVERSED.

UNOCCUPIED HEATING MODE - ROOM SENSOR TR-7, WILL ON A FALL IN TEMPERATURE TO ITS SETTING OF FIFTY (50F). ACTIVATE THE SYSTEM TO RUN IN THE WARM-UP MODE AS HEREINBEFORE DESCRIBED. ON A RISE IN TEMPERATURE TO FIFTY-FIVE (55F), THE SYSTEM WILL BE DE-ENERGIZED. IN THE UNOCCUPIED MODE ALL AIR HANDLING UNIT DAMPERS AND CONTROLS WILL RETURN TO THEIR NORMAL POSITION READY FOR RESTARTING.


OCCUPIED VENTILATING MODE - SUPPLY AND VENTILATION FANS START AND RUN CONTINUOUSLY. OUTSIDE AIR DAMPER D-7-1 WILL OPEN AND RETURN AIR DAMPER D-7-2 WILL CLOSE. HEATING COIL VALVE V-H-7 WILL BE CLOSED TO THE COIL.

UNOCCUPIED VENTILATING MODE - SYSTEM IS DE-ENERGIZED AND FANS ARE OFF.

SMOKE CONTROL - SMOKE DETECTORS WILL, ON THE DETECTION OF PRODUCTS OF COMBUSTION, SHUT DOWN THE SUPPLY AND EXHAUST FANS AND CLOSE ALL SYSTEM DAMPERS.

REVISION INFORMATION NUMBER: _____ DATE: 07/18/00 TIME: 03:32 PM FILE NAME: HVU-7.vsd	IN CONSIDERATION OF THE RECEIPT OF THIS DOCUMENT, THE RECIPIENT AGREES NOT TO REPRODUCE, COPY, USE OR TRANSMIT THIS DOCUMENT AND/OR THE INFORMATION THEREIN CONTAINED, IN WHOLE OR IN PART, OR TO SUFFER SUCH ACTION BY OTHERS, FOR ANY PURPOSE, EXCEPT WITH THE WRITTEN PERMISSION OF JOHNSON CONTROLS, INC. AND FURTHER AGREES TO SURRENDER SAME TO JOHNSON CONTROLS, INC. UPON DEMAND. COPYRIGHT JOHNSON CONTROLS, INC. 1998	DRAWING TITLE HEAT-VENT UNIT HVU-7 SHOP WEST SERVICE LEVEL QUAD B BALTIMORE NFL STADIUM AT CAMDEN YARDS BALTIMORE, MARYLAND	<table border="1"> <tr> <td>AS-BUILT</td> <td>7/18/00</td> <td>CME</td> </tr> <tr> <td>REFERENCE DRAWING NO.</td> <td>REVISION-LOCATION</td> <td>EGN DATE BY</td> </tr> <tr> <td>Sales Engineer JDP</td> <td>Project Manager WJT</td> <td>Application Engineer RTS</td> </tr> <tr> <td colspan="2">DRAWN BY RTS DATE 09/05/97</td> <td>APPROVED BY DATE</td> </tr> </table>	AS-BUILT	7/18/00	CME	REFERENCE DRAWING NO.	REVISION-LOCATION	EGN DATE BY	Sales Engineer JDP	Project Manager WJT	Application Engineer RTS	DRAWN BY RTS DATE 09/05/97		APPROVED BY DATE
AS-BUILT	7/18/00	CME													
REFERENCE DRAWING NO.	REVISION-LOCATION	EGN DATE BY													
Sales Engineer JDP	Project Manager WJT	Application Engineer RTS													
DRAWN BY RTS DATE 09/05/97		APPROVED BY DATE													
		JOHNSON CONTROLS Systems & Services Division	JOHNSON CONTROLS 60 LOVETON CIRCLE SPARKS, MD 21152 7052-0098 DRAWING NUMBER BL-6559-35												

Full Spreadsheet		Software				Digital Controller Information						Panel Information				Intermediate Device				Field Device				Ref Detail	Comment		
Tag	Point Type	System Name	Object Name	Expanded ID	Display Units	DC Type	N2 Trunk	N2 Addr	Destination Bay/Terminal	Module Type	Termination	Panel	Panel Location	Slot Number	Reference Drawing	Cable Number	Wiring/Tubing	Termination In	Device	Termination Out	Location	Wiring/Tubing	Terminations	Device	Location	Ref Detail	Comment
		HVU-7				UNT						EN-HVU-7	Service Level B		M.2-01B												Power to Controller
		HVU-7				UNT		17				EN-HVU-7	Service Level B		0.M.2-01B												N2 Trunk
AI-1		HVU-7				UNT		17	AI-1			EN-HVU-7	Service Level B		0.M.2-01B	HVU-7-17-AI-1											
AI-2		HVU-7				UNT		17	AI-2			EN-HVU-7	Service Level B		0.M.2-01B	HVU-7-17-AI-2											
AI-3		HVU-7				UNT		17	AI-3			EN-HVU-7	Service Level B		0.M.2-01B	HVU-7-17-AI-3											
AI-4		HVU-7	ZN-T	Zone Temperature	Deg F	UNT		17	AI-4		PHONE JACK	EN-HVU-7	Service Level B		0.M.2-01B	HVU-7-17-AI-4					8/26	PHONE JACK	TE-6410W-1000		U2		
AI-5		HVU-7				UNT		17	AI-5			EN-HVU-7	Service Level B		0.M.2-01B	HVU-7-17-AI-5											
AI-6		HVU-7				UNT		17	AI-6			EN-HVU-7	Service Level B		0.M.2-01B	HVU-7-17-AI-6											
BI-1		HVU-7	SF-S	Supply Fan Status	Off On	UNT		17	BI-1		BI# 24VAC	EN-HVU-7	Service Level B		0.M.2-01B	HVU-7-17-BI-1					2/22	Device dependent	Aux Contact (NO)		U70		
BI-2		HVU-7	VF7-S	Vent Fan 7 Status	Off On	UNT		17	BI-2		BI# 24VAC	EN-HVU-7	Service Level B		0.M.2-01B	HVU-7-17-BI-2					2/22	Device dependent	Aux Contact (NO)		U70		
BI-3		HVU-7	SMK-DET	Smoke Detectors	Normal Alarm	UNT		17	BI-3		BI# 24VAC	EN-HVU-7	Service Level B		0.M.2-01B	HVU-7-17-BI-3					2/22	Device dependent	Contact (NO)		U70		
BI-4		HVU-7	LT-S	Low Temperature Stat	Normal Alarm	UNT		17	BI-4		BI# 24VAC	EN-HVU-7	Service Level B		0.M.2-01B	HVU-7-17-BI-4					2/22	NO.M1	A70 (NC)		U71		
BC-1		HVU-7	SF-C	Supply Fan Control	Off On	UNT		17	BC-1		RLY	BO# 24V.COM	EN-HVU-7	Service Level B		0.M.2-01B	HVU-7-17-BO-1	3/18	A.COILS.COM	RELAY-A	NO.COM		2/14	See starter detail	Starter (NO)-(sw lo)	U60	
BC-2		HVU-7	OA-DMP	Outside Air Damper	Closed Open	UNT		17	BC-2		BO# 24VAC	EN-HVU-7	Service Level B		0.M.2-01B	HVU-7-17-BO-2					2/18	Device dependent	24VAC OUT (sw lo)		U51		
BC-3		HVU-7	VF7-C	Vent Fan 7 Control	Off On	UNT		17	BC-3		BO# 24VAC	EN-HVU-7	Service Level B		0.M.2-01B	HVU-7-17-BO-3					2/18	Device dependent	24VAC OUT (sw lo)		U51		
BC-4		HVU-7				UNT		17	BC-4			EN-HVU-7	Service Level B		0.M.2-01B	HVU-7-17-BO-4											
BC-5		HVU-7				UNT		17	BC-5			EN-HVU-7	Service Level B		0.M.2-01B	HVU-7-17-BO-5											
BC-6		HVU-7				UNT		17	BC-6			EN-HVU-7	Service Level B		0.M.2-01B	HVU-7-17-BO-6											
AC-1		HVU-7	H-VL.V	Heating Coil Valve	% Open	UNT		17	AC-1		AO# AOCM.24V	EN-HVU-7	Service Level B		0.M.2-01B	HVU-7-17-AO-1	2/18	+-	EP-8000-2	SUPPLY, O		3/18	Device dependent	0-10V OUT		U23	
AC-2		HVU-7				UNT		17	AC-2			EN-HVU-7	Service Level B		0.M.2-01B	HVU-7-17-AO-2											

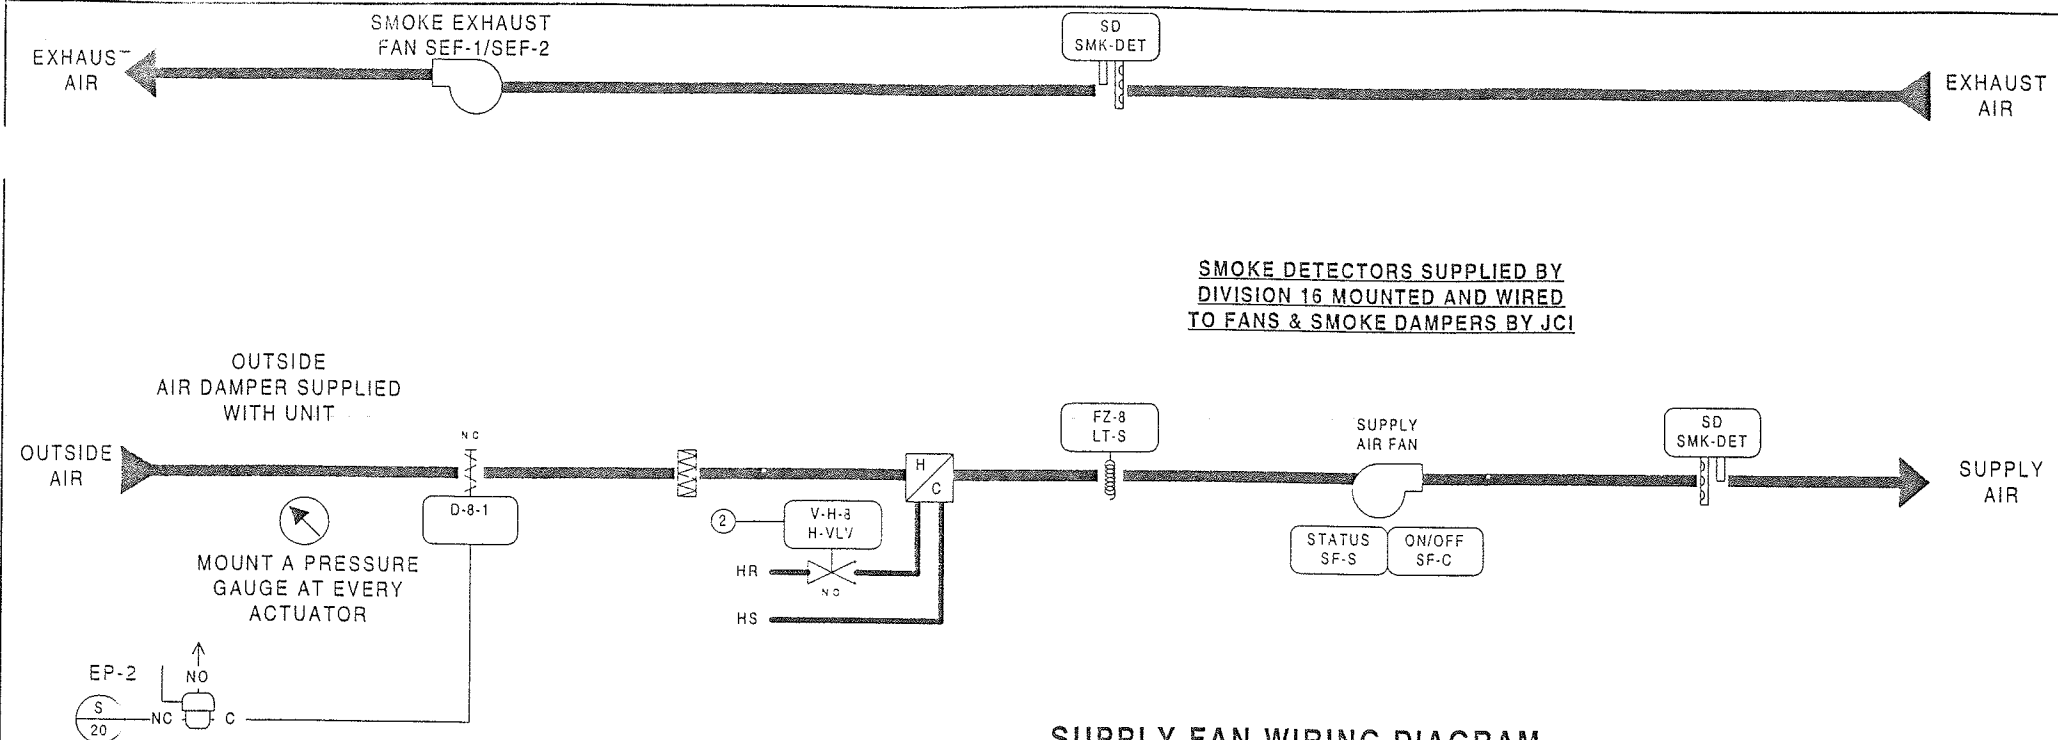

BILL OF MATERIALS

Estimate: hvu-8
Desig. QTY Part # Description


Field Devices:

D-8-1	1	D-3153-2	DMPR ACT, 8-13#
	1	G-2010-11	GAGE, 2", 0-30 PSIG, STEM
EP-2	1	V11HAA-100	3-W SOLENOID, W/OV, 120VAC
FZ-8	1	A70HA-1C	STAT, LL, 20', EL, MAN, 15/55F
H-VLV	1	--	SEE VALVE SCHEDULE
ZN-T	1	TE-6410W-1000	MSTAT, NI, BCK, JACK


Panel Devices:

EN-HVU-8	1	AS-UNT111-101	UNT111 MTD IN UPM, W/50VA
	1	EN-EXP101-0	UNIV PKG MOD, CVR & BACKBN
EP-1	1	EP-8000-2	XDUCR, EP, 0/10V, HI VOL
PI-1	1	G-2010-11	GAGE, 2", 0-30 PSIG, STEM
RLY-1	1	AS-RLY002-0	RELAY; 2SPDT 5 AMP 240VAC


SUPPLY FAN WIRING DIAGRAM

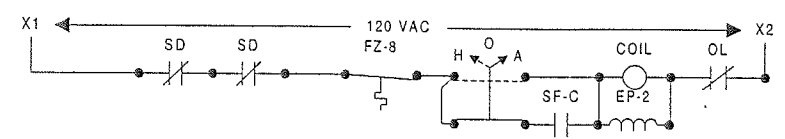

SMOKE EXHAUST FAN SEF-1 DIAGRAM

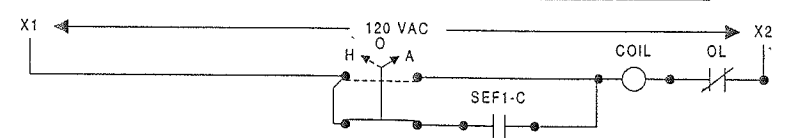

SMOKE EXHAUST FAN SEF-2 DIAGRAM

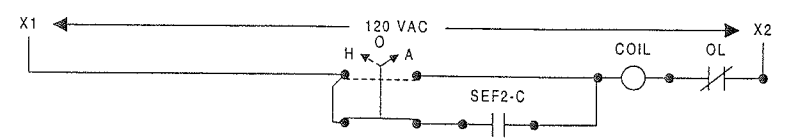

DESCRIPTION OF OPERATION

STARTING OF THE HVU SUPPLY FAN WILL INITIATE A START OF THE LEAD SMOKE EXHAUST FAN SEF-1 OR SEF-2. IF THE LEAD FAN FAILS OR FAILS TO START, THE LAG EXHAUST FAN SEF-1 OR SEF-2 WILL START AND RUN CONTINUOUSLY.

THE METASYS SYSTEM WILL DETERMINE THE "OCCUPIED AND UNOCCUPIED" MODES OF OPERATION. OCCUPIED MODES GENERALLY OCCUR DURING STADIUM EVENTS, BUT MANUAL OVERRIDE THROUGH THE METASYS SYSTEM ON SELECTED UNITS WILL FREQUENTLY BE REQUIRED. WHEN THE UNIT AND SMOKE EXHAUST FAN ARE DE-ENERGIZED, OUTSIDE AIR DAMPER D-8-1, WILL CLOSE. HEATING COIL VALVE V-H-8 WILL BE CLOSED TO THE COIL.



OCCUPIED HEATING MODE - SUPPLY FAN WILL BE RUNNING. OUTSIDE AIR DAMPER D-8-1 WILL OPEN. ROOM SENSOR TR-8 THROUGH THE METASYS SYSTEM CONTROL UNIT, WILL ON A RISE IN TEMPERATURE ABOVE ITS SETTING OF SEVENTY-FIVE (75F) MODULATE V-H-8 CLOSED TO THE HEATING COIL. ON A FALL IN TEMPERATURE, THIS CYCLE IS REVERSED.

UNOCCUPIED HEATING MODE - ROOM SENSOR TR-8, WILL ON A FALL IN TEMPERATURE TO ITS SETTING OF FIFTY (50F). ACTIVATE THE SYSTEM TO RUN IN THE HEATING MODE AS HEREINBEFORE DESCRIBED. ON A RISE IN TEMPERATURE TO FIFTY-FIVE (55F), THE SYSTEM WILL BE DE-ENERGIZED. IN THE UNOCCUPIED MODE ALL AIR HANDLING UNIT DAMPERS AND CONTROLS WILL RETURN TO THEIR NORMAL POSITION READY FOR RESTARTING.

OCCUPIED VENTILATING MODE - SUPPLY AND SMOKE EXHAUST FANS START AND RUN CONTINUOUSLY. OUTSIDE AIR DAMPER D-8-1 WILL OPEN. HEATING COIL VALVE V-H-8 WILL BE CLOSED TO THE COIL.

UNOCCUPIED VENTILATING MODE - SYSTEM IS DE-ENERGIZED AND FANS ARE OFF.

SMOKE CONTROL - SMOKE DETECTORS FOR HVU-8 WILL, ON THE DETECTION OF PRODUCTS OF COMBUSTION, SHUT DOWN THE SUPPLY AND CLOSE OUTSIDE DAMPER D-8-1. CROSS ZONED CEILING SMOKE DETECTORS IN THE SERVICE CORRIDOR OR A SPRINKLER WATER FLOW ALARM ON THE SERVICE LEVEL WILL ENERGIZE THE TWO (2) SMOKE EXHAUST FANS THROUGH THE FIRE ALARM SYSTEM. HVU-8, HVU-9 AND HVU-10 SERVICE THE AREA WILL BE DE-ENERGIZED AND ALL THEIR DAMPERS WILL RETURN TO THEIR NORMALLY CLOSED POSITION WHEN THE SMOKE EXHAUST IS ENERGIZED BY THE FIRE ALARM SYSTEM. SERVICE LEVEL SMOKE EXHAUST FANS WILL BE AUTOMATICALLY AND MANUALLY STARTED AND STOPPED FROM THE FIRE ALARM SYSTEM. FIRE ALARM SYSTEM CONTROL IS INDEPENDENT OF THE METASYS SYSTEM. TWO (2) SERVICE LEVEL EXIT CORRIDOR SMOKE EXHAUST SYSTEMS EXIST WITH A TOTAL OF FOUR (4) EXHAUST FANS. TWO (2) SMOKE EXHAUST FANS ARE RELATED TO THREE (3) HEATING AND VENTILATING UNITS. IF EITHER EXIT CORRIDOR SMOKE EXHAUST SYSTEM IS ACTIVATED, THE OTHER SYSTEM WILL ALSO BE ENERGIZED. FIRE ALARM SYSTEM CONTROL IS INDEPENDENT OF THE METASYS SYSTEM.

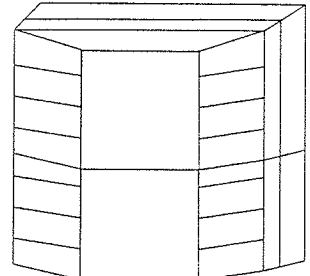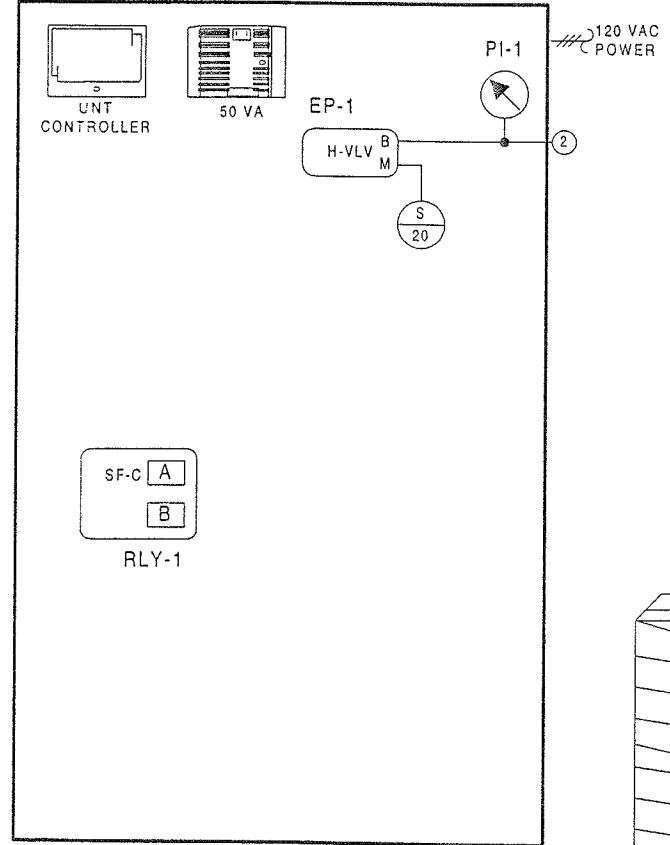


ENCLOSURE EN-HVU-8
AS-UNT111-101
LOCATED ADJACENT
TO UNIT
NCM-5/N2 ADD = 18

FAN	LOCATION	ELEC PANEL	STARTER	LOCATION
HVU-8	SERVICE LEVEL		LOCAL	SERVICE LEVEL
SEF-1	SERVICE LEVEL		LOCAL	SERVICE LEVEL
SEF-2	SERVICE LEVEL		LOCAL	SERVICE LEVEL

NOTE: FOR SMOKE EXHAUST FANS SEF-1 AND SEF-2
METASYS POINT CONNECTIONS SEE
AHU-19 CONTROL DIAGRAM BL-6559-25
POINT LIST NCM-5 PS-10

REVISION INFORMATION	<p>IN CONSIDERATION OF THE RECEIPT OF THIS DOCUMENT, THE RECIPIENT AGREES NOT TO REPRODUCE, COPY, USE OR TRANSMIT THIS DOCUMENT AND/OR THE INFORMATION THEREIN CONTAINED, IN WHOLE OR IN PART, OR TO SUFFER SUCH ACTION BY OTHERS, FOR ANY PURPOSE, EXCEPT WITH THE WRITTEN PERMISSION OF JOHNSON CONTROLS, INC. AND FURTHER AGREES TO SURRENDER SAME TO JOHNSON CONTROLS, INC. UPON DEMAND.</p> <p>DATE: 07/18/00 TIME: 03:32 PM FILE NAME: HVU-8.vsd</p> <p>Copyright Johnson Controls, Inc. 19nn</p>	DRAWING TITLE	<p>HEAT-VENT UNIT HVU-8 FREIGHT ELEVATOR LOBBY</p>				
NUMBER		AS-BUILT	7/18/00 CME				
DATE		REFERENCE DRAWING	NO.	REVISION-LOCATION	ECN	DATE	BY
TIME		JDP	WJT	RTS	BY RTS	DATE 09/05/97	BY
FILE NAME	PROJECT TITLE	<p>BALTIMORE NFL STADIUM AT CAMDEN YARDS</p>		<p>JOHNSON CONTROLS 60 LOVETON CIRCLE SPARKS, MD 21152</p>		<p>CONTRACT NUMBER 7052-0098</p>	
	BALTIMORE, MARYLAND	<p>Systems & Services Division</p>		<p>BL-6559-36</p>			

Full Spreadsheet		Software				Digital Controller Information					Panel Information				Intermediate Device				Field Device								
Tag	Point Type	System Name	Object Name	Expanded ID	Display Units	DC Type	N2 Trunk	N2 Addr	Cable Destination Bay/Terminal	Module Type	Termination	Panel	Panel Location	Slot Number	Reference Drawing	Cable Number	Wiring/Tubing	Termination In	Device	Termination Out	Location	Wiring/Tubing	Terminations	Device	Location	Ref Detail	Comment
		HVU-8				UNT						EN-HVU-8	Service Level A		M.2-01A												Power to Controller
		HVU-8				UNT	1	18				EN-HVU-8	Service Level A		01M.2-01A												N2 Trunk
A1-1		HVU-8				UNT	1	18	AI-1			EN-HVU-8	Service Level A		01M.2-01A	HVU-8-18-AI-1											
A1-2		HVU-8				UNT	1	18	AI-2			EN-HVU-8	Service Level A		01M.2-01A	HVU-8-18-AI-2											
A1-3		HVU-8				UNT	1	18	AI-3			EN-HVU-8	Service Level A		01M.2-01A	HVU-8-18-AI-3											
A1-4		HVU-8	ZN-T	Zone Temperature	Deg F	UNT	1	18	AI-4		PHONE JACK	EN-HVU-8	Service Level A		01M.2-01A	HVU-8-18-AI-4					8/26	PHONE JACK	TE-6410W-1000		U2		
A1-5		HVU-8				UNT	1	18	AI-5			EN-HVU-8	Service Level A		01M.2-01A	HVU-8-18-AI-5											
A1-6		HVU-8				UNT	1	18	AI-6			EN-HVU-8	Service Level A		01M.2-01A	HVU-8-18-AI-6											
B1-1		HVU-8	SF-S	Supply Fan Status	Off : On	UNT	1	18	BI-1		BI# 24VAC	EN-HVU-8	Service Level A		01M.2-01A	HVU-8-18-BI-1					2/22	Device dependent	Aux Contact (NO)		U70		
B1-2		HVU-8	SMK-DET	Smoke Detectors	Normal: Alarm	UNT	1	18	BI-2		BI# 24VAC	EN-HVU-8	Service Level A		01M.2-01A	HVU-8-18-BI-2					2/22	Device dependent	Contact (NO)		U70		
B1-3		HVU-8	LT-S	Low Temperature Stat	Normal: Alarm	UNT	1	18	BI-3		BI# 24VAC	EN-HVU-8	Service Level A		01M.2-01A	HVU-8-18-BI-3					2/22	NO,M1	A70 (NC)		U71		
B1-4		HVU-8				UNT	1	18	BI-4			EN-HVU-8	Service Level A		01M.2-01A	HVU-8-18-BI-4											
B1-1		HVU-8	SF-C	Supply Fan Control	Off : On	UNT	1	18	BO-1	RLY	BO# 24V.COM	EN-HVU-8	Service Level A		01M.2-01A	HVU-8-18-BO-1	3/18	A.COILS.COM	RELAY-A	NO.COM		2/14	See starter detail	Starter (NO)-(sw lo)		U60	
B1-2		HVU-8				UNT	1	18	BO-2			EN-HVU-8	Service Level A		01M.2-01A	HVU-8-18-BO-2											
B1-3		HVU-8				UNT	1	18	BO-3			EN-HVU-8	Service Level A		01M.2-01A	HVU-8-18-BO-3											
B1-4		HVU-8				UNT	1	18	BO-4			EN-HVU-8	Service Level A		01M.2-01A	HVU-8-18-BO-4											
B1-5		HVU-8				UNT	1	18	BO-5			EN-HVU-8	Service Level A		01M.2-01A	HVU-8-18-BO-5											
B1-6		HVU-8				UNT	1	18	BO-6			EN-HVU-8	Service Level A		01M.2-01A	HVU-8-18-BO-6											
A1-1		HVU-8	H-VLV	Heating Coil Valve	% Open	UNT	1	18	AO-1		AO#,AOCM,24V	EN-HVU-8	Service Level A		01M.2-01A	HVU-8-18-AO-1	2/18	+	EP-8000-2	SUPPLY_O		3/18	Device dependent	0-10V OUT		U23	
A1-2		HVU-8				UNT	1	18	AO-2			EN-HVU-8	Service Level A		01M.2-01A	HVU-8-18-AO-2											

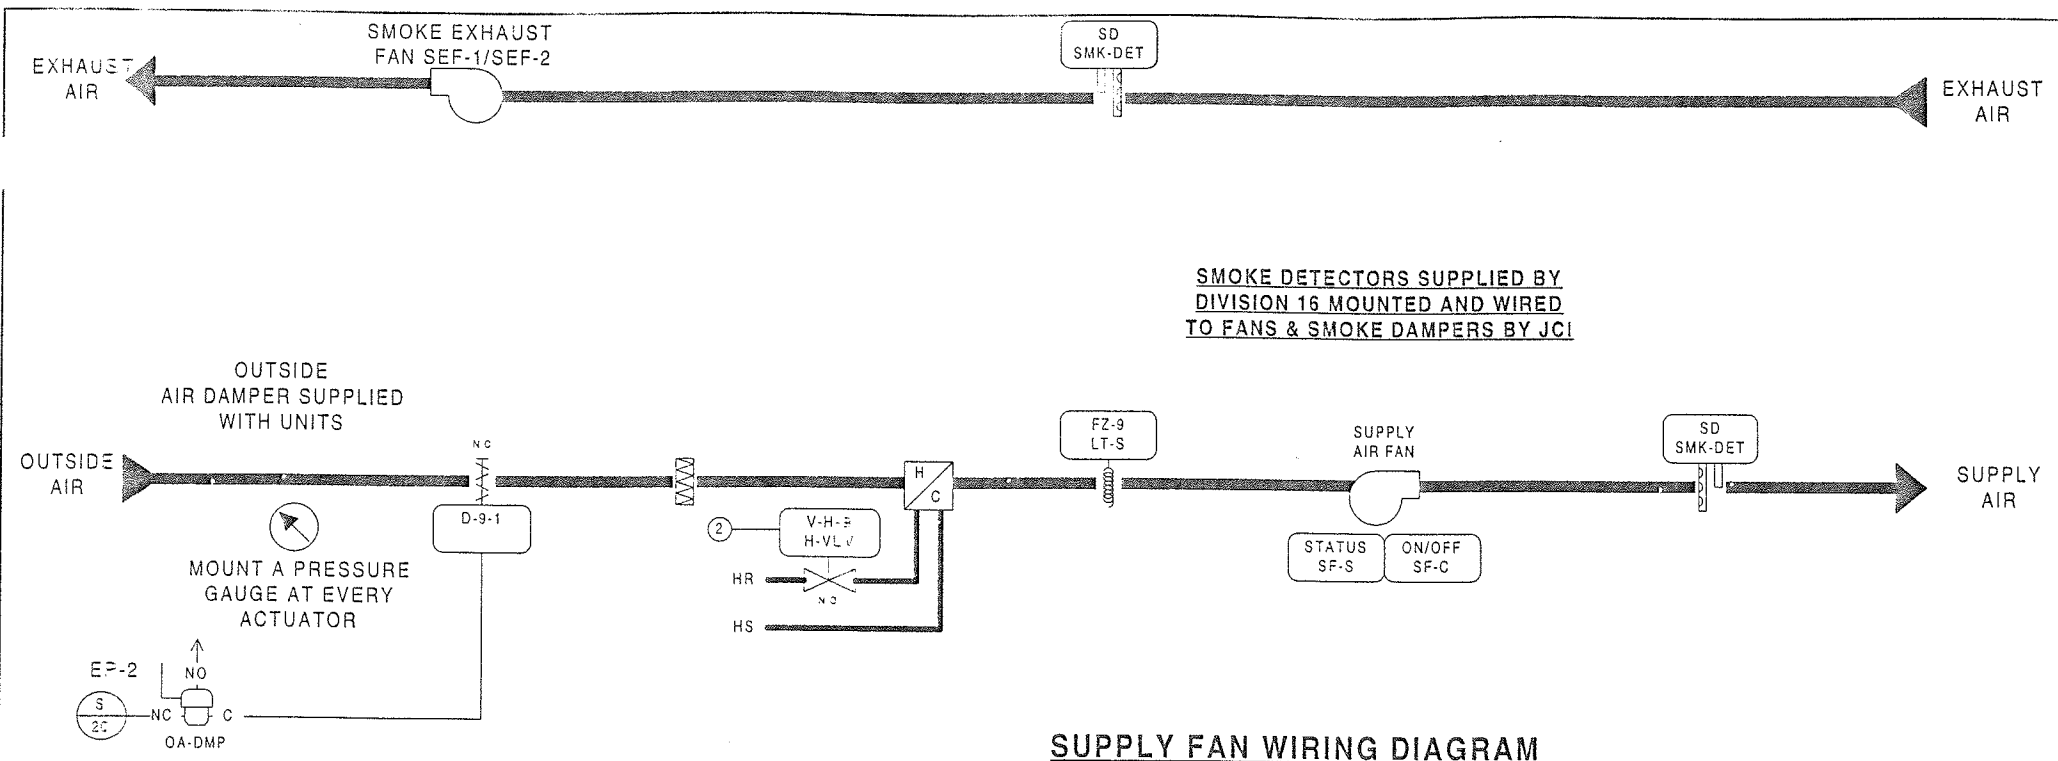


SMOKE DETECTORS SUPPLIED BY DIVISION 16 MOUNTED AND WIRED TO FANS & SMOKE DAMPERS BY JCI

BILL OF MATERIALS


Estimate: hvu-9 70520098.pre

Desig.	Qty	Part #	Description
Field Devices:			
D-9-1	1	D-3153-2	DMPR ACT, 8-13#
	1	G-2010-11	GAGE, 2", 0-30 PSIG, STEM
EP-2	1	V11HAA-100	3-W SOLENOID, W/OV, 120VAC
FZ-9	1	A70HA-1C	STAT, LL, 20", EL, MAN, 15/55F
H-VLV	1	--	SEE VALVE SCHEDULE
ZN-T	1	TE-6410W-1000	MSTAT, NI, BOX, JACK
Panel Devices:			
EN-HVU-9	1	AS-UNT111-101	UNT111 MTD IN UPM. W/50VA
	1	EN-EXP101-0	UNIV PKG MOD, CVR & BACKBN
EP-1	1	EP-8000-2	XDUCR, EP, 0/10V, HI VOL
PI-1	1	G-2010-11	GAGE, 2", 0-30 PSIG, STEM
RLY-1	1	AS-RLY002-0	RELAY; 2SPDT 5 AMP 240VAC


SUPPLY FAN WIRING DIAGRAM

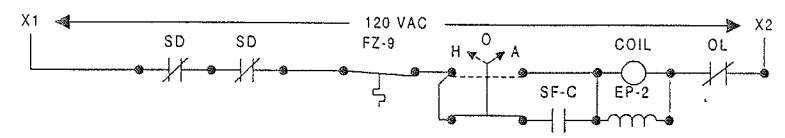

SMOKE EXHAUST FAN SEF-1 DIAGRAM

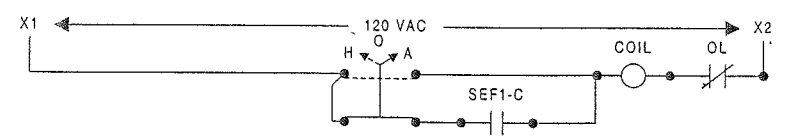

SMOKE EXHAUST FAN SEF-2 DIAGRAM

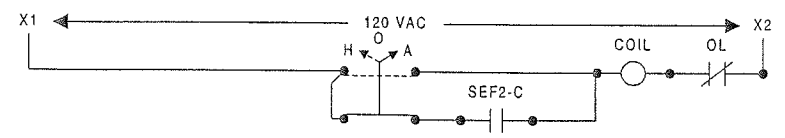

FAN	LOCATION	ELEC PANEL	STARTER	LOCATION
HVU-9	SERVICE LEVEL	MCC1SRA	5F	SERVICE LEVEL
SEF-1	SERVICE LEVEL		LOCAL	SERVICE LEVEL
SEF-2	SERVICE LEVEL		LOCAL	SERVICE LEVEL

NOTE: FOR SMOKE EXHAUST FANS SEF-1 AND SEF-2 METASYS POINT CONNECTIONS SEE AHU-19 CONTROL DIAGRAM BL-6559-25 POINT LIST NCM-5 PS-10

DESCRIPTION OF OPERATION

STARTING OF THE HVU SUPPLY FAN WILL INITIATE A START OF THE LEAD SMOKE EXHAUST FAN SEF-1 OR SEF-2. IF THE LEAD FAN FAILS OR FAILS TO START, THE LAG EXHAUST FAN SEF-1 OR SEF-2 WILL START AND RUN CONTINUOUSLY.

THE METASYS SYSTEM WILL DETERMINE THE "OCCUPIED AND UNOCCUPIED" MODES OF OPERATION. OCCUPIED MODES GENERALLY OCCUR DURING STADIUM EVENTS, BUT MANUAL OVERRIDE THROUGH THE METASYS SYSTEM ON SELECTED UNITS WILL FREQUENTLY BE REQUIRED. WHEN THE UNIT AND SMOKE EXHAUST FAN ARE DE-ENERGIZED, OUTSIDE AIR DAMPER D-9-1, WILL CLOSE. HEATING COIL VALVE V-H-9 WILL BE CLOSED TO THE COIL.



OCCUPIED HEATING MODE - SUPPLY FAN WILL BE RUNNING. OUTSIDE AIR DAMPER D-9-1 WILL OPEN. ROOM SENSOR TR-9 THROUGH THE METASYS SYSTEM CONTROL UNIT, WILL ON A RISE IN TEMPERATURE ABOVE ITS SETTING OF SEVENTY-FIVE (75F) MODULATE V-H-9 CLOSED TO THE HEATING COIL. ON A FALL IN TEMPERATURE, THIS CYCLE IS REVERSED.

UNOCCUPIED HEATING MODE - ROOM SENSOR TR-9, WILL ON A FALL IN TEMPERATURE TO ITS SETTING OF FIFTY (50F). ACTIVATE THE SYSTEM TO RUN IN THE HEATING MODE AS HEREINBEFORE DESCRIBED. ON A RISE IN TEMPERATURE TO FIFTY-FIVE (55F), THE SYSTEM WILL BE DE-ENERGIZED. IN THE UNOCCUPIED MODE ALL AIR HANDLING UNIT DAMPERS AND CONTROLS WILL RETURN TO THEIR NORMAL POSITION READY FOR RESTARTING.

OCCUPIED VENTILATING MODE - SUPPLY AND SMOKE EXHAUST FANS START AND RUN CONTINUOUSLY. OUTSIDE AIR DAMPER D-9-1 WILL OPEN. HEATING COIL VALVE V-H-9 WILL BE CLOSED TO THE COIL.

UNOCCUPIED VENTILATING MODE - SYSTEM IS DE-ENERGIZED AND FANS ARE OFF.


SMOKE CONTROL - SMOKE DETECTORS FOR HVU-9 WILL, ON THE DETECTION OF PRODUCTS OF COMBUSTION, SHUT DOWN THE SUPPLY AND CLOSE OUTSIDE DAMPER D-9-1. CROSS ZONED CEILING SMOKE DETECTORS IN THE SERVICE CORRIDOR OR A SPRINKLER WATER FLOW ALARM ON THE SERVICE LEVEL WILL ENERGIZE THE TWO (2) SMOKE EXHAUST FANS THROUGH THE FIRE ALARM SYSTEM. HVU-9, HVU-9 AND HVU-10 SERVICE THE AREA WILL BE DE-ENERGIZED AND ALL THEIR DAMPERS WILL RETURN TO THEIR NORMALLY CLOSED POSITION WHEN THE SMOKE EXHAUST IS ENERGIZED BY THE FIRE ALARM SYSTEM. SERVICE LEVEL SMOKE EXHAUST FANS WILL BE AUTOMATICALLY AND MANUALLY STARTED AND STOPPED FROM THE FIRE ALARM SYSTEM. FIRE ALARM SYSTEM CONTROL IS INDEPENDENT OF THE METASYS SYSTEM. TWO (2) SERVICE LEVEL EXIT CORRIDOR SMOKE EXHAUST SYSTEMS EXIST WITH A TOTAL OF FOUR (4) EXHAUST FANS. TWO (2) SMOKE EXHAUST FANS ARE RELATED TO THREE (3) HEATING AND VENTILATING UNITS. IF EITHER EXIT CORRIDOR SMOKE EXHAUST SYSTEM IS ACTIVATED, THE OTHER SYSTEM WILL ALSO BE ENERGIZED. FIRE ALARM SYSTEM CONTROL IS INDEPENDENT OF THE METASYS SYSTEM.

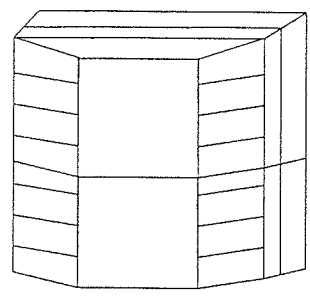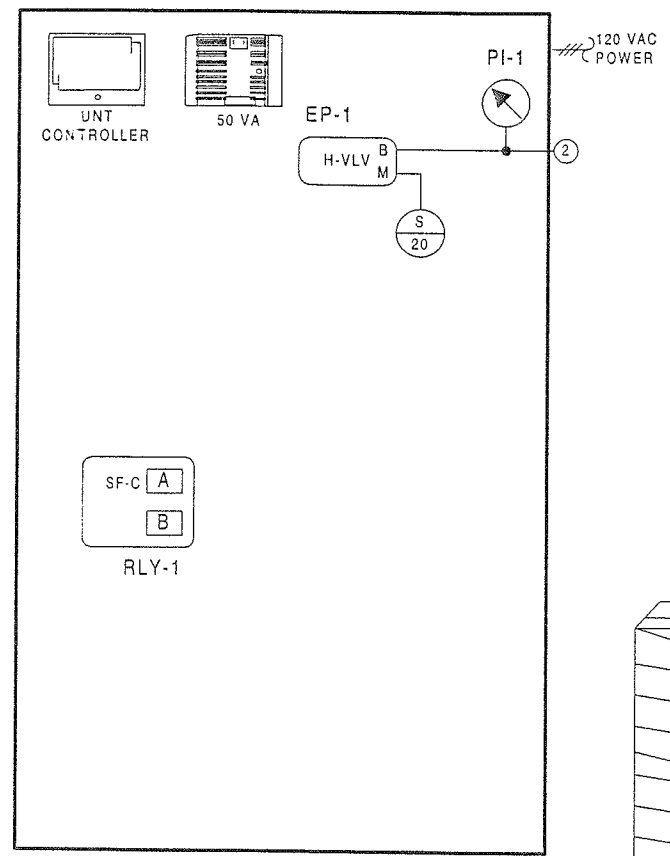

ENCLOSURE EN-HVU-9
AS-UNT111-101
LOCATED ADJACENT TO UNIT
NCM-5/N2 ADD = 19

REVISION INFORMATION NUMBER DATE 07/18/00 TIME 03:34 PM FILE NAME HVU-9.vsd	IN CONSIDERATION OF THE RECEIPT OF THIS DOCUMENT, THE RECIPIENT AGREES NOT TO REPRODUCE, COPY, USE OR TRANSMIT THIS DOCUMENT AND/OR THE INFORMATION THEREIN CONTAINED, IN WHOLE OR IN PART, OR TO SUFFER SUCH ACTION BY OTHERS, FOR ANY PURPOSE, EXCEPT WITH THE WRITTEN PERMISSION OF JOHNSON CONTROLS, INC. AND FURTHER AGREES TO SURRENDER SAME TO JOHNSON CONTROLS, INC. UPON DEMAND. COPYRIGHT JOHNSON CONTROLS, INC. 19nn	DRAWING TITLE HEAT-VENT UNIT HVU-9 SERVICE TUNNEL SERVICE LEVEL QUAD A PROJECT TITLE BALTIMORE NFL STADIUM AT CAMDEN YARDS BALTIMORE, MARYLAND	<table border="1"> <tr> <td>AS-BUILT</td> <td>7/18/00</td> <td>CME</td> </tr> <tr> <td>REFERENCE DRAWING</td> <td>NO.</td> <td>REVISION-LOCATION</td> </tr> <tr> <td>Sales Engineer JDP</td> <td>Project Manager WJT</td> <td>Application Engineer RTS</td> </tr> <tr> <td>BY: RTS</td> <td>DATE: 09/05/97</td> <td>BY: DATE</td> </tr> </table>	AS-BUILT	7/18/00	CME	REFERENCE DRAWING	NO.	REVISION-LOCATION	Sales Engineer JDP	Project Manager WJT	Application Engineer RTS	BY: RTS	DATE: 09/05/97	BY: DATE
AS-BUILT	7/18/00	CME													
REFERENCE DRAWING	NO.	REVISION-LOCATION													
Sales Engineer JDP	Project Manager WJT	Application Engineer RTS													
BY: RTS	DATE: 09/05/97	BY: DATE													
		Branch Information JOHNSON CONTROLS Systems & Services Division 60 LOVETON CIRCLE SPARKS, MD 21152	CONTRACT NUMBER 7052-0098 DRAWING NUMBER BL-6559-37												

Full Spreadsheet		Software				Digital Controller Information						Panel Information					Intermediate Device					Field Device					
Tag	Point Type	System Name	Object Name	Expanded ID	Display Units	DC Type	N2 Trunk	N2 Actr	Cable Destination Bay/Terminal	Module Type	Termination	Panel	Panel Location	Slot Number	Reference Drawing	Cable Number	Wiring/Tubing	Termination In	Device	Termination Out	Location	Wiring/Tubing	Terminations	Device	Location	Ref Detail	Comment
		HVU-9				UNT						EN-HVU-9	Service Level A		M.2-01A												Power to Controller
		HVU-9				UNT	1		19			EN-HVU-9	Service Level A		0IM.2-01A												N2 Trunk
	AI-1	HVU-9				UNT			19-AI-1			EN-HVU-9	Service Level A		0IM.2-01A	HVU-9-19-AI-1											
	AI-2	HVU-9				UNT			19-AI-2			EN-HVU-9	Service Level A		0IM.2-01A	HVU-9-19-AI-2											
	AI-3	HVU-9				UNT			19-AI-3			EN-HVU-9	Service Level A		0IM.2-01A	HVU-9-19-AI-3											
	AI-4	HVU-9	ZN-T	Zone Temperature	Deg F	UNT			19-AI-4		PHONE JACK	EN-HVU-9	Service Level A		0IM.2-01A	HVU-9-19-AI-4					8/26	PHONE JACK	TE-6410W-1000		U2		
	AI-5	HVU-9				UNT			19-AI-5			EN-HVU-9	Service Level A		0IM.2-01A	HVU-9-19-AI-5											
	AI-6	HVU-9				UNT			19-AI-6			EN-HVU-9	Service Level A		0IM.2-01A	HVU-9-19-AI-6											
	BI-1	HVU-9	SF-S	Supply Fan Status	Off On	UNT			19-BI-1		BI# 24VAC	EN-HVU-9	Service Level A		0IM.2-01A	HVU-9-19-BI-1					2/22	Device dependent	Aux Contact (NO)		U70		
	BI-2	HVU-9	SMK-DET	Smoke Detectors	Normal Alarm	UNT			19-BI-2		BI# 24VAC	EN-HVU-9	Service Level A		0IM.2-01A	HVU-9-19-BI-2					2/22	Device dependent	Contact (NO)		U70		
	BI-3	HVU-9	LT-S	Low Temperature Stat	Normal Alarm	UNT			19-BI-3		BI# 24VAC	EN-HVU-9	Service Level A		0IM.2-01A	HVU-9-19-BI-3					2/22	NO.M1	A70 (NC)		U71		
	BI-4	HVU-9				UNT			19-BI-4			EN-HVU-9	Service Level A		0IM.2-01A	HVU-9-19-BI-4											
	BO-1	HVU-9	SF-C	Supply Fan Control	Off On	UNT			19-BO-1		RLY BO# 24V.COM	EN-HVU-9	Service Level A		0IM.2-01A	HVU-9-19-BO-1	3/18	A.COILS.COM	RELAY-A	NO.COM		2/14	See starter detail	Starter (NO)-(sw lo)		U60	
	BO-2	HVU-9				UNT			19-BO-2			EN-HVU-9	Service Level A		0IM.2-01A	HVU-9-19-BO-2											
	BO-3	HVU-9				UNT			19-BO-3			EN-HVU-9	Service Level A		0IM.2-01A	HVU-9-19-BO-3											
	BO-4	HVU-9				UNT			19-BO-4			EN-HVU-9	Service Level A		0IM.2-01A	HVU-9-19-BO-4											
	BO-5	HVU-9				UNT			19-BO-5			EN-HVU-9	Service Level A		0IM.2-01A	HVU-9-19-BO-5											
	BO-6	HVU-9				UNT			19-BO-6			EN-HVU-9	Service Level A		0IM.2-01A	HVU-9-19-BO-6											
	AO-1	HVU-9	H-VLV	Heating Coil Valve	% Open	UNT			19-AO-1		AO# AOCM.24V	EN-HVU-9	Service Level A		0IM.2-01A	HVU-9-19-AO-1	2/18	+-	EP-8000-2	SUPPLY_O			Device dependent	0-10V OUT		U23	
	AO-2	HVU-9				UNT			19-AO-2			EN-HVU-9	Service Level A		0IM.2-01A	HVU-9-19-AO-2											

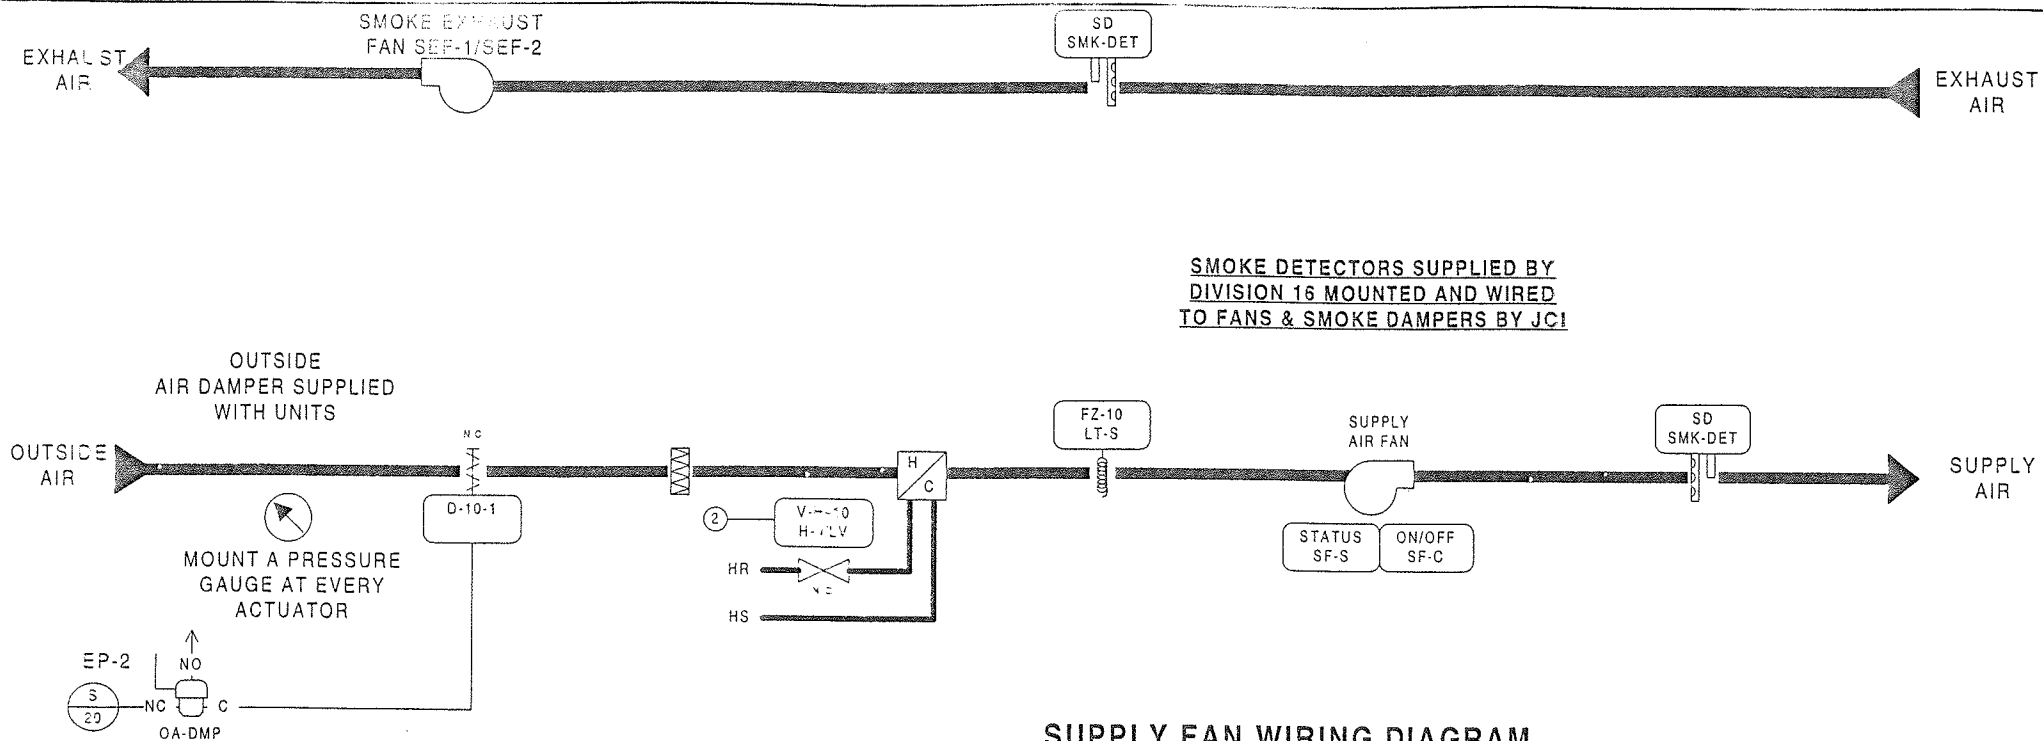

Estimate: hvu-10
Desig. QTY Part # Description

70520098.pre


Field Devices:

D-10-1	1	D-3153-2	DMPR ACT, 8-13#
EP-2	1	G-2010-11	GAGE, 2", 0-30 PSIG, STEM
FZ-10	1	V11HAA-100	3-W SOLENOID, W/OV, 120VAC
H-VLV	1	A70HA-1C	STAT, LL, 20', EL, MAN, 15/55F
ZN-T	1	--	SEE VALVE SCHEDULE
	1	TE-6410W-1000	MSTAT, NI, BOX, JACK


Panel Devices:

EN-HVU-10	1	AS-UNT111-101	UNT111 MTD IN UPM, W/50VA
	1	EN-EXP101-0	UNIV PKG MOD, CVR & BACKBN
EP-1	1	EP-8000-2	XDUCR, EP, 0/10V, HI VOL
PI-1	1	G-2010-11	GAGE, 2", 0-30 PSIG, STEM
RLY-1	1	AS-RLY002-0	RELAY; 2SPDT 5 AMP 240VAC


SUPPLY FAN WIRING DIAGRAM

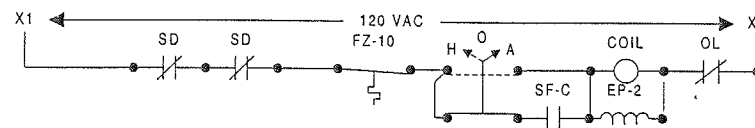

SMOKE EXHAUST FAN SEF-1 DIAGRAM

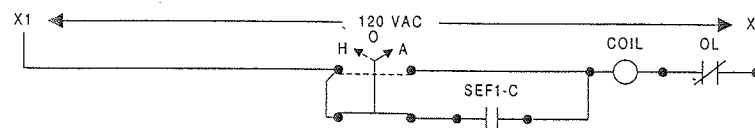

SMOKE EXHAUST FAN SEF-2 DIAGRAM

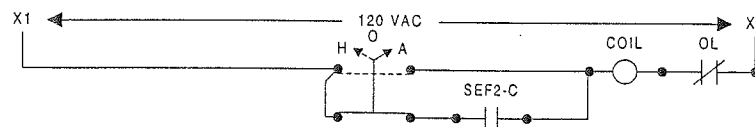

FAN	LOCATION	ELEC PANEL	STARTER	LOCATION
HVU-10	SERVICE LEVEL	MCC1SRA	9B	SERVICE LEVEL
SEF-1	SERVICE LEVEL		LOCAL	SERVICE LEVEL
SEF-2	SERVICE LEVEL		LOCAL	SERVICE LEVEL

NOTE: FOR SMOKE EXHAUST FANS SEF-1 AND SEF-2 METASYS POINT CONNECTIONS SEE AHU-19 CONTROL DIAGRAM BL-6559-25 POINT LIST NCM-5 PS-10

DESCRIPTION OF OPERATION

STARTING OF THE HVU SUPPLY FAN WILL INITIATE A START OF THE LEAD SMOKE EXHAUST FAN SEF-1 OR SEF-2. IF THE LEAD FAN FAILS OR FAILS TO START, THE LAG EXHAUST FAN SEF-1 OR SEF-2 WILL START AND RUN CONTINUOUSLY.

THE METASYS SYSTEM WILL DETERMINE THE "OCCUPIED AND UNOCCUPIED" MODES OF OPERATION. OCCUPIED MODES GENERALLY OCCUR DURING STADIUM EVENTS, BUT MANUAL OVERRIDE THROUGH THE METASYS SYSTEM ON SELECTED UNITS WILL FREQUENTLY BE REQUIRED. WHEN THE UNIT AND SMOKE EXHAUST FAN ARE DE-ENERGIZED, OUTSIDE AIR DAMPER D-10-1, WILL CLOSE. HEATING COIL VALVE V-H-10 WILL BE CLOSED TO THE COIL.



OCCUPIED HEATING MODE - SUPPLY FAN WILL BE RUNNING. OUTSIDE AIR DAMPER D-10-1 WILL OPEN. ROOM SENSOR TR-10 THROUGH THE METASYS SYSTEM CONTROL UNIT, WILL ON A RISE IN TEMPERATURE ABOVE ITS SETTING OF SEVENTY-FIVE (75F) MODULATE V-H-10 CLOSED TO THE HEATING COIL. ON A FALL IN TEMPERATURE, THIS CYCLE IS REVERSED.

UNOCCUPIED HEATING MODE - ROOM SENSOR TR-10, WILL ON A FALL IN TEMPERATURE TO ITS SETTING OF FIFTY (50F). ACTIVATE THE SYSTEM TO RUN IN THE HEATING MODE AS HEREINBEFORE DESCRIBED. ON A RISE IN TEMPERATURE TO FIFTY-FIVE (55F), THE SYSTEM WILL BE DE-ENERGIZED. IN THE UNOCCUPIED MODE ALL AIR HANDLING UNIT DAMPERS AND CONTROLS WILL RETURN TO THEIR NORMAL POSITION READY FOR RESTARTING.

OCCUPIED VENTILATING MODE - SUPPLY AND SMOKE EXHAUST FANS START AND RUN CONTINUOUSLY. OUTSIDE AIR DAMPER D-10-1 WILL OPEN. HEATING COIL VALVE V-H-10 WILL BE CLOSED TO THE COIL.

UNOCCUPIED VENTILATING MODE - SYSTEM IS DE-ENERGIZED AND FANS ARE OFF.


SMOKE CONTROL - SMOKE DETECTORS FOR HVU-10 WILL, ON THE DETECTION OF PRODUCTS OF COMBUSTION, SHUT DOWN THE SUPPLY AND CLOSE OUTSIDE DAMPER D-10-1. CROSS ZONED CEILING SMOKE DETECTORS IN THE SERVICE CORRIDOR OR A SPRINKLER WATER FLOW ALARM ON THE SERVICE LEVEL WILL ENERGIZE THE TWO (2) SMOKE EXHAUST FANS THROUGH THE FIRE ALARM SYSTEM. HVU-8, HVU-9 AND HVU-10 SERVICE THE AREA WILL BE DE-ENERGIZED AND ALL THEIR DAMPERS WILL RETURN TO THEIR NORMALLY CLOSED POSITION WHEN THE SMOKE EXHAUST IS ENERGIZED BY THE FIRE ALARM SYSTEM. SERVICE LEVEL SMOKE EXHAUST FANS WILL BE AUTOMATICALLY AND MANUALLY STARTED AND STOPPED FROM THE FIRE ALARM SYSTEM. FIRE ALARM SYSTEM CONTROL IS INDEPENDENT OF THE METASYS SYSTEM. TWO (2) SERVICE LEVEL EXIT CORRIDOR SMOKE EXHAUST SYSTEMS EXIST WITH A TOTAL OF FOUR (4) EXHAUST FANS. TWO (2) SMOKE EXHAUST FANS ARE RELATED TO THREE (3) HEATING AND VENTILATING UNITS. IF EITHER EXIT CORRIDOR SMOKE EXHAUST SYSTEM IS ACTIVATED, THE OTHER SYSTEM WILL ALSO BE ENERGIZED. FIRE ALARM SYSTEM CONTROL IS INDEPENDENT OF THE METASYS SYSTEM.

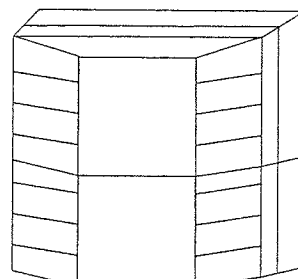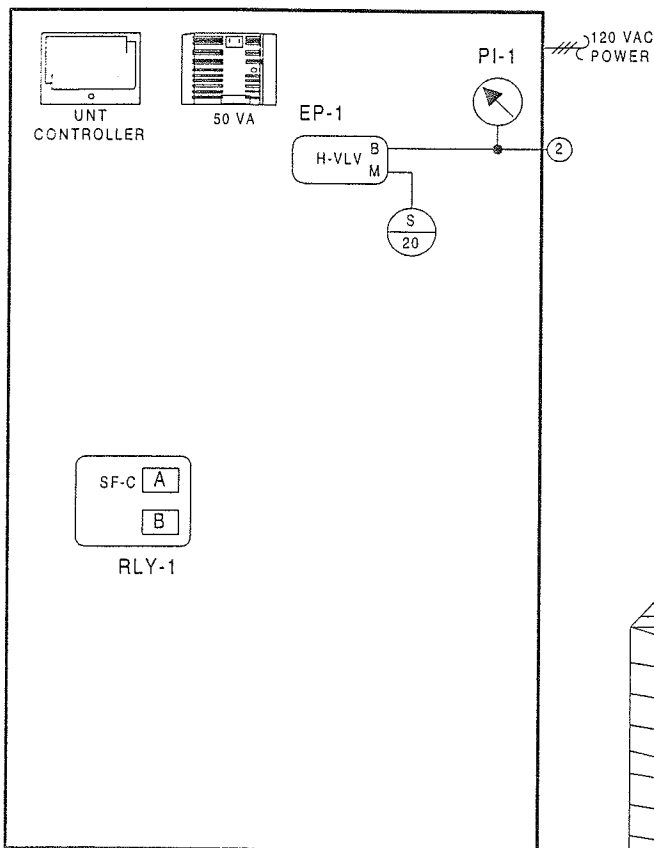

ENCLOSURE EN-HVU-10
AS-UNT111-101
LOCATED ADJACENT TO UNIT
NCM-5-N2 ADD = 20

REVISION INFORMATION	IN CONSIDERATION OF THE RECEIPT OF THIS DOCUMENT, THE RECIPIENT AGREES NOT TO REPRODUCE, COPY, USE OR TRANSMIT THIS DOCUMENT AND/OR THE INFORMATION THEREIN CONTAINED, IN WHOLE OR IN PART, OR TO SUFFER SUCH ACTION BY OTHERS, FOR ANY PURPOSE, EXCEPT WITH THE WRITTEN PERMISSION OF JOHNSON CONTROLS, INC. AND FURTHER AGREES TO SURRENDER SAME TO JOHNSON CONTROLS, INC. UPON DEMAND. COPYRIGHT JOHNSON CONTROLS, INC. 19nn	DRAWING TITLE					
NUMBER		HEAT-VENT UNIT HVU-10 SERVICE TUNNEL					
DATE		07/18/00	PROJECT TITLE	BALTIMORE NFL STADIUM AT CAMDEN YARDS			
TIME		03:35 PM		BALTIMORE, MARYLAND			
FILE NAME	HVU-10.vsd	AS-BUILT	7/18/00 CME				
		REFERENCE DRAWING	NO	REVISION-LOCATION	EDN	DATE	BY
		Sales Engineer	JDP	Project Manager	WJT	Application Engineer	RTS
		DATE	09/05/97	BY	RTS	DATE	
		Branch Information	JOHNSON CONTROLS 60 LOVETON CIRCLE SPARKS, MD 21152				
		CONTRACT NUMBER	7052-0098				
		DRAWING NUMBER	BL-6559-38				

Full Spreadsheet		Software				Digital Controller Information					Panel Information				Intermediate Device				Field Device								
Tag	Point Type	System Name	Object Name	Expanded ID	Display Units	DC Type	N2 Trunk	N2 Addr	Cable Destination Bay/Terminal	Module Type	Termination	Panel	Panel Location	Slot Number	Reference Drawing	Cable Number	Wiring/Tubing	Termination In	Device	Termination Out	Location	Wiring/Tubing	Terminations	Device	Location	Ref Detail	Comment
		HVU-10				UNT						EN-HVU10	Service Level A		M.2-01A												
		HVU-10				UNT	1	20				EN-HVU10	Service Level A		0IM.2-01A												Power to Controller
AI-1		HVU-10				UNT	1	20	AI-1			EN-HVU10	Service Level A		0IM.2-01A	HVU10-20-AI-1											N2 Trunk
AI-2		HVU-10				UNT	1	20	AI-2			EN-HVU10	Service Level A		0IM.2-01A	HVU10-20-AI-2											
AI-3		HVU-10				UNT	1	20	AI-3			EN-HVU10	Service Level A		0IM.2-01A	HVU10-20-AI-3											
AI-4		HVU-10	ZN-T	Zone Temperature	Deg F	UNT	1	20	AI-4		PHONE JACK	EN-HVU10	Service Level A		0IM.2-01A	HVU10-20-AI-4											
AI-5		HVU-10				UNT	1	20	AI-5			EN-HVU10	Service Level A		0IM.2-01A	HVU10-20-AI-5						8/26	PHONE JACK	TE-6410W-1000		U2	
AI-6		HVU-10				UNT	1	20	AI-6			EN-HVU10	Service Level A		0IM.2-01A	HVU10-20-AI-6											
BI-1		HVU-10	SF-S	Supply Fan Status	Off On	UNT	1	20	BI-1			EN-HVU10	Service Level A		0IM.2-01A	HVU10-20-BI-1											
BI-2		HVU-10	SMK-DET	Smoke Detectors	Normal Alarm	UNT	1	20	BI-2		BI#.24VAC	EN-HVU10	Service Level A		0IM.2-01A	HVU10-20-BI-2						2/22	Device dependent	Aux Contact (NO)		U70	
BI-3		HVU-10	LT-S	Low Temperature Stat	Normal Alarm	UNT	1	20	BI-3		BI#.24VAC	EN-HVU10	Service Level A		0IM.2-01A	HVU10-20-BI-3						2/22	Device dependent	Contact (NO)		U70	
BI-4		HVU-10				UNT	1	20	BI-4			EN-HVU10	Service Level A		0IM.2-01A	HVU10-20-BI-4						2/22	NO.M1	A70 (NC)		U71	
BO-1		HVU-10	SF-C	Supply Fan Control	Off On	UNT	1	20	BO-1		BO#.24V.COM	EN-HVU10	Service Level A		0IM.2-01A	HVU10-20-BO-1	3/18	A.COILS.COM	RELAY-A	NO.COM		2/14	See starter detail	Starter (NO)-(sw lo)		U60	
BO-2		HVU-10				UNT	1	20	BO-2			EN-HVU10	Service Level A		0IM.2-01A	HVU10-20-BO-2											
BO-3		HVU-10				UNT	1	20	BO-3			EN-HVU10	Service Level A		0IM.2-01A	HVU10-20-BO-3											
BO-4		HVU-10				UNT	1	20	BO-4			EN-HVU10	Service Level A		0IM.2-01A	HVU10-20-BO-4											
BO-5		HVU-10				UNT	1	20	BO-5			EN-HVU10	Service Level A		0IM.2-01A	HVU10-20-BO-5											
BO-6		HVU-10				UNT	1	20	BO-6			EN-HVU10	Service Level A		0IM.2-01A	HVU10-20-BO-6											
AO-1		HVU-10	H-VLV	Heating Coil Valve	% Open	UNT	1	20	AO-1		AO#.AOCM.24V	EN-HVU10	Service Level A		0IM.2-01A	HVU10-20-AO-1	2/18	+-	EP-8000-2	SUPPLY. O		3/18	Device dependent	0-10V OUT		U23	
AO-2		HVU-10				UNT	1	20	AO-2			EN-HVU10	Service Level A		0IM.2-01A	HVU10-20-AO-2											

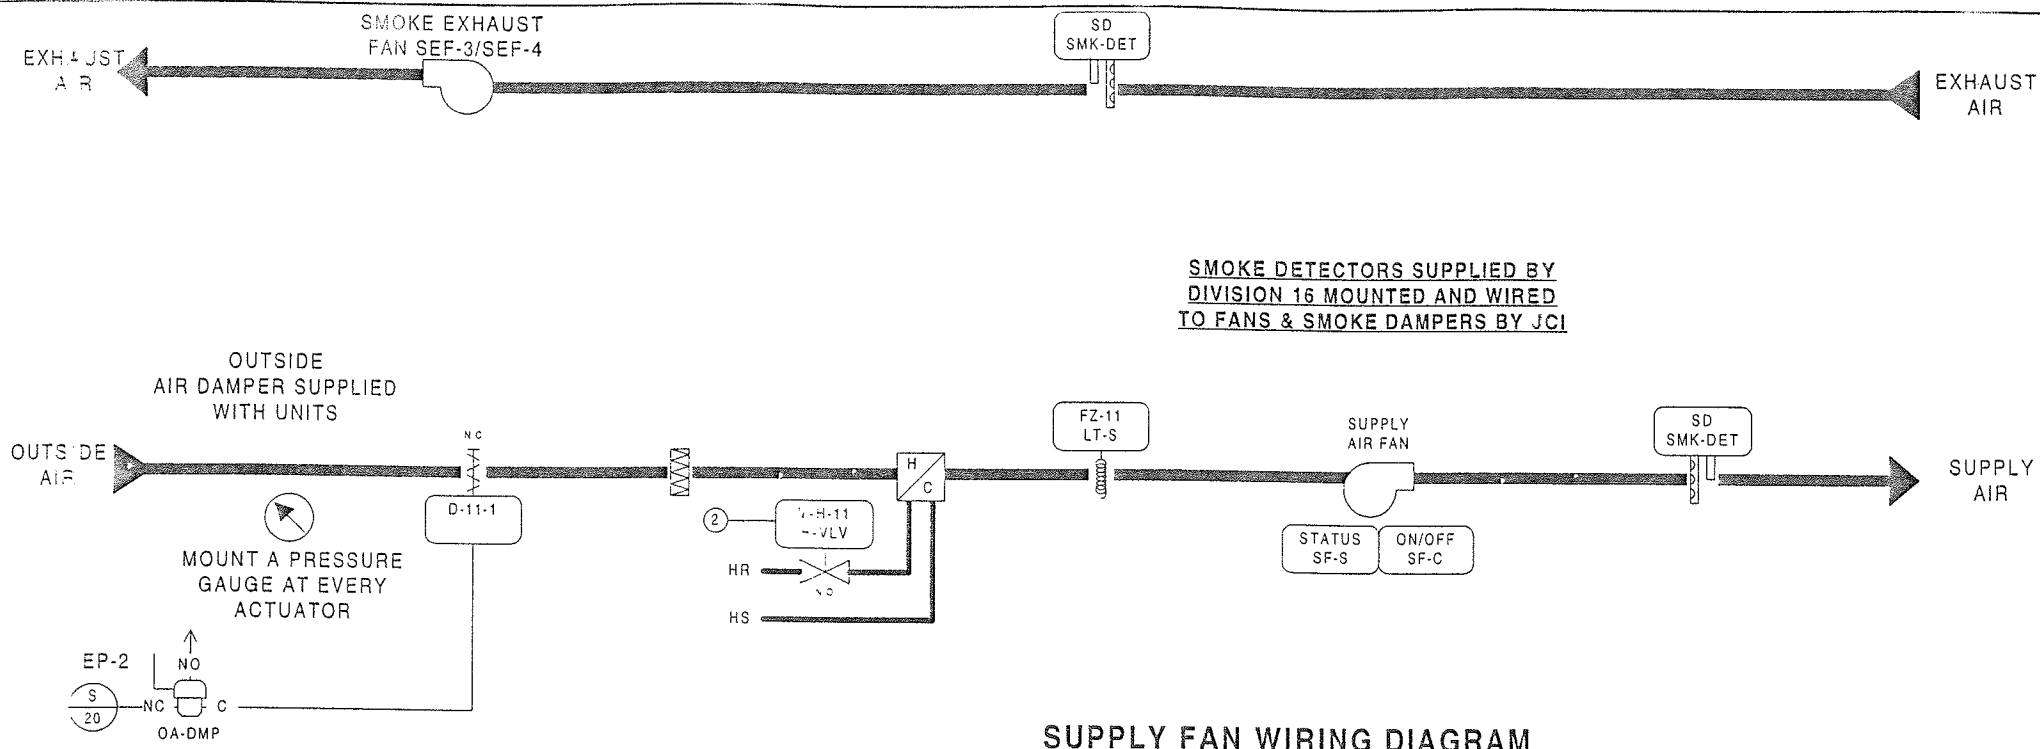


SMOKE DETECTORS SUPPLIED BY DIVISION 16 MOUNTED AND WIRED TO FANS & SMOKE DAMPERS BY JCI


BILL OF MATERIALS Estimate: hvu-11 70520098.pre

Desig.	Qty	Part #	Description
Field Devices:			
D-11-1	1	D-3153-2	DMPR ACT, 8-13#
	1	G-2010-11	GAGE, 2", 0-30 PSIG, STEM
EP-2	1	V11HAA-100	3-W SOLENOID, W/OV, 120VAC
FZ-11	1	A70HA-1C	STAT, LL, 20", EL, NAM, 15/55F
H-VLV	1	--	SEE VALVE SCHEDULE
ZN-T	1	TE-6410W-1000	MSTAT, NI, BOX, JACK
Panel Devices:			
EN-HVU-11	1	AS-UNT111-101	UNT111 MTD IN UFM, W/50VA
	1	EN-EXPI01-0	UNIV PKG MOD, CVR & BACKBN
EP-1	1	EP-8000-2	XDUCR, EP, 0/10V, HI VOL
PI-1	1	G-2010-11	GAGE, 2", 0-30 PSIG, STEM
RLY-1	1	AS-RLY002-0	RELAY, 2SPDT 5 AMP 240VAC


SUPPLY FAN WIRING DIAGRAM

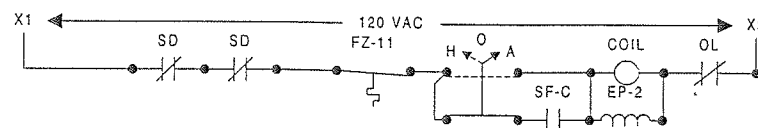

SMOKE EXHAUST FAN SEF-3 DIAGRAM

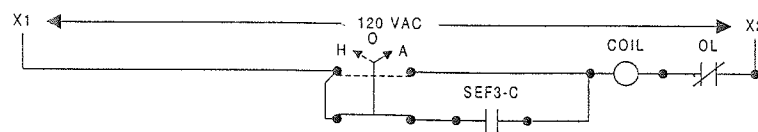

SMOKE EXHAUST FAN SEF-4 DIAGRAM

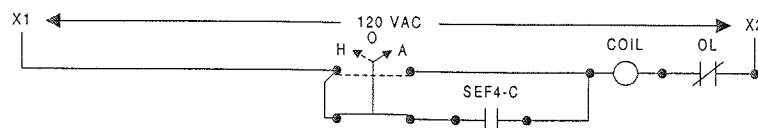

DESCRIPTION OF OPERATION

STARTING OF THE HVU SUPPLY FAN WILL INITIATE A START OF THE LEAD SMOKE EXHAUST FAN SEF-3 OR SEF-4. IF THE LEAD FAN FAILS OR FAILS TO START, THE LAG EXHAUST FAN SEF-3 OR SEF-4 WILL START AND RUN CONTINUOUSLY.

THE METASYS SYSTEM WILL DETERMINE THE "OCCUPIED AND UNOCCUPIED" MODES OF OPERATION. OCCUPIED MODES GENERALLY OCCUR DURING STADIUM EVENTS, BUT MANUAL OVERRIDE THROUGH THE METASYS SYSTEM ON SELECTED UNITS WILL FREQUENTLY BE REQUIRED. WHEN THE UNIT AND SMOKE EXHAUST FAN ARE DE-ENERGIZED, OUTSIDE AIR DAMPER D-11-1, WILL CLOSE. HEATING COIL VALVE V-H-11 WILL BE CLOSED TO THE COIL.

OCCUPIED HEATING MODE - SUPPLY FAN WILL BE RUNNING. OUTSIDE AIR DAMPER D-11-1 WILL OPEN. ROOM SENSOR TR-11 THROUGH THE METASYS SYSTEM CONTROL UNIT, WILL ON A RISE IN TEMPERATURE ABOVE ITS SETTING OF SEVENTY-FIVE (75F) MODULATE V-H-11 CLOSED TO THE HEATING COIL. ON A FALL IN TEMPERATURE, THIS CYCLE IS REVERSED.

UNOCCUPIED HEATING MODE - ROOM SENSOR TR-11, WILL ON A FALL IN TEMPERATURE TO ITS SETTING OF FIFTY (50F), ACTIVATE THE SYSTEM TO RUN IN THE HEATING MODE AS HEREINBEFORE DESCRIBED. ON A RISE IN TEMPERATURE TO FIFTY-FIVE (55F), THE SYSTEM WILL BE DE-ENERGIZED. IN THE UNOCCUPIED MODE ALL AIR HANDLING UNIT DAMPERS AND CONTROLS WILL RETURN TO THEIR NORMAL POSITION READY FOR RESTARTING.



OCCUPIED VENTILATING MODE - SUPPLY AND SMOKE EXHAUST FANS START AND RUN CONTINUOUSLY. OUTSIDE AIR DAMPER D-11-1 WILL OPEN. HEATING COIL VALVE V-H-11 WILL BE CLOSED TO THE COIL.

UNOCCUPIED VENTILATING MODE - SYSTEM IS DE-ENERGIZED AND FANS ARE OFF.

SMOKE CONTROL - SMOKE DETECTORS FOR HVU-11 WILL, ON THE DETECTION OF PRODUCTS OF COMBUSTION, SHUT DOWN THE SUPPLY AND CLOSE OUTSIDE DAMPER D-11-1. CROSS ZONED CEILING SMOKE DETECTORS IN THE SERVICE CORRIDOR OR A SPRINKLER WATER FLOW ALARM ON THE SERVICE LEVEL WILL ENERGIZE THE TWO (2) SMOKE EXHAUST FANS THROUGH THE FIRE ALARM SYSTEM. HVU-11, HVU-12 AND HVU-13 SERVICE THE AREA WILL BE DE-ENERGIZED AND ALL THEIR DAMPERS WILL RETURN TO THEIR NORMALLY CLOSED POSITION WHEN THE SMOKE EXHAUST IS ENERGIZED BY THE FIRE ALARM SYSTEM. SERVICE LEVEL SMOKE EXHAUST FANS WILL BE AUTOMATICALLY AND MANUALLY STARTED AND STOPPED FROM THE FIRE ALARM SYSTEM. FIRE ALARM SYSTEM CONTROL IS INDEPENDENT OF THE METASYS SYSTEM. TWO (2) SERVICE LEVEL EXIT CORRIDOR SMOKE EXHAUST SYSTEMS EXIST WITH A TOTAL OF FOUR (4) EXHAUST FANS. TWO (2) SMOKE EXHAUST FANS ARE RELATED TO THREE (3) HEATING AND VENTILATING UNITS. IF EITHER EXIT CORRIDOR SMOKE EXHAUST SYSTEM IS ACTIVATED, THE OTHER SYSTEM WILL ALSO BE ENERGIZED. FIRE ALARM SYSTEM CONTROL IS INDEPENDENT OF THE METASYS SYSTEM.

FAN	LOCATION	ELEC PANEL	STARTER	LOCATION
HVU-11	SERVICE LEVEL		LOCAL	SERVICE LEVEL
SEF-3	SERVICE LEVEL		LOCAL	SERVICE LEVEL
SEF-4	SERVICE LEVEL		LOCAL	SERVICE LEVEL


NOTE: FOR SMOKE EXHAUST FANS SEF-1 AND SEF-2 METASYS POINT CONNECTIONS SEE AHU-19 CONTROL DIAGRAM BL-6559-25 POINT LIST NCM-5 PS-10

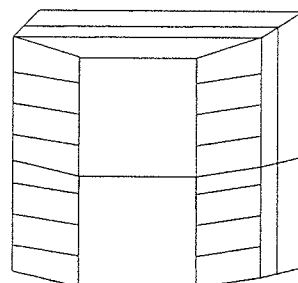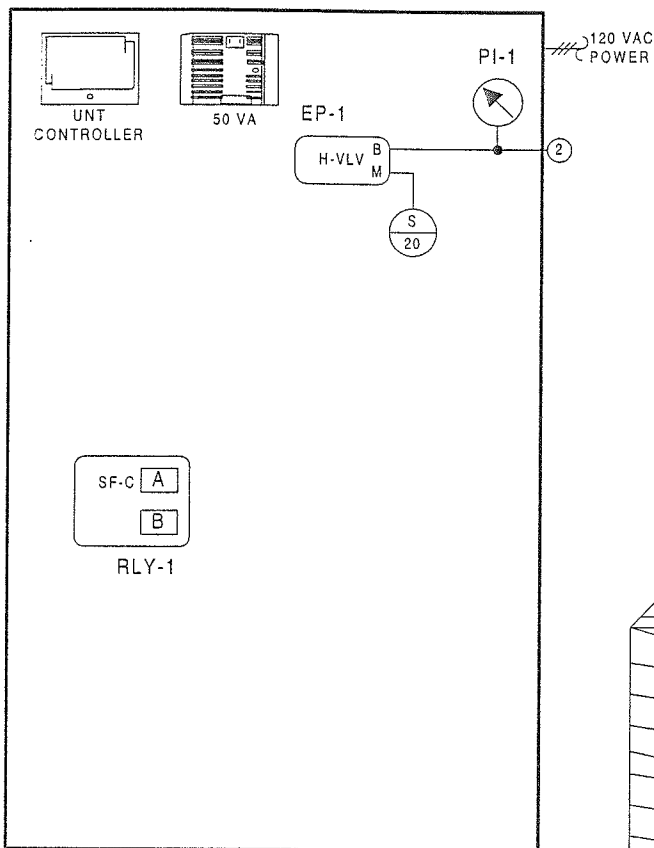

ENCLOSURE EN-HVU-11 AS-UNT111-101 LOCATED ADJACENT TO UNIT NCM-5/N2 ADD = 21

REVISION INFORMATION NUMBER DATE 07/18/00 TIME 03:35 PM FILE NAME HVU-11.vsd	IN CONSIDERATION OF THE RECEIPT OF THIS DOCUMENT, THE RECIPIENT AGREES NOT TO REPRODUCE, COPY, USE OR TRANSMIT THIS DOCUMENT AND/OR THE INFORMATION THEREIN CONTAINED, IN WHOLE OR IN PART, OR TO SUFFER SUCH ACTION BY OTHERS, FOR ANY PURPOSE, EXCEPT WITH THE WRITTEN PERMISSION OF JOHNSON CONTROLS, INC. AND FURTHER AGREES TO SURRENDER SAME TO JOHNSON CONTROLS, INC. UPON DEMAND. COPYRIGHT JOHNSON CONTROLS, INC. 1998	DRAWING TITLE HEAT-VENT UNIT HVU-11 SERVICE TUNNEL SERVICE LEVEL QUAD B PROJECT TITLE BALTIMORE NFL STADIUM AT CAMDEN YARDS BALTIMORE, MARYLAND	<table border="1"> <tr> <td>AS-BUILT</td> <td>7/18/00</td> <td>CME</td> </tr> <tr> <td>REFERENCE DRAWING</td> <td>NO</td> <td>REVISION/LOCATION</td> </tr> <tr> <td>Sales Engineer JDP</td> <td>Project Manager WJT</td> <td>Application Engineer RTS</td> </tr> <tr> <td>BY</td> <td>DATE 09/05/97</td> <td>APPROVED</td> </tr> </table>	AS-BUILT	7/18/00	CME	REFERENCE DRAWING	NO	REVISION/LOCATION	Sales Engineer JDP	Project Manager WJT	Application Engineer RTS	BY	DATE 09/05/97	APPROVED
AS-BUILT	7/18/00	CME													
REFERENCE DRAWING	NO	REVISION/LOCATION													
Sales Engineer JDP	Project Manager WJT	Application Engineer RTS													
BY	DATE 09/05/97	APPROVED													
		JOHNSON CONTROLS Systems & Services Division	JOHNSON CONTROLS 60 LOVETON CIRCLE SPARKS, MD 21152 CONTRACT NUMBER 7052-0098 DRAWING NUMBER BL-6559-39												

Full Spreadsheet		Software				Digital Controller Information						Panel Information				Intermediate Device				Field Device							
Tag	Point Type	System Name	Object Name	Expanded ID	Display Units	DC Type	N2 Trunk	N2 Addr	Cable Destination Bay/Terminal	Module Type	Termination	Panel	Panel Location	Slot Number	Reference Drawing	Cable Number	Wiring/Tubing	Termination In	Device	Termination Out	Location	Wiring/Tubing	Terminations	Device	Location	Ref Detail	Comment
b		HVU-11				IUNT						EN-HVU11	Service Level B		M.2-01B												Power to Controller
		HVU-11				IUNT	1	21				EN-HVU11	Service Level B		0IM.2-01B												N2 Trunk
	AI-1	HVU-11				IUNT			21AI-1			EN-HVU11	Service Level B		0IM.2-01B												
	AI-2	HVU-11				IUNT			21AI-2			EN-HVU11	Service Level B		0IM.2-01B												
	AI-3	HVU-11				IUNT			21AI-3			EN-HVU11	Service Level B		0IM.2-01B												
	AI-4	HVU-11	ZN-T	Zone Temperature	Deg F	IUNT	1		21AI-4		PHONE JACK	EN-HVU11	Service Level B		0IM.2-01B						8/26	PHONE JACK	TE-6410W-1000		U2		
	AI-5	HVU-11				IUNT			21AI-5			EN-HVU11	Service Level B		0IM.2-01B												
	AI-6	HVU-11				IUNT			21AI-6			EN-HVU11	Service Level B		0IM.2-01B												
	BI-1	HVU-11	SF-S	Supply Fan Status	Off On	IUNT	1		21BI-1		BI#,24VAC	EN-HVU11	Service Level B		0IM.2-01B												
	BI-2	HVU-11	SMK-DET	Smoke Detectors	Normal Alarm	IUNT	1		21BI-2		BI#,24VAC	EN-HVU11	Service Level B		0IM.2-01B						2/22	Device dependent	Aux Contact (NO)		U70		
	BI-3	HVU-11	LT-S	Low Temperature Stat	Normal Alarm	IUNT	1		21BI-3		BI#,24VAC	EN-HVU11	Service Level B		0IM.2-01B						2/22	Device dependent	Contact (NO)		U70		
	BI-4	HVU-11				IUNT	1		21BI-4			EN-HVU11	Service Level B		0IM.2-01B						2/22	NO,N:1	A70 (NC)		U71		
	BO-1	HVU-11	SF-C	Supply Fan Control	Off On	IUNT	1		21BO-1		RLY BO#,24V.COM	EN-HVU11	Service Level B		0IM.2-01B												
	BO-2	HVU-11				IUNT	1		21BO-2			EN-HVU11	Service Level B		0IM.2-01B												
	BO-3	HVU-11				IUNT	1		21BO-3			EN-HVU11	Service Level B		0IM.2-01B												
	BO-4	HVU-11				IUNT	1		21BO-4			EN-HVU11	Service Level B		0IM.2-01B												
	BO-5	HVU-11				IUNT	1		21BO-5			EN-HVU11	Service Level B		0IM.2-01B												
	BO-6	HVU-11				IUNT	1		21BO-6			EN-HVU11	Service Level B		0IM.2-01B												
	AO-1	HVU-11	H-VLV	Heating Coil Valve	% Open	IUNT	1		21AO-1		AO#,ACCM.24V	EN-HVU11	Service Level B		0IM.2-01B												
	AO-2	HVU-11				IUNT	1		21AO-2			EN-HVU11	Service Level B		0IM.2-01B												

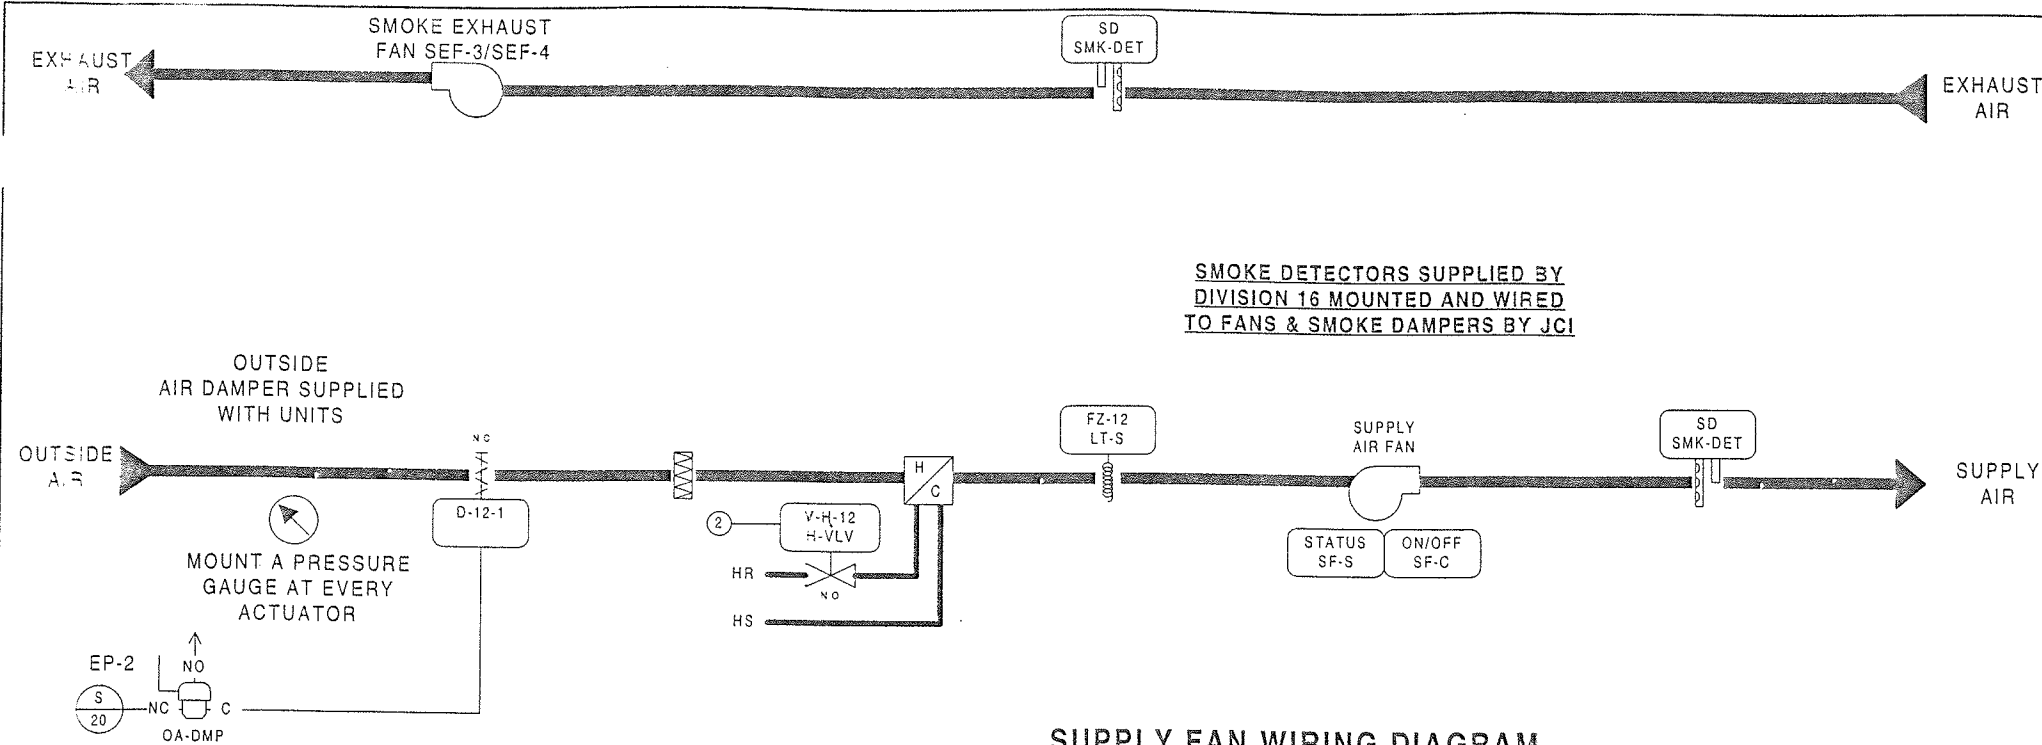


SMOKE DETECTORS SUPPLIED BY DIVISION 16 MOUNTED AND WIRED TO FANS & SMOKE DAMPERS BY JCI

ESTIMATE: hvu-12
70520098.pre


BILL OF MATERIALS

Desig.	Qty	Part #	Description
Field Devices:			
D-12-1	1	D-3153-2	DMPR ACT, 8-13#
	1	G-2010-11	GAGE, 2", 0-30 PSIG, STEM
EP-2	1	V11HAA-100	3-W SOLENOID, W/OV, 120VAC
FZ-12	1	A70HA-1C	STAT, LL, 20', EL, MAN, 15/55F
H-VLV	1	--	SEE VALVE SCHEDULE
ZN-T	1	TE-6410W-1000	MSTAT, NI, BOX, JACK
Panel Devices:			
EN-HVU-12	1	AS-UNT111-101	UNT111 MTD IN UPM, W/50VA
	1	EN-EXP101-0	UNIV PKG MOD, CVR & BACKBN
EP-1	1	EP-8000-2	XDUCR, EP, 0/10V, HI VOL
PI-1	1	G-2010-11	GAGE, 2", 0-30 PSIG, STEM
RLY-1	1	AS-RLY002-0	RELAY; 2SPDT 5 AMP 240VAC


SUPPLY FAN WIRING DIAGRAM

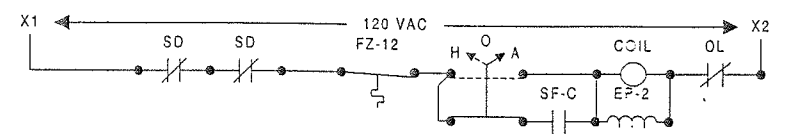

SMOKE EXHAUST FAN SEF-3 DIAGRAM

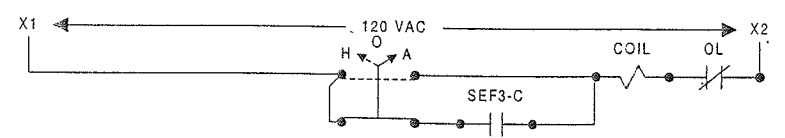

SMOKE EXHAUST FAN SEF-4 DIAGRAM

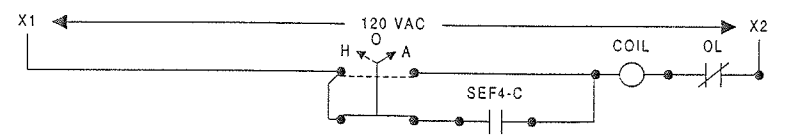

FAN	LOCATION	ELEC PANEL	STARTER	LOCATION
HVU-12	SERVICE LEVEL	MCC2SRB	3B	SERVICE LEVEL
SEF-3	SERVICE LEVEL		LOCAL	SERVICE LEVEL
SEF-4	SERVICE LEVEL		LOCAL	SERVICE LEVEL

NOTE: FOR SMOKE EXHAUST FANS SEF-3 AND SEF-4 METASYS POINT CONNECTIONS SEE AHU-13 CONTROL DIAGRAM BL-6559-18 POINT LIST NCM-5 PS-4

DESCRIPTION OF OPERATION

STARTING OF THE HVU SUPPLY FAN WILL INITIATE A START OF THE LEAD SMOKE EXHAUST FAN SEF-3 OR SEF-4. IF THE LEAD FAN FAILS OR FAILS TO START, THE LAG EXHAUST FAN SEF-3 OR SEF-4 WILL START AND RUN CONTINUOUSLY.

THE METASYS SYSTEM WILL DETERMINE THE "OCCUPIED AND UNOCCUPIED" MODES OF OPERATION. OCCUPIED MODES GENERALLY OCCUR DURING STADIUM EVENTS, BUT MANUAL OVERRIDE THROUGH THE METASYS SYSTEM ON SELECTED UNITS WILL FREQUENTLY BE REQUIRED. WHEN THE UNIT AND SMOKE EXHAUST FAN ARE DE-ENERGIZED, OUTSIDE AIR DAMPER D-12-1, WILL CLOSE. HEATING COIL VALVE V-H-12 WILL BE CLOSED TO THE COIL.



OCCUPIED HEATING MODE - SUPPLY FAN WILL BE RUNNING. OUTSIDE AIR DAMPER D-12-1 WILL OPEN. ROOM SENSOR TR-12 THROUGH THE METASYS SYSTEM CONTROL UNIT, WILL ON A RISE IN TEMPERATURE ABOVE ITS SETTING OF SEVENTY-FIVE (75F) MODULATE V-H-12 CLOSED TO THE HEATING COIL. ON A FALL IN TEMPERATURE, THIS CYCLE IS REVERSED.

UNOCCUPIED HEATING MODE - ROOM SENSOR TR-12, WILL ON A FALL IN TEMPERATURE TO ITS SETTING OF FIFTY (50F). ACTIVATE THE SYSTEM TO RUN IN THE HEATING MODE AS HEREINBEFORE DESCRIBED. ON A RISE IN TEMPERATURE TO FIFTY-FIVE (55F), THE SYSTEM WILL BE DE-ENERGIZED. IN THE UNOCCUPIED MODE ALL AIR HANDLING UNIT DAMPERS AND CONTROLS WILL RETURN TO THEIR NORMAL POSITION READY FOR RESTARTING.

OCCUPIED VENTILATING MODE - SUPPLY AND SMOKE EXHAUST FANS START AND RUN CONTINUOUSLY. OUTSIDE AIR DAMPER D-12-1 WILL OPEN. HEATING COIL VALVE V-H-12 WILL BE CLOSED TO THE COIL.

UNOCCUPIED VENTILATING MODE - SYSTEM IS DE-ENERGIZED AND FANS ARE OFF.


SMOKE CONTROL - SMOKE DETECTORS FOR HVU-12 WILL, ON THE DETECTION OF PRODUCTS OF COMBUSTION, SHUT DOWN THE SUPPLY AND CLOSE OUTSIDE DAMPER D-12-1. CROSS ZONED CEILING SMOKE DETECTORS IN THE SERVICE CORRIDOR OR A SPRINKLER WATER FLOW ALARM ON THE SERVICE LEVEL WILL ENERGIZE THE TWO (2) SMOKE EXHAUST FANS THROUGH THE FIRE ALARM SYSTEM. HVU-11, HVU-12 AND HVU-13 SERVICE THE AREA WILL BE DE-ENERGIZED AND ALL THEIR DAMPERS WILL RETURN TO THEIR NORMALLY CLOSED POSITION WHEN THE SMOKE EXHAUST IS ENERGIZED BY THE FIRE ALARM SYSTEM. SERVICE LEVEL SMOKE EXHAUST FANS WILL BE AUTOMATICALLY AND MANUALLY STARTED AND STOPPED FROM THE FIRE ALARM SYSTEM. FIRE ALARM SYSTEM CONTROL IS INDEPENDENT OF THE METASYS SYSTEM. TWO (2) SERVICE LEVEL EXIT CORRIDOR SMOKE EXHAUST SYSTEMS EXIST WITH A TOTAL OF FOUR (4) EXHAUST FANS. TWO (2) SMOKE EXHAUST FANS ARE RELATED TO THREE (3) HEATING AND VENTILATING UNITS. IF EITHER EXIT CORRIDOR SMOKE EXHAUST SYSTEM IS ACTIVATED, THE OTHER SYSTEM WILL ALSO BE ENERGIZED. FIRE ALARM SYSTEM CONTROL IS INDEPENDENT OF THE METASYS SYSTEM.

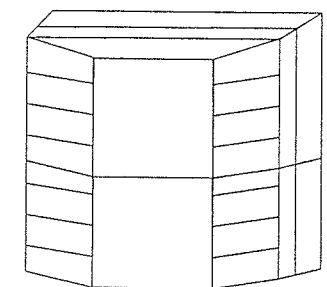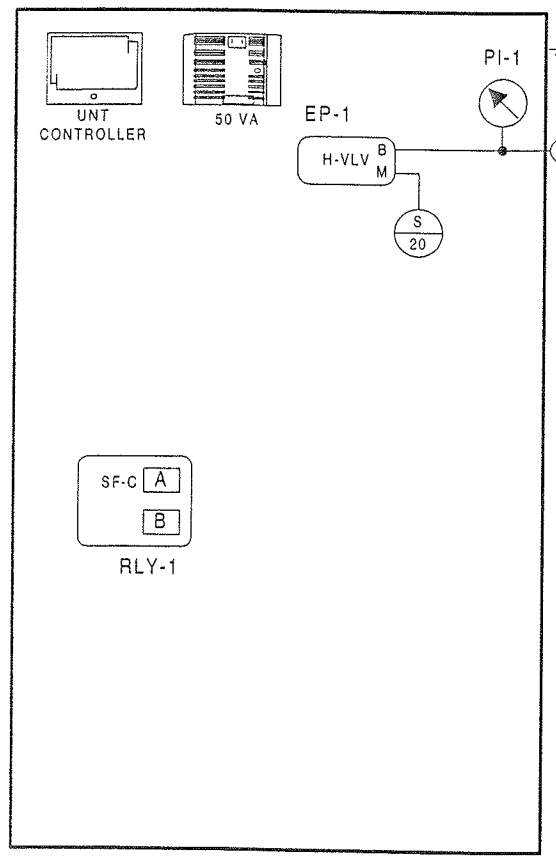

ENCLOSURE EN-HVU-12 AS-UNT111-101 LOCATED ADJACENT TO UNIT NCM-5:N2 ADD = 22

REVISION INFORMATION NUMBER DATE 07/18/00 TIME 03:36 PM FILE NAME HVU-12.vsd	IN CONSIDERATION OF THE RECEIPT OF THIS DOCUMENT, THE RECIPIENT AGREES NOT TO REPRODUCE, COPY, USE OR TRANSMIT THIS DOCUMENT AND/OR THE INFORMATION THEREIN CONTAINED, IN WHOLE OR IN PART, OR TO SUFFER SUCH ACTION BY OTHERS, FOR ANY PURPOSE, EXCEPT WITH THE WRITTEN PERMISSION OF JOHNSON CONTROLS, INC. AND FURTHER AGREES TO SURRENDER SAME TO JOHNSON CONTROLS, INC. UPON DEMAND. COPYRIGHT JOHNSON CONTROLS, INC. 1998	DRAWING TITLE HEAT-VENT UNIT HVU-12 SERVICE TUNNEL SERVICE LEVEL QUAD B PROJECT TITLE BALTIMORE NFL STADIUM AT CAMDEN YARDS BALTIMORE, MARYLAND	<table border="1"> <tr> <td>AS-BUILT</td> <td>7/18/00</td> <td>CME</td> </tr> <tr> <td>REFERENCE DRAWING</td> <td>NO</td> <td>REVISION-LOCATION</td> </tr> <tr> <td>Sales Engineer JDP</td> <td>Project Manager WJT</td> <td>Approval Engineer RTS</td> </tr> <tr> <td>BY RTS</td> <td>DATE 09/09/97</td> <td>BY DATE</td> </tr> </table>	AS-BUILT	7/18/00	CME	REFERENCE DRAWING	NO	REVISION-LOCATION	Sales Engineer JDP	Project Manager WJT	Approval Engineer RTS	BY RTS	DATE 09/09/97	BY DATE
AS-BUILT	7/18/00	CME													
REFERENCE DRAWING	NO	REVISION-LOCATION													
Sales Engineer JDP	Project Manager WJT	Approval Engineer RTS													
BY RTS	DATE 09/09/97	BY DATE													
		CONTRACT NUMBER 7052-0098 DRAWING NUMBER BL-6559-40	JOHNSON CONTROLS Systems & Services Division 60 LOVETON CIRCLE SPARKS, MD 21152												

Full Spreadsheet		Software				Digital Controller Information					Panel Information				Intermediate Device				Field Device				Ref Detail	Comment				
Tag	Point Type	System Name	Object Name	Expanded ID	Display Units	DC Type	N2 Trunk	N2 Addr	Cable Destination Bay/Terminal	Module Type	Termination	Panel	Panel Location	Slot Number	Reference Drawing	Cable Number	Wiring/Tubing	Termination In	Device	Termination Out	Location	Wiring/Tubing			Terminations	Device	Location	
		HVU-12				UNT						EN-HVU12	Service Level B		IM.2-01B												Power to Controller	
		HVU-12				UNT		22				EN-HVU12	Service Level B		0IM.2-01B												N2 Trunk	
AI-1		HVU-12				UNT		22	AI-1			EN-HVU12	Service Level B		0IM.2-01B	HVU12-22-AI-1												
AI-2		HVU-12				UNT		22	AI-2			EN-HVU12	Service Level B		0IM.2-01B	HVU12-22-AI-2												
AI-3		HVU-12				UNT		22	AI-3			EN-HVU12	Service Level B		0IM.2-01B	HVU12-22-AI-3												
AI-4		HVU-12	ZN-T	Zone Temperature	Deg F	UNT		22	AI-4		PHONE JACK	EN-HVU12	Service Level B		0IM.2-01B	HVU12-22-AI-4					8/26	PHONE JACK	TE-6410W-1000			U2		
AI-5		HVU-12				UNT		22	AI-5			EN-HVU12	Service Level B		0IM.2-01B	HVU12-22-AI-5												
AI-6		HVU-12				UNT		22	AI-6			EN-HVU12	Service Level B		0IM.2-01B	HVU12-22-AI-6												
BI-1		HVU-12	SF-S	Supply Fan Status	Off On	UNT		22	BI-1		BI# .24VAC	EN-HVU12	Service Level B		0IM.2-01B	HVU12-22-BI-1					2/22	Device dependant	Aux Contact (NO)			U70		
BI-2		HVU-12	SMK-DET	Smoke Detectors	Normal Alarm	UNT		22	BI-2		BI# .24VAC	EN-HVU12	Service Level B		0IM.2-01B	HVU12-22-BI-2					2/22	Device dependant	Contact (NO)			U70		
BI-3		HVU-12	LT-S	Low Temperature Stat	Normal Alarm	UNT		22	BI-3		BI# .24VAC	EN-HVU12	Service Level B		0IM.2-01B	HVU12-22-BI-3					2/22	NC.M1	A70 (NC)			U71		
BI-4		HVU-12				UNT		22	BI-4			EN-HVU12	Service Level B		0IM.2-01B	HVU12-22-BI-4												
BO-1		HVU-12	SF-C	Supply Fan Control	Off On	UNT		22	BO-1		RLY BO# .24V.COM	EN-HVU12	Service Level B		0IM.2-01B	HVU12-22-BO-1	3/18	A.COILS.COM	RELAY-A	NO.COM		2/14	See starter detail	Starter (NO)-(sw lo)		U60		
BO-2		HVU-12				UNT		22	BO-2			EN-HVU12	Service Level B		0IM.2-01B	HVU12-22-BO-2												
BO-3		HVU-12				UNT		22	BO-3			EN-HVU12	Service Level B		0IM.2-01B	HVU12-22-BO-3												
BO-4		HVU-12				UNT		22	BO-4			EN-HVU12	Service Level B		0IM.2-01B	HVU12-22-BO-4												
BO-5		HVU-12				UNT		22	BO-5			EN-HVU12	Service Level B		0IM.2-01B	HVU12-22-BO-5												
BO-6		HVU-12				UNT		22	BO-6			EN-HVU12	Service Level B		0IM.2-01B	HVU12-22-BO-6												
AO-1		HVU-12	H-VLV	Heating Coil Valve	% Open	UNT		22	AO-1		AO# .AOCM.24V	EN-HVU12	Service Level B		0IM.2-01B	HVU12-22-AO-1	2/18	+-	EP-8000-2	SUPPLY_O		13/18	Device dependant	0-10V OUT		U23		
AO-2		HVU-12				UNT		22	AO-2			EN-HVU12	Service Level B		0IM.2-01B	HVU12-22-AO-2												

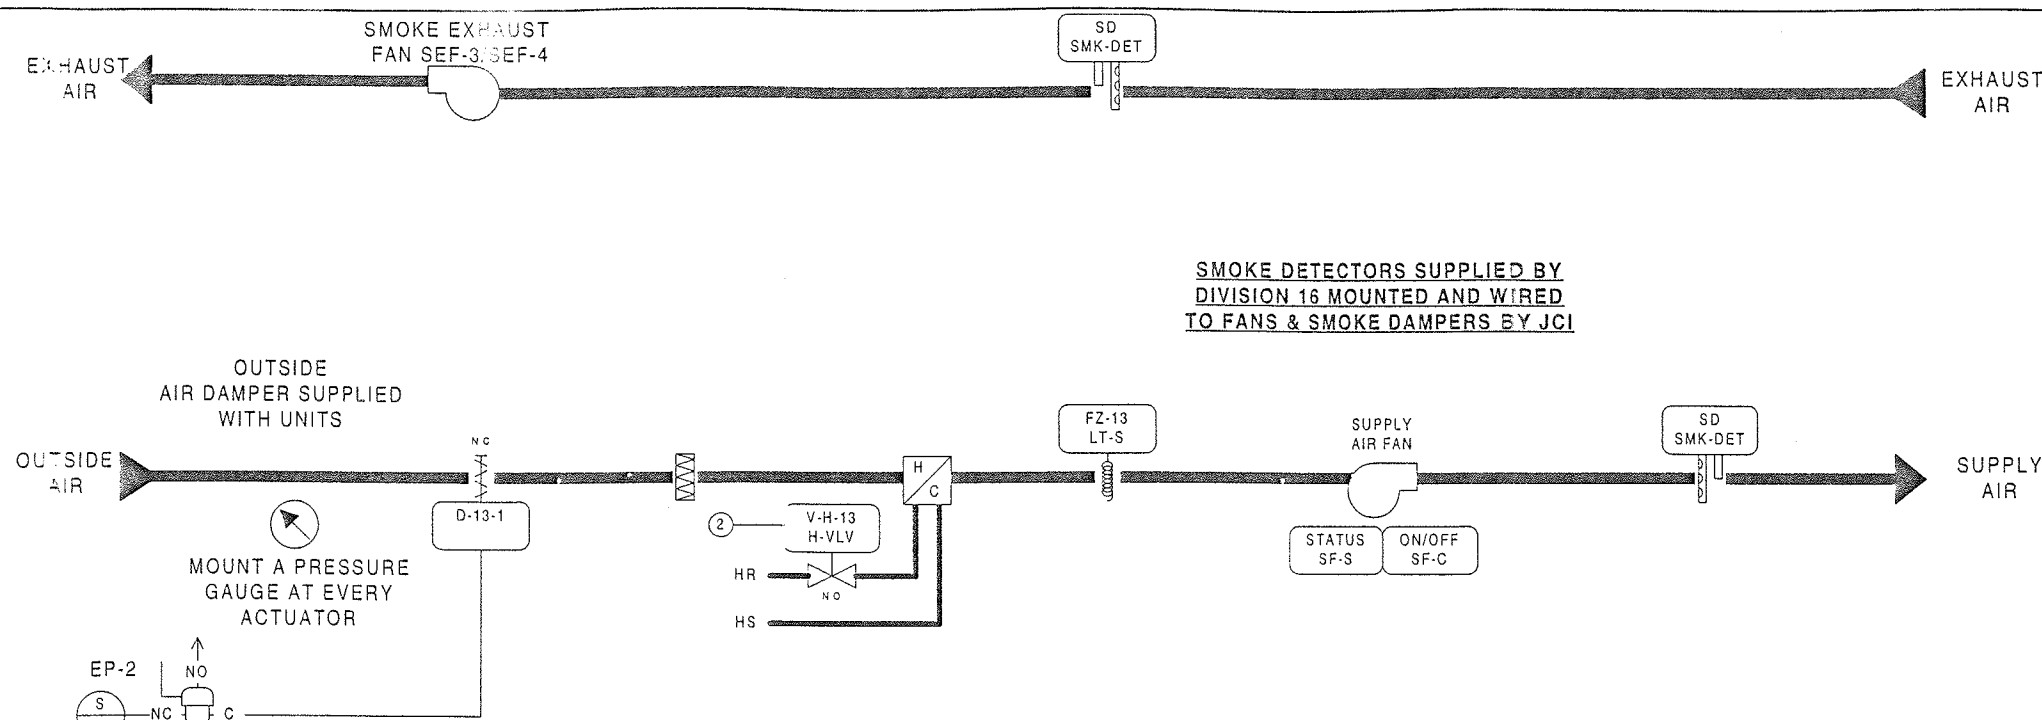

BILL OF MATERIALS

Estimate: hvu-13 70520098.pre

Desig.	QtyPart #	Description
Field Devices:		
D-13-1	1 D-3153-2	DMPR ACT, 8-13#
	1 G-2010-11	GAGE, 2", 0-30 PSIG, STEM
EP-2	1 V11HAA-100	3-W SOLENOID, W/OV, 120VAC
FZ-13	1 A70HA-1C	STAT, LL, 20', EL, MAN, 15/55F
H-VLV	1 --	SEE VALVE SCHEDULE
ZN-T	1 TE-6410W-1000	MSTAT, NI, BOX, JACK
Panel Devices:		
EN-HVU-13	1 AS-UNT111-101	UNT111 MTD IN UPM, W/50VA
	1 EN-EXP101-0	UNIV PKG MOD, CVR & BACKEN
EP-1	1 EP-8000-2	XDUCR, EP, 0/10V, HI VOL
PI-1	1 G-2010-11	GAGE, 2", 0-30 PSIG, STEM
RLY-1	1 AS-RLY002-0	RELAY; 2SPDT 5 AMP 240VAC



SUPPLY FAN WIRING DIAGRAM

DESCRIPTION OF OPERATION

STARTING OF THE HVU SUPPLY FAN WILL INITIATE A START OF THE LEAD SMOKE EXHAUST FAN SEF-3 OR SEF-4. IF THE LEAD FAN FAILS OR FAILS TO START, THE LAG EXHAUST FAN SEF-3 OR SEF-4 WILL START AND RUN CONTINUOUSLY.

THE METASYS SYSTEM WILL DETERMINE THE "OCCUPIED AND UNOCCUPIED" MODES OF OPERATION. OCCUPIED MODES GENERALLY OCCUR DURING STADIUM EVENTS, BUT MANUAL OVERRIDE THROUGH THE METASYS SYSTEM ON SELECTED UNITS WILL FREQUENTLY BE REQUIRED. WHEN THE UNIT AND SMOKE EXHAUST FAN ARE DE-ENERGIZED, OUTSIDE AIR DAMPER D-13-1, WILL CLOSE. HEATING COIL VALVE V-H-13 WILL BE CLOSED TO THE COIL.

OCCUPIED HEATING MODE - SUPPLY FAN WILL BE RUNNING. OUTSIDE AIR DAMPER D-13-1 WILL OPEN. ROOM SENSOR TR-13 THROUGH THE METASYS SYSTEM CONTROL UNIT, WILL ON A RISE IN TEMPERATURE ABOVE ITS SETTING OF SEVENTY-FIVE (75F) MODULATE V-H-13 CLOSED TO THE HEATING COIL. ON A FALL IN TEMPERATURE, THIS CYCLE IS REVERSED.


UNOCCUPIED HEATING MODE - ROOM SENSOR TR-13, WILL ON A FALL IN TEMPERATURE TO ITS SETTING OF FIFTY (50F), ACTIVATE THE SYSTEM TO RUN IN THE HEATING MODE AS HEREINBEFORE DESCRIBED. ON A RISE IN TEMPERATURE TO FIFTY-FIVE (55F), THE SYSTEM WILL BE DE-ENERGIZED. IN THE UNOCCUPIED MODE ALL AIR HANDLING UNIT DAMPERS AND CONTROLS WILL RETURN TO THEIR NORMAL POSITION READY FOR RESTARTING.

OCCUPIED VENTILATING MODE - SUPPLY AND SMOKE EXHAUST FANS START AND RUN CONTINUOUSLY. OUTSIDE AIR DAMPER D-13-1 WILL OPEN. HEATING COIL VALVE V-H-13 WILL BE CLOSED TO THE COIL.


UNOCCUPIED VENTILATING MODE - SYSTEM IS DE-ENERGIZED AND FANS ARE OFF.

SMOKE CONTROL - SMOKE DETECTORS FOR HVU-13 WILL, ON THE DETECTION OF PRODUCTS OF COMBUSTION, SHUT DOWN THE SUPPLY AND CLOSE OUTSIDE DAMPER D-13-1. CROSS ZONED CEILING SMOKE DETECTORS IN THE SERVICE CORRIDOR OR A SPRINKLER WATER FLOW ALARM ON THE SERVICE LEVEL WILL ENERGIZE THE TWO (2) SMOKE EXHAUST FANS THROUGH THE FIRE ALARM SYSTEM. HVU-11, HVU-12 AND HVU-13 SERVICE THE AREA WILL BE DE-ENERGIZED AND ALL THEIR DAMPERS WILL RETURN TO THEIR NORMALLY CLOSED POSITION WHEN THE SMOKE EXHAUST IS ENERGIZED BY THE FIRE ALARM SYSTEM. SERVICE LEVEL SMOKE EXHAUST FANS WILL BE AUTOMATICALLY AND MANUALLY STARTED AND STOPPED FROM THE FIRE ALARM SYSTEM. FIRE ALARM SYSTEM CONTROL IS INDEPENDENT OF THE METASYS SYSTEM. TWO (2) SERVICE LEVEL EXIT CORRIDOR SMOKE EXHAUST SYSTEMS EXIST WITH A TOTAL OF FOUR (4) EXHAUST FANS. TWO (2) SMOKE EXHAUST FANS ARE RELATED TO THREE (3) HEATING AND VENTILATING UNITS. IF EITHER EXIT CORRIDOR SMOKE EXHAUST SYSTEM IS ACTIVATED, THE OTHER SYSTEM WILL ALSO BE ENERGIZED. FIRE ALARM SYSTEM CONTROL IS INDEPENDENT OF THE METASYS SYSTEM.

SMOKE EXHAUST FAN SEF-3 DIAGRAM


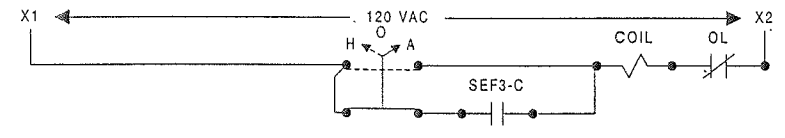


SMOKE EXHAUST FAN SEF-4 DIAGRAM

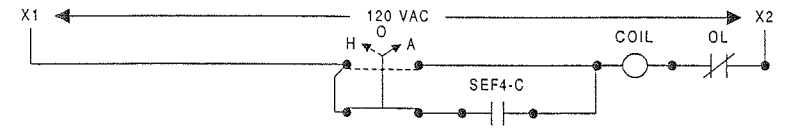

FAN	LOCATION	ELEC PANEL	STARTER	LOCATION
HVU-13	SERVICE LEVEL		LOCAL	SERVICE LEVEL
SEF-3	SERVICE LEVEL		LOCAL	SERVICE LEVEL
SEF-4	SERVICE LEVEL		LOCAL	SERVICE LEVEL

NOTE: FOR SMOKE EXHAUST FANS SEF-3 AND SEF-4 METASYS POINT CONNECTIONS SEE AHU-13 CONTROL DIAGRAM BL-6559-18 POINT LIST NCM-5 PS-4

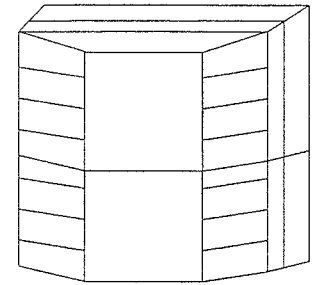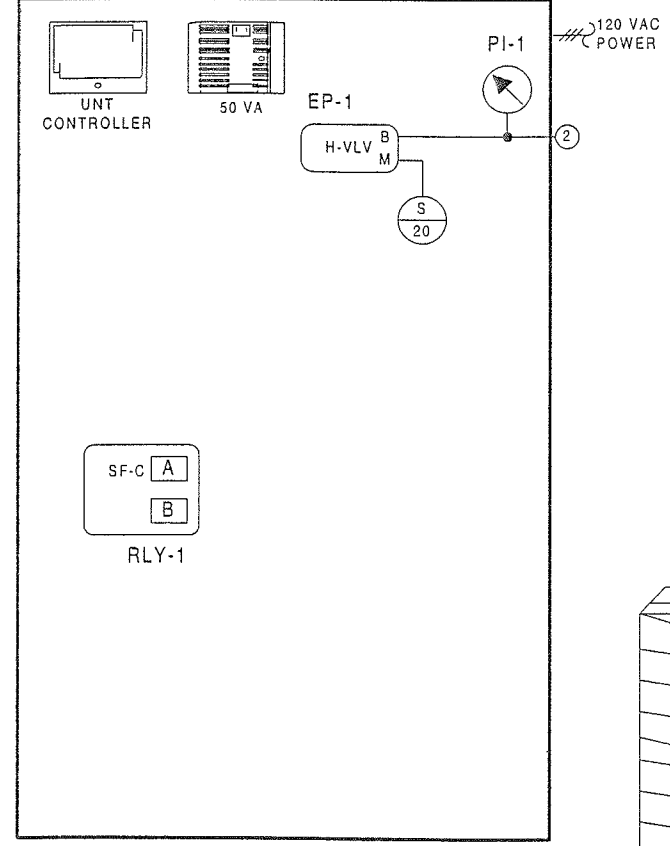


ENCLOSURE EN-HVU-13 AS-UNT111-101 LOCATED ADJACENT TO UNIT NCM-5/N2 ADD = 23

REVISION INFORMATION NUMBER DATE 07/18/00 TIME 03:35 PM FILE NAME HVU-13.vsd	IN CONSIDERATION OF THE RECEIPT OF THIS DOCUMENT, THE RECIPIENT AGREES NOT TO REPRODUCE, COPY, USE OR TRANSMIT THIS DOCUMENT AND/OR THE INFORMATION THEREIN CONTAINED, IN WHOLE OR IN PART, OR TO SUFFER SUCH ACTION BY OTHERS, FOR ANY PURPOSE, EXCEPT WITH THE WRITTEN PERMISSION OF JOHNSON CONTROLS, INC. AND FURTHER AGREES TO SURRENDER SAME TO JOHNSON CONTROLS, INC. UPON DEMAND. COPYRIGHT JOHNSON CONTROLS, INC. 1998	DRAWING TITLE HEAT-VENT UNIT HVU-13 FREIGHT ELEVATOR LOBBY SERVICE LEVEL QUAD B PROJECT TITLE BALTIMORE NFL STADIUM AT CAMDEN YARDS BALTIMORE, MARYLAND	<table border="1"> <tr> <td>AS-BUILT</td> <td>7/18/00</td> <td>CME</td> </tr> <tr> <td>REFERENCE DRAWING NO.</td> <td>REVISION-LOCATION</td> <td>ECN DATE BY</td> </tr> <tr> <td>Sales Engineer JDP</td> <td>Project Manager WJT</td> <td>Application Engineer RTS</td> </tr> <tr> <td colspan="2">DRAWN BY RTS DATE 09/09/97</td> <td>APPROVED BY DATE</td> </tr> </table>	AS-BUILT	7/18/00	CME	REFERENCE DRAWING NO.	REVISION-LOCATION	ECN DATE BY	Sales Engineer JDP	Project Manager WJT	Application Engineer RTS	DRAWN BY RTS DATE 09/09/97		APPROVED BY DATE
AS-BUILT	7/18/00	CME													
REFERENCE DRAWING NO.	REVISION-LOCATION	ECN DATE BY													
Sales Engineer JDP	Project Manager WJT	Application Engineer RTS													
DRAWN BY RTS DATE 09/09/97		APPROVED BY DATE													
		JOHNSON CONTROLS Systems & Services Division	Branch information JOHNSON CONTROLS 60 LOVETON CIRCLE SPARKS, MD 21152												
		CONTRACT NUMBER 7052-0098	DRAWING NUMBER BL-6559-41												

Full Spreadsheet		Software				Digital Controller Information						Panel Information				Intermediate Device					Field Device						
Tag	Point Type	System Name	Object Name	Expanded ID	Display Units	DC Type	N2 Trunk	N2 Addr	Cable Destination Bay/Terminal	Module Type	Termination	Panel	Panel Location	Slot Number	Reference Drawing	Cable Number	Wiring/Tubing	Termination In	Device	Termination Out	Location	Wiring/Tubing	Terminations	Device	Location	Ref Detail	Comment
		HVU-13				UNT						EN-HVU13	Service Level B		M.2-01B												Power to Controller
		HVU-13				UNT		23				EN-HVU13	Service Level B		01M.2-01B												N2 Trunk
AI-1		HVU-13				UNT		23	AI-1			EN-HVU13	Service Level B		01M.2-01B	HVU13-23-AI-1											
AI-2		HVU-13				UNT		23	AI-2			EN-HVU13	Service Level B		01M.2-01B	HVU13-23-AI-2											
AI-3		HVU-13				UNT		23	AI-3			EN-HVU13	Service Level B		01M.2-01B	HVU13-23-AI-3											
AI-4		HVU-13	ZN-T	Zone Temperature	Deg F	UNT		23	AI-4	PHONE JACK		EN-HVU13	Service Level B		01M.2-01B	HVU13-23-AI-4					8/26	PHONE JACK	TE-6410W-1000		U2		
AI-5		HVU-13				UNT		23	AI-5			EN-HVU13	Service Level B		01M.2-01B	HVU13-23-AI-5											
AI-6		HVU-13				UNT		23	AI-6			EN-HVU13	Service Level B		01M.2-01B	HVU13-23-AI-6											
BI-1		HVU-13	SF-S	Supply Fan Status	Off On	UNT		23	BI-1	BI#.24VAC		EN-HVU13	Service Level B		01M.2-01B	HVU13-23-BI-1					2/22	Device dependent	Aux Contact (NO)		U70		
BI-2		HVU-13	SMK-DET	Smoke Detectors	Normal Alarm	UNT		23	BI-2	BI#.24VAC		EN-HVU13	Service Level B		01M.2-01B	HVU13-23-BI-2					2/22	Device dependent	Contact (NO)		U70		
BI-3		HVU-13	LT-S	Low Temperature Stat	Normal Alarm	UNT		23	BI-3	BI#.24VAC		EN-HVU13	Service Level B		01M.2-01B	HVU13-23-BI-3					2/22	NO.M1	A70 (NC)		U71		
BI-4		HVU-13				UNT		23	BI-4			EN-HVU13	Service Level B		01M.2-01B	HVU13-23-BI-4											
BO-1		HVU-13	SF-C	Supply Fan Control	Off On	UNT		23	BO-1	RLY BO#.24V.COM		EN-HVU13	Service Level B		01M.2-01B	HVU13-23-BO-1	3/18	A.COILS.COM	RELAY-A	NO.COM		2/14	See starter detail	Starter (NO)-(sw lo)		U60	
BO-2		HVU-13				UNT		23	BO-2			EN-HVU13	Service Level B		01M.2-01B	HVU13-23-BO-2											
BO-3		HVU-13				UNT		23	BO-3			EN-HVU13	Service Level B		01M.2-01B	HVU13-23-BO-3											
BO-4		HVU-13				UNT		23	BO-4			EN-HVU13	Service Level B		01M.2-01B	HVU13-23-BO-4											
BO-5		HVU-13				UNT		23	BO-5			EN-HVU13	Service Level B		01M.2-01B	HVU13-23-BO-5											
BO-6		HVU-13				UNT		23	BO-6			EN-HVU13	Service Level B		01M.2-01B	HVU13-23-BO-6											
AO-1		HVU-13	H-VLV	Heating Coil Valve	% Open	UNT		23	AO-1	AO#.AOCM.24V		EN-HVU13	Service Level B		01M.2-01B	HVU13-23-AO-1	2/18	+-	EP-8000-2	SUPPLY_O		3/18	Device dependant	0-10V OUT		U23	
AO-2		HVU-13				UNT		23	AO-2			EN-HVU13	Service Level B		01M.2-01B	HVU13-23-AO-2											

BILL OF MATERIALS			70520098.prs
Estimate:	Qty	Part #	Description
cooling			
Desig.			
Field Devices:			
FS-1	1	F61KB-11C	SW. FLOW, SPDT, 1-6" PIPE
TC-1, 2, 3, 4	4	TE-631AP-1	SENS, T-NI, 0.1%, F/WZ1000-5
	4	WZ-1000-5	WELL, BRASS, 1/2"NPT+COMPND
V-CH-1	1	--	SEE VALVE SCHEDULE
Panel Devices:			
DC-1	1	DX-9100-8454	DIGITAL CONTR., EXTENDED
	1	DX-9100-8990	MTG BASE (DX9100-8454)
EN-COOL	1	EN-EWC25-0	UNIT/ PKG MOD, DUAL, W/50VA
EP-1	1	EP-8000-4	XDUCR, EP, 4-20ma, HI VOL
PI-1	1	G-2010-11	GAGE, 2", 0-30 PSIG, STEM
RLY-1, 2	2	AS-RLY002-0	RELAY; 2SPDT 5 AMP 240VAC

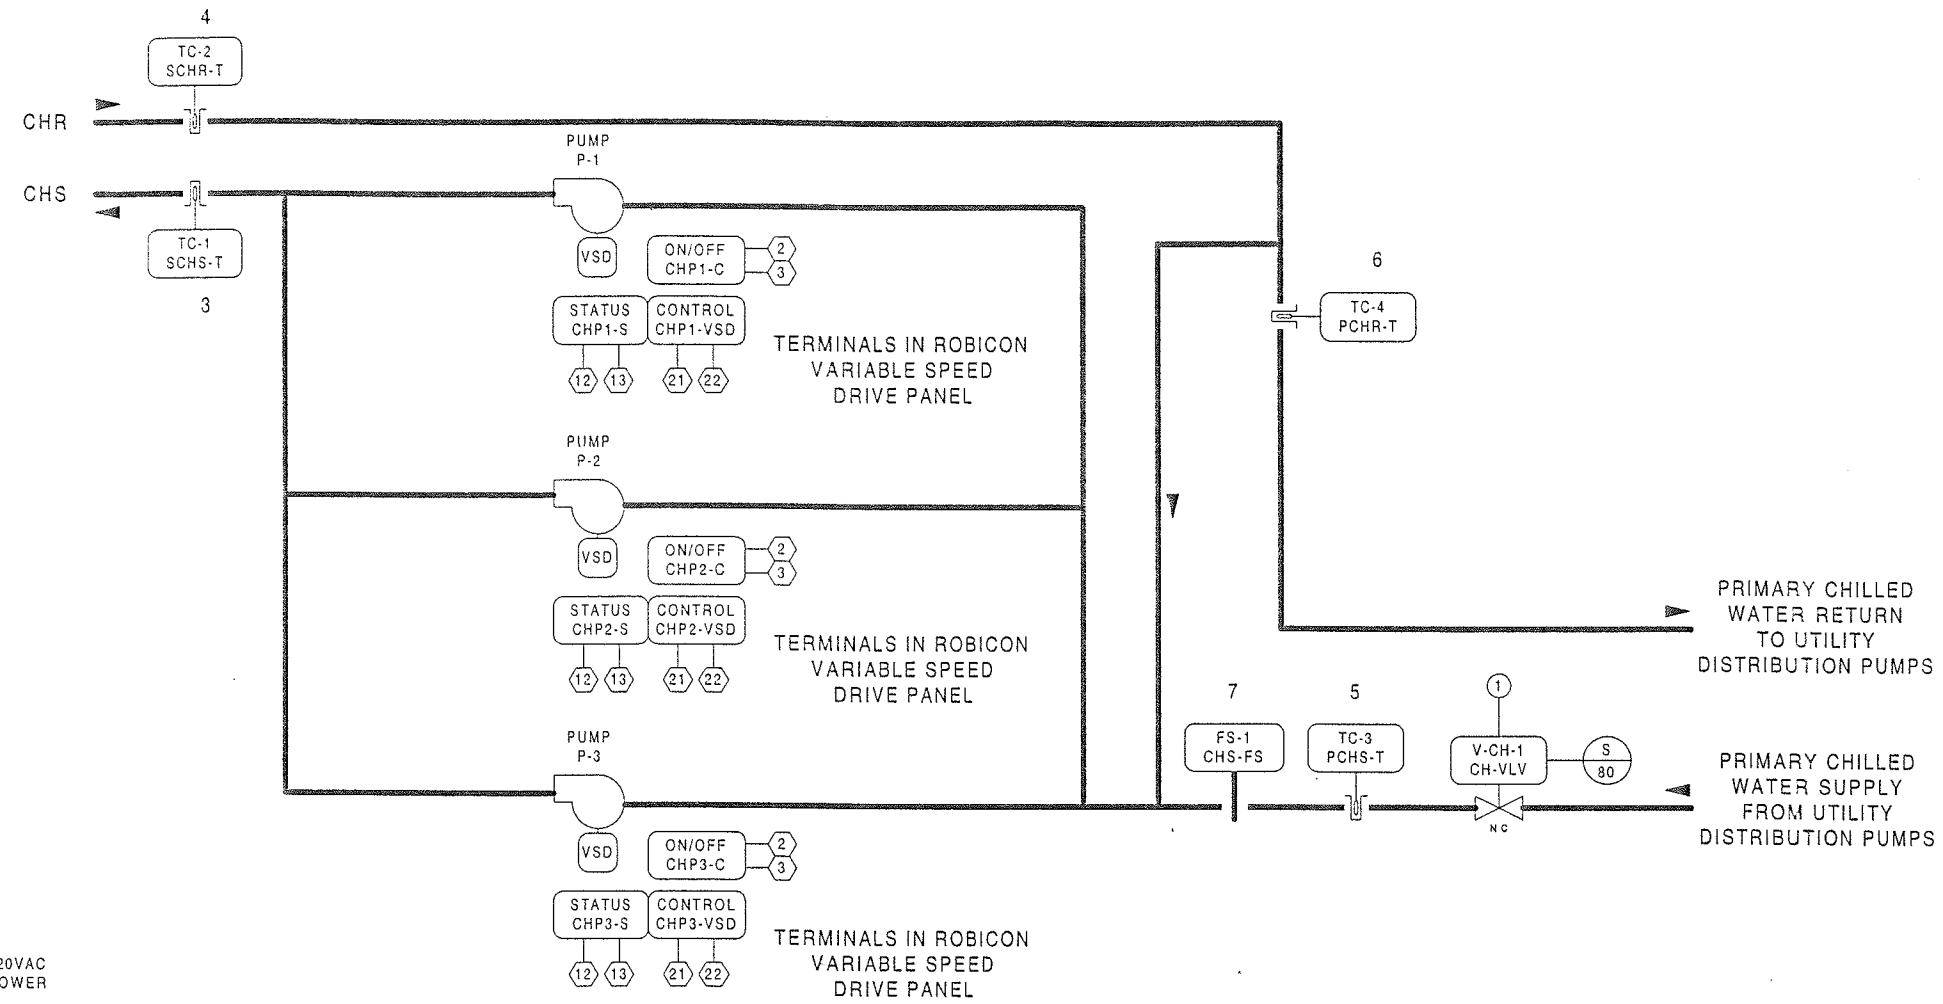


**PRIMARY CHILLED WATER PUMPS
UTILITY FLOW METER
AND BY-PASS VALVE
PROVIDED BY CHILLED
WATER UTILITY COMPANY**

FOR WATER LINE CONNECTIONS
SEE AHU-3 DRAWING BL-6559-07
FOR POINT CONNECTIONS
SEE POINT SCHEDULE
NCM-3/PS-1

FOR WATER LINE CONNECTIONS
SEE FCU DRAWING BL-6559-09
FOR POINT CONNECTIONS
SEE POINT SCHEDULE
NCM-3/PS-4

FOR WATER LINE CONNECTIONS
SEE AHU-4 DRAWING BL-6559-10
FOR POINT CONNECTIONS
SEE POINT SCHEDULE
NCM-4/PS-1

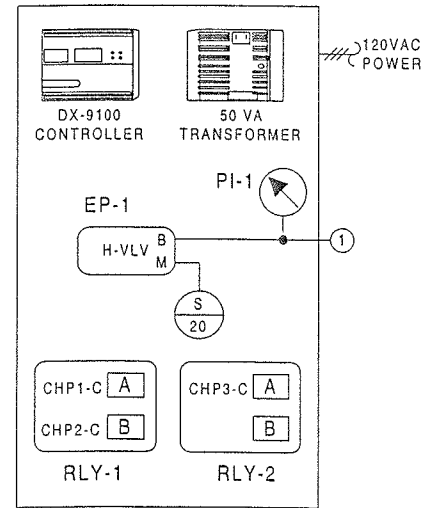

ENCLOSURE EN-COOL
DX-9100-8001
LOCATED IN MECHANICAL
ROOM
NCM-5/N2 ADD = 24

DESCRIPTION OF OPERATION

THE METASYS SYSTEM WILL CONTROL THE CHILLED WATER SYSTEM. WHEN THE SYSTEM IS DE-ENERGIZED, THE PRIMARY CHILLED WATER VALVE V-CH-1 WILL CLOSE AND BUILDING SECONDARY CHILLED WATER DISTRIBUTION PUMPS P-1, P-2, AND P-3 WILL BE OFF. CONTROL OF UTILITY DISTRIBUTION PUMPS WILL BE PROVIDED BY THE UTILITY COMPANY. WHEN THE CHILLED WATER SYSTEM IS ENERGIZED BY THE BUILDING HEATING-COOLING CONTROL, CHILLED WATER VALVE V-CH-1 WILL MODULATE OPEN TO ITS MAXIMUM POSITION. THE SECONDARY CHILLED WATER DISTRIBUTION PUMPS MAY BE STARTED MANUALLY OR THROUGH THE METASYS SYSTEM AFTER PRIMARY CHILLED WATER FLOW HAS BEEN CONFIRMED BY UTILITY FLOW METER AND SYSTEM FLOW SWITCH FS-1. THE VARIABLE FREQUENCY DRIVE (VFD) SYSTEM FOR THE SECONDARY CHILLED WATER DISTRIBUTION PUMPS WILL BE CONFIGURED WITH THREE (3) INDEPENDENT VFD CABINETS. ONE FOR EACH PUMP. VFD CABINETS WILL BE CAPABLE OF MANUAL OPERATION THROUGH OPERATOR INTERVENTION IF REQUIRED. AFTER PRIMARY CHILLED WATER FLOW HAS BEEN CONFIRMED, THE LEAD PUMP AS SELECTED BY THE METASYS SYSTEM LEAD/LAG PROGRAM AND ACTING THROUGH THE VFD WILL START AT REDUCED SPEED AND RUN CONTINUOUSLY. REDUCED SPEED STARTING WILL BE THE MINIMUM SETTING OF THE VARIABLE FREQUENCY PUMP DRIVE AND WILL BE FULLY ADJUSTABLE THROUGHOUT THE RANGE OF THE DRIVE. IF PUMP P-1 FAILS OR FAILS TO START AS SENSED BY THE VFD PANEL CONTACT, PUMP P-2 OR P-3 WILL AUTOMATICALLY START AND RUN CONTINUOUSLY. A FAILURE OF ANY DISTRIBUTION PUMP AS SENSED BY THEIR RESPECTIVE VFD PANEL CONTACT WILL BE ALARMED ON THE METASYS SYSTEM. EACH DISTRIBUTION PUMP WILL BE STARTED AT REDUCED SPEED THROUGH INDIVIDUAL VARIABLE FREQUENCY PUMP DRIVES AND SEQUENCED WITH THE PROGRAMMED LEAD/LAG OPERATION. THREE (3) DIFFERENTIAL PRESSURE TRANSMITTERS DPT-1, DPT-2 AND DPT-3 WITH ADJUSTABLE SETPOINT, THROUGH THE METASYS SYSTEM WILL MODULATE THE VARIABLE FREQUENCY PUMP DRIVE TO MAINTAIN THEIR SETPOINT. ON A FALL IN THE REQUIRED DIFFERENTIAL PRESSURE AS SENSED BY EITHER TRANSMITTER THE PUMP DRIVE WILL GRADUALLY INCREASE THE PUMP SPEED FROM MINIMUM TO MAXIMUM AS REQUIRED TO MAINTAIN THE SETPOINT. ON A RISE IN DIFFERENTIAL PRESSURE THE REVERSE WILL OCCUR. THREE (3) DIFFERENTIAL PRESSURE TRANSMITTERS DPT-1, DPT-2 AND DPT-3 AND THREE (3) TEMPERATURE SENSORS TC-5, TC-6 AND TC-7 WILL BE LOCATED THROUGHOUT THE STADIUM COMPLEX AS FOLLOWS:

DPT-1 AND TC-5 WILL BE LOCATED ADJACENT TO AHU-3 ON THE PRESS LEVEL QUAD C
DPT-2 AND TC-6 WILL BE LOCATED AT THE TOP OF HYDRAULICALLY REMOTE CHS AND CHR RISER SERVING SUITES UPPER SUITES QUAD C
DPT-3 AND TC-7 WILL BE LOCATED ADJACENT TO AHU-4 ON THE PRESS LEVEL QUAD D

ON A CONTINUED FALL IN DIFFERENTIAL PRESSURE AS SENSED BY EITHER TRANSMITTER WITH PUMP P-1 AT MAXIMUM SPEED, A SECOND OR LAG DISTRIBUTION PUMP P-2 OR P-3 AS APPLICABLE WILL BE STARTED. PRIOR TO STARTING THE SECOND PUMP, P-1 WILL BE REDUCED TO FIFTY (50) PERCENT FULL LOAD. THE SECOND PUMP WILL BE STARTED THROUGH ITS VARIABLE FREQUENCY DRIVE AT REDUCED SPEED. WHEN THE SECOND PUMP IS PROVEN OPERATIONAL BY ITS RESPECTIVE VFD PANEL CONTACT, BOTH PUMPS WILL BE GRADUALLY MODULATED AT THE SAME SPEED TO MAINTAIN THE SETPOINTS OF THE DPT-1, DPT-2 OR DPT-3 AS DETERMINED THROUGH THE METASYS SYSTEM. ON A CONTINUED FALL IN DIFFERENTIAL PRESSURE AS SENSED BY EITHER TRANSMITTER WITH PUMPS P-1 AND P-2 AT MAXIMUM SPEED, THE THIRD DISTRIBUTION PUMP P-3 WILL BE STARTED. PRIOR TO STARTING THE THIRD PUMP, P-1 AND P-2 WILL BE REDUCED TO SIXTY-SEVEN (67) PERCENT FULL LOAD. THE THIRD PUMP WILL BE STARTED THROUGH ITS VARIABLE FREQUENCY PUMP DRIVE AT REDUCED SPEED. WHEN THE THIRD PUMP IS PROVEN OPERATIONAL BY ITS RESPECTIVE VFD PANEL CONTACT, ALL THREE (3) PUMPS WILL BE GRADUALLY MODULATED AT THE SAME SPEED TO MAINTAIN THE SETPOINTS OF THE DPT-1, DPT-2 OR DPT-3 AS DETERMINED THROUGH THE METASYS SYSTEM. ON A RISE IN DIFFERENTIAL PRESSURE ABOVE THE SETPOINT OF ALL TRANSMITTERS THE REVERSE SEQUENCE WILL OCCUR. WHEN ALL THREE (3) DISTRIBUTION PUMPS HAVE BEEN REDUCED IN SPEED TO SIXTY-SEVEN (67) PERCENT OF THE MAXIMUM SPEED (ADJUSTABLE) PUMP P-1 WILL BE STOPPED. PUMPS P-2 AND P-3 WILL AGAIN BE GRADUALLY MODULATED AT THE SAME SPEED TO MAINTAIN THE SETPOINTS OF DPT-1, DPT-2 OR DPT-3. ON A CONTINUED RISE IN DIFFERENTIAL PRESSURE WITH PUMPS P-2 AND P-3 REDUCED IN SPEED TO FIFTY (50) PERCENT OF THE MAXIMUM SPEED (ADJUSTABLE) PUMP P-2 WILL BE STOPPED. PUMP P-3 WILL BE GRADUALLY MODULATED TO MAINTAIN THE SETPOINTS OF DPT-1, DPT-2 OR DPT-3. DISTRIBUTION PUMP CYCLES WILL BE LIMITED BY AN ADJUSTABLE TIME PERIOD OF ONE (1) HOUR. PUMP STARTS AND STOPS WILL BE LIMITED BY THE TIME PERIOD AND INDICATED ON THE METASYS SYSTEM. DISTRIBUTION PUMPS OPERATING IN PARALLEL WILL RUN AT THE SAME SPEED THROUGH THEIR RESPECTIVE VFD. SPEED ADJUSTMENTS WILL OCCUR QUICKLY WHEN A PUMP IS BROUGHT ON LINE. TEMPERATURE SENSOR TC-1 LOCATED IN THE CHILLED WATER SUPPLY LINE DOWNSTREAM OF PUMPS P-1, P-2 AND P-3 WILL MODULATE VALVE V-CH-1 TO MAINTAIN ITS SETTING OF THIRTY-SIX (36F). TEMPERATURE SENSORS TC-2, TC-3 AND TC-4 WILL MONITOR CHILLED WATER TEMPERATURE AT LOCATIONS INDICATED. UTILITY FLOW METER WILL BE USED TO MONITOR AND TEND CHILLED WATER CONSUMPTION AT THE FACILITY. DURING A STADIUM EVENT, THE METASYS SYSTEM WILL BE PROGRAMMED TO TEND THE TEMPERATURE READINGS FROM TC-1, TC-2, TC-3 AND TC-4; RECORD PRIMARY CHILLED WATER FLOW; AND INDICATE SECONDARY CHILLED WATER DISTRIBUTION PUMP OPERATION IN TEN MINUTE INCREMENTS.

REVISION INFORMATION	IN CONSIDERATION OF THE RECEIPT OF THIS DOCUMENT, THE RECIPIENT AGREES NOT TO REPRODUCE, COPY, USE OR TRANSMIT THIS DOCUMENT AND/OR THE INFORMATION THEREIN CONTAINED, IN WHOLE OR IN PART, OR TO SUFFER SUCH ACTION BY OTHERS, FOR ANY PURPOSE, EXCEPT WITH THE WRITTEN PERMISSION OF JOHNSON CONTROLS, INC. AND FURTHER AGREES TO SURRENDER SAME TO JOHNSON CONTROLS, INC. UPON DEMAND. COPYRIGHT JOHNSON CONTROLS, INC. 1998	DRAWING TITLE	CHILLED WATER SYSTEM																																																							
NUMBER		PROJECT TITLE	MECHANICAL ROOM NORTH SERVICE LEVEL QUAD A																																																							
DATE		07/18/00	BALTIMORE NFL STADIUM AT CAMDEN YARDS																																																							
TIME		03:37 PM	BALTIMORE, MARYLAND																																																							
SCALE		COOLING.vsd	<table border="1"> <tr> <td>AS-BUILT</td> <td></td> <td></td> <td></td> <td>7/18/00</td> <td>CME</td> </tr> <tr> <td>REFERENCE DRAWING</td> <td>NO.</td> <td>REVISION/LOCATION</td> <td>EGN</td> <td>DATE</td> <td>BY</td> </tr> <tr> <td>Sales Engineer</td> <td>JDP</td> <td>Project Manager</td> <td>WJT</td> <td>Application Engineer</td> <td>RTS</td> </tr> <tr> <td colspan="2">BY</td> <td>DATE</td> <td colspan="2">09/10/97</td> <td>BY</td> </tr> <tr> <td colspan="2">DATE</td> <td colspan="2">09/10/97</td> <td colspan="2">DATE</td> </tr> <tr> <td colspan="3">Branch Information</td> <td colspan="3">CONTRACT NUMBER</td> </tr> <tr> <td colspan="3">JOHNSON CONTROLS</td> <td colspan="3">7052-0098</td> </tr> <tr> <td colspan="3">Systems & Services Division</td> <td colspan="3">DRAWING NUMBER</td> </tr> <tr> <td colspan="3">60 LOVETON CIRCLE SPARKS, MD 21152</td> <td colspan="3">BL-6559-42</td> </tr> </table>			AS-BUILT				7/18/00	CME	REFERENCE DRAWING	NO.	REVISION/LOCATION	EGN	DATE	BY	Sales Engineer	JDP	Project Manager	WJT	Application Engineer	RTS	BY		DATE	09/10/97		BY	DATE		09/10/97		DATE		Branch Information			CONTRACT NUMBER			JOHNSON CONTROLS			7052-0098			Systems & Services Division			DRAWING NUMBER			60 LOVETON CIRCLE SPARKS, MD 21152			BL-6559-42	
AS-BUILT				7/18/00	CME																																																					
REFERENCE DRAWING	NO.	REVISION/LOCATION	EGN	DATE	BY																																																					
Sales Engineer	JDP	Project Manager	WJT	Application Engineer	RTS																																																					
BY		DATE	09/10/97		BY																																																					
DATE		09/10/97		DATE																																																						
Branch Information			CONTRACT NUMBER																																																							
JOHNSON CONTROLS			7052-0098																																																							
Systems & Services Division			DRAWING NUMBER																																																							
60 LOVETON CIRCLE SPARKS, MD 21152			BL-6559-42																																																							

Full Spreadsheet		Software				Digital Controller Information					Panel Information				Intermediate Device				Field Device				Ref Detail	Comment						
Tag	Point Type	System Name	Object Name	Expanded ID	Display Units	DC Type	N2 Trunk	N2 Addr	Cable Destination Bqy/Terminal	Module Type	Termination	Panel	Panel Location	Slot Number	Reference Drawing	Cable Number	Wiring/Tubing	Termination In	Device	Termination Out	Location	Wiring/Tubing	Terminations	Device	Location	Ref Detail	Comment			
		COOLING				DX9100						EN-COOL	Service Lev MER A		IM_3-14												Power to Controller			
		COOLING				DX9100		24				EN-COOL	Service Lev MER A		IM_3-14												N2 Trunk			
DI-1		COOLING	CHP1-S	Chill Wtr Pump 1 Status	Off On	DX9100		24	DI-1			DI#.COM	EN-COOL	Service Lev MER A		IM_3-14						2/22	Device dependent	Aux Contact (NO)		D70				
DI-2		COOLING	CHP2-S	Chill Wtr Pump 2 Status	Off On	DX9100		24	DI-2			DI#.COM	EN-COOL	Service Lev MER A		IM_3-14						2/22	Device dependent	Aux Contact (NO)		D70				
DI-3		COOLING	CHP3-S	Chill Wtr Pump 3 Status	Off On	DX9100		24	DI-3			DI#.COM	EN-COOL	Service Lev MER A		IM_3-14						2/22	Device dependent	Aux Contact (NO)		D70				
DI-4		COOLING	CHS-FS	Chill Wtr Sup Flow Sw	Open Closed	DX9100		24	DI-4			DI#.COM	EN-COOL	Service Lev MER A		IM_3-14						2/22	Device dependent	Contact (NO)		D70				
DI-5		COOLING				DX9100		24	DI-5				EN-COOL	Service Lev MER A		IM_3-14						2/22	Device dependent	Contact (NO)		D70				
DI-6		COOLING				DX9100		24	DI-6				EN-COOL	Service Lev MER A		IM_3-14														
DI-7		COOLING				DX9100		24	DI-7				EN-COOL	Service Lev MER A		IM_3-14														
DI-8		COOLING				DX9100		24	DI-8				EN-COOL	Service Lev MER A		IM_3-14														
AO-1		COOLING	CH-VLV	Main Chill Wtr Valve	%	DX9100		24	AO-1			AO#.AOCOM	EN-COOL	Service Lev MER A		IM_3-14						2/18	EP-8000-2	SUPPLY_O		1/4"	Barb Fitting	EP-PNEU.	D22	
AO-2		COOLING	CHP1-VSD	Ch Wat Pmp 1 Var Spd Dr	%	DX9100		24	AO-2			AO#.AOCOM	EN-COOL	Service Lev MER A		IM_3-14						2/18	Device dependent	0-20mA OUT		D21				
AO-9		COOLING	CHP2-VSD	Ch Wat Pmp 2 Var Spd Dr	%	DX9100		24	AO-9			AO#.AOCOM	EN-COOL	Service Lev MER A		IM_3-14						2/18	Device dependent	0-20mA OUT		D21				
AO-10		COOLING	CHP3-VSD	Ch Wat Pmp 3 Var Spd Dr	%	DX9100		24	AO-10			AO#.AOCOM	EN-COOL	Service Lev MER A		IM_3-14						2/18	Device dependent	0-20mA OUT		D21				
AO-11		COOLING				DX9100		24	AO-11				EN-COOL	Service Lev MER A		IM_3-14														
AO-12		COOLING				DX9100		24	AO-12				EN-COOL	Service Lev MER A		IM_3-14														
AO-13		COOLING				DX9100		24	AO-13				EN-COOL	Service Lev MER A		IM_3-14														
AO-14		COOLING				DX9100		24	AO-14				EN-COOL	Service Lev MER A		IM_3-14														
DO-3		COOLING	CHP1-C	Chill Water Pump 1 Cntrl	Off On	DX9100		24	DO-3			RLY	DO#.24V.COM	EN-COOL	Service Lev MER A		IM_3-14					2/14	See starter detail	Starter (NO)		D60				
DO-4		COOLING	CHP2-C	Chill Water Pump 2 Cntrl	Off On	DX9100		24	DO-4			RLY	DO#.24V.COM	EN-COOL	Service Lev MER A		IM_3-14					2/14	See starter detail	Starter (NO)		D60				
DO-5		COOLING	CHP3-C	Chill Water Pump 3 Cntrl	Off On	DX9100		24	DO-5			RLY	DO#.24V.COM	EN-COOL	Service Lev MER A		IM_3-14					2/14	See starter detail	Starter (NO)		D60				
DO-6		COOLING				DX9100		24	DO-6				EN-COOL	Service Lev MER A		IM_3-14						2/14	See starter detail	Starter (NO)		D60				
DO-7		COOLING				DX9100		24	DO-7				EN-COOL	Service Lev MER A		IM_3-14														
DO-8		COOLING				DX9100		24	DO-8				EN-COOL	Service Lev MER A		IM_3-14														
AI-1		COOLING	PCHS-T	Pri Chill Wtr Supply Temp	Deg F	DX9100		24	AI-1			AI#.AICOM	EN-COOL	Service Lev MER A		IM_3-14						2/18	2-Wire	TE-631AP-1		D3				
AI-2		COOLING	PCHR-T	Pri Chill Wtr Return Temp	Deg F	DX9100		24	AI-2			AI#.AICOM	EN-COOL	Service Lev MER A		IM_3-14						2/18	2-Wire	TE-631AP-1		D3				
AI-3		COOLING	SCHS-T	Sec Chill Wtr Supply Temp	Deg F	DX9100		24	AI-3			AI#.AICOM	EN-COOL	Service Lev MER A		IM_3-14						2/18	2-Wire	TE-631AP-1		D3				
AI-4		COOLING	SCHR-T	Sec Chill Wtr Supply Temp	Deg F	DX9100		24	AI-4			AI#.AICOM	EN-COOL	Service Lev MER A		IM_3-14						2/18	2-Wire	TE-631AP-1		D3				
AI-5		COOLING				DX9100		24	AI-5				EN-COOL	Service Lev MER A		IM_3-14						2/18	2-Wire	TE-631AP-1		D3				
AI-6		COOLING				DX9100		24	AI-6				EN-COOL	Service Lev MER A		IM_3-14														
AI-7		COOLING				DX9100		24	AI-7				EN-COOL	Service Lev MER A		IM_3-14														
AI-8		COOLING				DX9100		24	AI-8				EN-COOL	Service Lev MER A		IM_3-14														


Estimate: heating
 Desig. QtyPart # Description

Field Devices:

HL1-T, HL2-T	2	T-8020-1	CONTRLR, IMMERSION, PROP
TH-1, 2, 4, 5, 6, 8, 7, 8, 9	8	TE-631AP-1	WELL, BRASS, F/T-8020
TH-1, 2, 4, 5, 6, 8, 7, 8, 9	8	WZ-1000-5	WELL, BRASS, 1/2"NPT+COMPND
V-H-1, V-H-2	4	--	SEE VALVE SCHEDULE
V-HW-1, 2, 4	3	--	SEE VALVE SCHEDULE

Panel Devices:

DC-1	1	DX-9100-8454	DIGITAL CONTR.. EXTENDED
EN-HEAT	1	DX-9100-8990	MTG BASE (DX9100-8454)
EP-1, 2, 3	3	EN-EWC25-0	UNIV PKG MOD, DUAL, W/50VA
PI-1, 2, 3	3	EP-8000-4	XDUCCR, EP, 4-20ma, HI VOL
RLY-1, 2, 3	3	G-2010-11	GAGE, 2", 0-30 PSIG, STEM
	3	AS-RLY002-0	RELAY; 2SPDT 5 AMP 240VAC

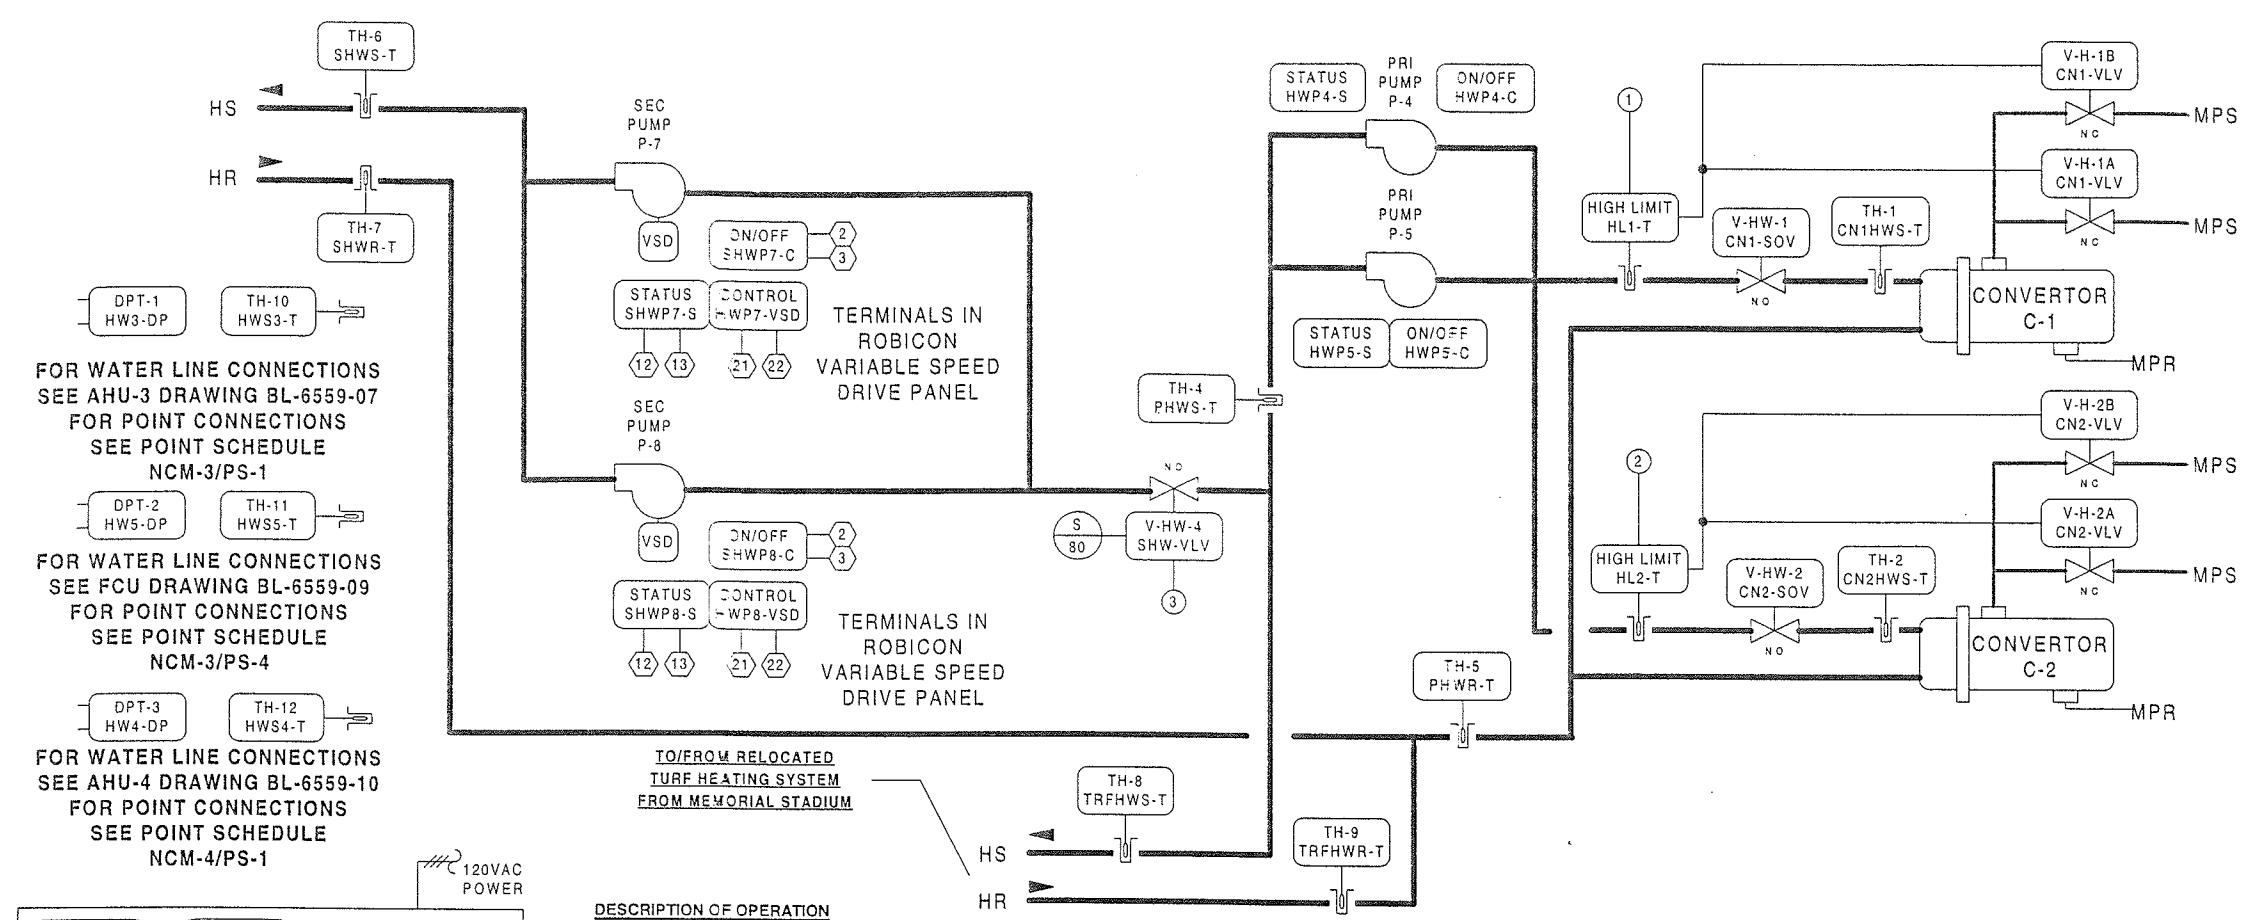

FOR WATER LINE CONNECTIONS
 SEE AHU-3 DRAWING BL-6559-07
 FOR POINT CONNECTIONS
 SEE POINT SCHEDULE
 NCM-3/PS-1

FOR WATER LINE CONNECTIONS
 SEE FCU DRAWING BL-6559-09
 FOR POINT CONNECTIONS
 SEE POINT SCHEDULE
 NCM-3/PS-4



FOR WATER LINE CONNECTIONS
 SEE AHU-4 DRAWING BL-6559-10
 FOR POINT CONNECTIONS
 SEE POINT SCHEDULE
 NCM-4/PS-1

DESCRIPTION OF OPERATION

THE METASYS SYSTEM WILL CONTROL THE HOT WATER SYSTEM. WHEN THE SYSTEM IS DE-ENERGIZED, THE STEAM/HEATING WATER CONVERTERS AND BUILDING HEATING PUMPS WILL BE OFF. THE HEATING SYSTEM WILL GENERALLY RUN ALL YEAR WITH REDUCED CAPACITY IN THE COOLING SEASON. WHEN THE HEATING WATER SYSTEM IS ENERGIZED, THE PRIMARY HEATING WATER PUMPS AND CONVERTERS WILL BE BROUGHT ON-LINE IN STAGES TO MAINTAIN PROGRAMMED HEATING WATER TEMPERATURE DIFFERENCE. THE LEAD PUMP P-4 AND CONVERTOR C-1 AS SELECTED BY THE METASYS SYSTEM LEAD/LAG PROGRAM WILL BE ENERGIZED TO START AND RUN CONTINUOUSLY AFTER ISOLATION VALVE V-HW-1 OPENS. IF THE LEAD COMPONENTS FAIL OR FAIL TO START AS SENSED BY THEIR RESPECTIVE AUX CONTACT, THE LAG COMPONENTS WILL AUTOMATICALLY START AND RUN CONTINUOUSLY. A FAILURE OF ANY COMPONENT AS SENSED BY THEIR RESPECTIVE AUX CONTACT WILL BE ALARMED ON THE METASYS SYSTEM. STEAM CONTROL VALVES V-H-1A AND V-H-1B SERVING CONVERTOR C-1 WILL BE MODULATED IN SEQUENCE BY TEMPERATURE SENSOR TH-1 TO MAINTAIN HEATING WATER SUPPLY TEMPERATURE OF 200F. CONTROL FOR CONVERTOR C-2 WILL BE SIMILAR TO C-1 AND INDEPENDENT OF EACH OTHER. EACH CONVERTOR WILL BE PROVIDED WITH A HIGH LIMIT THERMOSTAT IN THE SUPPLY LINE WHICH WILL PREVENT SUPPLY WATER TEMPERATURE FROM EXCEEDING 210F. PRIMARY HEATING WATER SUPPLY AND RETURN WATER TEMPERATURE SENSORS TH-4 AND TH-5 WILL BE USED TO STAGE CONVERTOR OPERATION. WITH THE LEAD HEATING PUMP AND CONVERTOR OPERATIONAL, IF THE HEATING WATER TEMPERATURE DIFFERENCE EXCEEDS TWENTY-FOUR (24F) THE LAG HEATING PUMP AND CONVERTOR WILL BE ENERGIZED. THE SYSTEM DESIGN REQUIRES A MAXIMUM OF TWO (2) CONVERTORS TO CARRY THE BUILDING LOAD. WHEN TWO (2) HEATING PUMPS AND CONVERTORS ARE OPERATIONAL AND THE PRIMARY HEATING WATER TEMPERATURE DIFFERENCE IS REDUCED TO TWELVE (12F), THE LEAD PUMP AND CONVERTOR WILL BE DE-ENERGIZED. THE VARIABLE FREQUENCY DRIVE (VFD) SYSTEM FOR THE SECONDARY HEATING WATER DISTRIBUTION PUMPS WILL BE CONFIGURED WITH TWO (2) INDEPENDENT VFD CABINETS, ONE FOR EACH PUMP. VFD CABINETS WILL BE CAPABLE OF MANUAL OPERATION THROUGH OPERATOR INTERVENTION IF REQUIRED. AFTER PRIMARY HEATING WATER FLOW HAS BEEN CONFIRMED, THE LEAD PUMP AS SELECTED BY THE METASYS SYSTEM LEAD/LAG PROGRAM AND ACTING THROUGH THE VFD WILL START AT REDUCED SPEED AND RUN CONTINUOUSLY. REDUCED SPEED STARTING WILL BE THE MINIMUM SETTING OF THE VARIABLE FREQUENCY PUMP DRIVE AND WILL BE FULLY ADJUSTABLE THROUGHOUT THE RANGE OF THE DRIVE. IF PUMP P-7 FAILS OR FAILS TO START AS SENSED BY THE VFD PANEL CONTACT, PUMP P-8 WILL AUTOMATICALLY START AND RUN CONTINUOUSLY. A FAILURE OF ANY DISTRIBUTION PUMP AS SENSED BY THEIR RESPECTIVE VFD PANEL CONTACT WILL BE ALARMED ON THE METASYS SYSTEM. EACH DISTRIBUTION PUMP WILL BE STARTED AT REDUCED SPEED THROUGH INDIVIDUAL VARIABLE FREQUENCY PUMP DRIVES AND SEQUENCED WITH THE PROGRAMMED LEAD/LAG OPERATION. THREE (3) DIFFERENTIAL PRESSURE TRANSMITTERS DPT-1, DPT-2 AND DPT-3 WITH ADJUSTABLE SETPOINT, THROUGH THE METASYS SYSTEM WILL MODULATE THE VARIABLE FREQUENCY PUMP DRIVE TO MAINTAIN THEIR SETPOINT. THE TRANSMITTER CALLING FOR AN INCREASE IN DIFFERENTIAL PRESSURE ABOVE ITS MINIMUM SETPOINT WILL TAKE CONTROL OF THE PUMP DRIVE. ON A FALL IN THE REQUIRED DIFFERENTIAL PRESSURE AS SENSED BY EITHER TRANSMITTER THE PUMP DRIVE WILL GRADUALLY INCREASE THE PUMP SPEED FROM MINIMUM TO MAXIMUM AS REQUIRED TO MAINTAIN THE SETPOINT. ON A RISE IN DIFFERENTIAL PRESSURE THE REVERSE WILL OCCUR. THREE (3) DIFFERENTIAL PRESSURE TRANSMITTERS DPT-1, DPT-2 AND DPT-3 AND THREE (3) TEMPERATURE SENSORS TH-10, TH-11 AND TH-12 WILL BE LOCATED THROUGHOUT THE STADIUM COMPLEX AS FOLLOWS:

- DPT-1 AND TH-10 WILL BE LOCATED ADJACENT TO AHU-3 ON THE PRESS LEVEL QUAD C
- DPT-2 AND TH-11 WILL BE LOCATED AT THE TOP OF HYDRAULICALLY REMOTE CHS AND CHR RISER SERVING SUITES UPPER SUITES QUAD C
- DPT-3 AND TH-12 WILL BE LOCATED ADJACENT TO AHU-4 ON THE PRESS LEVEL QUAD D

ON A CONTINUED FALL IN DIFFERENTIAL PRESSURE AS SENSED BY EITHER TRANSMITTER WITH PUMP P-7 AT MAXIMUM SPEED, THE LAG DISTRIBUTION PUMP P-8 WILL BE STARTED. PRIOR TO STARTING THE SECOND PUMP, P-7 WILL BE REDUCED TO FIFTY (50) PERCENT FULL LOAD. THE SECOND PUMP WILL BE STARTED THROUGH ITS VARIABLE FREQUENCY DRIVE AT REDUCED SPEED. WHEN THE SECOND PUMP IS PROVEN OPERATIONAL BY ITS RESPECTIVE VFD PANEL CONTACT, BOTH PUMPS WILL BE GRADUALLY MODULATED AT THE SAME SPEED TO MAINTAIN THE SETPOINTS OF THE DPT-1, DPT-2 OR DPT-3 AS DETERMINED THROUGH THE METASYS SYSTEM. ON A RISE IN DIFFERENTIAL PRESSURE ABOVE THE SETPOINT OF ALL TRANSMITTERS THE REVERSE SEQUENCE WILL OCCUR. WHEN BOTH DISTRIBUTION PUMPS HAVE BEEN REDUCED IN SPEED TO FIFTY (50) PERCENT OF THE MAXIMUM SPEED (ADJUSTABLE) PUMP P-7 WILL BE STOPPED. PUMP P-8 WILL AGAIN BE GRADUALLY MODULATED AT THE SAME SPEED TO MAINTAIN THE SETPOINTS OF DPT-1, DPT-2 OR DPT-3. DISTRIBUTION PUMP, HEATING PUMP AND CONVERTOR CYCLES WILL BE LIMITED BY AN ADJUSTABLE TIME PERIOD OF ONE (1) HOUR. PUMP STARTS AND STOPS WILL BE LIMITED BY THE TIME PERIOD AND INDICATED ON THE METASYS SYSTEM. DISTRIBUTION PUMPS OPERATING IN PARALLEL WILL RUN AT THE SAME SPEED THROUGH THEIR RESPECTIVE VFD. SPEED ADJUSTMENTS WILL OCCUR QUICKLY WHEN A PUMP IS BROUGHT ON LINE. TEMPERATURE SENSOR TH-6 LOCATED IN THE SECONDARY HEATING WATER SUPPLY LINE DOWNSTREAM OF PUMPS P-7 AND P-8 WILL MODULATE VALVE V-HW-4 TO MAINTAIN ITS SETTING OF 200F AT ZERO (0F) OUTDOOR AIR TEMPERATURE. TEMPERATURE RESET WILL BE A LINEAR FUNCTION BETWEEN ZERO (0F) AND SIXTY-FIVE (65F) OUTDOOR AIR TEMPERATURE. AS OUTDOOR AIR TEMPERATURE RISES ABOVE 65F SUPPLY WATER WILL REMAIN CONSTANT AT 120F. DURING A STADIUM EVENT, THE METASYS SYSTEM WILL BE PROGRAMMED TO TREND THE TEMPERATURE READINGS FROM ALL SENSORS TH-1 THRU TH-9 AND INDICATE PUMP AND CONVERTOR OPERATION, INCLUDING TURF HEATING IN TEN (10) MINUTE INCREMENTS.

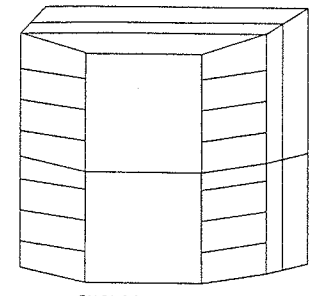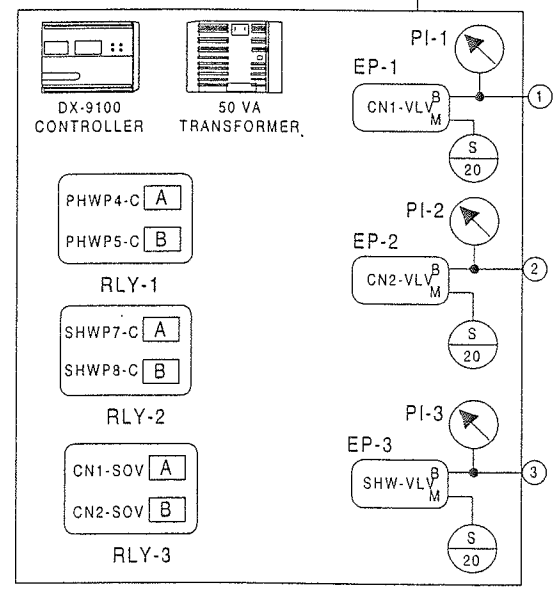

ENCLOSURE EN-HEAT
 DX-9100-8001
 LOCATED IN MECHANICAL
 ROOM
 NCM-5/N2 ADD = 25

REVISION INFORMATION
NUMBER
DATE
TIME
HEATING vs
DATE

IN CONSIDERATION OF THE RECEIPT OF THIS DOCUMENT, THE RECIPIENT AGREES NOT TO REPRODUCE, COPY, USE OR TRANSMIT THIS DOCUMENT AND/OR THE INFORMATION THEREIN CONTAINED, IN WHOLE OR IN PART, OR TO SUFFER SUCH ACTION BY OTHERS, FOR ANY PURPOSE, EXCEPT WITH THE WRITTEN PERMISSION OF JOHNSON CONTROLS, INC. AND FURTHER AGREES TO SURRENDER SAME TO JOHNSON CONTROLS, INC. UPON DEMAND.

COPYRIGHT JOHNSON CONTROLS, INC. 19nn

DRAWING TITLE
HOT WATER SYSTEM

MECHANICAL ROOM SOUTH
 SERVICE LEVEL QUAD B


PROJECT TITLE
**BALTIMORE NFL STADIUM
 AT CAMDEN YARDS**

BALTIMORE, MARYLAND

AS-BUILT	NO.	REVISION-LOCATION	ECN	DATE	BY
				7/18/00	CME
REFERENCE DRAWING	NO.	REVISION-LOCATION	ECN	DATE	BY
Sales Engineer JDP	Project Manager WJT	Application Engineer RTS			
DRAWN			APPROVED		
by RTS			DATE 09/10/97		
SEARCH INFORMATION			CONTRACT NUMBER		
JOHNSON CONTROLS 60 LOVETON CIRCLE SPARKS, MD 21152			7052-0098		
Systems & Services Division			DRAWING NUMBER BL-6559-43		

Full Spreadsheet		Software				Digital Controller Information						Panel Information				Intermediate Device				Field Device								
Tag	Point Type	System Name	Object Name	Expanded ID	Display Units	DC Type	N2 Trunk	N2 Addr	Cable Destination Bay/Terminal	Module Type	Termination	Panel	Panel Location	Slot Number	Reference Drawing	Cable Number	Wiring/Termination	Termination In	Device	Termination Out	Location	Wiring/Termination	Terminations	Device	Location	Ref Detail	Comment	
		HEATING				DX9100						EN-HEAT	Service Lev MER B		M.3-16												Power to Controller	
		HEATING				DX9100		25				EN-HEAT	Service Lev MER B		0/M.3-16												N2 Trunk	
DI-1	HEATING	PHWP4-S	Pri HW Pump 4 Status		Off On	DX9100		25	DI-1			DI#.COM	Service Lev MER B		0/M.3-16	HEAT-25-DI-1						2/22	Device dependent	Aux Contact (NO)		D70		
DI-2	HEATING	PHWP5-S	Pri HW Pump 5 Status		Off On	DX9100		25	DI-2			DI#.COM	Service Lev MER B		0/M.3-16	HEAT-25-DI-2							2/22	Device dependent	Aux Contact (NO)		D70	
DI-3	HEATING	SHWP7-S	Sec HW Pump 7 Status		Off On	DX9100		25	DI-3			DI#.COM	Service Lev MER B		0/M.3-16	HEAT-25-DI-3							2/22	Device dependent	Aux Contact (NO)		D70	
DI-4	HEATING	SHWP8-S	Sec HW Pump 8 Status		Off On	DX9100		25	DI-4			DI#.COM	Service Lev MER B		0/M.3-16	HEAT-25-DI-4							2/22	Device dependent	Aux Contact (NO)		D70	
DI-5	HEATING	DWP9-S	Dom HW Pump 9 Status		Off On	DX9100		25	DI-5			DI#.COM	Service Lev MER B		0/M.3-16	HEAT-25-DI-5							2/22	Device dependent	Aux Contact (NO)		D70	
DI-6	HEATING	DWP10-S	Dom HW Pump 10 Status		Off On	DX9100		25	DI-6			DI#.COM	Service Lev MER B		0/M.3-16	HEAT-25-DI-6							2/22	Device dependent	Aux Contact (NO)		D70	
DI-7	HEATING					DX9100		25	DI-7			EN-HEAT	Service Lev MER B		0/M.3-16	HEAT-25-DI-7											D70	
DI-8	HEATING					DX9100		25	DI-8			EN-HEAT	Service Lev MER B		0/M.3-16	HEAT-25-DI-8												
AO-1	HEATING	CN1-VLV	Conv 1 Steam Valves		%	DX9100		25	AO-1			AO#.AOCOM	Service Lev MER B		0/M.3-16	HEAT-25-AO-1	2/18	+-	EP-8000-2	SUPPLY,O		1/4"	Barb Fitting	EP-PNEU.		D22		
AO-2	HEATING	CN2-VLV	Conv 2 Steam Valves		%	DX9100		25	AO-2			AO#.AOCOM	Service Lev MER B		0/M.3-16	HEAT-25-AO-2	2/18	+-	EP-8000-2	SUPPLY,O		1/4"	Barb Fitting	EP-PNEU.		D22		
AO-9	HEATING	HWP7-VSD	Sec HW Pump 1 Var Spd Dr		%	DX9100		25	AO-9			AO#.AOCOM	Service Lev MER B		0/M.3-16	HEAT-25-AO-9							2/18	Device dependent	10-20mA OUT		D21	
AO-10	HEATING	HWP8-VSD	Sec HW Pump 2 Var Spd Dr		%	DX9100		25	AO-10			AO#.AOCOM	Service Lev MER B		0/M.3-16	HEAT-25-AO-10							2/18	Device dependent	10-20mA OUT		D21	
AO-11	HEATING	SHW-VLV	Sec HW Control Valve		%	DX9100		25	AO-11			AO#.AOCOM	Service Lev MER B		0/M.3-16	HEAT-25-AO-11	2/18	+-	EP-8000-2	SUPPLY,O		1/4"	Barb Fitting	EP-PNEU.		D22		
AO-12	HEATING					DX9100		25	AO-12			EN-HEAT	Service Lev MER B		0/M.3-16	HEAT-25-AO-12												
AO-13	HEATING					DX9100		25	AO-13			EN-HEAT	Service Lev MER B		0/M.3-16	HEAT-25-AO-13												
AO-14	HEATING					DX9100		25	AO-14			EN-HEAT	Service Lev MER B		0/M.3-16	HEAT-25-AO-14												
DO-3	HEATING	PHWP4-C	Pri HW Pump 4 Control		Off On	DX9100		25	DO-3			DO#.24V.COM	Service Lev MER B		0/M.3-16	HEAT-25-DO-3	3/18		A.COILS.COM	RELAY-A	COM,NO		2/14	See starter detail	Starter (NO)		D60	
DO-4	HEATING	PHWP5-C	Pri HW Pump 5 Control		Off On	DX9100		25	DO-4			DO#.24V.COM	Service Lev MER B		0/M.3-16	HEAT-25-DO-4	3/18		B.COILS.COM	RELAY-B	COM,NO		2/14	See starter detail	Starter (NO)		D60	
DO-5	HEATING	SHWP7-C	Sec HW Pump 7 Control		Off On	DX9100		25	DO-5			DO#.24V.COM	Service Lev MER B		0/M.3-16	HEAT-25-DO-5	3/18		A.COILS.COM	RELAY-A	COM,NO		2/14	See starter detail	Starter (NO)		D60	
DO-6	HEATING	SHWP8-C	Sec HW Pump 8 Control		Off On	DX9100		25	DO-6			DO#.24V.COM	Service Lev MER B		0/M.3-16	HEAT-25-DO-6	3/18		B.COILS.COM	RELAY-B	COM,NO		2/14	See starter detail	Starter (NO)		D60	
DO-7	HEATING	CN1-SOV	Conv 1 Shut Off Valve		Off On	DX9100		25	DO-7			DO#.24V.COM	Service Lev MER B		0/M.3-16	HEAT-25-DO-7	3/18		A.COILS.COM	RELAY-A	COM,NO		2/14	See starter detail	Starter (NO)		D60	
DO-8	HEATING	CN2-SOV	Conv 2 Shut Off Valve		Off On	DX9100		25	DO-8			DO#.24V.COM	Service Lev MER B		0/M.3-16	HEAT-25-DO-8	3/18		B.COILS.COM	RELAY-B	COM,NO		2/14	See starter detail	Starter (NO)		D60	
AI-1	HEATING	CN1HWS-T	Conv 1 HW Supply Temp		Deg F	DX9100		25	AI-1			AI#.AICOM	Service Lev MER B		0/M.3-16	HEAT-25-AI-1							2/18	2-Wire	TE-631AP-1		D3	
AI-2	HEATING	CN2HWS-T	Conv 2 HW Supply Temp		Deg F	DX9100		25	AI-2			AI#.AICOM	Service Lev MER B		0/M.3-16	HEAT-25-AI-2							2/18	2-Wire	TE-631AP-1		D3	
AI-3	HEATING	PHWS-T	Pri HW Supply Temp		Deg F	DX9100		25	AI-3			AI#.AICOM	Service Lev MER B		0/M.3-16	HEAT-25-AI-3							2/18	2-Wire	TE-631AP-1		D3	
AI-4	HEATING	PHWR-T	Pri HW Return Temp		Deg F	DX9100		25	AI-4			AI#.AICOM	Service Lev MER B		0/M.3-16	HEAT-25-AI-4							2/18	2-Wire	TE-631AP-1		D3	
AI-5	HEATING	SHWS-T	Sec HW Supply Temp		Deg F	DX9100		25	AI-5			AI#.AICOM	Service Lev MER B		0/M.3-16	HEAT-25-AI-5							2/18	2-Wire	TE-631AP-1		D3	
AI-6	HEATING	SHWR-T	Sec HW Return Temp		Deg F	DX9100		25	AI-6			AI#.AICOM	Service Lev MER B		0/M.3-16	HEAT-25-AI-6							2/18	2-Wire	TE-631AP-1		D3	
AI-7	HEATING	TRFHWS-T	Turf HW Supply Temp		Deg F	DX9100		25	AI-7			AI#.AICOM	Service Lev MER B		0/M.3-16	HEAT-25-AI-7							2/18	2-Wire	TE-631AP-1		D3	
AI-8	HEATING	TRFHR-T	Turf HW Return Temp		Deg F	DX9100		25	AI-8			AI#.AICOM	Service Lev MER B		0/M.3-16	HEAT-25-AI-8							2/18	2-Wire	TE-631AP-1		D3	


DOMESTIC WATER BOOSTER PUMPS

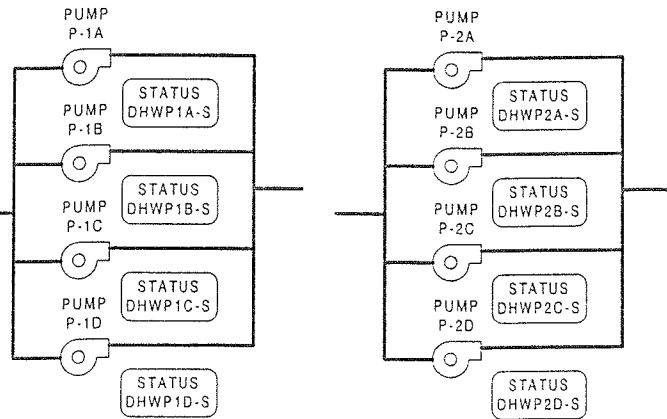

MASTER OUTSIDE AIR TEMPERATURE/HUMIDITY





NOTE: HOT WATER PUMP STATUS POINTS ARE IN ENCLOSURE EN-HEAT SEE POINT SCHEDULE NCM-5.PS-25

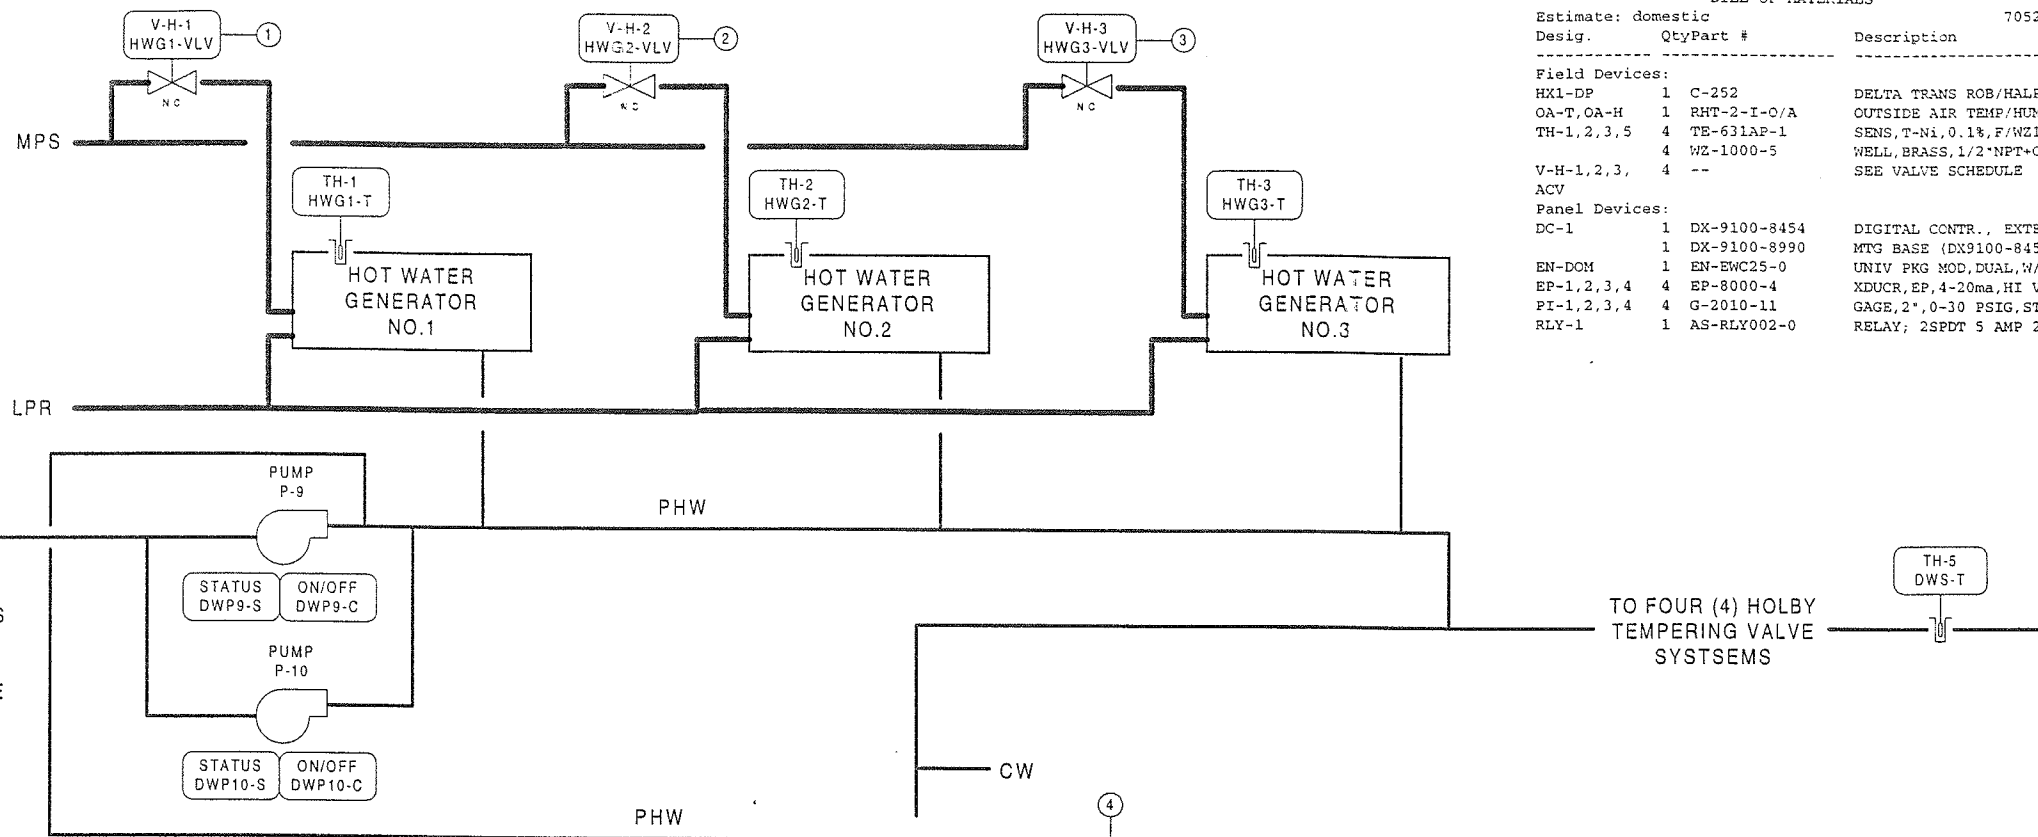


Estimate: domestic 70520098.ppt

Desig.	Qty	Part #	Description
Field Devices:			
HX1-DP	1	C-252	DELTA TRANS ROB/HALP
OA-T, OA-H	1	RHT-2-I-O/A	OUTSIDE AIR TEMP/HUMID
TH-1, 2, 3, 5	4	TE-631AP-1	SENS, T-Ni, 0.1%, F/WZ1000-5
	4	WZ-1000-5	WELL, BRASS, 1/2"NPT+COMPND
V-H-1, 2, 3	4	--	SEE VALVE SCHEDULE
Panel Devices:			
ACV	1	DX-9100-8454	DIGITAL CONTR., EXTENDED
DC-1	1	DX-9100-8990	MTG BASE (DX9100-8454)
EN-DOM	1	EN-EWC25-0	UNIV PKG MOD, DUAL, W/50VA
EP-1, 2, 3, 4	4	EP-8000-4	XDUCR, EP, 4-20ma, HI VOL
PI-1, 2, 3, 4	4	G-2010-11	GAGE, 2", 0-30 PSIG, STEM
RLY-1	1	AS-RLY002-0	RELAY; 2SPDT 5 AMP 240VAC

CONDENSATE RECEIVER TEMPERATURE

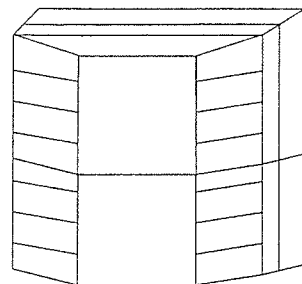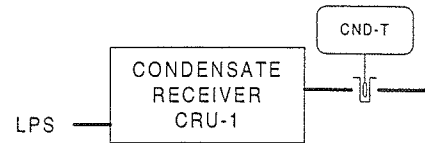

ENCLOSURE EN-DOM
DX-9100-8001
LOCATED IN MECHANICAL ROOM
NCM-5/N2 ADD = 25

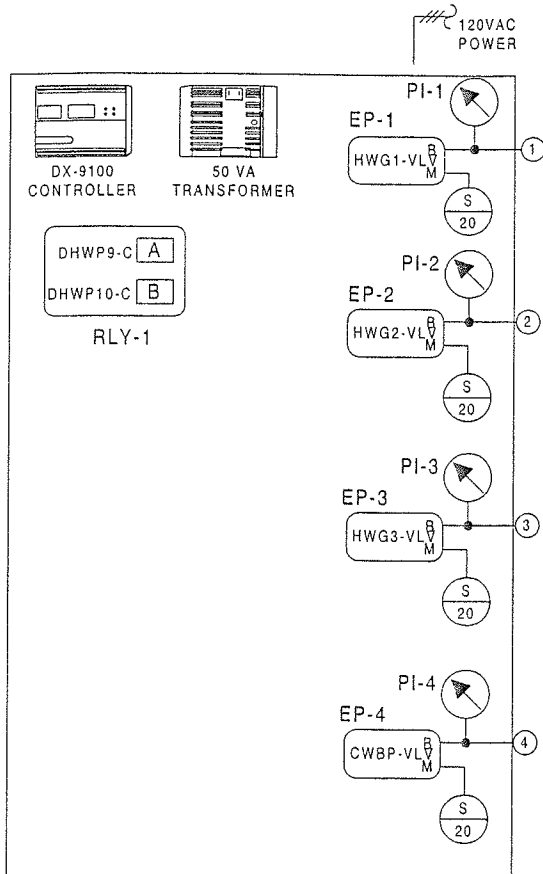

DESCRIPTION OF OPERATION - DOMESTIC WATER HEATERS

TANK MOUNTED SENSOR TH-1 WILL MODULATE STEAM VALVES V-H-1 TO MAINTAIN ITS SETTING OF 140F. THREE (3) STORAGE WATER HEATERS ARE PIPED IN PARALLEL TO HANDLE THE DESIGN LOAD. EACH HEATER WILL HAVE SELF CONTAINED CONTROL OF ITS OWN TANK TEMPERATURE. EACH TANK TEMPERATURE WILL BE INDICATED ON THE METASYS SYSTEM. TWO (2) DOMESTIC HOT WATER RECIRCULATION PUMPS ARE PROVIDED TO MAINTAIN LOOP WATER TEMPERATURE. ONE (1) PUMP IS REQUIRED TO FOR DESIGN LOAD AND WILL RUN CONTINUOUSLY. THE METASYS SYSTEM WILL ENERGIZE THE LEAD PUMP AS SELECTED BY THE LEAD/LAG PROGRAM AND THE PUMP WILL START AND RUN CONTINUOUSLY. IF THE LEAD PUMP FAILS OR FAILS TO START AS SENSED BY ITS AUX CONTACT, THE LAG PUMP WILL AUTOMATICALLY START AND RUN CONTINUOUSLY. A FAILURE OF EITHER PUMP AS SENSED BY THEIR RESPECTIVE AUX CONTACT WILL BE ALARMED ON THE METASYS SYSTEM. ONE (1) DOMESTIC WATER SUPPLY TEMPERATURE SENSOR TH-5 WILL BE PROVIDED WHERE INDICATED ON THE DOMESTIC WATER RISER DIAGRAM. TEMPERATURE SENSOR WILL MONITOR LOOP TEMPERATURE AND TREND DATA DURING STADIUM EVENTS IN TEN (10) MINUTE INCREMENTS. DOMESTIC HOT WATER SUPPLY TEMPERATURE TO DISTRIBUTION WILL BE MECHANICALLY REGULATED TO 120F USING MANUALLY ADJUSTING TEMPERING VALVES LOCATED DOWNSTREAM OF WATER HEATERS. HEAT EXCHANGER HX-1 WILL BE USED TO PREHEAT DOMESTIC HOT WATER AND TO COOL DOWN STEAM CONDENSATE BEFORE DISCHARGING TO THE DRAINAGE SYSTEM. SELF-CONTAINED TEMPERATURE CONTROL VALVE V-H-5 WILL BE USED TO INJECT COLD WATER INTO STEAM CONDENSATE DOWNSTREAM OF HX-1 AS REQUIRED TO FURTHER REDUCE CONDENSATE TEMPERATURE TO 140F. HEAT EXCHANGER HX-1 IS A MECHANICAL DEVICE REQUIRING NO TEMPERATURE CONTROLS. BYPASS COLD WATER VALVE ACV WILL MODULATE OPEN AS THE DIFFERENTIAL PRESSURE AS SENSED BY HX1-DP INLET AND OUTLET PIPING RISES ABOVE ITS SETTING (AS HOT WATER DEMAND RISES ABOVE CAPACITY OF HX-1 AND PREHEATING IS MAXIMIZED).

DESCRIPTION OF OPERATION - DOMESTIC WATER BOOSTER PUMPS


TWO (2) PACKAGED DOMESTIC WATER BOOSTER PUMP SYSTEMS WITH FOUR (4) PUMPS EACH ARE PROVIDED FOR THE FACILITY. EACH SYSTEM WILL BE SELF-CONTAINED WITH FULLY PACKAGED CONTROLS. STATUS INDICATION WILL BE PROVIDED ON THE METASYS SYSTEM THROUGH THE BOOSTER PUMP CONTROL PANEL FOR EACH PUMP.

REVISION INFORMATION	IN CONSIDERATION OF THE RECEIPT OF THIS DOCUMENT, THE RECIPIENT AGREES NOT TO REPRODUCE, COPY, USE OR TRANSMIT THIS DOCUMENT AND/OR THE INFORMATION THEREIN CONTAINED, IN WHOLE OR IN PART, OR TO SUFFER SUCH ACTION BY OTHERS, FOR ANY PURPOSE, EXCEPT WITH THE WRITTEN PERMISSION OF JOHNSON CONTROLS, INC. AND FURTHER AGREES TO SURRENDER SAME TO JOHNSON CONTROLS, INC. UPON DEMAND. COPYRIGHT JOHNSON CONTROLS, INC. 1998	DRAWING TITLE	DOMESTIC HOT WATER SYSTEM		
NUMBER		MECHANICAL ROOM SOUTH SERVICE LEVEL QUAD B			
DATE		07/18/00			
TIME		03:39 PM			
DESIGNED BY	DOMESTIC. vsd	PROJECT TITLE	BALTIMORE NFL STADIUM AT CAMDEN YARDS BALTIMORE, MARYLAND		
AS-BUILT		DATE	7/18/00		
REFERENCE DRAWING		NO.			
Sales Engineer		JDP	Project Manager	WJT	Application Engineer
DRAWN		DATE	09/11/97		
JOHNSON CONTROLS		JOHNSON CONTROLS		7052-0098	
Systems & Services Division		60 LOVETON CIRCLE SPARKS, MD 21152		DRAWING NUMBER	
				BL-6559-44	

Full Spreadsheet		Software				Digital Controller Information					Panel Information				Intermediate Device				Field Device				Ref Detail	Comment					
Tag	Point Type	System Name	Object Name	Expanded ID	Display Units	DC Type	N2 Trunk	N2 Addr	Cable Destination Bay/Terminal	Module Type	Termination	Panel	Panel Location	Slot Number	Reference Drawing	Cable Number	Wiring/Termination	Termination In	Device	Termination Out	Location	Wiring/Termination	Terminations	Device	Location	Ref Detail	Comment		
		DOMESTIC				DX9100						EN-COM	Service Lev MER B		M.3-16												Power to Controller		
		DOMESTIC				DX9100		26				EN-COM	Service Lev MER B		M.3-16												N2 Trunk		
DI-1	DOMESTIC	DHWP1A-S	Dom HW Pump 1A Status		Off On	DX9100		26	DI-1			DI#.COM	EN-COM	Service Lev MER B	M.3-16	DOM-26-DI-1						2/22	Device dependent	Contact (NO)			D70		
DI-2	DOMESTIC	DHWP1B-S	Dom HW Pump 1B Status		Off On	DX9100		26	DI-2			DI#.COM	EN-COM	Service Lev MER B	M.3-16	DOM-26-DI-2						2/22	Device dependent	Contact (NO)			D70		
DI-3	DOMESTIC	DHWP1C-S	Dom HW Pump 1C Status		Off On	DX9100		26	DI-3			DI#.COM	EN-COM	Service Lev MER B	M.3-16	DOM-26-DI-3						2/22	Device dependent	Contact (NO)			D70		
DI-4	DOMESTIC	DHWP1D-S	Dom HW Pump 1D Status		Off On	DX9100		26	DI-4			DI#.COM	EN-COM	Service Lev MER B	M.3-16	DOM-26-DI-4						2/22	Device dependent	Contact (NO)			D70		
DI-5	DOMESTIC	DHWP2A-S	Dom HW Pump 2A Status		Off On	DX9100		26	DI-5			DI#.COM	EN-COM	Service Lev MER B	M.3-16	DOM-26-DI-5						2/22	Device dependent	Contact (NO)			D70		
DI-6	DOMESTIC	DHWP2B-S	Dom HW Pump 2B Status		Off On	DX9100		26	DI-6			DI#.COM	EN-COM	Service Lev MER B	M.3-16	DOM-26-DI-6						2/22	Device dependent	Contact (NO)			D70		
DI-7	DOMESTIC	DHWP2C-S	Dom HW Pump 2C Status		Off On	DX9100		26	DI-7			DI#.COM	EN-COM	Service Lev MER B	M.3-16	DOM-26-DI-7						2/22	Device dependent	Contact (NO)			D70		
DI-8	DOMESTIC	DHWP2D-S	Dom HW Pump 2D Status		Off On	DX9100		26	DI-8			DI#.COM	EN-COM	Service Lev MER B	M.3-16	DOM-26-DI-8						2/22	Device dependent	Contact (NO)			D70		
AO-1	DOMESTIC	HWG1-VLV	HW Gen 1 Steam Valve		%	DX9100		26	AO-1			AO#.AOCOM	EN-COM	Service Lev MER B	M.3-16	DOM-26-AO-1	2/18	+-	EP-8000-2	SUPPLY_O		1/4"	Barb Fitting	EP-PNEU.			D22		
AO-2	DOMESTIC	HWG2-VLV	HW Gen 2 Steam Valve		%	DX9100		26	AO-2			AO#.AOCOM	EN-COM	Service Lev MER B	M.3-16	DOM-26-AO-2	2/18	+-	EP-8000-2	SUPPLY_O		1/4"	Barb Fitting	EP-PNEU.			D22		
AO-9	DOMESTIC	HWG3-VLV	HW Gen 3 Steam Valve		%	DX9100		26	AO-9			AO#.AOCOM	EN-COM	Service Lev MER B	M.3-16	DOM-26-AO-9	2/18	+-	EP-8000-2	SUPPLY_O		1/4"	Barb Fitting	EP-PNEU.			D22		
AO-10	DOMESTIC	CWBP-VLV	Cold Water Bypass Valve		%	DX9100		26	AO-10			AO#.AOCOM	EN-COM	Service Lev MER B	M.3-16	DOM-26-AO-10	2/18	+-	EP-8000-2	SUPPLY_O		1/4"	Barb Fitting	EP-PNEU.			D22		
AO-11	DOMESTIC					DX9100		26	AO-11			EN-COM	Service Lev MER B		M.3-16	DOM-26-AO-11													
AO-12	DOMESTIC					DX9100		26	AO-12			EN-COM	Service Lev MER B		M.3-16	DOM-26-AO-12													
AO-13	DOMESTIC					DX9100		26	AO-13			EN-COM	Service Lev MER B		M.3-16	DOM-26-AO-13													
AO-14	DOMESTIC					DX9100		26	AO-14			EN-COM	Service Lev MER B		M.3-16	DOM-26-AO-14													
DO-3	DOMESTIC	DHWP9-C	Dom HW Pump 9 Control		Off On	DX9100		26	DO-3	RLY	DO#.24V.COM	EN-COM	Service Lev MER B		M.3-16	DOM-26-DO-3	3/18		A.COILS.COM	RELAY-A	COM:NO		2/14	See starter detail	Starter (NO)			D60	
DO-4	DOMESTIC	DHWP10-C	Dom HW Pump 10 Control		Off On	DX9100		26	DO-4	RLY	DO#.24V.COM	EN-COM	Service Lev MER B		M.3-16	DOM-26-DO-4	3/18		B.COILS.COM	RELAY-B	COM:NO		2/14	See starter detail	Starter (NO)			D60	
DO-5	DOMESTIC					DX9100		26	DO-5			EN-COM	Service Lev MER B		M.3-16	DOM-26-DO-5													
DO-6	DOMESTIC					DX9100		26	DO-6			EN-COM	Service Lev MER B		M.3-16	DOM-26-DO-6													
DO-7	DOMESTIC					DX9100		26	DO-7			EN-COM	Service Lev MER B		M.3-16	DOM-26-DO-7													
DO-8	DOMESTIC					DX9100		26	DO-8			EN-COM	Service Lev MER B		M.3-16	DOM-26-DO-8													
AI-1	DOMESTIC	OA-T	Outdoor Air Temperature		Deg F	DX9100		26	AI-1		AI#.15V	EN-COM	Service Lev MER B		M.3-16	DOM-26-AI-1						2/18	+-	RH-2-I/O/A				D1	
AI-2	DOMESTIC	HWG1-T	HW Gen 1 HW Supply Temp		Deg F	DX9100		26	AI-2		AI#.AICOM	EN-COM	Service Lev MER B		M.3-16	DOM-26-AI-2						2/18	2-Wire	TE-631AP-1				D3	
AI-3	DOMESTIC	HWG2-T	HW Gen 2 HW Supply Temp		Deg F	DX9100		26	AI-3		AI#.AICOM	EN-COM	Service Lev MER B		M.3-16	DOM-26-AI-3						2/18	2-Wire	TE-631AP-1				D3	
AI-4	DOMESTIC	HWG3-T	HW Gen 3 HW Supply Temp		Deg F	DX9100		26	AI-4		AI#.AICOM	EN-COM	Service Lev MER B		M.3-16	DOM-26-AI-4						2/18	2-Wire	TE-631AP-1				D3	
AI-5	DOMESTIC	HX1-DP	Dom HW Diff Pressure		PSI	DX9100		26	AI-5		AI#.15V	EN-COM	Service Lev MER B		M.3-16	DOM-26-AI-5						2/18	Device dependent	Rob/Hal 252C				D1	
AI-6	DOMESTIC	CND-T	Condensate Water Temp		Deg F	DX9100		26	AI-6		AI#.AICOM	EN-COM	Service Lev MER B		M.3-16	DOM-26-AI-6						2/18	2-Wire	TE-631AP-1				D3	
AI-7	DOMESTIC	OA-H	Outdoor Air Humidity		% RH	DX9100		26	AI-7		AI#.15V	EN-COM	Service Lev MER B		M.3-16	DOM-26-AI-7						2/18	+-	RH-2-I/O/A				D1	
AI-8	DOMESTIC	DWS-T	Hot Water Supply Temp		Deg F	DX9100		26	AI-8		AI#.AICOM	EN-COM	Service Lev MER B		M.3-16	DOM-26-AI-8						2/18	2-Wire	TE-631AP-1				D3	


Full Spreadsheet		Software				Digital Controller Information					Panel Information				Intermediate Device				Field Device			Ref Detail	Comment					
Tag	Point Type	System Name	Object Name	Expanded ID	Display Units	DC Type	N2 Trunk	N2 Addr	Cable Destination Bay/Terminal	Module Type	Termination	Panel	Panel Location	Slot Number	Reference Drawing	Cable Number	Wiring/Tubing	Termination In	Device	Termination Out	Location			Wiring/Tubing	Terminations	Device	Location	
		SEF-A				VAV						EN-EXH	AT FAN															
		SEF-A				VAV	1	2				EN-EXH	AT FAN	01													Power to Controller N2 Trunk	
AI-1		SEF-A				VAV	1	2	AI-1			EN-EXH	AT FAN	01		EXH-2-AI-1												
AI-2		SEF-A				VAV	1	2	AI-2			EN-EXH	AT FAN	01		EXH-2-AI-2												
AI-3		SEF-A				VAV	1	2	AI-3			EN-EXH	AT FAN	01		EXH-2-AI-3												
AI-4		SEF-A				VAV	1	2	AI-4			EN-EXH	AT FAN	01		EXH-2-AI-4												
AI-5		SEF-A				VAV	1	2	AI-5			EN-EXH	AT FAN	01		EXH-2-AI-5												
AI-6		SEF-A				VAV	1	2	AI-6			EN-EXH	AT FAN	01		EXH-2-AI-6												
BI-1		SEF-A	SEF5-S	Smoke Exh Fan 5 Status	Off On	VAV	1	2	BI-1		BI#,24VAC	EN-EXH	AT FAN	01		EXH-2-BI-1												
BI-2		SEF-A	SEF6-S	Smoke Exh Fan 6 Status	Off On	VAV	1	2	BI-2		BI#,24VAC	EN-EXH	AT FAN	01		EXH-2-BI-2					2/22	Device dependent	Aux Contact			U70		
BI-3		SEF-A				VAV	1	2	BI-3			EN-EXH	AT FAN	01		EXH-2-BI-3					2/22	Device dependent	Aux Contact (NO)			U70		
BI-4		SEF-A				VAV	1	2	BI-4			EN-EXH	AT FAN	01		EXH-2-BI-4												
BO-1		SEF-A				VAV	1	2	BO-1			EN-EXH	AT FAN	01		EXH-2-BO-1												
BO-2		SEF-A				VAV	1	2	BO-2			EN-EXH	AT FAN	01		EXH-2-BO-2												
BO-3		SEF-A				VAV	1	2	BO-3			EN-EXH	AT FAN	01		EXH-2-BO-3												
BO-4		SEF-A				VAV	1	2	BO-4			EN-EXH	AT FAN	01		EXH-2-BO-4												
BO-5		SEF-A				VAV	1	2	BO-5			EN-EXH	AT FAN	01		EXH-2-BO-5												
BO-6		SEF-A				VAV	1	2	BO-6			EN-EXH	AT FAN	01		EXH-2-BO-6												
BO-7		SEF-A				VAV	1	2	BO-7			EN-EXH	AT FAN	01		EXH-2-BO-7												
BO-8		SEF-A				VAV	1	2	BO-8			EN-EXH	AT FAN	01		EXH-2-BO-8												

**PACKAGED HEAT PUMP UNITS
(TYPICAL OF 7)**

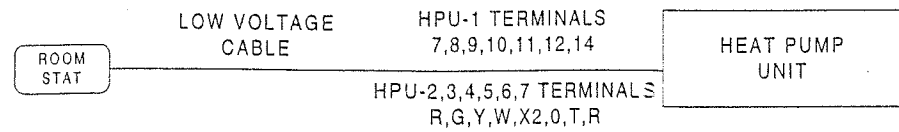


NOTE: ROOM THERMOSTATS SUPPLIED WITH PACKAGED UNITS


**PACKAGED HEAT PUMP UNITS WITH REMOTE CONDENSING UNITS
(TYPICAL OF 5)**

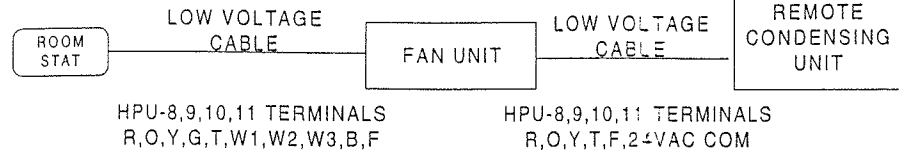

MECHANICAL ROOM QUAD A VENTILATION

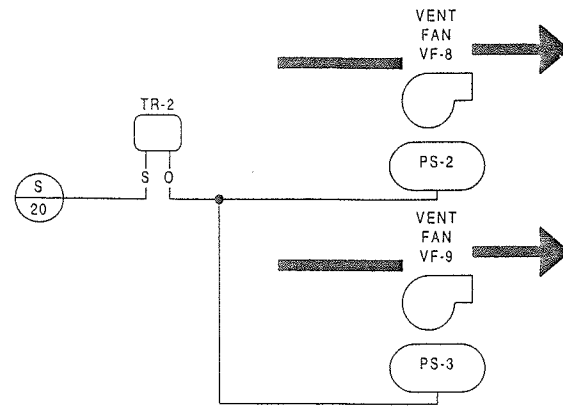


FAN WIRING DIAGRAM

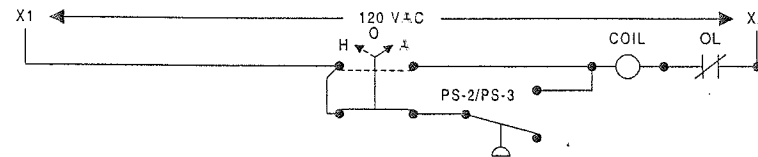

**ELECTRICAL ROOM VENTILATION
(TYPICAL OF 8)**




FAN WIRING DIAGRAM

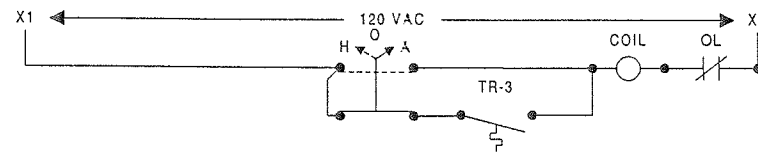


VENT FAN	LOCATION
VF-26	PRESS LEVEL ELECTRICAL ROOM QUAD A
VF-27	PRESS LEVEL ELECTRICAL ROOM QUAD B
VF-28	PRESS LEVEL ELECTRICAL ROOM QUAD C
VF-29	PRESS LEVEL ELECTRICAL ROOM QUAD D
VF-10	SERVICE LEVEL MECH ROOM B QUAD B
VF-24	SERVICE LEVEL MECH ROOM B QUAD B
VF-31	SERVICE ELEVATOR MECH ROOM QUAD A
VF-31	SERVICE ELEVATOR MECH ROOM QUAD B

**GENERAL MECHANICAL ROOM VENTILATION
(TYPICAL OF 10)**

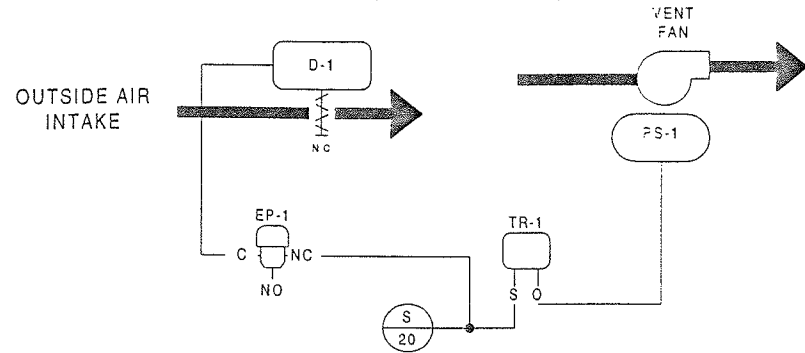


FAN WIRING DIAGRAM

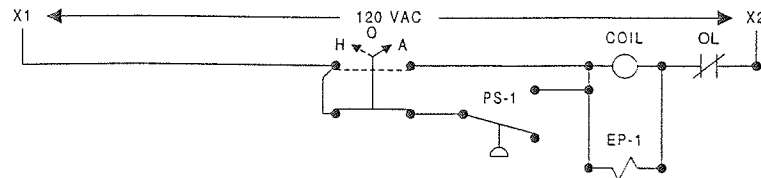


VENT FAN	LOCATION
VF-25	PRESS LEVEL MECH ROOM QUAD A
VF-25	PRESS LEVEL MECH ROOM QUAD B
VF-25	PRESS LEVEL MECH ROOM QUAD C
VF-25	PRESS LEVEL MECH ROOM QUAD D
VF-11	SERVICE LEVEL MECH ROOM QUAD B
VF-12	SERVICE LEVEL MECH ROOM QUAD B
VF-13	SERVICE LEVEL MECH ROOM QUAD B
VF-30	ELEVATOR MECH ROOM QUAD A
VF-30	ELEVATOR MECH ROOM QUAD B
VF-30	ELEVATOR MECH ROOM QUAD C

BILL OF MATERIALS 705200#8.pre


Estimate: miscellaneous	Qty	Part #	Description
AC-1	1	AD-030-3C4	3 HP 460/3 80G DA DRY AD
AC-2,3	2	AD-007-1C4	3/4HP 460/3 30G DA DRY AD
D-1	10	D-4073-2	DMPR ACT, 8-13#
EP-1	10	V11HAA-100	3-W SOLENOID, W/OV, 120VAC
PS, 1, 2, 3	12	P10BC-7C	SW, PE, SPDT, 2#DIF
TR-1, 2	11	T-4000-3139	CVR, WHT, JCI, HOR
	11	T-4002-124	STAT MOUNTING BRACKET
	11	T-4002-201	STAT, DIR, HORIZ, F
TR-3	8	T26S-18C	STAT, RM, H/C, ADJ, 40/90F

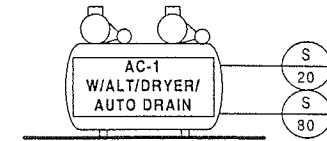

3 H.P. LOCATED IN SERVICE LEVEL MECHANICAL ROOM QUAD B

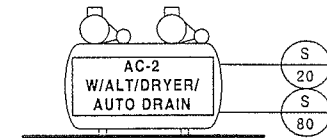

3/4 H.P. LOCATED IN PRESS LEVEL AHU-3 MECHANICAL ROOM QUAD C

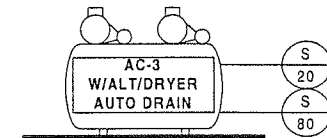

3/4 H.P. LOCATED IN PRESS LEVEL AHU-4 MECHANICAL ROOM QUAD D

PACKAGED AIR CONDITIONING UNITS


PACKAGED AIR CONDITIONING SYSTEMS INCLUDE ELECTRIC HEAT PUMP UNITS AND SPLIT SYSTEM DIRECT EXPANSION COOLING UNITS WITH ELECTRIC HEAT. THESE SYSTEMS WILL BE PROVIDED WITH PACKAGED ELECTRONIC CONTROLS AND REMOTE MOUNTED PROGRAMMABLE THERMOSTAT.

GENERAL MECHANICAL ROOM VENTILATION - ROOM THERMOSTAT TR-1 CONTROLS THE VENTILATION FAN. ON A RISE IN ROOM TEMPERATURE ABOVE THE SETTING OF TR-1 TO NINETY-FIVE (95F), FAN WILL START AND RUN CONTINUOUSLY AND OUTSIDE AIR INTAKE DAMPER WILL OPEN FULL. ON A FALL IN TEMPERATURE TO EIGHTY-FIVE (85F), FAN WILL BE DE-ENERGIZED AND THE OUTSIDE AIR INTAKE DAMPER WILL CLOSE.

MECHANICAL ROOM QUAD A VENTILATION - ROOM THERMOSTAT TR-2 CONTROLS THE VENTILATION FAN IN SEQUENCE TWO (2) VENTILATION FANS VF-8 AND VF-9. ON A RISE IN ROOM TEMPERATURE ABOVE THE SETTING OF TR-2, TO NINETY-FIVE (95F), FAN VF-8 WILL START AND RUN CONTINUOUSLY. ON A CONTINUED RISE IN ROOM TEMPERATURE ABOVE THE SETTING OF TR-2, FAN VF-9 WILL START AND RUN CONTINUOUSLY. ON A FALL IN TEMPERATURE TO EIGHTY-FIVE (85F) THE REVERSE SEQUENCE WILL OCCUR. ON A CONTINUED FALL IN TEMPERATURE FAN VF-8 WILL BE DE-ENERGIZED.


ELECTRIC ROOM VENTILATION - ROOM THERMOSTAT TR-3 WILL CONTROL THE VENTILATION FAN. ON A RISE IN ROOM TEMPERATURE ABOVE THE SETTING OF TR-3 TO NINETY-FIVE (95F), THE FAN WILL START AND RUN CONTINUOUSLY. ON A FALL IN TEMPERATURE TO EIGHTY-FIVE (85F), FAN WILL BE DE-ENERGIZED.

REVISION INFORMATION	Drawing Title	AS-BUILT		DATE	BY
NUMBER	MISCELLANEOUS SYSTEMS AS SHOWN			7/18/00	CME
DATE		REFERENCE DRAWING	NO	REVISION/LOCATION	EDN
07/18/00		Sales Engineer	JDP	Project Manager	WJT
		Application Engineer	RTS	DATE	09/11/97
TIME	Project Title	Branch Information		CONTRACT NUMBER	
03:42 PM	BALTIMORE NFL STADIUM AT CAMDEN YARDS	Johnson Controls, Inc. 60 Loveton Circle Sparks, Md 21152		7052-0098	
FILE NAME	BALTIMORE, MARYLAND	JOHNSON CONTROLS Systems & Services Division		DRAWING NUMBER BL-6559-45	

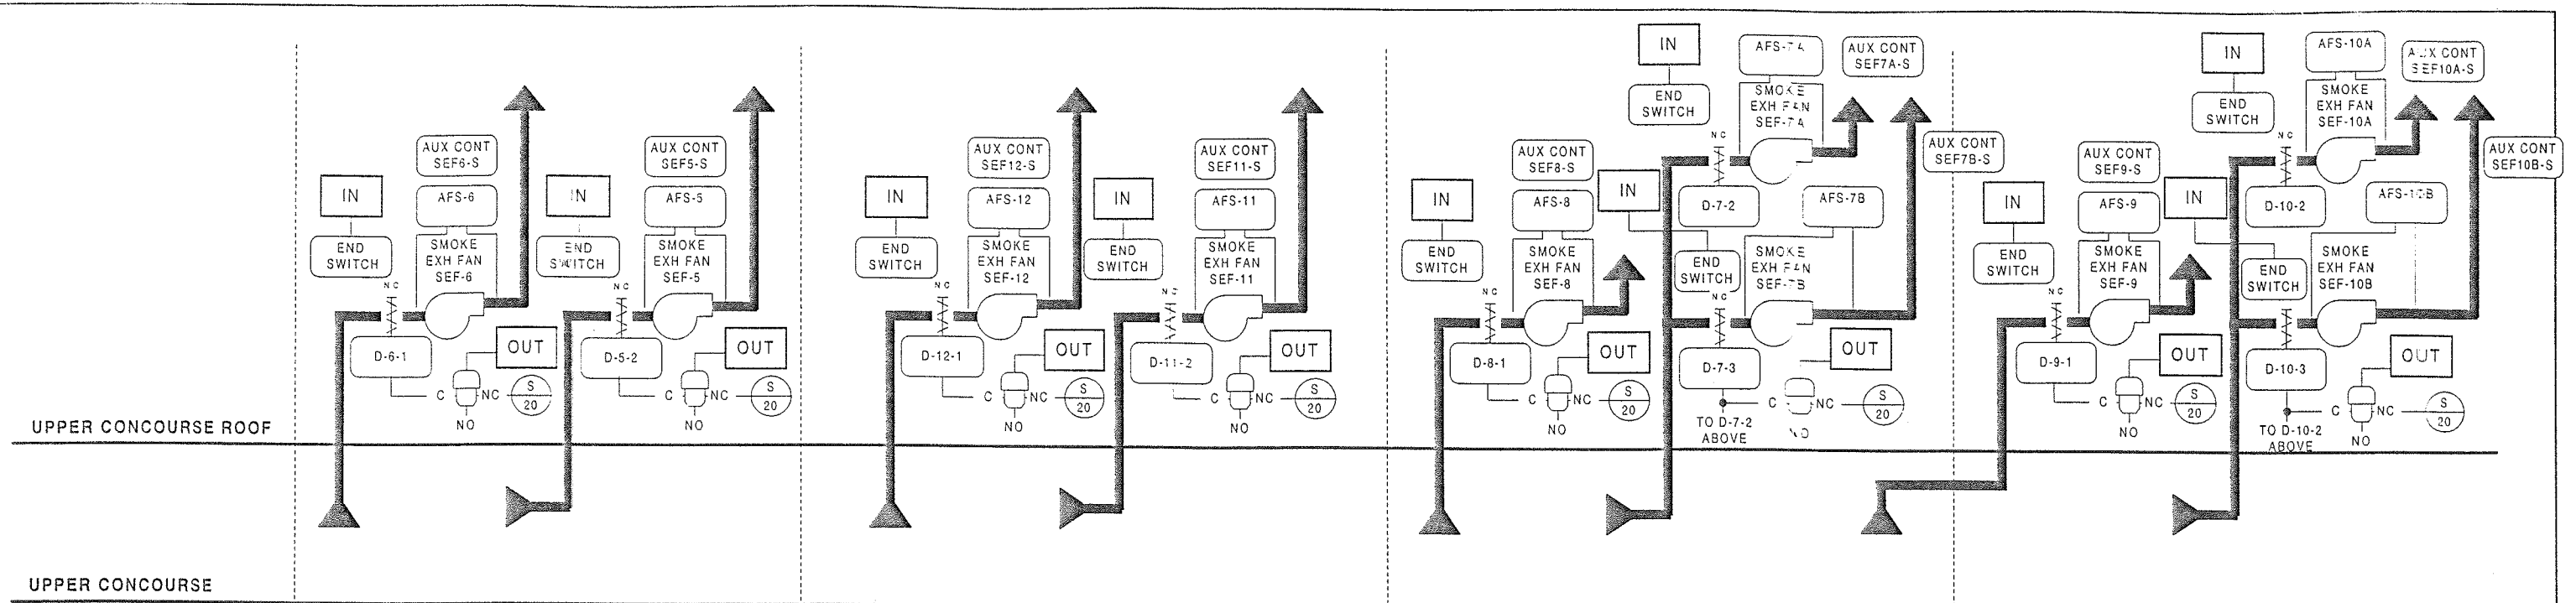

QUAD 'A' **QUAD 'D'** **QUAD 'B'** **QUAD 'C'**

NORTH ATRIUM SMOKE ZONE **SOUTHEAST ATRIUM SMOKE ZONE** **SOUTHWEST CLUB SMOKE ZONE**

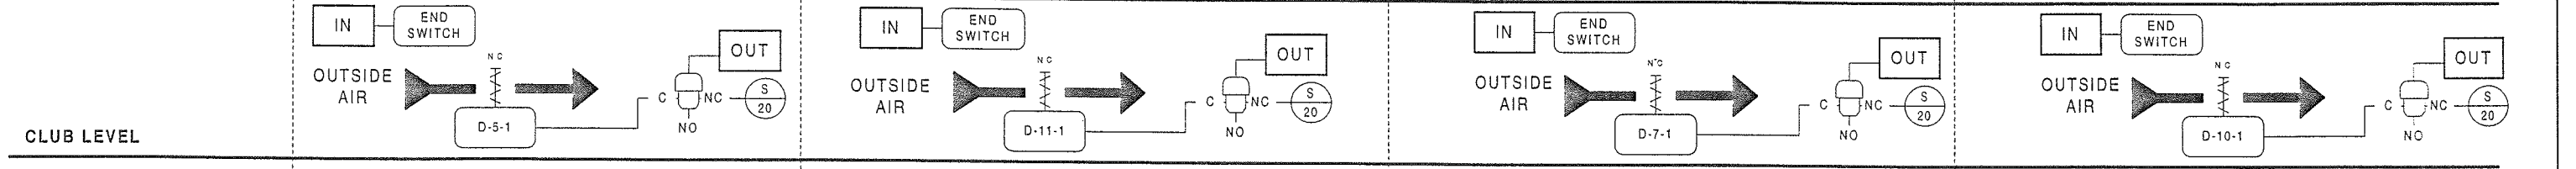

AHU-1 SUPPLY FAN **AHU-4 SUPPLY FAN** **AHU-2 SUPPLY FAN** **AHU-3 SUPPLY FAN**

CROSS ZONED CEILING SMOKE DETECTORS, HVAC SMOKE DETECTORS, OR A SPRINKLER WATER FLOW ALARM WITHIN THE ATRIUM WILL ENERGIZE THE SMOKE EXHAUST SYSTEM THROUGH THE FIRE ALARM SYSTEM. WHEN A START SIGNAL HAS BEEN RECEIVED, FOUR (4) SMOKE EXHAUST FANS SEF-5,6,11,12 WILL START AND RUN CONTINUOUSLY AFTER INTAKE DAMPERS D-5-1 AND D-11-1 AND EXHAUST AIR DAMPERS HAVE BEEN PROVEN OPEN BY END SWITCHES. EACH EXHAUST FAN SHALL BE PROVIDED WITH A SAIL SWITCH TO PROVIDE POSITIVE STATUS FOR OPERATION ON THE FIRE ALARM SYSTEM. AIR HANDLING UNITS AHU-1 AND 4 SERVING THE ATRIUM WILL BE DE-ENERGIZED AND ALL OF THEIR DAMPERS WILL RETURN TO THEIR NORMALLY CLOSED POSITION WHEN THE SMOKE EXHAUST IS ENERGIZED. ATRIUM SMOKE EXHAUST FANS WILL BE AUTOMATICALLY AND MANUALLY STARTED AND STOPPED FROM THE FIRE ALARM PANEL.


CROSS ZONED CEILING SMOKE DETECTORS, HVAC SMOKE DETECTORS, OR A SPRINKLER WATER FLOW ALARM WITHIN THE ATRIUM WILL ENERGIZE THE SMOKE EXHAUST SYSTEM THROUGH THE FIRE ALARM SYSTEM. WHEN A START SIGNAL HAS BEEN RECEIVED, FOUR (4) SMOKE EXHAUST FANS SEF-7A,7B,8,9 WILL START AND RUN CONTINUOUSLY AFTER INTAKE DAMPERS D-10-1 AND D-7-1 AND EXHAUST AIR DAMPERS HAVE BEEN PROVEN OPEN BY END SWITCHES. EACH EXHAUST FAN SHALL BE PROVIDED WITH A SAIL SWITCH TO PROVIDE POSITIVE STATUS FOR OPERATION ON THE FIRE ALARM SYSTEM. AIR HANDLING UNITS AHU-2 AND 3 SERVING THE ATRIUM WILL BE DE-ENERGIZED AND ALL OF THEIR DAMPERS WILL RETURN TO THEIR NORMALLY CLOSED POSITION WHEN THE SMOKE EXHAUST IS ENERGIZED. ATRIUM SMOKE EXHAUST FANS WILL BE AUTOMATICALLY AND MANUALLY STARTED AND STOPPED FROM THE FIRE ALARM PANEL.

REVISION INFORMATION		Drawing Title	
NUMBER		ATRIUM SMOKE EXHAUST NORTH ATRIUM SMOKE ZONE	
DATE	07/18/00	QUAD A & D	
TIME	03:43 PM	Project Title	
FILE NAME	SMOKE.vsd	BALTIMORE NFL STADIUM AT CAMDEN YARDS	
		BALTIMORE, MARYLAND	

AS-BUILT		7/18/00	CME
REFERENCE DRAWING	NO.	REVISION-LOCATION	EDN DATE BY
Sales Engineer	JDP	Project Manager	WJT
Application Engineer	RTS	DATE	09/11/97
BY		DATE	
BY		DATE	

JOHNSON CONTROLS	Johnson Controls, Inc. 60 Lovelton Circle Sparks, Md 21152	7052-0098
Systems & Services Division		DRAWING NUMBER BL-6559-46

BILL OF MATERIALS		
Estimate:	Qty/Part #	Description
AIR FLCW	10 AFS-222	FAN AIR FLOW SWITCH
D-5-1, D-7-1, D-10-1, D-11-1	4	SEE DAMPER SCHEDULE
END SW	12 TS-470	DPR POSITION SWITCH
SOLE VALVE	12 V11HAA-100	3-W SOLENOID, W/OV, 120VAC
EN-EXH	4 EN-EWC15-0	UNIV PKG MOD, SING, W/50VA
DC-1	4 AS-VAV110-1	VAV 6AI, 4BI, 8BO, 8K

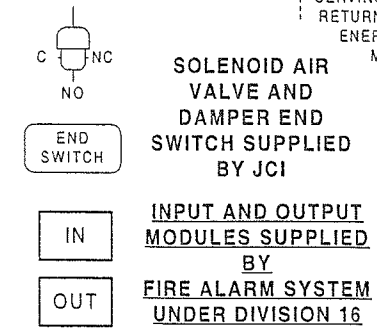

Full Spreadsheet		Software				Digital Controller Information						Panel Information				Intermediate Device				Field Device				Ref Detail	Comment		
Tag	Point Type	System Name	Object Name	Expanded ID	Display Units	DC Type	N2 Trunk	N2 Addr	Cable Destination Bay/Terminal	Module Type	Termination	Panel	Panel Location	Slot Number	Reference Drawing	Cable Number	Wiring/Tubing	Termination In	Device	Termination Out	Location	Wiring/Tubing	Terminations	Device	Location	Ref Detail	Comment
		SEF-B				VAV						EN-EXH	AT FAN														Power to Controller
		SEF-B				VAV	1	3				EN-EXH	AT FAN	01													N2 Trunk
AI-1		SEF-B				VAV	1	3	AI-1			EN-EXH	AT FAN	01		EXH-3-AI-1											
AI-2		SEF-B				VAV	1	3	AI-2			EN-EXH	AT FAN	01		EXH-3-AI-2											
AI-3		SEF-B				VAV	1	3	AI-3			EN-EXH	AT FAN	01		EXH-3-AI-3											
AI-4		SEF-B				VAV	1	3	AI-4			EN-EXH	AT FAN	01		EXH-3-AI-4											
AI-5		SEF-B				VAV	1	3	AI-5			EN-EXH	AT FAN	01		EXH-3-AI-5											
AI-6		SEF-B				VAV	1	3	AI-6			EN-EXH	AT FAN	01		EXH-3-AI-6											
BI-1		SEF-B	SEF7A-S	Smoke Exh Fan 7A Status	Off On	VAV	1	3	BI-1		BI# 24VAC	EN-EXH	AT FAN	01		EXH-3-BI-1					2/22	Device dependent	Aux Contact (NO)		U70		
BI-2		SEF-B	SEF7B-S	Smoke Exh Fan 7B Status	Off On	VAV	1	3	BI-2		BI# 24VAC	EN-EXH	AT FAN	01		EXH-3-BI-2					2/22	Device dependent	Aux Contact (NO)		U70		
BI-3		SEF-B	SEF8-S	Smoke Exh Fan 8 Status	Off On	VAV	1	3	BI-3		BI# 24VAC	EN-EXH	AT FAN	01		EXH-3-BI-3					2/22	Device dependent	Aux Contact (NO)		U70		
BI-4		SEF-B				VAV	1	3	BI-4			EN-EXH	AT FAN	01		EXH-3-BI-4											
BO-1		SEF-B				VAV	1	3	BO-1			EN-EXH	AT FAN	01		EXH-3-BO-1											
BO-2		SEF-B				VAV	1	3	BO-2			EN-EXH	AT FAN	01		EXH-3-BO-2											
BO-3		SEF-B				VAV	1	3	BO-3			EN-EXH	AT FAN	01		EXH-3-BO-3											
BO-4		SEF-B				VAV	1	3	BO-4			EN-EXH	AT FAN	01		EXH-3-BO-4											
BO-5		SEF-B				VAV	1	3	BO-5			EN-EXH	AT FAN	01		EXH-3-BO-5											
BO-6		SEF-B				VAV	1	3	BO-6			EN-EXH	AT FAN	01		EXH-3-BO-6											
BO-7		SEF-B				VAV	1	3	BO-7			EN-EXH	AT FAN	01		EXH-3-BO-7											
BO-8		SEF-B				VAV	1	3	BO-8			EN-EXH	AT FAN	01		EXH-3-BO-8											

Full Spreadsheet		Software				Digital Controller Information					Panel Information					Intermediate Device				Field Device			Ref Detail	Comment				
Tag	Point Type	System Name	Object Name	Expanded ID	Display Units	DC Type	N2 Trunk	N2 Addr	Cable Destination Bay/Terminal	Module Type	Termination	Panel	Panel Location	Slot Number	Reference Drawing	Cable Number	Wiring/Tubing	Termination In	Device	Termination Out	Location	Wiring/Tubing	Terminations	Device	Location	Ref Detail	Comment	
		SEF-C				VAV						EN-EXH	AT FAN														Power to Controller	
		SEF-C				VAV	1	6				EN-EXH	AT FAN	0													N2 Trunk	
AI-1		SEF-C				VAV	1	6	AI-1			EN-EXH	AT FAN	0		EXH-6-AI-1												
AI-2		SEF-C				VAV	1	6	AI-2			EN-EXH	AT FAN	0		EXH-6-AI-2												
AI-3		SEF-C				VAV	1	6	AI-3			EN-EXH	AT FAN	0		EXH-6-AI-3												
AI-4		SEF-C				VAV	1	6	AI-4			EN-EXH	AT FAN	0		EXH-6-AI-4												
AI-5		SEF-C				VAV	1	6	AI-5			EN-EXH	AT FAN	0		EXH-6-AI-5												
AI-6		SEF-C				VAV	1	6	AI-6			EN-EXH	AT FAN	0		EXH-6-AI-6												
BI-1		SEF-C	SEF9-S	Exh Fan 1 Status	Off On	VAV	1	6	BI-1		BI#,24VAC	EN-EXH	AT FAN	0		EXH-6-BI-1					2/22	Device dependent	Aux Contact (NO)			U70		
BI-2		SEF-C	SEF10A-S	Exh Fan 1 Status	Off On	VAV	1	6	BI-2		BI#,24VAC	EN-EXH	AT FAN	0		EXH-6-BI-2					2/22	Device dependent	Aux Contact (NO)			U70		
BI-3		SEF-C	SEF10B-S	Exh Fan 1 Status	Off On	VAV	1	6	BI-3		BI#,24VAC	EN-EXH	AT FAN	0		EXH-6-BI-3					2/22	Device dependent	Aux Contact (NO)			U70		
BI-4		SEF-C				VAV	1	6	BI-4			EN-EXH	AT FAN	0		EXH-6-BI-4												
BO-1		SEF-C				VAV	1	6	BO-1			EN-EXH	AT FAN	0		EXH-6-BO-1												
BO-2		SEF-C				VAV	1	6	BO-2			EN-EXH	AT FAN	0		EXH-6-BO-2												
BO-3		SEF-C				VAV	1	6	BO-3			EN-EXH	AT FAN	0		EXH-6-BO-3												
BO-4		SEF-C				VAV	1	6	BO-4			EN-EXH	AT FAN	0		EXH-6-BO-4												
BO-5		SEF-C				VAV	1	6	BO-5			EN-EXH	AT FAN	0		EXH-6-BO-5												
BO-6		SEF-C				VAV	1	6	BO-6			EN-EXH	AT FAN	0		EXH-6-BO-6												
BO-7		SEF-C				VAV	1	6	BO-7			EN-EXH	AT FAN	0		EXH-6-BO-7												
BO-8		SEF-C				VAV	1	6	BO-8			EN-EXH	AT FAN	0		EXH-6-BO-8												

Full Spreadsheet		Software				Digital Controller Information					Panel Information					Intermediate Device					Field Device			Ref Detail	Comment			
Tag	Point Type	System Name	Object Name	Expanded ID	Display Units	DC Type	N2 Trunk	N2 Addr	Cable Destination Bay/Terminal	Module Type	Termination	Panel	Panel Location	Slot Number	Reference Drawing	Cable Number	Wiring/Tubing	Termination In	Device	Termination Out	Location	Wiring/Tubing	Terminations			Device	Location	
		SEF-D				VAV						EN-EXH	AT FAN														Power to Controller	
		SEF-D				VAV	1	4				EN-EXH	AT FAN	0													N2 Trunk	
AI-1		SEF-D				VAV	1	4	AI-1			EN-EXH	AT FAN	0		EXH-4-AI-1												
AI-2		SEF-D				VAV	1	4	AI-2			EN-EXH	AT FAN	0		EXH-4-AI-2												
AI-3		SEF-D				VAV	1	4	AI-3			EN-EXH	AT FAN	0		EXH-4-AI-3												
AI-4		SEF-D				VAV	1	4	AI-4			EN-EXH	AT FAN	0		EXH-4-AI-4												
AI-5		SEF-D				VAV	1	4	AI-5			EN-EXH	AT FAN	0		EXH-4-AI-5												
AI-6		SEF-D				VAV	1	4	AI-6			EN-EXH	AT FAN	0		EXH-4-AI-6												
BI-1		SEF-D	SEF11-S	Smoke Exh Fan 11 Status	Off On	VAV	1	4	BI-1		BI#_24VAC	EN-EXH	AT FAN	0		EXH-4-BI-1				2/22		Device dependent	Aux Contact (NO)			U70		
BI-2		SEF-D	SEF12-S	Smoke Exh Fan 12 Status	Off On	VAV	1	4	BI-2		BI#_24VAC	EN-EXH	AT FAN	0		EXH-4-BI-2				2/22		Device dependent	Aux Contact (NO)			U70		
BI-3		SEF-D				VAV	1	4	BI-3			EN-EXH	AT FAN	0		EXH-4-BI-3												
BI-4		SEF-D				VAV	1	4	BI-4			EN-EXH	AT FAN	0		EXH-4-BI-4												
BO-1		SEF-D				VAV	1	4	BO-1			EN-EXH	AT FAN	0		EXH-4-BO-1												
BO-2		SEF-D				VAV	1	4	BO-2			EN-EXH	AT FAN	0		EXH-4-BO-2												
BO-3		SEF-D				VAV	1	4	BO-3			EN-EXH	AT FAN	0		EXH-4-BO-3												
BO-4		SEF-D				VAV	1	4	BO-4			EN-EXH	AT FAN	0		EXH-4-BO-4												
BO-5		SEF-D				VAV	1	4	BO-5			EN-EXH	AT FAN	0		EXH-4-BO-5												
BO-6		SEF-D				VAV	1	4	BO-6			EN-EXH	AT FAN	0		EXH-4-BO-6												
BO-7		SEF-D				VAV	1	4	BO-7			EN-EXH	AT FAN	0		EXH-4-BO-7												
BO-8		SEF-D				VAV	1	4	BO-8			EN-EXH	AT FAN	0		EXH-4-BO-8												

ELECTRICAL SUBSTATIONS

- TMP-S HIGH TEMPERATURE ALARM
IN SUBSTATION ENCLOSURE
(CONTACT BY DIVISION 16)
- DCM-S DIGITAL ELECTRIC METER
IN SUBSTATION ENCLOSURE
(CONTACT BY DIVISION 16)

SUBSTATION	LOCATION	JCI PANEL
SS1-PRA	PRESS LEVEL ELECTRICAL ROOM QUAD A	EN-ELEC-A1
SS2-PRA	PRESS LEVEL ELECTRICAL ROOM QUAD A	EN-ELEC-A2
SS1-PRB	PRESS LEVEL ELECTRICAL ROOM QUAD B	EN-ELEC-B1
SS2-PRB	PRESS LEVEL ELECTRICAL ROOM QUAD B	EN-ELEC-B2
SS1-PRC	PRESS LEVEL ELECTRICAL ROOM QUAD C	EN-ELEC-C1
SS2-PRC	PRESS LEVEL ELECTRICAL ROOM QUAD C	EN-ELEC-C2
SS1-PRD	PRESS LEVEL ELECTRICAL ROOM QUAD D	EN-ELEC-D1
SS2-PRD	PRESS LEVEL ELECTRICAL ROOM QUAD D	EN-ELEC-D2
SS1-SRB	SERVICE LEVEL ELECTRICAL ROOM QUAD B	EN-ELEC-S1
SS2-SRB	SERVICE LEVEL ELECTRICAL ROOM QUAD B	EN-ELEC-S2
SS3-SRB	SERVICE LEVEL ELECTRICAL ROOM QUAD B	EN-ELEC-S3
SSFP-SRB	SERVICE LEVEL ELECTRICAL ROOM QUAD B	EN-ELEC-S4
SSGE-SRB	SERVICE LEVEL ELECTRICAL ROOM QUAD B	EN-ELEC-S5
SSGL-SRB	SERVICE LEVEL ELECTRICAL ROOM QUAD B	EN-ELEC-S6

HEAT TRACE PANELS

- HTP-S PANEL ALARM
CONTACT IN ENCLOSURE
(CONTACT BY DIVISION 16)

HEAT TRACE	LOCATION	JCI PANEL
QUAD A	MAIN CONCOURSE ELECTRICAL ROOM QUAD A	EN-ELEC-A1
QUAD B	MAIN CONCOURSE ELECTRICAL ROOM QUAD B	EN-ELEC-B1
QUAD C	MAIN CONCOURSE ELECTRICAL ROOM QUAD C	EN-ELEC-C1
QUAD D	MAIN CONCOURSE ELECTRICAL ROOM QUAD D	EN-ELEC-D1

CONCOURSE LEVEL TOILET EXHAUST FANS

TEFA4-C

EXHAUST FAN	LOCATION	JCI PANEL
TEF-A4	MAIN CONCOURSE LEVEL QUAD A	EN-ELEC-A1
TEF-A5	MAIN CONCOURSE LEVEL QUAD A	EN-ELEC-A1
TEF-A6	MAIN CONCOURSE LEVEL QUAD A	EN-AHU-1
TEF-A9	MAIN CONCOURSE LEVEL QUAD A	EN-AHU-1
TEF-B9	MAIN CONCOURSE LEVEL QUAD B	EN-AHU-2
TEF-B10	MAIN CONCOURSE LEVEL QUAD B	EN-AHU-2
TEF-B12	MAIN CONCOURSE LEVEL QUAD B	EN-AHU-2
TEF-B13	MAIN CONCOURSE LEVEL QUAD B	EN-AHU-2
TEF-C1	MAIN CONCOURSE LEVEL QUAD C	EN-ELEC-C1
TEF-C2	MAIN CONCOURSE LEVEL QUAD C	EN-ELEC-C1
TEF-C3	MAIN CONCOURSE LEVEL QUAD C	EN-AHU-3
TEF-D1	MAIN CONCOURSE LEVEL QUAD D	EN-AHU-4
TEF-D4	MAIN CONCOURSE LEVEL QUAD D	EN-ELEC-D1
TEF-D5	MAIN CONCOURSE LEVEL QUAD D	EN-ELEC-D1

ELECTRICAL SUB-STATIONS

SUBSTATION TRANSFORMER HIGH TEMPERATURE ALARMS AND SUBSTATION ELECTRIC USAGE WILL BE MONITORED THROUGH THE METATSYS SYSTEM.

ELECTRIC HEAT TRACE SYSTEMS

THE FOUR (4) MAIN HEAT TRACE SYSTEM PANEL ALARMS WILL BE MONITORED THROUGH THE METATSYS SYSTEM.

CONCOURSE LEVEL TOILET ROOMS

CONCOURSE LEVEL TOILET ROOMS HAVE THREE (2) MODES OF STANDARD OPERATION AS FOLLOWS:

1. OCCUPIED - FULLY OPERATIONAL DURING STADIUM EVENT.
2. UNOCCUPIED - NOT VENTILATED BETWEEN STADIUM EVENTS DURING THE NFL SEASON.


THE METATSYS SYSTEM WILL HAVE THE ABILITY TO CONTROL INDIVIDUAL TOILET ROOM COMPONENTS (ON/OFF) AS REQUIRED BY THE MODE OF OPERATION. IN THE OCCUPIED MODE, INDIVIDUAL TOILET EXHAUST FANS WILL START AND RUN CONTINUOUSLY. GRAVITY OPERATED BACKDRAFT DAMPER ON FAN WILL RESPOND TO FAN OPERATION. IN THE UNOCCUPIED MODE INDIVIDUAL TOILET EXHAUST FANS WILL BE DE-ENERGIZED AND BACKDRAFT DAMPERS WILL CLOSE. PLUMBING LINE ARE VALVED OFF AND DRAINED, FIXTURES HAD TRAPS ARE PROTECTED FROM FREEZING WITH GLYCOL. THE JANITOR'S CLOSET ASSOCIATED WITH EACH TOILET ROOM WILL REMAIN HEATED THROUGHOUT THE HEATING SEASON. ISOLATION OF WATER PIPING AND DRAINING OF TOILET ROOM BRANCH LINES OCCURS IN THIS ROOM. HEATERS IN JANITOR'S CLOSET WILL BE ADJUSTED TO MAINTAIN FIFTY-FIVE (55F).

CABINET HEATERS FAN AND HEATING ELEMENTS WILL BE CYCLED ON AND OFF TO MAINTAIN A FIFTY-FIVE (55F) SPACE TEMPERATURE IN THE OCCUPIED OR UNOCCUPIED MODE.

BILL OF MATERIALS		
Estimate:	electric	70520098.pre
Desig.	QtyPart #	Description
Field Devices:		
TEF, CUH	14 BZ-1000-11	ENCL, 4-5/8X 5-1/8 X 3-3/8
	14 PD-101-35	RLY BASE, 3PDT, 11PIN, 10A
	14 PD-109-51	RELAY PLUG-IN 3PDT 24VAC
Panel Devices:		
DC-1	14 AS-VAV110-1	VAV 6AI, 4BI, 8BO, 8K
EN-ELEC-x	14 EN-ENC15-0	UNIV PKG MOD, SING, W 50VA

REVISION INFORMATION	Drawing Title	AS-BUILT		DATE	BY
NUMBER	SUBSTATION ELEC METERING HEAT TRACE PANELS MAIN CONCOURSE TOILET EXHAUST FANS			7/18/00	CME
DATE		REFERENCE DRAWING	NO.	REVISION-LOCATION	ECN
07/18/00		SALES ENGINEER	PROJECT MANAGER	APPLICATION ENGINEER	DRAWN
		JDP	WJT	RTS	APPROVED
TIME	PROJECT TITLE	BY	DATE	DATE	DATE
03:44 PM	BALTIMORE NFL STADIUM AT CAMDEN YARDS	RTS	09/11/97		
FILE NAME		Branch Information		CONTRACT NUMBER	
ELECTRIC.vsd	BALTIMORE, MARYLAND	JOHNSON CONTROLS Systems & Services Division		7052-0098	
		Johnson Controls, Inc. 60 Loveton Circle Sparks, Md 21152		DRAWING NUMBER	
				BL-6559-47	

Full Spreadsheet		Software				Digital Controller Information					Panel Information				Intermediate Device				Field Device				Ref Detail	Comment				
Tag	Point Type	System Name	Object Name	Expanded ID	Display Units	DIC Type	N2 Trunk	N2 Addr	Cable Destination Bay/Terminal	Module Type	Termination	Panel	Panel Location	Slot Number	Reference Drawing	Cable Number	Wiring/Tubing	Termination In	Device	Termination Out	Location	Wiring/Tubing	Terminations	Device	Location	Ref Detail	Comment	
		ELEC-A1				VA/V																						
		ELEC-A1				VA/V	1	4																				
AI-1		ELEC-A1				VA/V	1	4	AI-1							ELECA-4-AI-1												
AI-2		ELEC-A1				VA/V	1	4	AI-2							ELECA-4-AI-2												
AI-3		ELEC-A1				VA/V	1	4	AI-3							ELECA-4-AI-3												
AI-4		ELEC-A1				VA/V	1	4	AI-4							ELECA-4-AI-4												
AI-5		ELEC-A1				VA/V	1	4	AI-5							ELECA-4-AI-5												
AI-6		ELEC-A1				VA/V	1	4	AI-6							ELECA-4-AI-6												
BI-1		ELEC-A1				VA/V	1	4	BI-1							ELECA-4-BI-1												
BI-2		ELEC-A1	HTP-A	Heat Trace Panel Quad A	Normal Alarm	VA/V	1	4	BI-2		BI#,24VAC					ELECA-4-BI-2												
BI-3		ELEC-A1	TMP-A1	Substation SS1-PRA Temp	Normal Alarm	VA/V	1	4	BI-3		BI#,24VAC					ELECA-4-BI-3					2/22	Device dependent	Panel Contact (NO)		U70			
BI-4		ELEC-A1	ELE-A1	Substation SS1-PRA Elec	Kw	VA/V	1	4	BI-4		BI#,24VAC					ELECA-4-BI-4					2/22	Device dependent	Panel Contact (NO)		U70			
BO-1		ELEC-A1	TEFA4-C	Toilet Exh Fan A4 Cntrl	Off On	VA/V	1	4	BO-1		BO#,24VAC					ELECA-4-BO-1					2/22	Device dependent	Panel Contact (NO)		U70			
BO-2		ELEC-A1	TEFA5-C	Toilet Exh Fan A5 Cntrl	Off On	VA/V	1	4	BO-2		BO#,24VAC					ELECA-4-BO-2					2/18	Device dependent	24VAC OUT		U51			
BO-3		ELEC-A1				VA/V	1	4	BO-3							ELECA-4-BO-3												
BO-4		ELEC-A1				VA/V	1	4	BO-4							ELECA-4-BO-4												
BO-5		ELEC-A1				VA/V	1	4	BO-5							ELECA-4-BO-5												
BO-6		ELEC-A1				VA/V	1	4	BO-6							ELECA-4-BO-6												
BO-7		ELEC-A1				VA/V	1	4	BO-7							ELECA-4-BO-7												
BO-8		ELEC-A1				VA/V	1	4	BO-8							ELECA-4-BO-8												

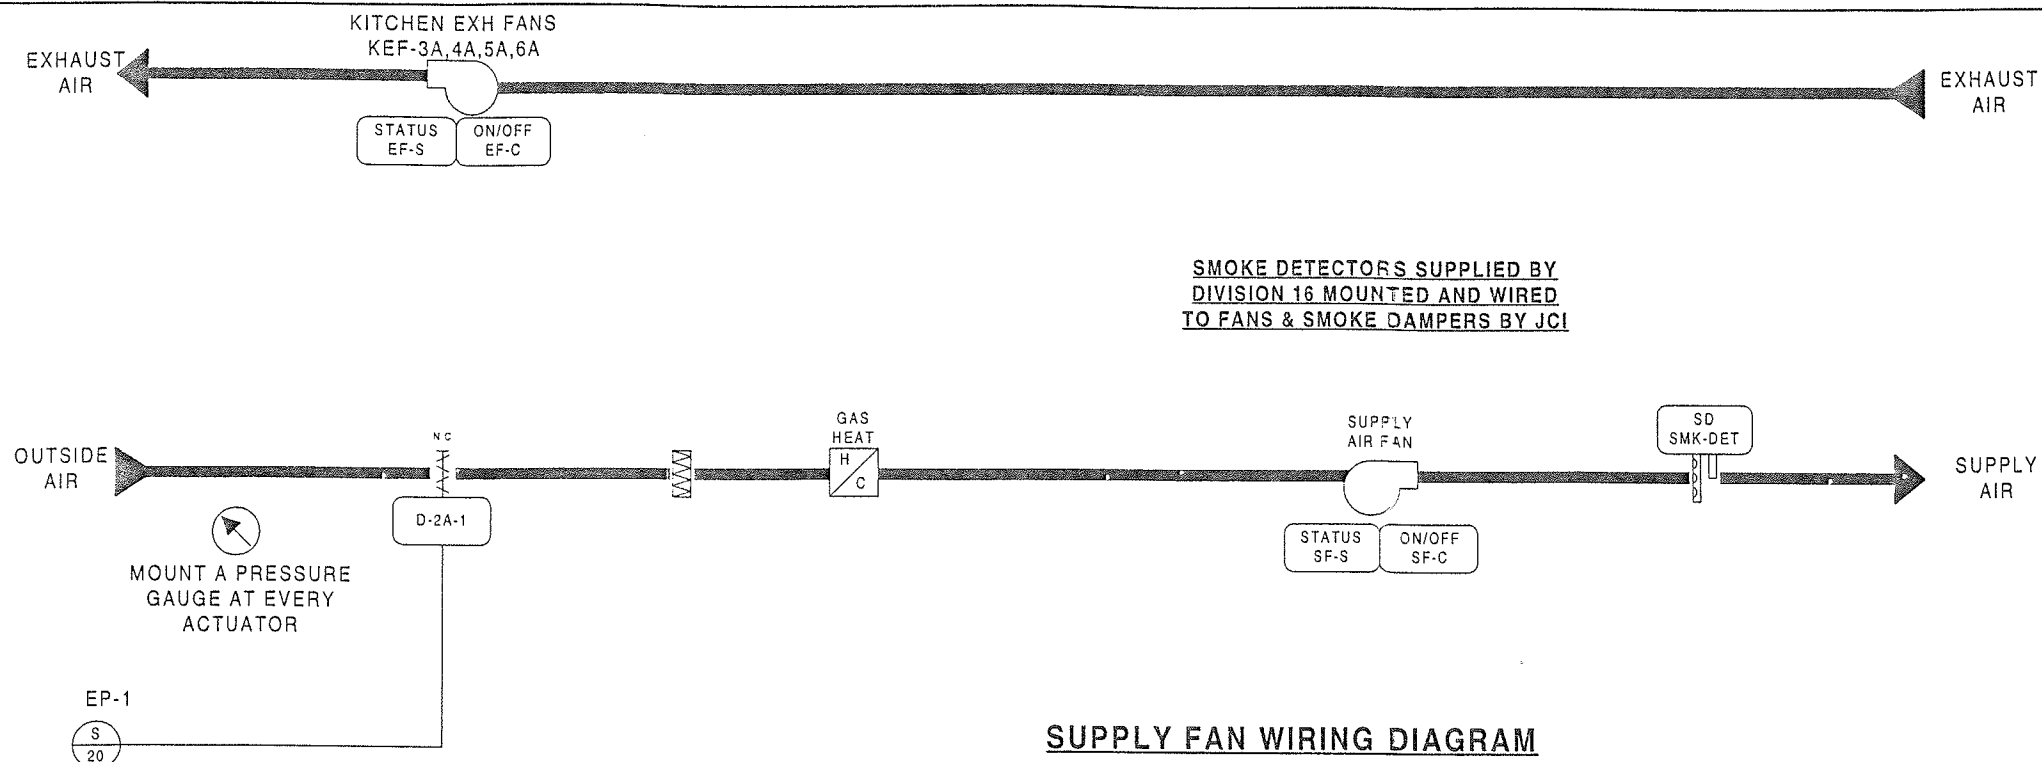

Estimate: mau-2a
Desig. QtyPart # Description


Field Devices:

D-2A-1	1	---	SEE DAMPER SCHEDULE
	1	D-3153-2	DMPR ACT, 8-13#
	1	G-2010-11	GAGE, 2", 0-30 PSIG, STEM
EP-1	1	V11HAA-100	3-W SOLENOID, W/OV, 120VAC
T-1	1	TE-6315P-1	SENS, T-Ni, 0.1#, 8' AVG
EF-3A, 4A, 5A, 6A	2	BZ-1000-11	ENCL, 4-5/8X 5-1/8 X 3-3/8
	2	PD-101-35	RLY BASE, 3PDT, 11P IN, 10A
	2	PD-109-51	RELAY PLUG-IN 3PDT 24VAC
ZN-T	1	TE-6410W-1000	MSTAT, NI, BOX, JACK




Panel Devices:

EN-MAU-2A	1	AS-UNT111-101	UNT111 MTD IN UPM. W/50VA
	1	EN-EXP101-0	UNIV PKG MOD, CVR & BACKBN
RLY-1, 2	2	AS-RLY002-0	RELAY; 2SPDT 5 AMP 240VAC

SUPPLY FAN WIRING DIAGRAM

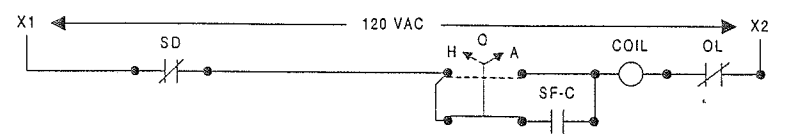

TYPICAL EXHAUST FAN WIRING DIAGRAM

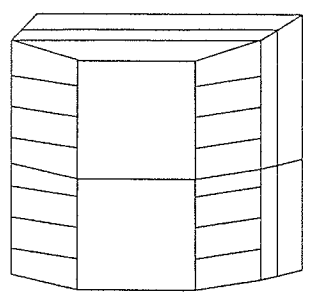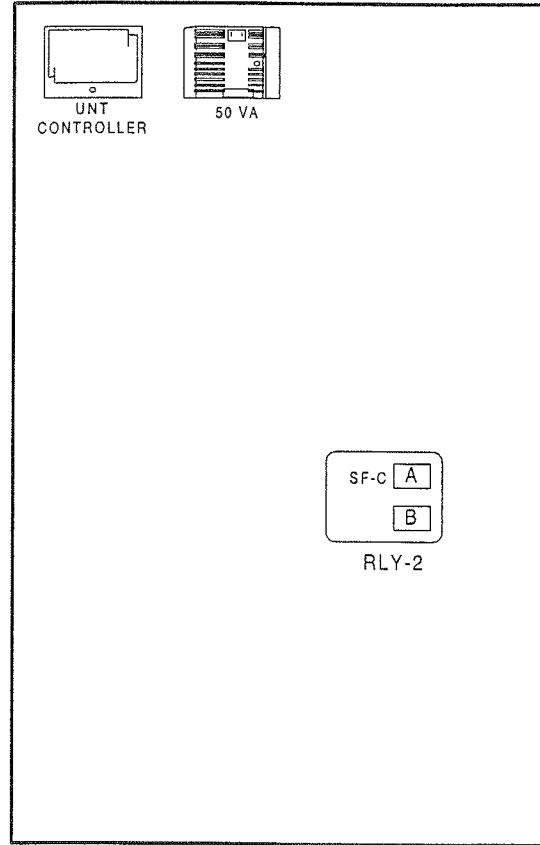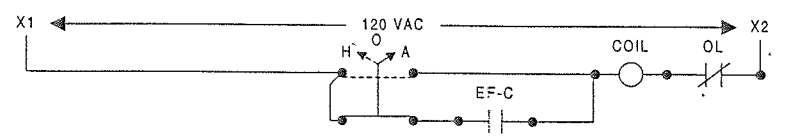

ENCLOSURE EN-MAU-2A
AS-UNT111-101
LOCATED ADJACENT
TO UNIT
NCM-1/N2 ADD = 3

DESCRIPTION OF OPERATION

THE METASYS SYSTEM WILL HAVE THE ABILITY TO CONTROL INDIVIDUAL CONCESSION COMPONENTS (ON/OFF) AS REQUIRED BY THE MODE OF OPERATION. IN THE OCCUPIED MODE, INDIVIDUAL CONCESSION MAKEUP AIR UNIT MAU-2A AND EXHAUST FANS KEF-3A, 4A, 5A, 6A WILL START AND RUN CONTINUOUSLY. WHEN THE UNIT AND EXHAUST FANS ARE ENERGIZED, OUTSIDE AIR DAMPER D-2A-1, WILL OPEN. ROOM SENSOR TR-1 WILL CYCLE DIRECT GAS FIRED HEATER TO MAINTAIN ITS SETPOINT. DISCHARGE SENSOR T-1 WILL MONITOR SUPPLY TEMPERATURE AND PROVE GAS FIRING OF UNIT.

OCCUPIED HEATING MODE - SUPPLY FAN WILL BE RUNNING. OUTSIDE AIR DAMPER D-2A-1 WILL OPEN AND EXHAUST FANS WILL START AND RUN CONTINUOUSLY. THE DIRECT GAS FIRED HEATER WILL BE ACTIVATED BY ZONE SENSOR TR-1 TO MAINTAIN ITS SETTING OF FIFTY (50F). THE DIRECT GAS FIRED HEATER WILL BE MONITORED BY T-1. THE SYSTEM WILL ALARM WHEN ROOM SENSOR TR-1 DROPS BELOW FIFTY (50F). DIRECT GAS FIRED HEATER CONTROL PANEL WILL BE INTERLOCKED WITH GAS EMERGENCY SHUT OFF SYSTEM ASSOCIATED WITH GAS COOKING EQUIPMENT. AUTOMATIC SHUT-DOWN WILL BE PROVIDED AS REQUIRED BY NFPA.

UNOCCUPIED HEATING MODE - MAKE-UP AIR UNIT AND EXHAUST FANS WILL BE DE-ENERGIZED AND OUTSIDE AIR DAMPER WILL CLOSE. ELECTRIC UNIT HEATERS (WITH BUILT-IN THERMOSTAT) WILL CYCLE (ON/OFF) TO MAINTAIN FIFTY (50F).


OCCUPIED COOLING MODE - NONE

UNOCCUPIED COOLING MODE - NONE

SMOKE CONTROL - SMOKE DETECTORS WILL, ON THE DETECTION OF PRODUCTS OF COMBUSTION, SHUT DOWN THE SUPPLY AND EXHAUST FANS AND CLOSE ALL SYSTEM DAMPERS.

REVISION INFORMATION	IN CONSIDERATION OF THE RECEIPT OF THIS DOCUMENT, THE RECIPIENT AGREES NOT TO REPRODUCE, COPY, USE OR TRANSMIT THIS DOCUMENT AND/OR THE INFORMATION THEREIN CONTAINED, IN WHOLE OR IN PART, OR TO SUFFER SUCH ACTION BY OTHERS, FOR ANY PURPOSE, EXCEPT WITH THE WRITTEN PERMISSION OF JOHNSON CONTROLS, INC. AND FURTHER AGREES TO SURRENDER SAME TO JOHNSON CONTROLS, INC. UPON DEMAND. COPYRIGHT JOHNSON CONTROLS, INC. 1999	DRAWING TITLE	AS-BUILT		7/18/00	CME		
NUMBER		MAKE-UP AIR UNIT 2A KITCHEN FOOD SERVICE	NO.	REVISION-LOCATION	ECN	DATE	BY	
DATE		07/18/00	CLUB LEVEL QUAD A	Sales Engineer	Project Manager	Application Engineer	DRAWN	APPROVED
TIME		03:46 PM	BALTIMORE NFL STADIUM AT CAMDEN YARDS	JDP	WJT	RTS	BY RTS	DATE 09/16/97
FILE NAME	MAU-2A.vsd	BALTIMORE, MARYLAND			Branch Information	CONTRACT NUMBER		
			Systems & Services Division		JOHNSON CONTROLS 60 LOVETON CIRCLE SPARKS, MD 21152	7052-0098		
						DRAWING NUMBER		
						BL-6559-48		

Full Spreadsheet		Software				Digital Controller Information						Panel Information				Intermediate Device				Field Device				Ref Detail	Comment			
Tag	Point Type	System Name	Object Name	Expanded ID	Display Units	DC Type	N2 Trunk	N2 Addr	Cable Destination Bay/Terminal	Module Type	Termination	Panel	Panel Location	Slot Number	Reference Drawing	Cable Number	Wiring/Tubing	Termination In	Device	Termination Out	Location	Wiring/Tubing	Terminations	Device	Location	Ref Detail	Comment	
		MAU-2A				LINT						EN-MAU2BIAT UNIT															Power to Controller	
		MAU-2A				LINT	1	3				EN-MAU2BIAT UNIT															N2 Trunk	
AI-1		MAU-2A				LINT			3AI-1			EN-MAU2BIAT UNIT				MAU2B-3-AI-1												
AI-2		MAU-2A				LINT			3AI-2			EN-MAU2BIAT UNIT				MAU2B-3-AI-2												
AI-3		MAU-2A				LINT			3AI-3			EN-MAU2BIAT UNIT				MAU2B-3-AI-3												
AI-4		MAU-2A	ZN-T	Zone Temperature	Deg F	LINT			3AI-4			EN-MAU2BIAT UNIT				MAU2B-3-AI-4												
AI-5		MAU-2A				LINT			3AI-5			EN-MAU2BIAT UNIT				MAU2B-3-AI-5												
AI-6		MAU-2A				LINT			3AI-6			EN-MAU2BIAT UNIT				MAU2B-3-AI-6												
BI-1		MAU-2A	SF-S	Supply Fan Status	Off On	LINT			3BI-1			EN-MAU2BIAT UNIT				MAU2B-3-BI-1												
BI-2		MAU-2A	EF-S	Exh Fan Status	Off On	LINT			3BI-2			EN-MAU2BIAT UNIT				MAU2B-3-BI-2						12/22	Device dependent	Aux Contact (NO)			U70	
BI-3		MAU-2A	SMK-DET	Smoke Detectors	Normal Alarm	LINT			3BI-3			EN-MAU2BIAT UNIT				MAU2B-3-BI-3						12/22	Device dependent	Aux Contact (NO)			U70	
BI-4		MAU-2A				LINT			3BI-4			EN-MAU2BIAT UNIT				MAU2B-3-BI-4												
BO-1		MAU-2A				LINT			3BO-1			EN-MAU2BIAT UNIT				MAU2B-3-BO-1												
BO-2		MAU-2A				LINT			3BO-2			EN-MAU2BIAT UNIT				MAU2B-3-BO-2												
BO-3		MAU-2A	SF-C	Supply Fan Control	Off On	LINT			3BO-3	RLY	BO#.24V.CCM	EN-MAU2BIAT UNIT				MAU2B-3-BO3/18		A.COILS.COM	RELAY-A	NO.COM			12/14	See starter detail	Starter (NO)-(sw lg)		U60	
BO-4		MAU-2A	EF-C	Exh Fan Control	Off On	LINT			3BO-4		BO#.24VAC	EN-MAU2BIAT UNIT				MAU2B-3-BO-4							12/18	Device dependent	24VAC OUT (sw lg)		U51	
BO-5		MAU-2A				LINT			3BO-5			EN-MAU2BIAT UNIT				MAU2B-3-BO-5												
BO-6		MAU-2A				LINT			3BO-6			EN-MAU2BIAT UNIT				MAU2B-3-BO-6												
AO-1		MAU-2A				LINT			3AO-1			EN-MAU2BIAT UNIT				MAU2B-3-AO-1												
AO-2		MAU-2A				LINT			3AO-2			EN-MAU2BIAT UNIT				MAU2B-3-AO-2												

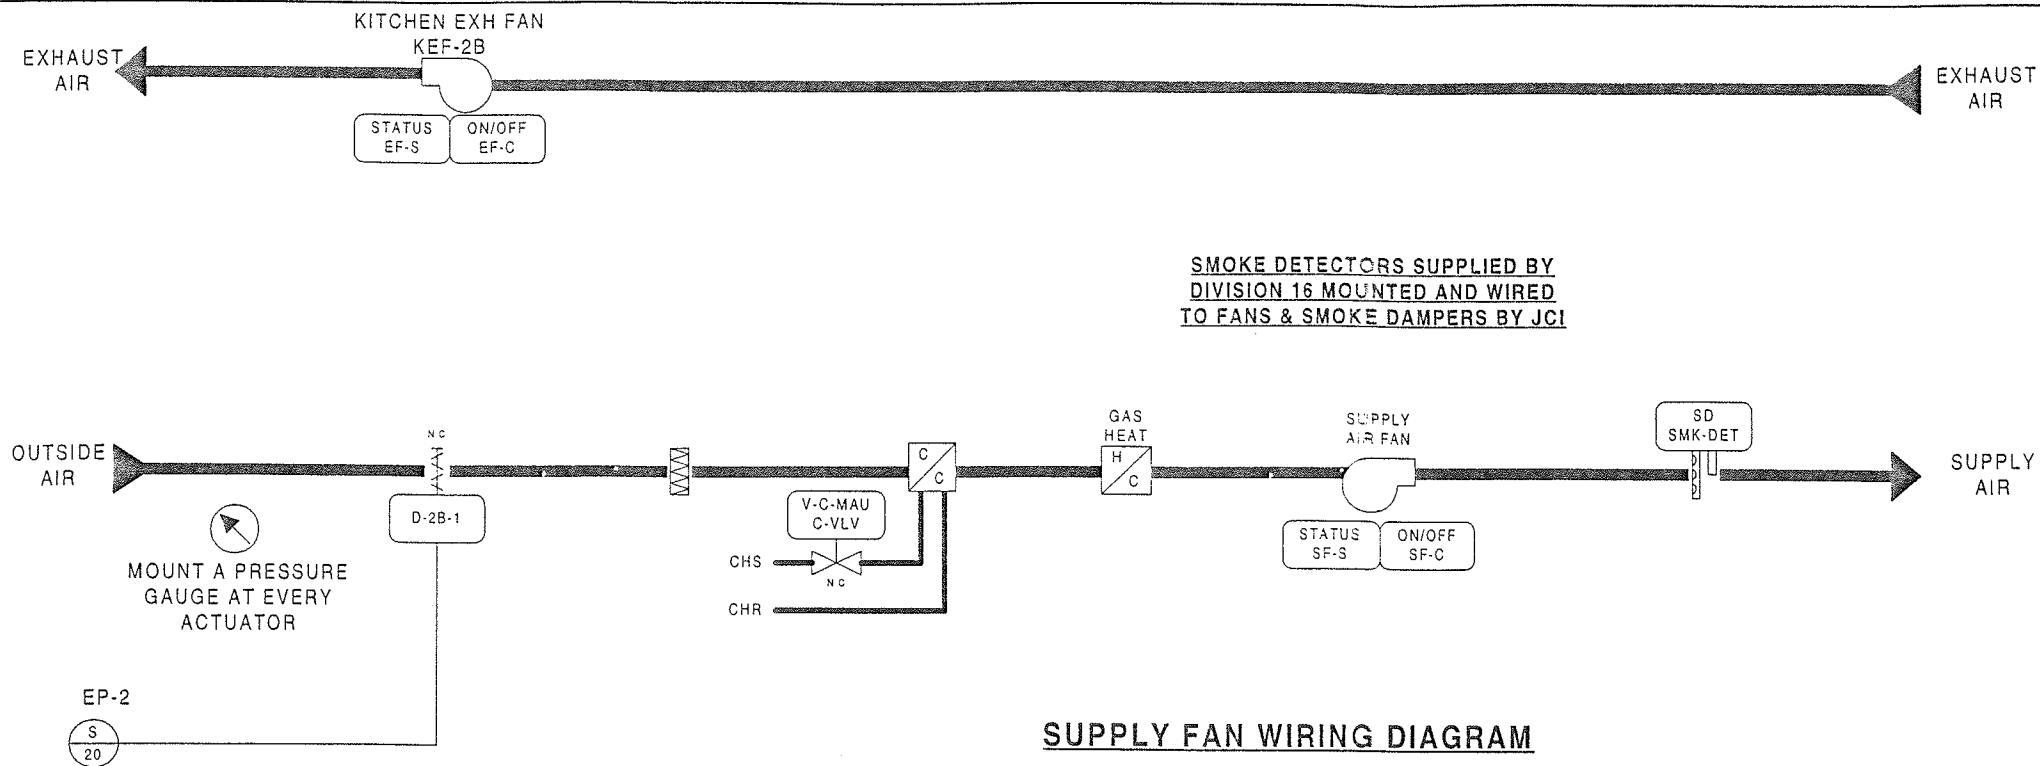


BILL OF MATERIALS




Estimate: mau-2b 70520098.pre

Desig.	Qty	Part #	Description
Field Devices:			
D-2B-1	1	---	SEE DAMPER SCHEDULE
	1	D-3153-2	DMPR ACT, 8-13#
	1	G-2010-11	GAGE, 2", 0-30 PSIG, STEM
EP-2B	1	BZ-1000-11	ENCL, 4-5/8X 5-1/8 X 3-3/8
	1	PD-101-35	RLY BASE, 3PDT, 11PIN, 10A
	1	PD-109-51	RELAY PLUG-IN 3PDT 24VAC
EP-2	1	V11HAA-100	3-W SOLENOID, W/CV, 120VAC
T-1	1	TE-6315P-1	SENS, T-NI, 0.1%, 8' AVG
V-C-MAU	1	--	SEE VALVE SCHEDULE
ZN-T	1	TE-6410W-1000	HSTAT, NI, BOX, JACK
Panel Devices:			
EN-MAU-2B	1	AS-UNT111-101	UNT111 MTD IN UPM. W/50VA
	1	EN-EXP101-0	UNIV PKG MOD, CVR & BACKBN
EP-1	1	EP-8000-2	XDUCR, EP, 0/10V, HZ VOL
PI-1	1	G-2010-11	GAGE, 2", 0-30 PSIG, STEM
RLY-1,2	2	AS-RL7002-0	RELAY; 2SPDT 5 AMP 240VAC

SUPPLY FAN WIRING DIAGRAM

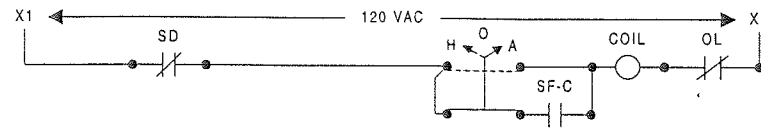

TYPICAL EXHAUST FAN WIRING DIAGRAM

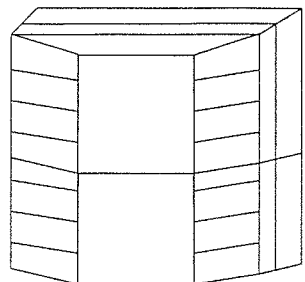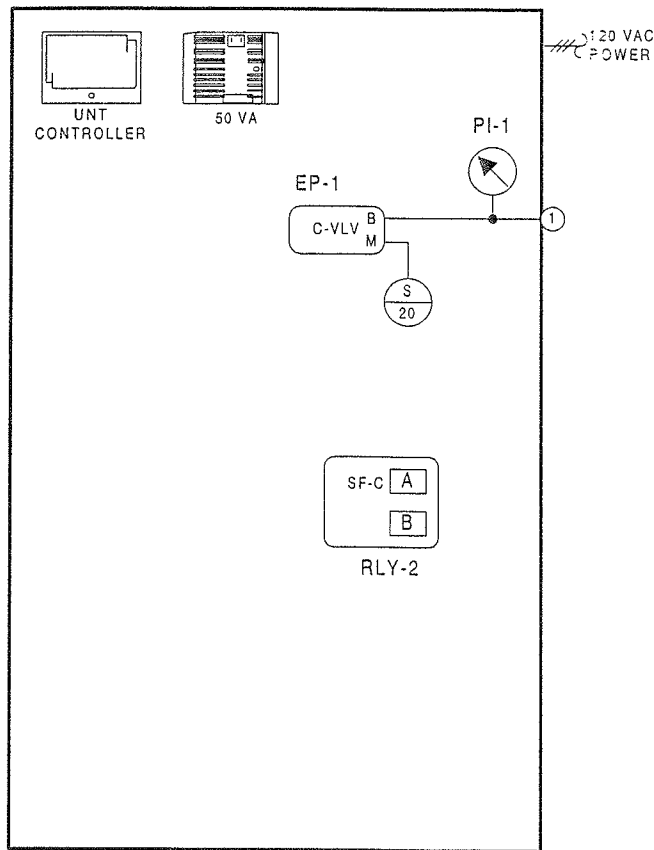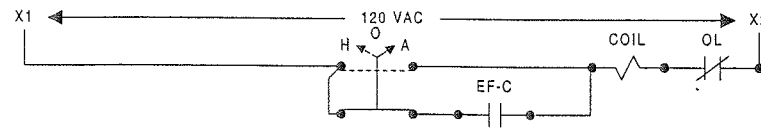

ENCLOSURE EN-MAU-2B
AS-UNT111-101
LOCATED ADJACENT
TO UNIT
NCM-2/N2 ADD = 4

DESCRIPTION OF OPERATION

THE METASYS SYSTEM WILL HAVE THE ABILITY TO CONTROL INDIVIDUAL CONCESSION COMPONENTS (ON/OFF) AS REQUIRED BY THE MODE OF OPERATION. IN THE OCCUPIED MODE, INDIVIDUAL CONCESSION MAKEUP AIR UNIT MAU-2B AND EXHAUST FAN KEF-2B WILL START AND RUN CONTINUOUSLY. WHEN THE UNIT AND EXHAUST FANS ARE ENERGIZED, OUTSIDE AIR DAMPER D-2B-1, WILL OPEN. ROOM SENSOR TR-1 WILL CYCLE DIRECT GAS FIRED HEATER TO MAINTAIN ITS SETPOINT. DISCHARGE SENSOR T-1 WILL MONITOR SUPPLY TEMPERATURE AND PROVE GAS FIRING OF UNIT.

OCCUPIED HEATING MODE - SUPPLY FAN WILL BE RUNNING. OUTSIDE AIR DAMPER D-2B-1 WILL OPEN AND EXHAUST FANS WILL START AND RUN CONTINUOUSLY. THE DIRECT GAS FIRED HEATER WILL BE ACTIVATED BY ZONE SENSOR TR-1 TO MAINTAIN ITS SETTING OF FIFTY (50F). THE DIRECT GAS FIRED HEATER WILL BE MONITORED BY T-1. THE SYSTEM WILL ALARM WHEN ROOM SENSOR TR-1 DROPS BELOW FIFTY (50F). DIRECT GAS FIRED HEATER CONTROL PANEL WILL BE INTERLOCKED WITH GAS EMERGENCY SHUT OFF SYSTEM ASSOCIATED WITH GAS COOKING EQUIPMENT. AUTOMATIC SHUT-DOWN WILL BE PROVIDED AS REQUIRED BY NFPA.

UNOCCUPIED HEATING MODE - MAKE-UP AIR UNIT AND EXHAUST FANS WILL BE DE-ENERGIZED AND OUTSIDE AIR DAMPER WILL CLOSE. ELECTRIC UNIT HEATERS (WITH BUILT-IN THERMOSTAT) WILL CYCLE (ON/OFF) TO MAINTAIN FIFTY (50F).


OCCUPIED COOLING MODE - SUPPLY FAN WILL BE RUNNING AND OUTSIDE AIR DAMPER WILL BE OPEN. ROOM SENSOR TR-1 THROUGH THE METASYS SYSTEM WILL MODULATE CHILLED WATER VALVE V-C-MAU TO MAINTAIN ROOM TEMPERATURE SETTING OF EIGHTY (80F).

UNOCCUPIED COOLING MODE - SYSTEM IS DE-ENERGIZED AND FANS ARE OFF. OUTSIDE AIR DAMPER AND CHILLED WATER VALVE WILL BE CLOSED.

SMOKE CONTROL - SMOKE DETECTORS WILL, ON THE DETECTION OF PRODUCTS OF COMBUSTION, SHUT DOWN THE SUPPLY AND EXHAUST FANS AND CLOSE ALL SYSTEM DAMPERS.

REVISION INFORMATION NUMBER DATE 07/18/00 TIME 03:48 PM FILE NAME MAU-2B.vsd	IN CONSIDERATION OF THE RECEIPT OF THIS DOCUMENT, THE RECIPIENT AGREES NOT TO REPRODUCE, COPY, USE OR TRANSMIT THIS DOCUMENT AND/OR THE INFORMATION THEREIN CONTAINED, IN WHOLE OR IN PART, OR TO SUFFER SUCH ACTION BY OTHERS, FOR ANY PURPOSE, EXCEPT WITH THE WRITTEN PERMISSION OF JOHNSON CONTROLS, INC. AND FURTHER AGREES TO SURRENDER SAME TO JOHNSON CONTROLS, INC. UPON DEMAND. COPYRIGHT JOHNSON CONTROLS, INC. 1998	DRAWING TITLE MAKE-UP AIR UNIT 2B CLC-2-PANTRY CLUB LEVEL QUAD B PROJECT TITLE BALTIMORE NFL STADIUM AT CAMDEN YARDS BALTIMORE, MARYLAND	<table border="1"> <tr> <td>AS-BUILT</td> <td>7/18/00</td> <td>CME</td> </tr> <tr> <td>REFERENCE DRAWING NO.</td> <td>REVISION-LOCATION</td> <td>ECN</td> </tr> <tr> <td>Sales Engineer JDP</td> <td>Project Manager WJT</td> <td>Application Engineer RTS</td> </tr> <tr> <td colspan="2">DRAWN BY RTS</td> <td>DATE 09/16/97</td> </tr> <tr> <td colspan="2">Branch Information</td> <td>CONTRACT NUMBER</td> </tr> <tr> <td colspan="2">JOHNSON CONTROLS 80 LOVETON CIRCLE SPARKS, MD 21152</td> <td>7052-0098</td> </tr> <tr> <td colspan="2">Systems & Services Division</td> <td>DRAWING NUMBER BL-6559-49</td> </tr> </table>	AS-BUILT	7/18/00	CME	REFERENCE DRAWING NO.	REVISION-LOCATION	ECN	Sales Engineer JDP	Project Manager WJT	Application Engineer RTS	DRAWN BY RTS		DATE 09/16/97	Branch Information		CONTRACT NUMBER	JOHNSON CONTROLS 80 LOVETON CIRCLE SPARKS, MD 21152		7052-0098	Systems & Services Division		DRAWING NUMBER BL-6559-49
AS-BUILT	7/18/00	CME																						
REFERENCE DRAWING NO.	REVISION-LOCATION	ECN																						
Sales Engineer JDP	Project Manager WJT	Application Engineer RTS																						
DRAWN BY RTS		DATE 09/16/97																						
Branch Information		CONTRACT NUMBER																						
JOHNSON CONTROLS 80 LOVETON CIRCLE SPARKS, MD 21152		7052-0098																						
Systems & Services Division		DRAWING NUMBER BL-6559-49																						

Full Spreadsheet		Software				Digital Controller Information						Panel Information					Intermediate Device				Field Device				Ref Detail	Comment		
Tag	Point Type	System Name	Object Name	Expanded ID	Display Units	DC Type	N2 Trunk	N2 Addr	Cable Destination Bay/Terminal	Module Type	Termination	Panel	Panel Location	Slot Number	Reference Drawing	Cable Number	Wiring/Tubing	Termination In	Device	Termination Out	Location	Wiring/Tubing	Terminations	Device	Location	Ref Detail	Comment	
		MAU-2B				JNT						EN-MAU2BJAT UNIT																
		MAU-2B				JNT		4				EN-MAU2BJAT UNIT															Power to Controller	
AI-1		MAU-2B				JNT		4AI-1				EN-MAU2BJAT UNIT				MAU2B-4-AI-1												N2 Trunk
AI-2		MAU-2B				JNT		4AI-2				EN-MAU2BJAT UNIT				MAU2B-4-AI-2												
AI-3		MAU-2B				JNT		4AI-3				EN-MAU2BJAT UNIT				MAU2B-4-AI-3												
AI-4		MAU-2B	ZN-T	Zone Temperature	Deg F	JNT		4AI-4		PHONE JACK		EN-MAU2BJAT UNIT				MAU2B-4-AI-4												
AI-5		MAU-2B				JNT		4AI-5				EN-MAU2BJAT UNIT				MAU2B-4-AI-5												
AI-6		MAU-2B				JNT		4AI-6				EN-MAU2BJAT UNIT				MAU2B-4-AI-6												
BI-1		MAU-2B	SF-S	Supply Fan Status	Off On	JNT		4BI-1		BI#,24VAC		EN-MAU2BJAT UNIT				MAU2B-4-BI-1												
BI-2		MAU-2B	EF-S	Exh Fan Status	Off On	JNT		4BI-2		BI#,24VAC		EN-MAU2BJAT UNIT				MAU2B-4-BI-2						2/22	Device dependant	Aux Contact (NO)			U70	
BI-3		MAU-2B	SMK-DET	Smoke Detectors	Normal Alarm	JNT		4BI-3		BI#,24VAC		EN-MAU2BJAT UNIT				MAU2B-4-BI-3						2/22	Device dependant	Aux Contact (NO)			U70	
BI-4		MAU-2B				JNT		4BI-4				EN-MAU2BJAT UNIT				MAU2B-4-BI-4												
BO-1		MAU-2B				JNT		4BO-1				EN-MAU2BJAT UNIT				MAU2B-4-BO-1												
BO-2		MAU-2B				JNT		4BO-2				EN-MAU2BJAT UNIT				MAU2B-4-BO-2												
BO-3		MAU-2B	SF-C	Supply Fan Control	Off On	JNT		4BO-3		RLY	BO#,24V.COM	EN-MAU2BJAT UNIT				MAU2B-4-BO-3	3/18	A.COILS.COM	RELAY-A	NO.COM								
BO-4		MAU-2B	EF-C	Exh Fan Control	Off On	JNT		4BO-4		BO#,24VAC		EN-MAU2BJAT UNIT				MAU2B-4-BO-4												
BO-5		MAU-2B				JNT		4BO-5				EN-MAU2BJAT UNIT				MAU2B-4-BO-5												
BO-6		MAU-2B				JNT		4BO-6				EN-MAU2BJAT UNIT				MAU2B-4-BO-6												
AO-1		MAU-2B	C-VLV	Cooling Coil Valve	% Open	JNT		4AO-1		AO#,AOCM,24VAC		EN-MAU2BJAT UNIT				MAU2B-4-AO-1	2/18	+	EP-8000-2	SUPPLY, O								
AO-2		MAU-2B				JNT		4AO-2				EN-MAU2BJAT UNIT				MAU2B-4-AO-2												

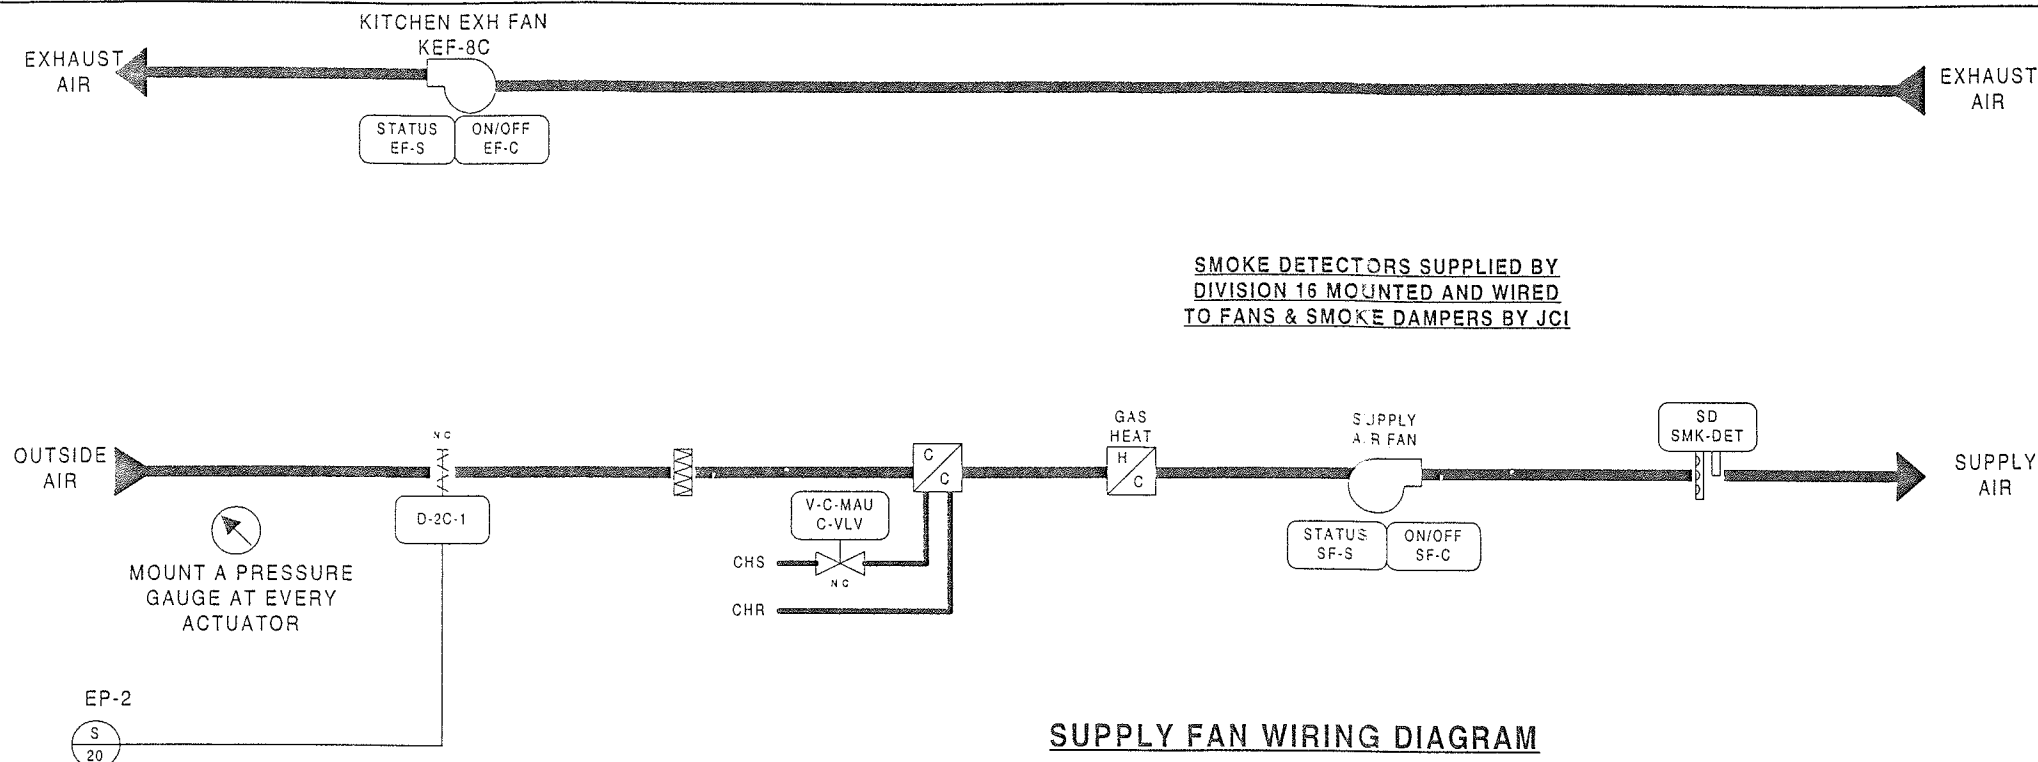


BILL OF MATERIALS




Estimate: mau-2c 70520098.pre

Desig.	Qty	Part #	Description
Field Devices:			
D-2C-1	1	---	SEE DAMPER SCHEDULE
	1	D-3153-2	DMPR ACT, 8-13#
	1	G-2010-11	GAGE, 2", 0-30 PSIG, STEM
EF-8C	1	BZ-1000-11	ENCL, 4-5/8X 5-1/8 X 3-3/8
	1	PD-101-35	RLY BASE, 3PDT, 11PIN, 10A
	1	PD-109-51	RELAY PLUG-IN 3PDT 24VAC
EP-2	1	V11HAA-100	3-W SOLENOID, W/ OV, 120VAC
T-1	1	TE-6315P-1	SENS, T-Ni, 0.1%, 8' AVG
V-C-MAU	1	--	SEE VALVE SCHEDULE
ZN-T	1	TE-6410W-1000	MSTAT, NI, BOX, TACK
Panel Devices:			
EN-MAU-2C	1	AS-UNT111-101	UNT111 MTD IN TPM, W/50VA
	1	EN-EXP101-0	UNIV PKG MOD, CTR & BACKBN
EP-1	1	EP-8000-2	XDUCR, EP, 0/10V, HI VOL
PI-1	1	G-2010-11	GAGE, 2", 0-30 PSIG, STEM
RLY-1,2	2	AS-RLY002-0	RELAY; 2SPDT 5 AMP 240VAC

SUPPLY FAN WIRING DIAGRAM

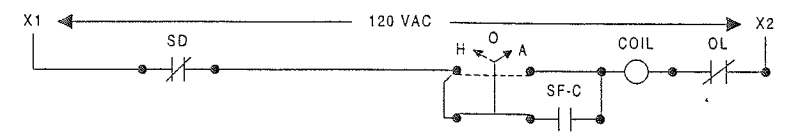

TYPICAL EXHAUST FAN WIRING DIAGRAM

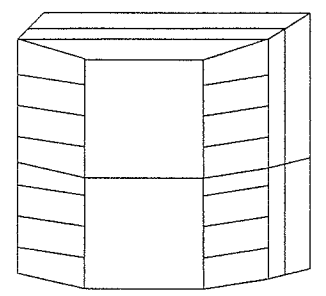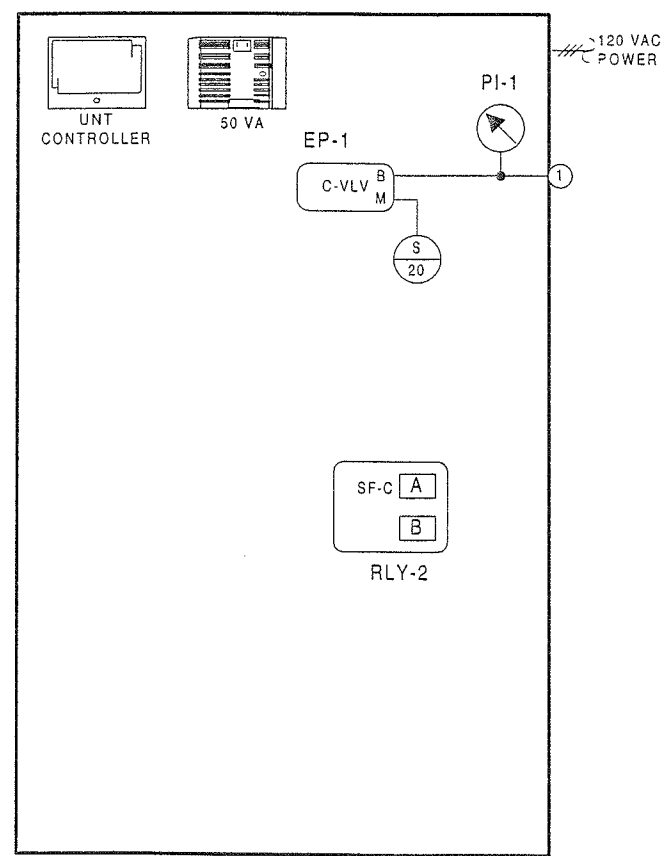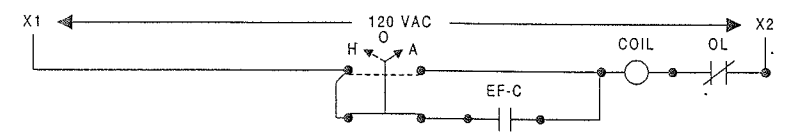

ENCLOSURE EN-MAU-2C
AS-UNT111-101
LOCATED ADJACENT
TO UNIT
NCM-3/N2 ADD = 7

DESCRIPTION OF OPERATION

THE METASYS SYSTEM WILL HAVE THE ABILITY TO CONTROL INDIVIDUAL CONCESSION COMPONENTS (ON/OFF) AS REQUIRED BY THE MODE OF OPERATION. IN THE OCCUPIED MODE, INDIVIDUAL CONCESSION MAKEUP AIR UNIT MAU-2C AND EXHAUST FAN KEF-8C WILL START AND RUN CONTINUOUSLY. WHEN THE UNIT AND EXHAUST FANS ARE ENERGIZED, OUTSIDE AIR DAMPER D-2C-1, WILL OPEN. ROOM SENSOR TR-1 WILL CYCLE DIRECT GAS FIRED HEATER TO MAINTAIN ITS SETPOINT. DISCHARGE SENSOR T-1 WILL MONITOR SUPPLY TEMPERATURE AND PROVE GAS FIRING OF UNIT.

OCCUPIED HEATING MODE - SUPPLY FAN WILL BE RUNNING. OUTSIDE AIR DAMPER D-2C-1 WILL OPEN AND EXHAUST FANS WILL START AND RUN CONTINUOUSLY. THE DIRECT GAS FIRED HEATER WILL BE ACTIVATED BY ZONE SENSOR TR-1 TO MAINTAIN ITS SETTING OF FIFTY (50F). THE DIRECT GAS FIRED HEATER WILL BE MONITORED BY T-1. THE SYSTEM WILL ALARM WHEN ROOM SENSOR TR-1 DROPS BELOW FIFTY (50F). DIRECT GAS FIRED HEATER CONTROL PANEL WILL BE INTERLOCKED WITH GAS EMERGENCY SHUT OFF SYSTEM ASSOCIATED WITH GAS COOKING EQUIPMENT. AUTOMATIC SHUT-DOWN WILL BE PROVIDED AS REQUIRED BY NFPA.

UNOCCUPIED HEATING MODE - MAKE-UP AIR UNIT AND EXHAUST FANS WILL BE DE-ENERGIZED AND OUTSIDE AIR DAMPER WILL CLOSE. ELECTRIC UNIT HEATERS (WITH BUILT-IN THERMOSTATS) WILL CYCLE (ON/OFF) TO MAINTAIN FIFTY (50F).


OCCUPIED COOLING MODE - SUPPLY FAN WILL BE RUNNING AND OUTSIDE AIR DAMPER WILL BE OPEN. ROOM SENSOR TR-1 THROUGH THE METASYS SYSTEM WILL MODULATE CHILLED WATER VALVE V-C-MAU TO MAINTAIN ROOM TEMPERATURE SETTING OF EIGHTY (80F).

UNOCCUPIED COOLING MODE - SYSTEM IS DE-ENERGIZED AND FANS ARE OFF. OUTSIDE AIR DAMPER AND CHILLED WATER VALVE WILL BE CLOSED.

SMOKE CONTROL - SMOKE DETECTORS WILL, ON THE DETECTION OF PRODUCTS OF COMBUSTION, SHUT DOWN THE SUPPLY AND EXHAUST FANS AND CLOSE ALL SYSTEM DAMPERS.

REVISION INFORMATION NUMBER DATE 07/18/00 TIME 03:49 PM FILE NAME MAU-2C.vsd	IN CONSIDERATION OF THE RECEIPT OF THIS DOCUMENT, THE RECIPIENT AGREES NOT TO REPRODUCE, COPY, USE OR TRANSMIT THIS DOCUMENT AND/OR THE INFORMATION THEREIN CONTAINED, IN WHOLE OR IN PART, OR TO SUFFER SUCH ACTION BY OTHERS, FOR ANY PURPOSE, EXCEPT WITH THE WRITTEN PERMISSION OF JOHNSON CONTROLS, INC. AND FURTHER AGREES TO SURRENDER SAME TO JOHNSON CONTROLS, INC. UPON DEMAND. COPYRIGHT JOHNSON CONTROLS, INC. 1998	DRAWING TITLE MAKE-UP AIR UNIT 2C CLC-3-PANTRY CLUB LEVEL QUAD C PROJECT TITLE BALTIMORE NFL STADIUM AT CAMDEN YARDS BALTIMORE, MARYLAND	<table border="1"> <tr> <td>AS-BUILT</td> <td>7/18/00</td> <td>CME</td> </tr> <tr> <td>REFERENCE DRAWING</td> <td>NO.</td> <td>REVISION-LOCATION</td> </tr> <tr> <td>Sales Engineer JDP</td> <td>Project Manager WJT</td> <td>Application Engineer RTS</td> </tr> <tr> <td colspan="2">DRAWN BY RTS</td> <td>DATE 09/15/97</td> </tr> <tr> <td colspan="2">Branch Information</td> <td>CONTRACT NUMBER</td> </tr> <tr> <td colspan="2">JOHNSON CONTROLS 60 LOVETON CIRCLE SPARKS, MD 21152</td> <td>7052-0098</td> </tr> <tr> <td colspan="2">Systems & Services Division</td> <td>DRAWING NUMBER</td> </tr> <tr> <td colspan="2"></td> <td>BL-6559-50</td> </tr> </table>	AS-BUILT	7/18/00	CME	REFERENCE DRAWING	NO.	REVISION-LOCATION	Sales Engineer JDP	Project Manager WJT	Application Engineer RTS	DRAWN BY RTS		DATE 09/15/97	Branch Information		CONTRACT NUMBER	JOHNSON CONTROLS 60 LOVETON CIRCLE SPARKS, MD 21152		7052-0098	Systems & Services Division		DRAWING NUMBER			BL-6559-50
AS-BUILT	7/18/00	CME																									
REFERENCE DRAWING	NO.	REVISION-LOCATION																									
Sales Engineer JDP	Project Manager WJT	Application Engineer RTS																									
DRAWN BY RTS		DATE 09/15/97																									
Branch Information		CONTRACT NUMBER																									
JOHNSON CONTROLS 60 LOVETON CIRCLE SPARKS, MD 21152		7052-0098																									
Systems & Services Division		DRAWING NUMBER																									
		BL-6559-50																									

Full Spreadsheet		Software				Digital Controller Information					Panel Information					Intermediate Device					Field Device				Ref Detail	Comment		
Tag	Point Type	System Name	Object Name	Expanded ID	Display Units	DC Type	N2 Trunk	N2 Addr	Cable Destination Bay/Terminal	Module Type	Termination	Panel	Panel Location	Slot Number	Reference Drawing	Cable Number	Wiring/Tubing	Termination In	Device	Termination Out	Location	Wiring/Tubing	Terminations	Device	Location	Ref Detail	Comment	
		MAU-2C				UNT						EN-MAU2CIAT UNIT																
		MAU-2C				UNT	1	7				EN-MAU2CIAT UNIT															Power to Controller	
AI-1		MAU-2C				UNT	1	7	AI-1			EN-MAU2CIAT UNIT				MAU2C-7-AI-1												N2 Trunk
AI-2		MAU-2C				UNT	1	7	AI-2			EN-MAU2CIAT UNIT				MAU2C-7-AI-2												
AI-3		MAU-2C				UNT	1	7	AI-3			EN-MAU2CIAT UNIT				MAU2C-7-AI-3												
AI-4		MAU-2C	ZN-T	Zone Temperature	Deg F	UNT	1	7	AI-4		PHONE JACK	EN-MAU2CIAT UNIT				MAU2C-7-AI-4					8/26	PHONE JACK	TE-6410W-1000		U2			
AI-5		MAU-2C				UNT	1	7	AI-5			EN-MAU2CIAT UNIT				MAU2C-7-AI-5												
AI-6		MAU-2C				UNT	1	7	AI-6			EN-MAU2CIAT UNIT				MAU2C-7-AI-6												
BI-1		MAU-2C	SF-S	Supply Fan Status	Off Cr	UNT	1	7	BI-1		BI#,24VAC	EN-MAU2CIAT UNIT				MAU2C-7-BI-1					2/22	Device dependent	Aux Contact (NO)		U70			
BI-2		MAU-2C	EF-S	Exh Fan Status	Off Cr	UNT	1	7	BI-2		BI#,24VAC	EN-MAU2CIAT UNIT				MAU2C-7-BI-2					2/22	Device dependent	Aux Contact (NO)		U70			
BI-3		MAU-2C	SMK-DET	Smoke Detectors	Normal Alarm	UNT	1	7	BI-3		BI#,24VAC	EN-MAU2CIAT UNIT				MAU2C-7-BI-3					2/22	Device dependent	Contact (NO)		U70			
BI-4		MAU-2C				UNT	1	7	BI-4			EN-MAU2CIAT UNIT				MAU2C-7-BI-4												
BO-1		MAU-2C				UNT	1	7	BO-1			EN-MAU2CIAT UNIT				MAU2C-7-BO-1												
BO-2		MAU-2C				UNT	1	7	BO-2			EN-MAU2CIAT UNIT				MAU2C-7-BO-2												
BO-3		MAU-2C	SF-C	Supply Fan Control	Off Cr	UNT	1	7	BO-3	RLY	BO#,24V.COM	EN-MAU2CIAT UNIT				MAU2C-7-BO-3	3/18	A.COILS.COM	RELAY-A	NO.COM		2/14	See starter detail	Starter (NO)-(sw lo)		U60		
BO-4		MAU-2C	EF-C	Exh Fan Control	Off Cr	UNT	1	7	BO-4		BO#,24VAC	EN-MAU2CIAT UNIT				MAU2C-7-BO-4						2/18	Device dependent	24VAC OUT (sw lo)		U51		
BO-5		MAU-2C				UNT	1	7	BO-5			EN-MAU2CIAT UNIT				MAU2C-7-BO-5												
BO-6		MAU-2C				UNT	1	7	BO-6			EN-MAU2CIAT UNIT				MAU2C-7-BO-6												
AO-1		MAU-2C	C-VLV	Cooling Coil Valve	% Open	UNT	1	7	AO-1		AO#,AOCM,24VAC	EN-MAU2CIAT UNIT				MAU2C-7-AO-1	2/18	..	EP-8000-2	SUPPLY, O		3/18	Device dependent	0-10V OUT		U23		
AO-2		MAU-2C				UNT	1	7	AO-2			EN-MAU2CIAT UNIT				MAU2C-7-AO-2												

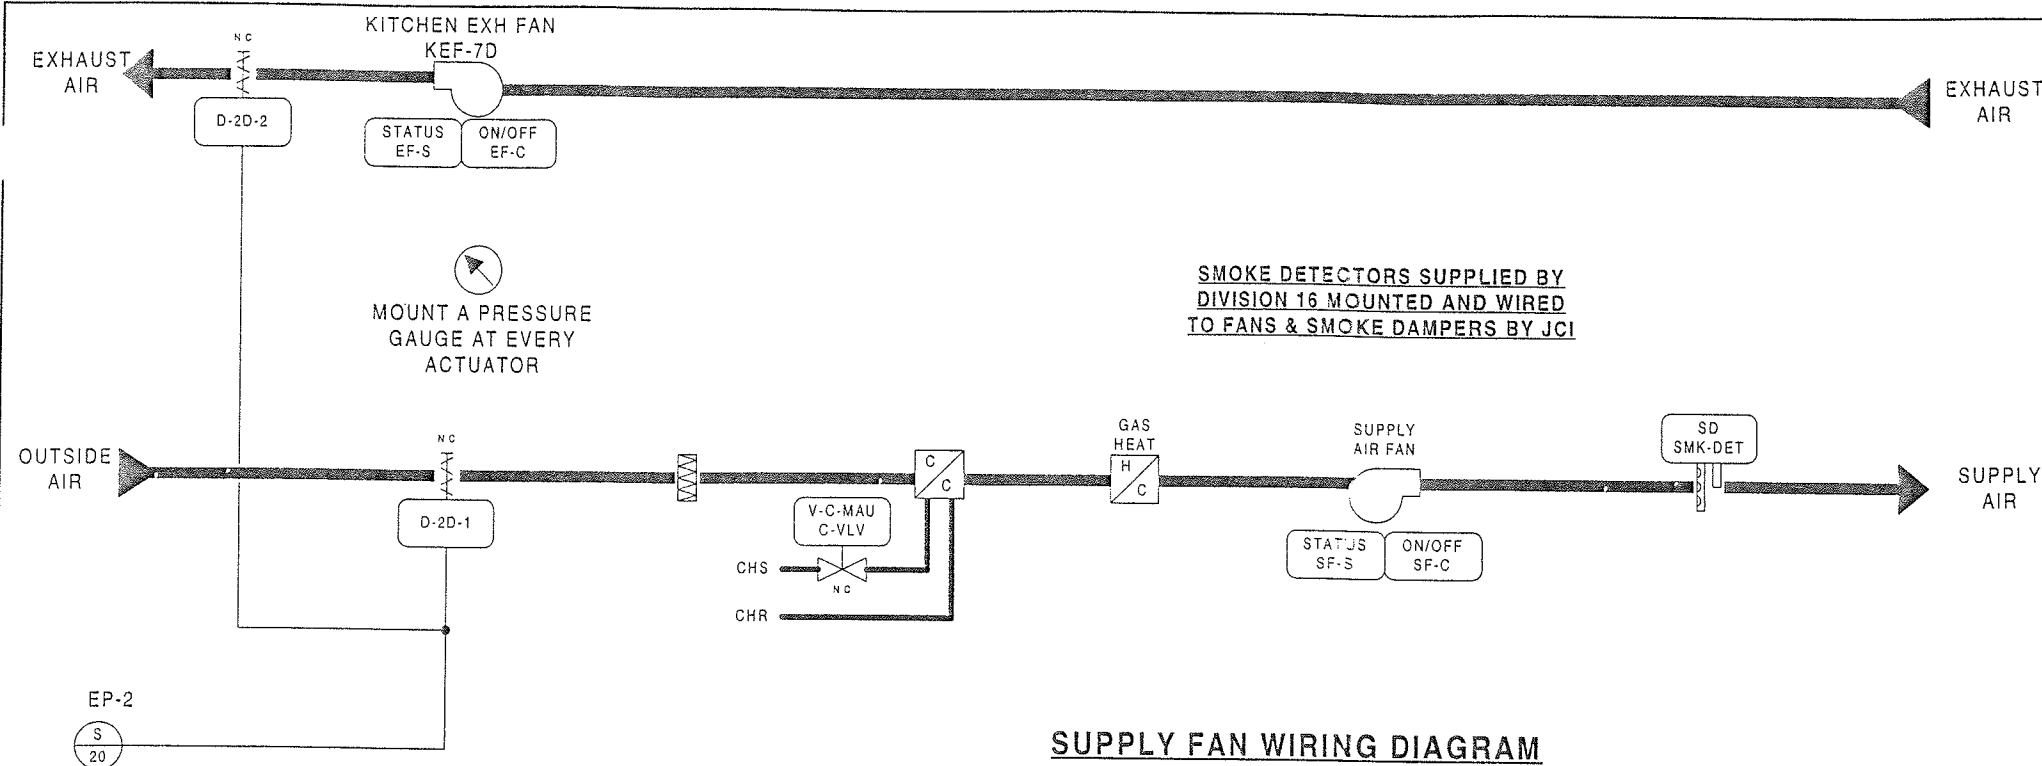


SMOKE DETECTORS SUPPLIED BY DIVISION 16 MOUNTED AND WIRED TO FANS & SMOKE DAMPERS BY JCI

MOUNT A PRESSURE GAUGE AT EVERY ACTUATOR




BILL OF MATERIALS 70520098.pre

Estimate:	mau-2d	Qty/Part #	Description
Field Devices:			
D-2D-1,	2	---	SEE DAMPER SCHEDULE
D-2D-2	2	D-4073-2	DMPR ACT, 8-1 1/2"
	2	G-2010-11	GAGE, 2", 0-30 PSIG, STEM
EF-7D	1	BZ-1000-11	ENCL, 4-5/8 X 3-1/8 X 3-3/8
	1	PD-101-35	RLY BASE, 3PDT, 11PIN, 10A
	1	PD-109-51	RELAY PLUG-IN 3PDT 24VAC
EP-2	1	V11HAA-100	3-W SOLENOID, W/OV, 120VAC
T-1	1	TE-6315P-1	SENS, T-NI, 0.1%, 8' AVG
V-C-MAU	1	--	SEE VALVE SCHEDULE
ZN-T	1	TE-6410W-1000	MSTAT, NI, BOX, JACK
Panel Devices:			
EN-MAU-2D	1	AS-UNT111-101	UNT111 MTD IN UPM, W/50VA
	1	EN-EXP101-0	UNIV PKG MOD, TVR & BACKBN
EP-1	1	EP-8000-2	XDUCR, EP, 0/100, HI VOL
PI-1	1	G-2010-11	GAGE, 2", 0-30 PSIG, STEM
RLY-1,2	2	AS-RLY002-0	RELAY; 2SPDT 5 AMP 240VAC

SUPPLY FAN WIRING DIAGRAM

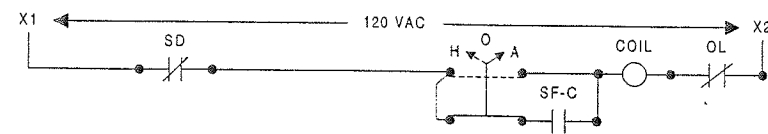

TYPICAL EXHAUST FAN WIRING DIAGRAM

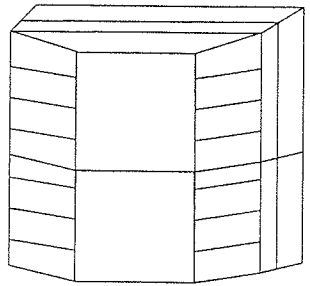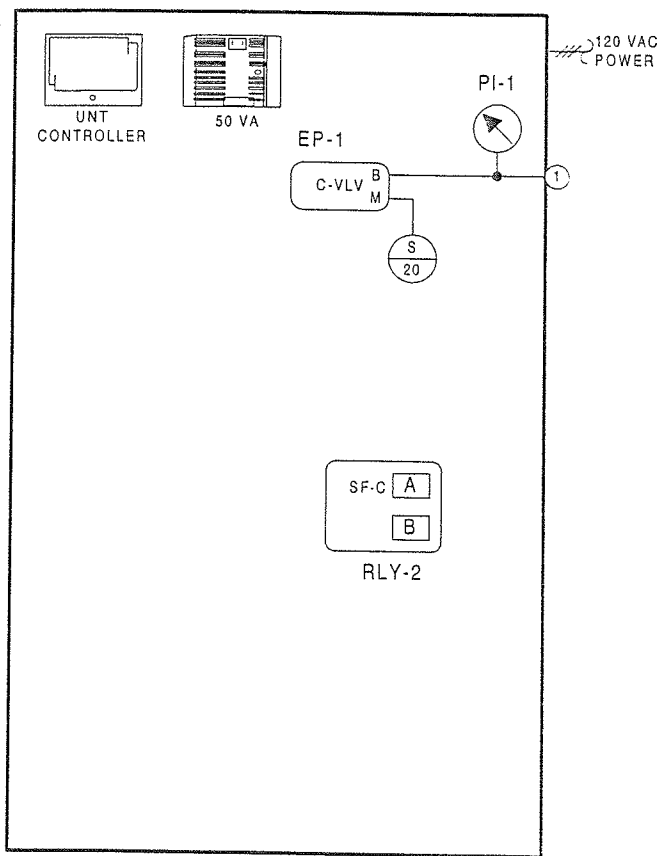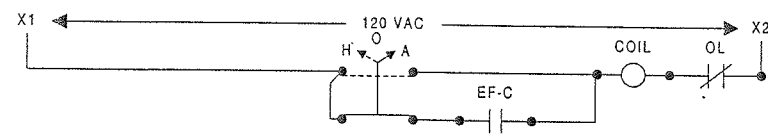

ENCLOSURE EN-MAU-2D AS-UNT111-101 LOCATED ADJACENT TO UNIT NCM-4/N2 ADD = 5

DESCRIPTION OF OPERATION

THE METASYS SYSTEM WILL HAVE THE ABILITY TO CONTROL INDIVIDUAL CONCESSION COMPONENTS (ON/OFF) AS REQUIRED BY THE MODE OF OPERATION. IN THE OCCUPIED MODE, INDIVIDUAL CONCESSION MAKEUP AIR UNIT MAU-2D AND EXHAUST FAN KEF-7D WILL START AND RUN CONTINUOUSLY. WHEN THE UNIT AND EXHAUST FANS ARE ENERGIZED, OUTSIDE AIR DAMPER D-2D-1, AND EXHAUST AIR DAMPER D-2D-2 WILL OPEN. ROOM SENSOR TR-1 WILL CYCLE DIRECT GAS FIRED HEATER TO MAINTAIN ITS SETPOINT. DISCHARGE SENSOR T-1 WILL MONITOR SUPPLY TEMPERATURE AND PROVE GAS FIRING OF UNIT.

OCCUPIED HEATING MODE - SUPPLY FAN WILL BE RUNNING. OUTSIDE AIR DAMPER D-2D-1 AND EXHAUST AIR DAMPER D-2D-2 WILL OPEN AND EXHAUST FANS WILL START AND RUN CONTINUOUSLY. THE DIRECT GAS FIRED HEATER WILL BE ACTIVATED BY ZONE SENSOR TR-1 TO MAINTAIN ITS SETTING OF FIFTY (50F). THE DIRECT GAS FIRED HEATER WILL BE MONITORED BY T-1. THE SYSTEM WILL ALARM WHEN ROOM SENSOR TR-1 DROPS BELOW FIFTY (50F). DIRECT GAS FIRED HEATER CONTROL PANEL WILL BE INTERLOCKED WITH GAS EMERGENCY SHUT OFF SYSTEM ASSOCIATED WITH GAS COOKING EQUIPMENT. AUTOMATIC SHUT-DOWN WILL BE PROVIDED AS REQUIRED BY NFPA.

UNOCCUPIED HEATING MODE - MAKE-UP AIR UNIT AND EXHAUST FANS WILL BE DE-ENERGIZED AND OUTSIDE AIR DAMPER WILL CLOSE. ELECTRIC UNIT HEATERS (WITH BUILT-IN THERMOSTATS) WILL CYCLE (ON/OFF) TO MAINTAIN FIFTY (50F).

OCCUPIED COOLING MODE - SUPPLY FAN WILL BE RUNNING AND OUTSIDE AIR DAMPER WILL BE OPEN. ROOM SENSOR TR-1 THROUGH THE METASYS SYSTEM WILL MODULATE CHILLED WATER VALVE V-C-MAU TO MAINTAIN ROOM TEMPERATURE SETTING OF EIGHTY (80F).

UNOCCUPIED COOLING MODE - SYSTEM IS DE-ENERGIZED AND FANS ARE OFF. OUTSIDE AIR DAMPER AND CHILLED WATER VALVE WILL BE CLOSED.

SMOKE CONTROL - SMOKE DETECTORS WILL, ON THE DETECTION OF PRODUCTS OF COMBUSTION, SHUT DOWN THE SUPPLY AND EXHAUST FANS AND CLOSE ALL SYSTEM DAMPERS.

REVISION INFORMATION NUMBER DATE 07/18/00 TIME 03:50 PM FILE NAME MAU-2D.vsd	IN CONSIDERATION OF THE RECEIPT OF THIS DOCUMENT, THE RECIPIENT AGREES NOT TO REPRODUCE, COPY, USE OR TRANSMIT THIS DOCUMENT AND/OR THE INFORMATION THEREIN CONTAINED, IN WHOLE OR IN PART, OR TO SUFFER SUCH ACTION BY OTHERS, FOR ANY PURPOSE, EXCEPT WITH THE WRITTEN PERMISSION OF JOHNSON CONTROLS, INC. AND FURTHER AGREES TO SURRENDER SAME TO JOHNSON CONTROLS, INC. UPON DEMAND. COPYRIGHT JOHNSON CONTROLS, INC. 1998	DRAWING TITLE MAKE-UP AIR UNIT 2D CLC-4-PANTRY CLUB LEVEL QUAD D PROJECT TITLE BALTIMORE NFL STADIUM AT CAMDEN YARDS BALTIMORE, MARYLAND	<table border="1"> <tr> <td>AS-BUILT</td> <td></td> <td></td> <td></td> <td></td> <td>7/18/00</td> <td>CME</td> </tr> <tr> <td>REFERENCE DRAWING</td> <td>NO.</td> <td>REVISION-LOCATION</td> <td>ECN</td> <td>DATE</td> <td>BY</td> <td></td> </tr> <tr> <td>Sales Engineer JDP</td> <td>Project Manager WJT</td> <td>Application Engineer RTS</td> <td></td> <td>DRAWN</td> <td>APPROVED</td> <td></td> </tr> <tr> <td></td> <td></td> <td></td> <td></td> <td>BY RTS</td> <td>DATE 09/16/97</td> <td>BY DATE</td> </tr> </table>	AS-BUILT					7/18/00	CME	REFERENCE DRAWING	NO.	REVISION-LOCATION	ECN	DATE	BY		Sales Engineer JDP	Project Manager WJT	Application Engineer RTS		DRAWN	APPROVED						BY RTS	DATE 09/16/97	BY DATE
AS-BUILT					7/18/00	CME																									
REFERENCE DRAWING	NO.	REVISION-LOCATION	ECN	DATE	BY																										
Sales Engineer JDP	Project Manager WJT	Application Engineer RTS		DRAWN	APPROVED																										
				BY RTS	DATE 09/16/97	BY DATE																									
		JOHNSON CONTROLS Systems & Services Division	Branch Information JOHNSON CONTROLS 60 LOVETON CIRCLE SPARKS, MD 21152	CONTRACT NUMBER 7052-0098 DRAWING NUMBER BL-6559-51																											

Full Spreadsheet		Software				Digital Controller Information					Panel Information					Intermediate Device				Field Device								
Tag	Point Type	System Name	Object Name	Expanded ID	Display Units	DC Type	N2 Trunk	N2 Addr	Cable Destination Bay/Terminal	Module Type	Termination	Panel	Panel Location	Slot Number	Reference Drawing	Cable Number	Wiring/Tubing	Termination In	Device	Termination Out	Location	Wiring/Tubing	Terminations	Device	Location	Ref Detail	Comment	
		MAU-2D				UNT						EN-MAU2BIAT UNIT															Power to Controller	
		MAU-2D				UNT	1	5				EN-MAU2BIAT UNIT		0													N2 Trunk	
AI-1		MAU-2D				UNT			5AI-1			EN-MAU2BIAT UNIT		0		MAU2B-5-AI-1												
AI-2		MAU-2D				UNT			5AI-2			EN-MAU2BIAT UNIT		0		MAU2B-5-AI-2												
AI-3		MAU-2D				UNT			5AI-3			EN-MAU2BIAT UNIT		0		MAU2B-5-AI-3												
AI-4		MAU-2D	ZN-T	Zone Temperature	Deg F	UNT			5AI-4		PHONE JACK	EN-MAU2BIAT UNIT		0		MAU2B-5-AI-4						8/26	PHONE JACK	TE-6410W-1000		U2		
AI-5		MAU-2D				UNT			5AI-5			EN-MAU2BIAT UNIT		0		MAU2B-5-AI-5												
AI-6		MAU-2D				UNT			5AI-6			EN-MAU2BIAT UNIT		0		MAU2B-5-AI-6												
BI-1		MAU-2D	SF-S	Supply Fan Status	Off On	UNT			5BI-1		BI# 24VAC	EN-MAU2BIAT UNIT		0		MAU2B-5-BI-1						2/22	Device dependent	Aux Contact (NO)		U70		
BI-2		MAU-2D	EF-S	Exh Fan Status	Off On	UNT			5BI-2		BI# 24VAC	EN-MAU2BIAT UNIT		0		MAU2B-5-BI-2						2/22	Device dependent	Aux Contact (NO)		U70		
BI-3		MAU-2D	SMK-DET	Smoke Detectors	Normal Alarm	UNT			5BI-3		BI# 24VAC	EN-MAU2BIAT UNIT		0		MAU2B-5-BI-3						2/22	Device dependent	Contact (NO)		U70		
BI-4		MAU-2D				UNT			5BI-4			EN-MAU2BIAT UNIT		0		MAU2B-5-BI-4												
BO-1		MAU-2D				UNT			5BO-1			EN-MAU2BIAT UNIT		0		MAU2B-5-BO-1												
BO-2		MAU-2D				UNT			5BO-2			EN-MAU2BIAT UNIT		0		MAU2B-5-BO-2												
BO-3		MAU-2D	SF-C	Supply Fan Control	Off On	UNT			5BO-3	FLY	BO# 24V.COM	EN-MAU2BIAT UNIT		0		MAU2B-5-BO-3	A.COILS.COM	RELAY-A	NO.COM			2/14	See starter detail	Starter (NO)-(sw lo)		U60		
BO-4		MAU-2D	EF-C	Exh Fan Control	Off On	UNT			5BO-4		BO# 24VAC	EN-MAU2BIAT UNIT		0		MAU2B-5-BO-4			PD-109-51			2/18	Device dependent	24VAC OUT (sw lo)		U51		
BO-5		MAU-2D				UNT			5BO-5			EN-MAU2BIAT UNIT		0		MAU2B-5-BO-5												
BO-6		MAU-2D				UNT			5BO-6			EN-MAU2BIAT UNIT		0		MAU2B-5-BO-6												
AO-1		MAU-2D	C-VLV	Cooling Coil Valve	% Open	UNT			5AO-1		AO# AOCM,24VAC	EN-MAU2BIAT UNIT		0		MAU2B-5-AO-1						3/18	Device dependent	0-10V OUT		U23		
AO-2		MAU-2D				UNT			5AO-2			EN-MAU2BIAT UNIT		0		MAU2B-5-AO-2												

Damper Schedule

Tag										Damper Information										Actuator Information			Coupld. Detail	Comments	
Item	System	Service	Ref. Dwg.	Qty.	Code No.	Fail Pos.	Dmpr. Type	Dmpr. Oper.	Blade Type	Bear. Type	Seals	W (in.)	H (in.)	W (in.)	H (in.)	Area (ft²)	Mtg.	Qty.	Code No.	Pilot	Type	Control			Mtg.
												Duct Size		Damper Size											
D-1-1A	AHU-1	Min Out Air	M.3-09	-	(Coupled Damper)		Control	Opposed	Double	Acetal	Standard	148"	17"	148"	17"	17.5	1	D-3153-2	n/a	Pneu	8-13#				
D-1-1B	AHU-1	Max Out Air	M.3-09	-	(Coupled Damper)		Control	Opposed	Double	Acetal	Standard	148"	28"	148"	28"	28.8	1	D-3153-1	n/a	Pneu	8-13#				
D-1-2	AHU-1	Return Air	M.3-09	1	COPAS-600X320		Control	Opposed	Double	Acetal	Standard	60"	32"	60"	32"	13.3	1	D-3153-1	D-9502	Pneu	8-13#				
D-1-3	AHU-1	Relief Air	M.3-09	1	COPAS-360X300		Control	Opposed	Double	Acetal	Standard	36"	30"	36"	30"	7.5	1	D-3153-1	D-9502	Pneu	8-13#				
D-2-1A	AHU-2	Min Out Air	M.3-10	-	(Coupled Damper)		Control	Opposed	Double	Acetal	Standard	148"	30"	148"	30"	30.8	1	D-3153-1	D-9502	Pneu	8-13#				
D-2-1B	AHU-2	Max Out Air	M.3-10	-	(Coupled Damper)		Control	Opposed	Double	Acetal	Standard	148"	42"	148"	42"	43.2	1	D-3153-1	D-9502	Pneu	8-13#				
D-2-2	AHU-2	Return Air	M.3-10	1	COPAS-370X420							10.8	42"	10.8	42"	10.8	1	D-3153-2	n/a	Pneu	8-13#				
D-2-3	AHU-2	Relief Air	M.3-10	1	COPAS-740X300		Control	Opposed	Double	Acetal	Standard	74"	30"	74"	30"	15.4	1	D-3153-1	D-9502	Pneu	8-13#				
D-3-1A	AHU-3	Min Out Air	M.3-11	-	(Coupled Damper)		Control	Opposed	Double	Acetal	Standard	148"	27"	148"	27"	27.8	1	D-3153-2	D-9502	n/a	8-13#				
D-3-1B	AHU-3	Max Out Air	M.3-11	-	(Coupled Damper)		Control	Opposed	Double	Acetal	Standard	148"	45"	148"	45"	46.3	1	D-3153-1	D-9502	Pneu	8-13#				
D-3-2	AHU-3	Return Air	M.3-11	1	COPAS-370X450							11.6	45"	11.6	45"	11.6	1	D-3153-2	n/a	Pneu	8-13#				
D-3-3	AHU-3	Relief Air	M.3-11	1	COPAS-800X300		Control	Opposed	Double	Acetal	Standard	80"	30"	80"	30"	16.7	1	D-3153-1	D-9502	Pneu	8-13#				
D-4-1A	AHU-4	Min Out Air	M.3-12	-	(Coupled Damper)		Control	Opposed	Double	Acetal	Standard	148"	17"	148"	17"	17.5	1	D-3153-2	n/a	Pneu	8-13#				
D-4-1B	AHU-4	Max Out Air	M.3-12	-	(Coupled Damper)		Control	Opposed	Double	Acetal	Standard	148"	28"	148"	28"	28.8	1	D-3153-1	D-9502	Pneu	8-13#				
D-4-2	AHU-4	Return Air	M.3-12	1	COPAS-370X280							7.2	28"	7.2	28"	7.2	1	D-3153-2	n/a	Pneu	8-13#				
D-4-3	AHU-4	Relief Air	M.3-12	1	COPAS-600X280		Control	Opposed	Double	Acetal	Standard	60"	28"	60"	28"	11.7	1	D-3153-1	D-9502	Pneu	8-13#				

Damper Schedule

Tag				Damper Information													Actuator Information						Coupld. Detail	Comments
Item	System	Service	Ref. Dwg.	Qty.	Code No.	Fail Pos.	Dmpr. Type	Dmpr. Oper.	Blade Type	Bear. Type	Seals	Duct Size		Damper Size			Mtg.	Qty.	Code No.	Pilot	Type	Control Signal		
												W (in.)	H (in.)	W (in.)	H (in.)	Area (ft ²)								
D-9-3	AHU-9	Relief Air	M.3-13	1	COPAS-380X180		Control	Opposed	Double	Acetal	Standard	38"	18"	38"	18"	4.8		1	D-3153-2	n/a	Pneu	8-13#		
D-9-4	AHU-9	Bypass Air	M.3-13	1	COPAS-300X160		Control	Opposed	Double	Acetal	Standard	30"	16"	30"	16"	3.3		1	D-3153-1	D-9502	Pneu	8-13#		
	"A" Press MER	VF-25 Intake	M.3-09	1	COPAS-320X320		Control	Opposed	Double	Acetal	Standard	32"	32"	32"	32"	7.1		1	D-4073-2	n/a	Pneu	8-13#		
	"B" Press MER	VF-25 Intake	M.3-10	1	COPAS-320X320		Control	Opposed	Double	Acetal	Standard	32"	32"	32"	32"	7.1		1	D-4073-2	n/a	Pneu	8-13#		
	"C" Press MER	VF-25 Intake	M.3-11	1	COPAS-320X320		Control	Opposed	Double	Acetal	Standard	32"	32"	32"	32"	7.1		1	D-4073-2	n/a	Pneu	8-13#		
	"D" Press MER	VF-25 Intake	M.3-12	1	COPAS-240X240		Control	Opposed	Double	Acetal	Standard	24"	24"	24"	24"	4.0		1	D-4073-2	n/a	Pneu	8-13#		
	"B" Plant MER	VF-24 Intake	M.3-17	2	COPAS-360X360		Control	Opposed	Double	Acetal	Standard	36"	36"	36"	36"	9.0		1	D-4073-2	n/a	Pneu	8-13#		
	"B" Plant MER	VF-11,12,13	M.3-17	1	COPAS-960X360		Control	Opposed	Double	Acetal	Standard	96"	36"	96"	36"	24.0		1	D-3153-2	n/a	Pneu	8-13#		
	"B" Plant MER	VF-11 Exh	M.3-17	1	COPAS-720X720		Control	Opposed	Double	Acetal	Standard	72"	72"	72"	72"	36.0		2	D-3153-1	D-9502	Pneu	8-13#		
	"B" Plant MER	VF-12 Exh	M.3-17	1	COPAS-720X720		Control	Opposed	Double	Acetal	Standard	72"	72"	72"	72"	36.0		2	D-3153-1	D-9502	Pneu	8-13#		
	"B" Plant MER	VF-13 Exh	M.3-17	1	COPAS-720X720		Control	Opposed	Double	Acetal	Standard	72"	72"	72"	72"	36.0		2	D-3153-1	D-9502	Pneu	8-13#		
	Elev Core MER	Out Intake	M.3-26	4	COPAS-360X360		Control	Opposed	Double	Acetal	Standard	36"	36"	36"	36"	9.0		1	D-4073-2	n/a	Pneu	8-13#		
	Elev Core MER	VF-30 Exh	M.3-26	4	COPAS-300X300		Control	Opposed	Double	Acetal	Standard	30"	30"	30"	30"	6.3		1	D-4073-2	n/a	Pneu	8-13#		
D-24-1	AHU-24	Outside Air	M.2-02C	1	COPAS-160X140		Control	Opposed	Double	Acetal	Standard	16"	14"	16"	14"	1.6		1	D-4073-2	n/a	Pneu	8-13#		
D-25-1	AHU-25	Outside Air	M.2-02D	1	COPAS-160X140		Control	Opposed	Double	Acetal	Standard	16"	14"	16"	14"	1.6		1	D-4073-2	n/a	Pneu	8-13#		
D-26-1	AHU-26	Outside Air	M.3-10	1	COPAS-160X140		Control	Opposed	Double	Acetal	Standard	16"	14"	16"	14"	1.6		1	D-4073-2	n/a	Pneu	8-13#		
D-5-1	"A" Smoke Intake	Outside Air	M.2-04A	-	(Coupled Damper)		Control	Opposed	Double	Acetal	Standard	192"	64"	192"	64"	85.3		1	D-3153-1	D-9502	Pneu	8-13#		
			M.4-03	1	COPAS-480X640									48"	64"	21.3		3	D-3153-2	n/a	Pneu	8-13#		
				1	COPAS-480X640									48"	64"	21.3								
				1	COPAS-480X640									48"	64"	21.3								
				1	COPAS-480X640									48"	64"	21.3								
D-7-1	"B" Smoke Intake	Outside Air	M.2-04B	-	(Coupled Damper)		Control	Opposed	Double	Acetal	Standard	192"	108"	192"	108"	144.0		2	D-3153-1	D-9502	Pneu	8-13#		
			M.4-03	1	COPAS-480X540									48"	54"	18.0		5	D-3153-2	n/a	Pneu	8-13#		
				1	COPAS-480X540									48"	54"	18.0								
				1	COPAS-480X540									48"	54"	18.0								
D-10-1	"C" Smoke Intake	Outside Air	M.2-04C	-	(Coupled Damper)		Control	Opposed	Double	Acetal	Standard	192"	108"	192"	108"	144.0		6	D-3153-1	D-9502	Pneu	8-13#		
			M.4-03	1	COPAS-480X540									48"	54"	18.0		5	D-3153-2	n/a	Pneu	8-13#		
				1	COPAS-480X540									48"	54"	18.0								
				1	COPAS-480X540									48"	54"	18.0								
D-11-1	"D" Smoke Intake	Outside Air	M.2-04D	-	(Coupled Damper)		Control	Opposed	Double	Acetal	Standard	192"	64"	192"	64"	85.3		1	D-3153-1	D-9502	Pneu	8-13#		
			M.4-03	1	COPAS-480X640									48"	64"	21.3		3	D-3153-2	n/a	Pneu	8-13#		
				1	COPAS-480X640									48"	64"	21.3								
				1	COPAS-480X640									48"	64"	21.3								
				1	COPAS-480X640									48"	64"	21.3								
D-2A-1	MAU-2A	Outside Air		1	COPAS-840X600		Control	Opposed	Single	Acetal	Standard	84"	60"	84"	60"	35.0		2	D-3153-2		Pneu	8-13#		
D-2B-1	MAU-2B	Outside Air		1	COPAS-360X360		Control	Opposed	Double	Acetal	Standard	36"	36"	36"	36"	9.0		1	D-4073-2		Pneu	8-13#		
D-2C-1	MAU-2C	Outside Air		1	COPAS-360X360		Control	Opposed	Double	Acetal	Standard	36"	36"	36"	36"	9.0		1	D-4073-2		Pneu	8-13#		
D-2D-1	MAU-2D	Outside Air		1	COPAS-360X360		Control	Opposed	Double	Acetal	Standard	36"	36"	36"	36"	9.0		1	D-4073-2		Pneu	8-13#		
	KEF-7D	Exhaust Air		1	COPAS-360X240		Control	Opposed	Double	Acetal	Standard	36"	24"	36"	24"	6.0		1	D-4073-2		Pneu	8-13#		
27-1	AHU-27	Outside Air		1	COPAS-360X720		Control	Opposed	Double	Acetal	Standard	36"	72"	36"	72"	18.0		1	D-3153-2	n/a	Pneu	8-13#		
27-2	AHU-27	Return Air		1	COPAS-400X300		Control	Opposed	Double	Acetal	Standard	40"	30"	40"	30"	8.3		1	D-3153-2	n/a	Pneu	8-13#		
D-27-3	GF-9A	Exhaust Air		1	COPAS-240X240		Control	Opposed	Double	Acetal	Standard	24"	24"	24"	24"	4.0		1	D-4073-2	n/a	Pneu	8-13#		

© Johnson Controls
Damper