

MARYLAND STADIUM AUTHORITY PROJECT:
M&T BANK STADIUM (RAVENS)

Automatic Temperature Controls ASBUILT



OWNER: MARYLAND STADIUM AUTHORITY
GENERAL CONTRACTOR: PEPCO ENERGY SERVICES
ATC & EMS CONTRACTOR: ENGINEERED SERVICES, INC.

DATE: November 22, 2010

Index

1.1 Symbols

- 2.1 RAVENS QUAD A BACnet Topology
- 2.2 RAVENS QUAD B BACnet Topology
- 2.3 RAVENS QUAD C BACnet Topology
- 2.4 RAVENS QUAD D BACnet Topology

3.x Panels

- 4.1 CHW Glycol Flow Diagram
- 4.2 RAVENS CHW Pumps Hardwired Points
- 4.3 Field Heating Upgrade Flow Diagram
- 4.4 Field Heating Upgrade Hardwired Points
- 4.5 Heating Water Plant Flow Diagram
- 4.6 Heating Bypass Valves Hardwired Points

- 5.1 AHU Units 1-4 Additions
- 5.2 AHU Unit 9 Additions
- 5.3 AHU Units 10-12, 14-17 CO2 Addition
- 5.4 AHU Unit 27 Additions

- 6.1 VF-9 VFD Hardwired Points
- 6.2 VF-11, 12, 13 VFD Hardwired Points
- 6.3 VF-26, 27, 28, 29 A&B VFD Hardwired Points

- 7.1 HVU-1 & 2 Static Pressure Locations
- 7.2 HVU-1 & 2 Additions
- 7.3 HVU-3 & 5 Additions

- 8.1 Cabinet Unit Heaters Thermostat Wiring
- 8.2 Toilet Exhaust Fan Relay Wiring
- 8.3 Scoreboard EFs Wiring (East & West)

9.1 Typical Wiring Details




x.x Available Existing Johnson Control Drawings with Notations





45150 Business Court
Suite 100
Sterling, Virginia 20166

Tel. (703) 471-6310
Fax (703) 471-3919

WIRING/SCHEMATIC SYMBOLS

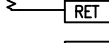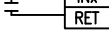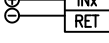	RELAY – RELAY COIL
	N.O. CONTACTS
	N.C. CONTACTS
	TRANSFORMER
	THERMOSTAT, MAKE ON FALL IN TEMP.
	THERMOSTAT/HUMIDISTAT/ MAKE ON RISE IN TEMP./HUMIDITY
	FREEZESTAT, T’STAT, BREAK ON FALL IN TEMP.
	FIRESTAT, T’STAT, BREAK ON RISE IN TEMP.
	N.C. HIGH PRESSURE SWITCH
	N.O. HIGH PRESSURE SWITCH
	N.C. LOW PRESSURE SWITCH
	N.O. LOW PRESSURE SWITCH
	SWITCH – SWITCH
	FLOW SWITCH
	FLOAT SWITCH, BREAK ON RISE
	FLOAT SWITCH, BREAK ON FALL
	FUSE
	SOLENOID
	GROUND
	RESISTOR
	THERMAL SWITCH
	PILOT LIGHT / STROBE
	HORN / BELL
	THERMISTER OR RESISTANCE INPUT
	DRY CONTACTS OR PULSE INPUT
	SELF–POWERED 0–10VDC INPUT
	SEPARATELY POWERED 0–10VDC INPUT
	24V COMMON JUMPER BAR, TERMINAL

FLOW/DIAGRAMITC SYMBOLS

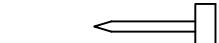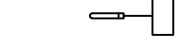	DIGITAL CURRENT SWITCH
	ANALOG CURRENT SENSOR
	GAUGE
	WATER FLOW PADDLE SWITCH
	DUCT HUMIDITY SENSOR
	DUCT TEMP. SENSOR
	IMMERSION SENSOR
	AVERAGING SENSOR
	OUTSIDE AIR SENSOR
	FLOW METER
	WALL SENSOR
	WALL CO SENSOR
	THERMOSTAT
	FIRESTAT
	FREEZESTAT
	3–WAY ELECTRIC VALVE
	2–WAY ELECTRIC VALVE
	ELECTRIC DAMPER ACTUATOR
	N.C. CONTROL DAMPER
	N.O. CONTROL DAMPER
	DRY MEDIA DIFFERENTIAL PRESSURE TRANSDUCER
	WET MEDIA DIFFERENTIAL PRESSURE TRANSDUCER
	AIR FLOW MONITORING STATION
	POTENTIOMETER
	ELECTRIC HEATER

Title		Symbols	
Project/Location		M&T BANK STADIUM (RAVENS) MARYLAND STADIUM AUTHORITY PROJECT	
 engineered services inc		45150 Business Court Suite 100 Sterling, Virginia 20166 Tel. (703) 471–6310 Fax (703) 471–3919	
PM: EK		Engineer: BH	
Asbuilt 11/22/10	Job # 4828	Dwg. Name 1.1 Symbols	

ROOF

UPPER CONCOURSE

UPPER SUITE LEVEL


LOWER SUITE LEVEL

CLUB LEVEL

PRESS LEVEL

MAIN CONCOURSE

SERVICE LEVEL

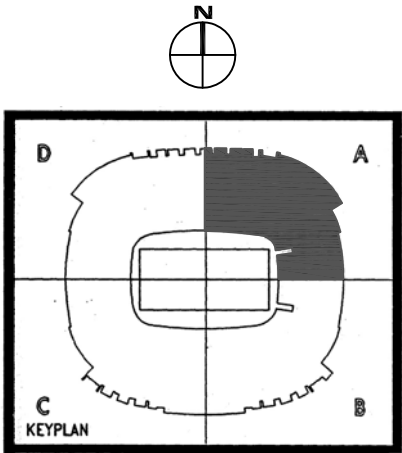

22 AWG TWISTED SHIELDED PAIR =

NOTE:

* RAVENS_MC_QUAD_A_1: 120 OHM END-OF LINE RESISTOR AT VF_26A_B (b3 867) & AT CUH-500B (AT THERMOSTAT).
RAVENS_MC_QUAD_A_2: 120 OHM END-OF LINE RESISTOR AT TEF-A3 (BACnet RELAY) & AT CUH-112A (AT THERMOSTAT).

ELEC. RM. 7.06.01
POWER FROM CKT. #23 RP_UCA

CUH-#
(TYP. 11)
A 506 A 503B
A 505A A 502A
A 505B A 502B
A 504A A 500A
A 504B A 500B *
A 503A

ELEC. RM. 6.13.03
POWER FROM #23 RP_USB

CUH-#
(TYP. 8)
B 515B B 517A
B 515A B 517B
B 516B B 518A
B 516A B 518B

TEF-A23 ELEC. RM. 5.10.02

VF_26A_B
b3 867

AHU-1
b3 920

FAMILY TOILET
2.54.04

CONCESSION 2.01.02

FOOD PREP. 2.01.04

WOMEN'S RESTROOM 2.02.04

CONCESSION 2.04.01

FOOD PREP. 2.04.03 & ADJACENT ROOM

MEN'S RESTROOM 2.05.01

MEN'S RESTROOM 2.13.01

FOOD PREP. 2.12.01

CONCESSION 2.12.02

FOOD PREP. 2.10.01

MEN'S RESTROOM 2.08.01

WOMEN'S RESTROOM 2.07.01

Title
**RAVENS QUAD A
BACnet Topology**

Project/Location
M&T BANK STADIUM (RAVENS)
MARYLAND STADIUM AUTHORITY PROJECT

ESI
engineered
services inc
45150 Business Court
Suite 100
Sterling, Virginia 20166
Tel. (703) 471-6310
Fax (703) 471-3919

PM: EK	Engineer: BH
Asbuilt 11/22/10	Job # 4828
Dwg. Name 2.1 RAVENS_QA_BACnet_Topology	

ROOF

UPPER CONCOURSE


UPPER SUITE LEVEL

LOWER SUITE LEVEL

CLUB LEVEL

PRESS LEVEL

MAIN CONCOURSE

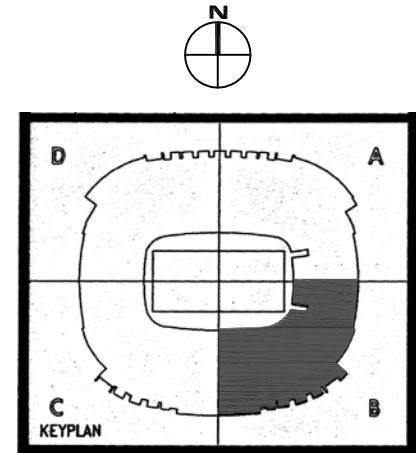

SERVICE LEVEL

22 AWG TWISTED SHIELDED PAIR =

NOTE:


* RAVENS_MC_QUAD_B_1: 120 OHM END-OF LINE RESISTOR AT VF_27A_B (b3 867) & AT CUH-526A (AT THERMOSTAT).
RAVENS_MC_QUAD_B_2: 120 OHM END-OF LINE RESISTOR AT TEF-B8 (BACnet RELAY) & AT SCOREBOARD_EAST (b3 867).

ELEC. RM. 7.21.02
POWER FROM CKT. #23 RC_UCB




B 520 B 524A
B 521B B 525B
B 521A B 525A
B 523B B 526B
B 523A B 526A*
B 524B

RAVENS_MC_QUAD_B_2

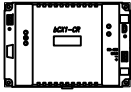

RAVENS_MC_QUAD_B_1

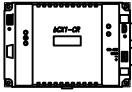


ELEC. RM. 4.20.08




ELEC. RM. 2.24.04

*

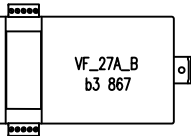

AHU-2
b3 920

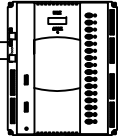

MEN'S RESTROOM 2.26.01



FOOD PREP. 2.25.04



CONCESSION 2.25.01



FOOD PREP. 2.24.05



CONCESSION 2.24.01



WOMEN'S RESTROOM 2.22.01



WOMEN'S RESTROOM 2.15.01




CONCESSION 2.16.01




FOOD PREP. 2.16.02




MEN'S RESTROOM 2.17.01

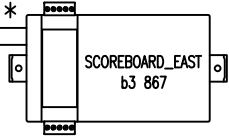

VF_11_12_13
b3 804

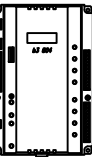

STEAM RM.

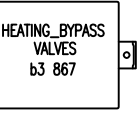

MAINTENANCE SHOP 1.18.02



*

Title

RAVENS QUAD B
BACnet Topology

Project/Location

M&T BANK STADIUM (RAVENS)
MARYLAND STADIUM AUTHORITY PROJECT

ESI
engineered
services inc

45150 Business Court
Suite 100
Sterling, Virginia 20166

Tel. (703) 471-6310
Fax (703) 471-3919

PM: EK

Engineer: BH

Asbuilt
11/22/10

Job #
4828

Dwg. Name
2.2 RAVENS_QB_BACnet_Topology

ROOF

UPPER CONCOURSE



UPPER SUITE LEVEL

LOWER SUITE LEVEL


CLUB LEVEL

PRESS LEVEL


MAIN CONCOURSE

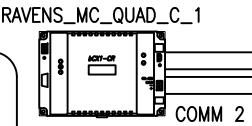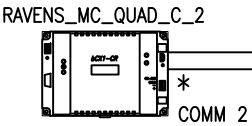

ELEC. RM. 7.33.01
POWER FROM CKT. #28 RC_UCC

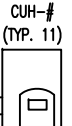


C 533 C 529B
C 532A C 528A
C 532B C 528B
C 530A C 527A
C 530B C 527B *
C 529A

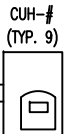

C 538A C 536B
C 538B C 535A
C 537A C 535B
C 537B C 534
C 536A






ELEC. RM. 6.41.02

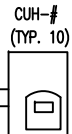


D 545A D 543B
D 545B D 542A
D 544A D 542B
D 544B D 540A
D 543A D 540B




ELEC. RM. 4.37.03

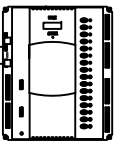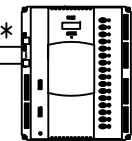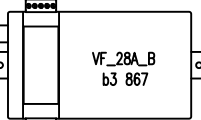


FAMILY TOILET
2.27.03

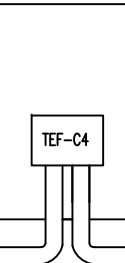


WOMEN'S RESTROOM 2.29.01

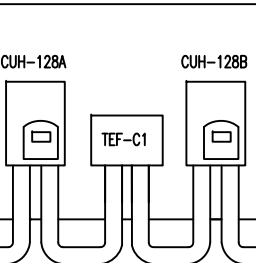


CONCESSION 2.30.01

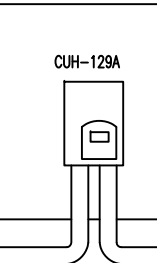


FOOD PREP. 2.30.05

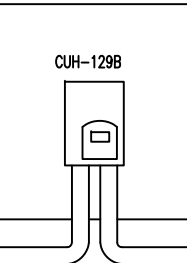


FOOD PREP. 2.31.02

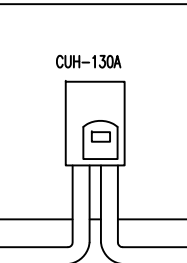


FOOD PREP. 2.31.01

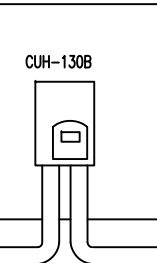


MEN'S RESTROOM 2.32.01

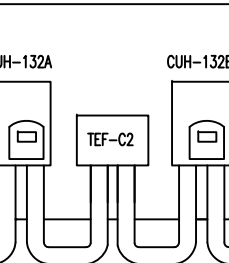


RESTROOM
2.39.04

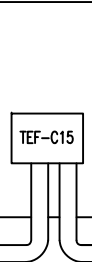


MEN'S RESTROOM 2.40.01

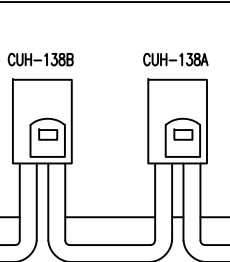


CONCESSION 2.38.01

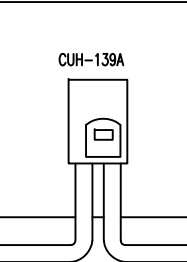




FOOD PREP. 2.38.03

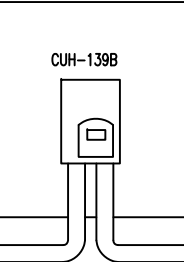

WOMEN'S RESTROOM 2.37.01

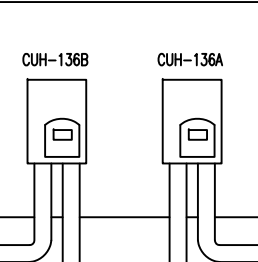

FOOD PREP. 2.35.03

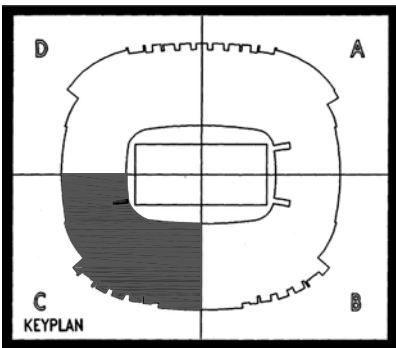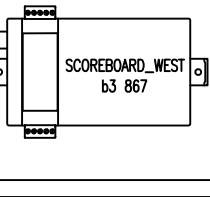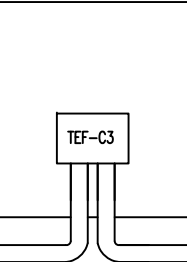

22 AWG TWISTED SHIELDED PAIR =

NOTE:

- * RAVENS_MC_QUAD_C_1: 120 OHM END-OF LINE RESISTOR AT AHU-9 (b3 920) & AT CUH-527B (AT THERMOSTAT).
RAVENS_MC_QUAD_C_2: 120 OHM END-OF LINE RESISTOR AT RAVENS_MC_QUAD_B_2 (BCX1-CR) & AT SCOREBOARD_WEST (b3 867).

Title		RAVENS QUAD C BACnet Topology	
Project/Location		M&T BANK STADIUM (RAVENS) MARYLAND STADIUM AUTHORITY PROJECT	
ESI engineered services inc		45150 Business Court Suite 100 Sterling, Virginia 20166 Tel. (703) 471-6310 Fax (703) 471-3919	
PM: EK		Engineer: BH	
Asbuilt 11/22/10	Job # 4828	Dwg. Name 2.3 RAVENS_QC_AHU__Add_Bac.	

ROOF

UPPER CONCOURSE



UPPER SUITE LEVEL

LOWER SUITE LEVEL

CLUB LEVEL

PRESS LEVEL

MAIN CONCOURSE

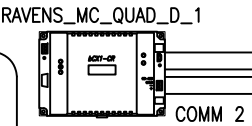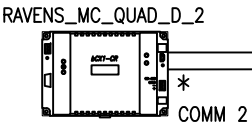



ELEC. RM. 7.48.02
POWER FROM CKT. #37 RP_UCD



D 547 D 550A
D 548B D 551B
D 548A D 551A
D 549 D 553B
D 550B D 553A *



ELEC. RM. 4.44.02

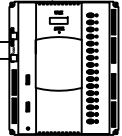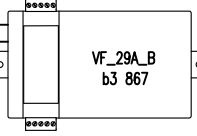

CONCESSION 2.53.01 FOOD PREP. 2.53.02

CUH-152A

CUH-152B

MEN'S RESTROOM 2.52.01

CUH-151A

CUH-151B

TEF-D5

STORAGE 2.50.02

CUH-150B

CUH-150A

CONCESSION 2.50.01

WOMEN'S RESTROOM 2.49.01

CUH-148B

CUH-148A

TEF-D4

WOMEN'S RESTROOM 2.42.01

CUH-141A

CUH-141B

*

CONCESSION 2.43.01 FOOD PREP. 2.43.03


CUH-142A

CUH-142B

MEN'S RESTROOM 2.44.01

CUH-144A

CUH-144B

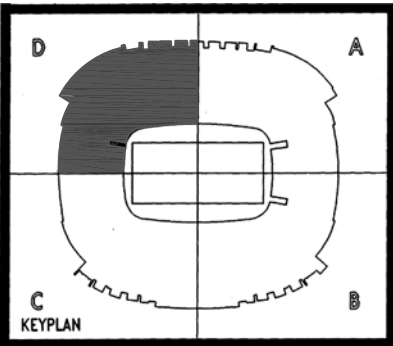

22 AWG TWISTED SHIELDED PAIR =

NOTE:

- * RAVENS_MC_QUAD_D_1: 120 OHM END-OF LINE RESISTOR AT TEF-D1 (BACnet RELAY) & AT CUH-553A (AT THERMOSTAT).
RAVENS_MC_QUAD_D_2: 120 OHM END-OF LINE RESISTOR AT RAVENS_MC_QUAD_D_2 (BCX1-CR) & AT CUH-141A (AT THERMOSTAT).



Title
RAVENS QUAD D
AHU Addition to BACnet Topology

Project/Location
M&T BANK STADIUM (RAVENS)
MARYLAND STADIUM AUTHORITY PROJECT

ESI
engineered
services inc
45150 Business Court
Suite 100
Sterling, Virginia 20166
Tel. (703) 471-6310
Fax (703) 471-3919

PM: EK	Engineer: BH
Asbuilt 11/22/10	Job # 4828 Dwg. Name 2.4 RAVENS_QD_AHU__Add_Bac.


NEW 18" X 12" PANEL

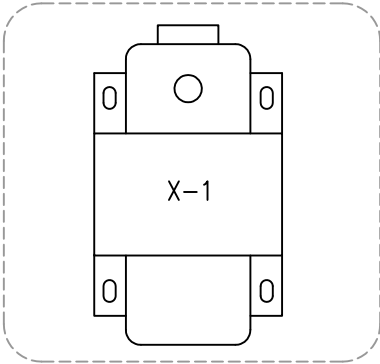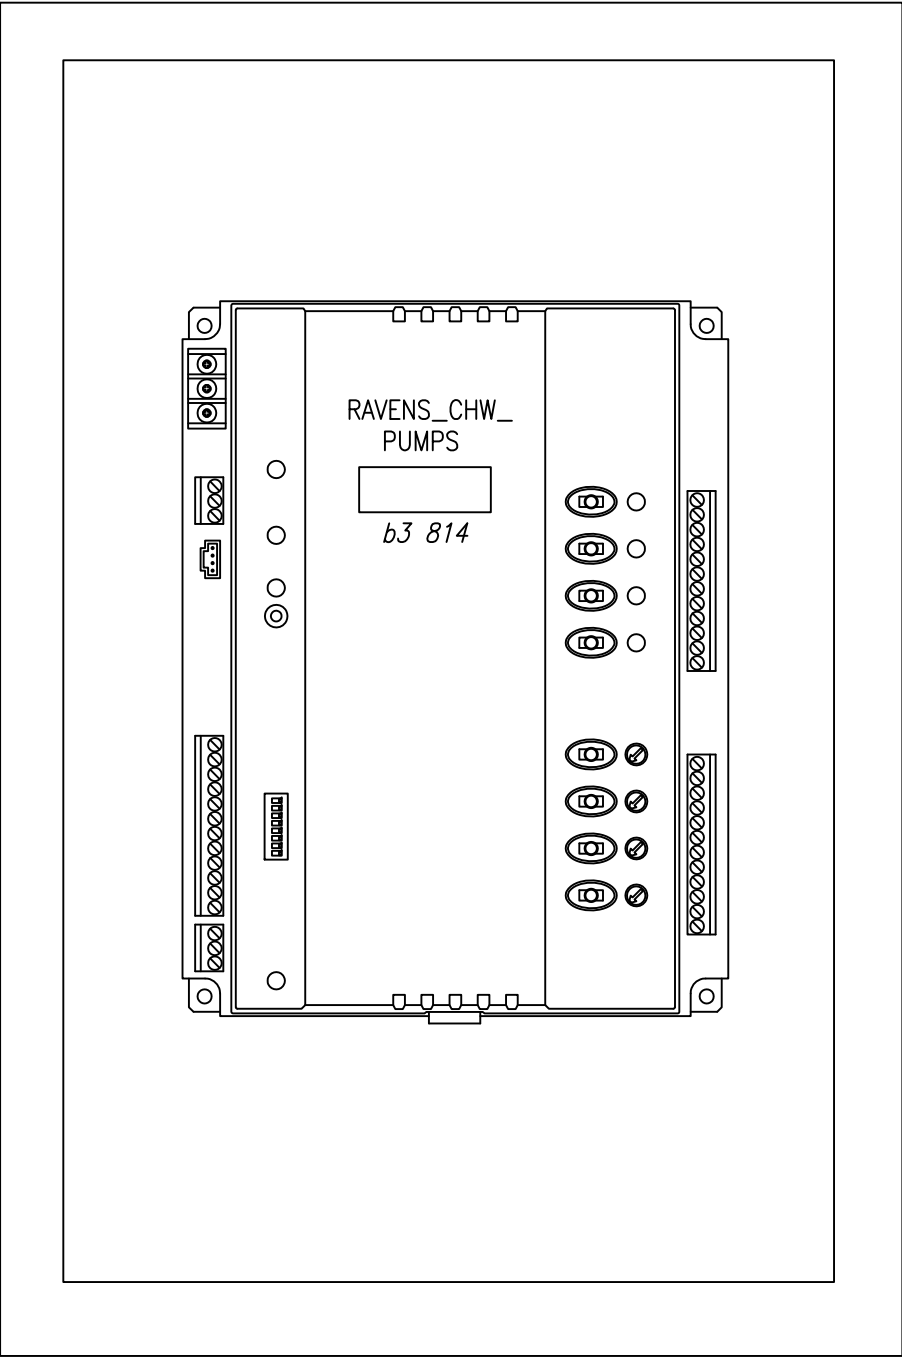

EXISTING TRANSFORMER FOR
CONTROLLER OUTPUTS AND
b3 814 POWER FEED


Tag	Qty.	Mfg.	Model	Description
RAVENS_PUMPS	1	Andover Hoffman	b3 814 HC18124P	BACnet local controller Nema 1 hinged Cover enclosure w/ backplate

Title RAVENS PUMPS PANEL Located in Ravens Field		
Project/Location M&T BANK STADIUM (RAVENS) MARYLAND STADIUM AUTHORITY PROJECT		
ESI engineered services inc 45150 Business Court Suite 100 Sterling, Virginia 20166 Tel. (703) 471-6310 Fax (703) 471-3919		
PM: EK		Engineer: BH
Asbuilt 11/22/10	Job # 4828	Dwg. Name 3.1 Ravens_Pumps_Panel

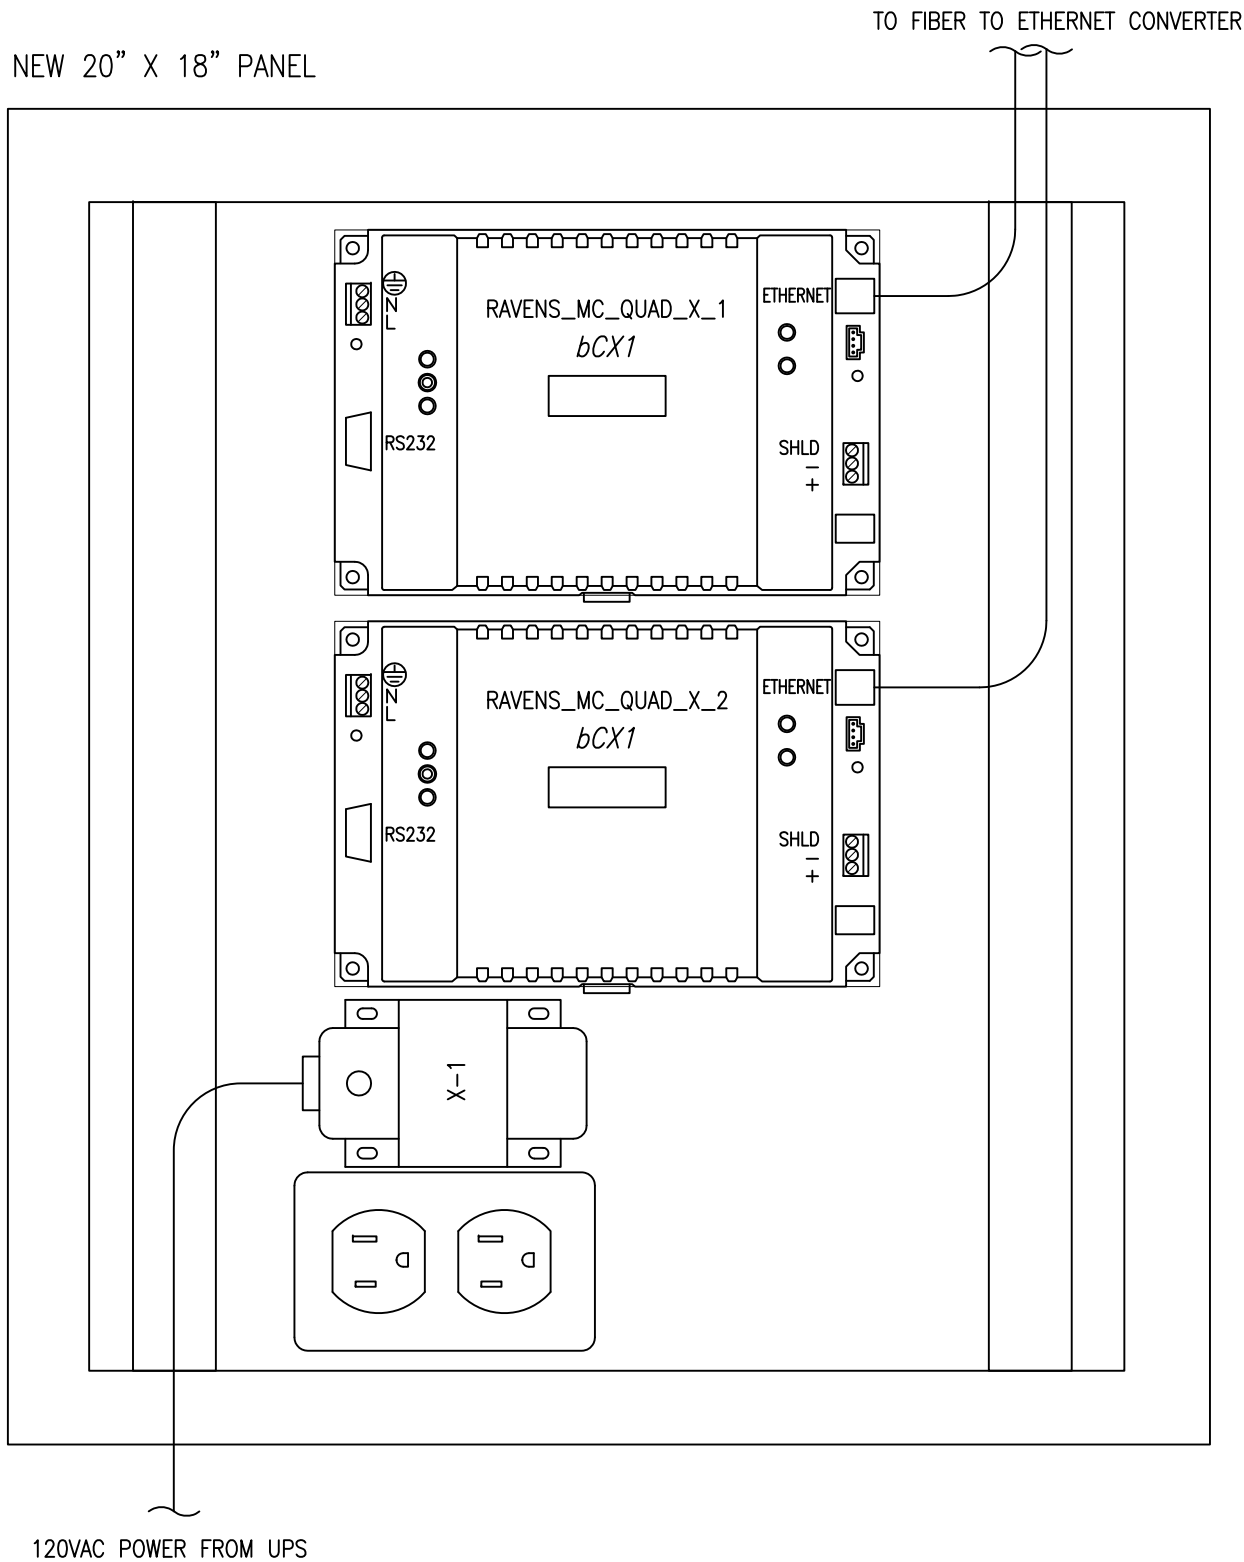

LOCATED IN OR NEAR THE FOLLOWING ROOMS WHERE NETWORK ACCESS IS AVAILABLE:

- T.V./A.V. 6.03.09 (QUAD A)
- T.V./A.V. 6.24.11 (QUAD B)
- T.V./A.V. 6.30.10 (QUAD C)
- T.V./A.V. 6.51.10 (QUAD D)

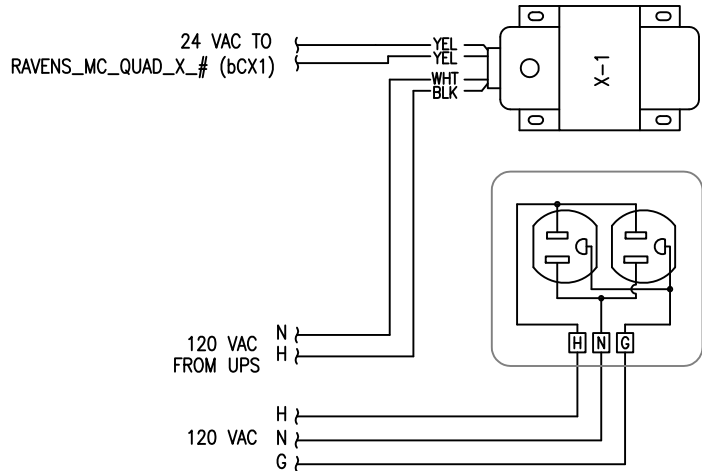

(Typical for 4)

Tag	Qty.	Mfg.	Model	Description
RAVENS_MC_QUAD_X_#	2	Andover	bCX1-CR-32	BACnet controller/router
	1	Kele	RET2018ULP	Controls enclosure, w/ perf panel
	1	Kele	PRK	Panel receptacle assembly
	2	Panduit	F1X3WH6 w/ C1WH6	1" wide wire duct
X-1	1	Veris	X050CBA	Control transformer, 120/240/277/480V~24V, 50VA



Title
RAVENS UPPER SUITE BCX PANEL
Typical for 4 (Quads A – D)

Project/Location
M&T BANK STADIUM (RAVENS)
MARYLAND STADIUM AUTHORITY PROJECT

ESI 45150 Business Court
Suite 100
Sterling, Virginia 20166
engineered services inc Tel. (703) 471-6310
Fax (703) 471-3919

PM: EK Engineer: BH
Asbuilt 11/22/10 Job # 4828 Dwg. Name 3.2 RAVENS_Upper_Suite_BCX_P.

NEW 26" X 20" PANEL

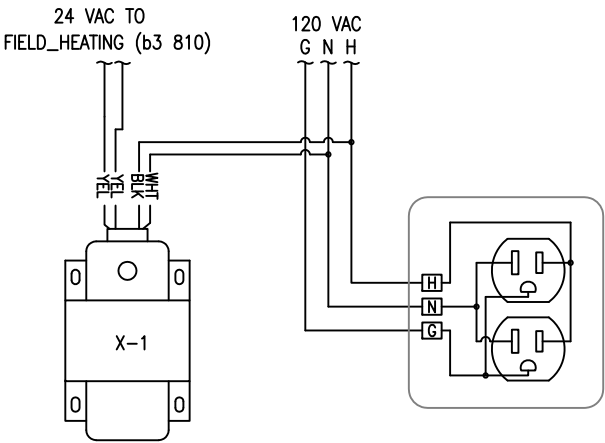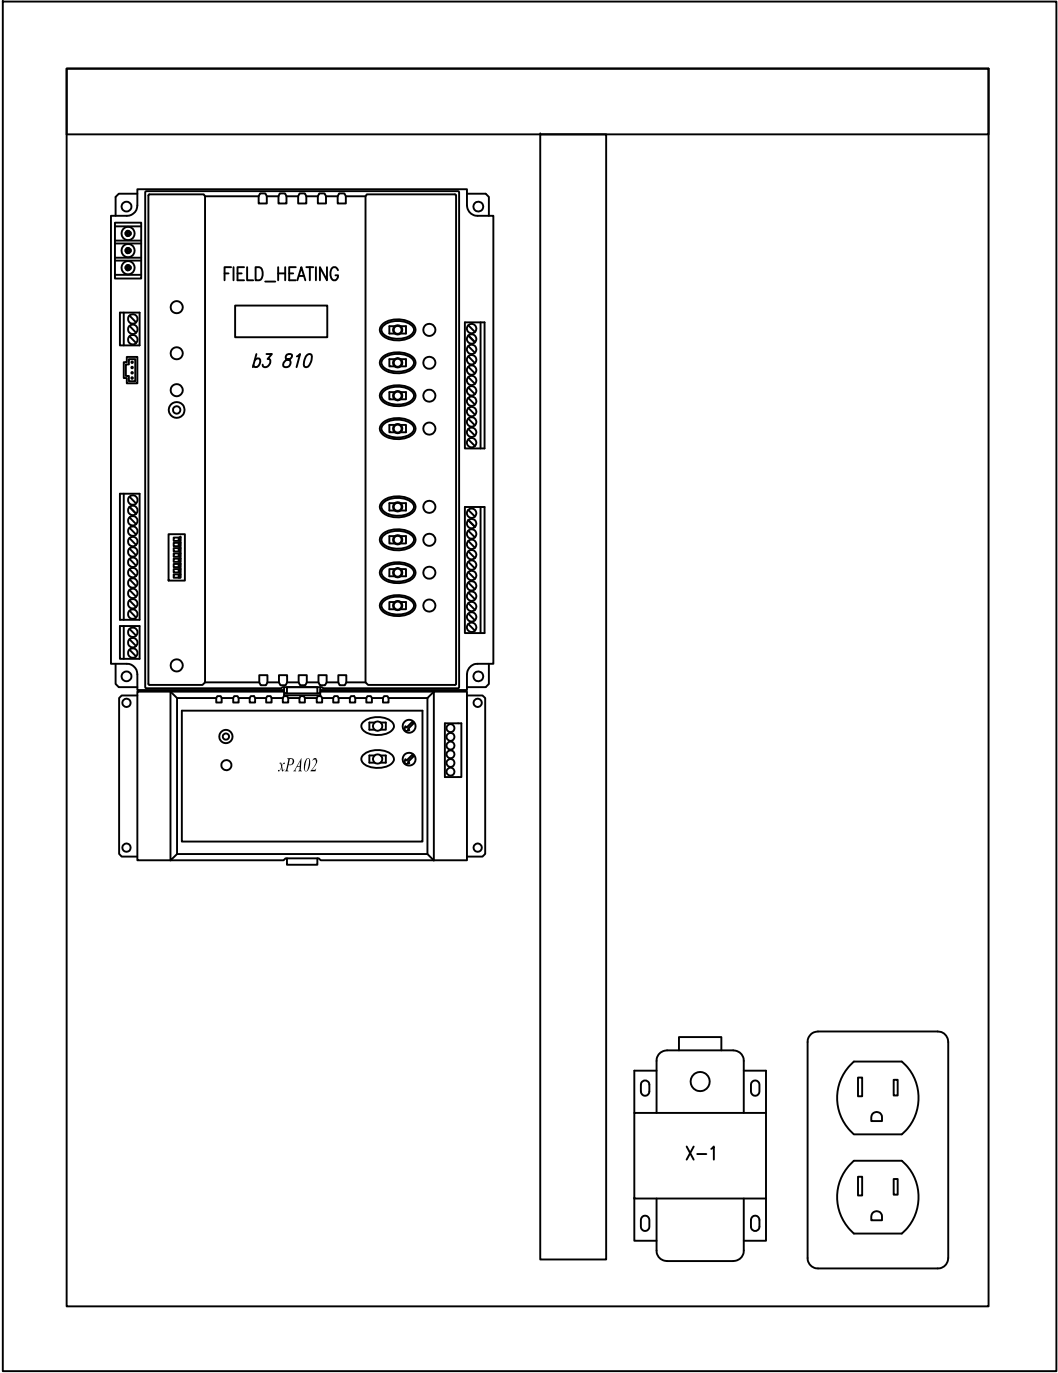

Tag	Qty.	Mfg.	Model	Description
FIELD_HEATING	1	Andover	b3 810	BACnet local controller
"	1	Andover	xP AO2	Expansion Module
	1	Kele	RET2620	Controls enclosure, w/ perf panel
	1	Kele	PRK	Panel receptacle assembly
	2	Panduit	F1X3WH6 w/ C1WH6	1" wide wire duct
X-1	1	Veris/TAC	T-208	Control transformer,120V~24V, 100VA

Title

RAVENS FIELD HEATING PANEL
Located in Field Maint. Rm. 1.12.01

Project/Location

M&T BANK STADIUM (RAVENS)
MARYLAND STADIUM AUTHORITY PROJECT

ESI

engineered
services inc

45150 Business Court
Suite 100
Sterling, Virginia 20166

Tel. (703) 471-6310
Fax (703) 471-3919

PM: EK



Engineer: BH

Asbuilt
11/22/10


Job #
4828

Dwg. Name
3.3 RAVENS_Field_Heating_Panel

NEW 16" X 12" PANEL

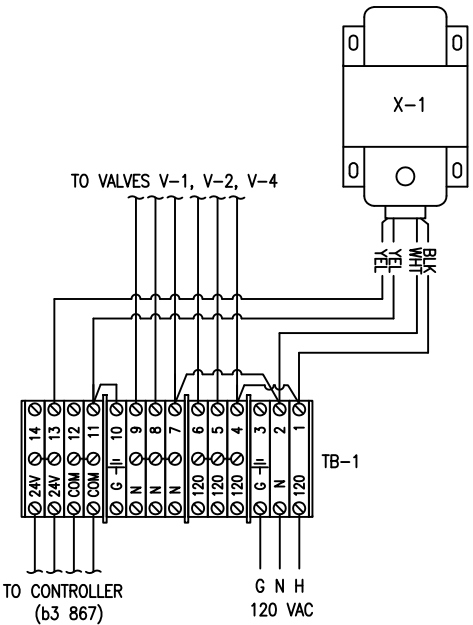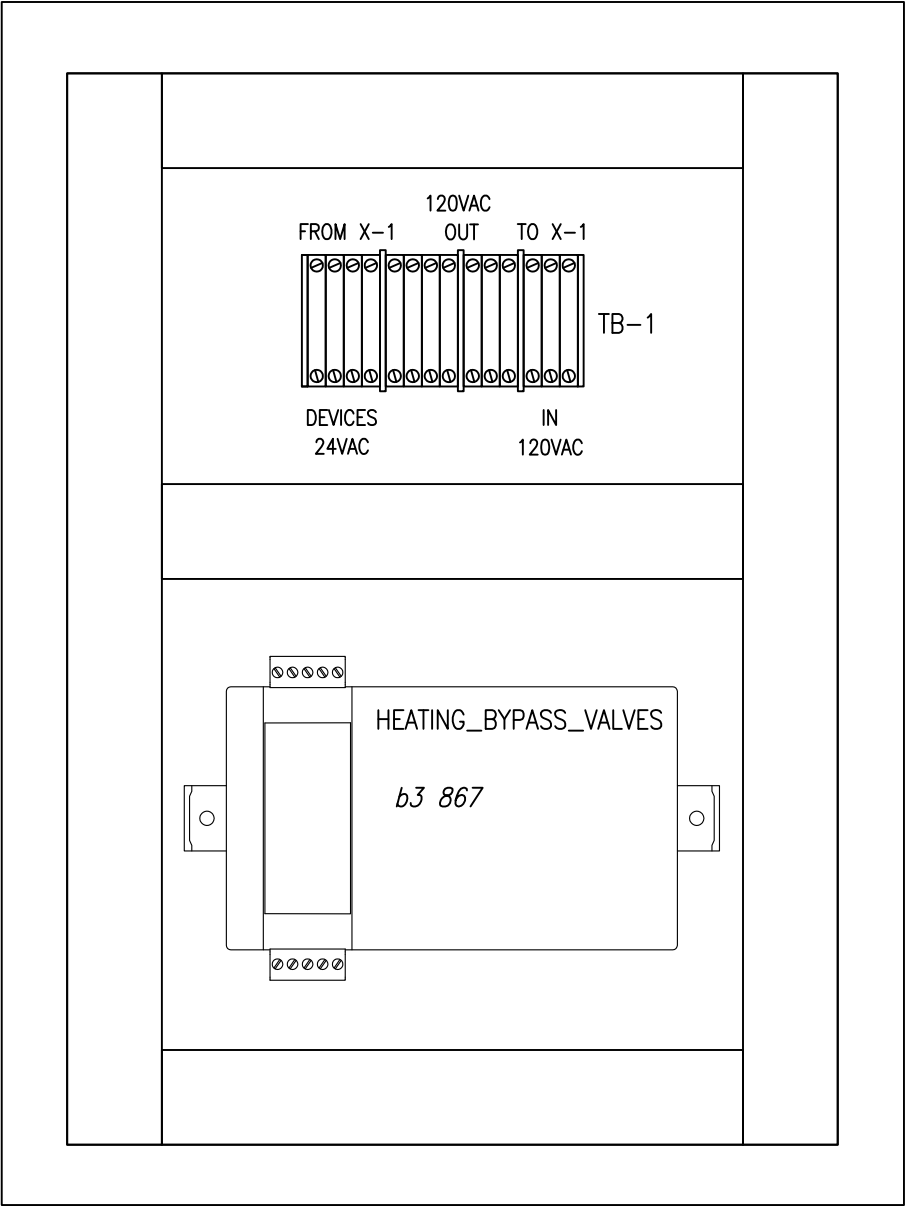


NEW 50 VA TRANSFORMER FOR
CONTROLLER OUTPUTS AND
b3 867 POWER FEED

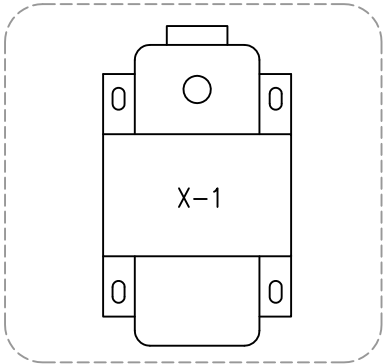

Tag	Qty.	Mfg.	Model	Description
HEATING_BYPASS_VALVES	1	Andover	b3 867	Bacnet terminal controller
	1	Hoffman	HC16124P	Nema 1 hinged Cover enclosure w/ backplate
	1	Veris/TAC	X050CBA	Control transformer, 50 VA, w/ circuit breaker
	-	Kele	DIN-3F	DIN Rail
	1	Panduit	F1X3WH6 w/ C1WH6	1.26"W x 3.12"H wire duct w/ cover
TB-1	-	Phoenix	UK5 series	terminal blocks & accessories


Title		RAVENS HEATING BYPASS VALVES PANEL	
Project/Location		M&T BANK STADIUM (RAVENS) MARYLAND STADIUM AUTHORITY PROJECT	
ESI engineered services inc		45150 Business Court Suite 100 Sterling, Virginia 20166 Tel. (703) 471-6310 Fax (703) 471-3919	
PM: EK		Engineer: BH	
Asbuilt 11/22/10	Job # 4828	Dwg. Name 3.4 RAVENS HEATING BYPASS P.	

NEW 26" X 20" PANEL

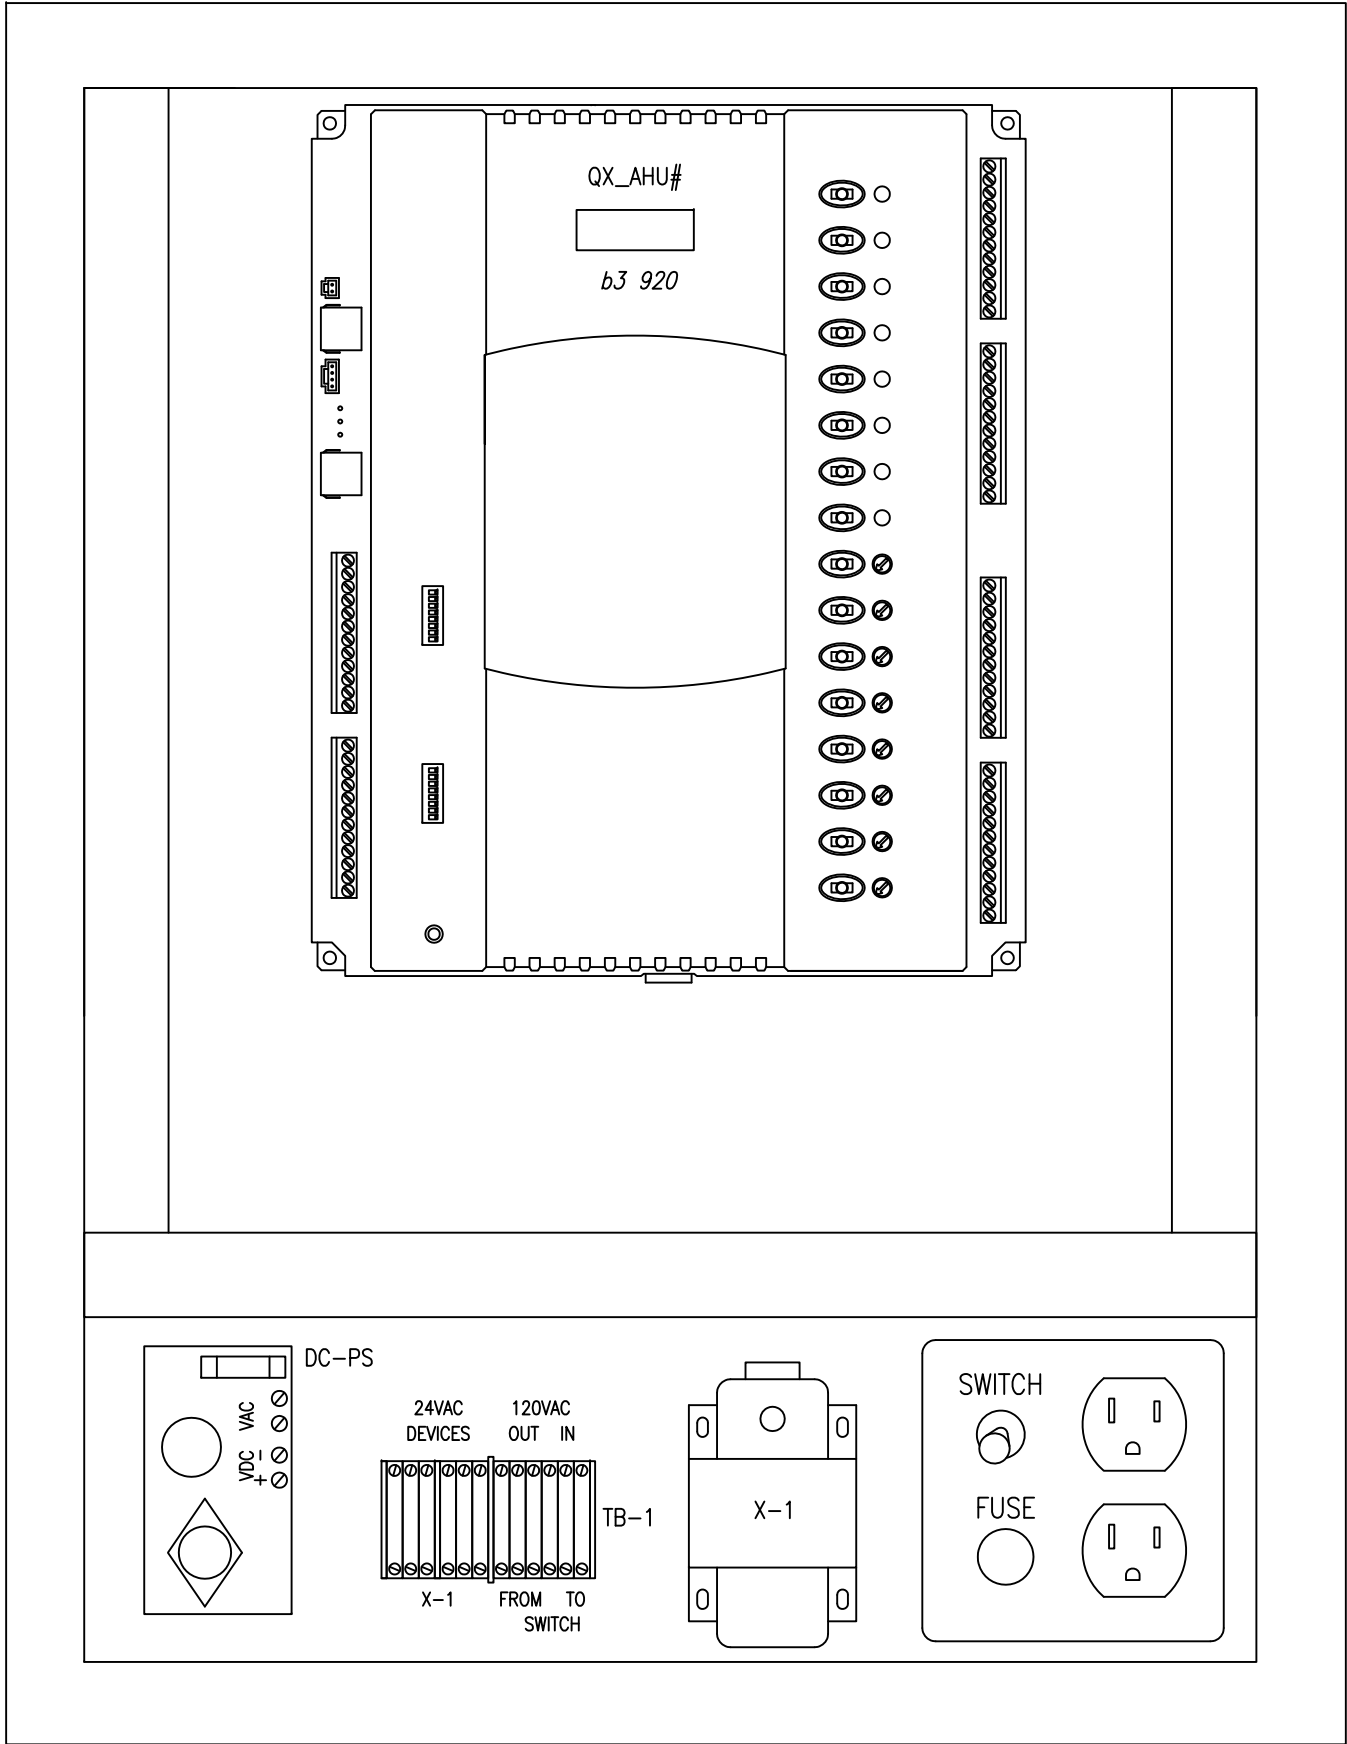


LOCATED NEAR EXISTING JOHNSON AHU CONTROLLER

SWITCHED 120VAC TO QX_AHU# (b3 920) DEVICE
24VAC TO QX_AHU# DEVICES

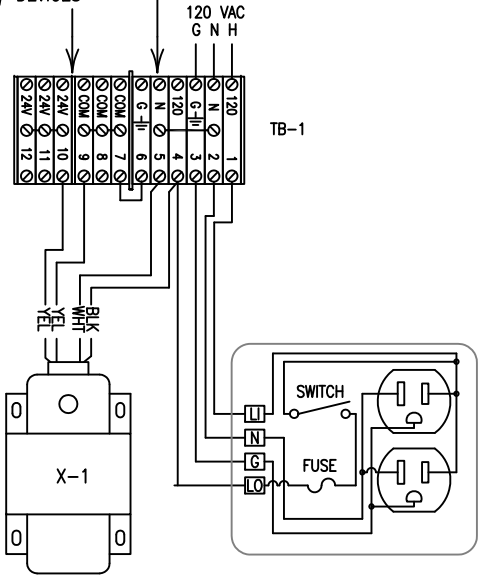

JOHNSON EXISTING TB SEE DRAWING 5.1

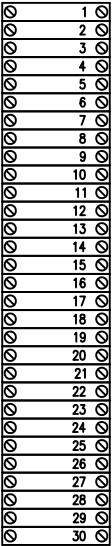

(Typical for 5)

Tag	Qty.	Mfg.	Model	Description
QX-AHU#	1	Andover	b3 920	BACnet system controller
	1	Kele	RET2620	Nema 1 enclosure, with panel plate
	1	Kele	PRK-FS	Panel receptacle & disconnect
	2	Kele	GF-1S	Fuse 1 amp slow-blow
DC-PS	1	Kele	DCP-1.5-W	24VAC~24VDC Power Supply
	1	Kele	DIN-3F	DIN Rail
	2	Panduit	F1X3WH6 w/ C1WH6	1.26"W x 3.12"H wire duct w/ cover
X-1	1	Veris/TAC	T-208	Control transformer, 120V~24V, 100VA
TB-1	-	Phoenix	UK5 series	terminal blocks & accessories

Title

Typical VAV AHU Panel
Typical for AHU-1 through 4 & 9

Project/Location

M&T BANK STADIUM (RAVENS)
MARYLAND STADIUM AUTHORITY PROJECT

ESI

engineered
services inc

45150 Business Court
Suite 100
Sterling, Virginia 20166

Tel. (703) 471-6310
Fax (703) 471-3919

PM: EK

Engineer: BH



Asbuilt
11/22/10

Job #
4828

Dwg. Name
3.5 Typical VAV AHU Panel

Panels	Panel Location	Level
VF-9	North Mech. Rm. A	Service - A
VF-26A & B	Electric Room	Press-A
VF-27A& B	Electric Room	Press-B
VF-28A & B	Electric Room	Press-C
VF-29A & B	Electric Room	Press-D

NEW 12" X 12" PANEL

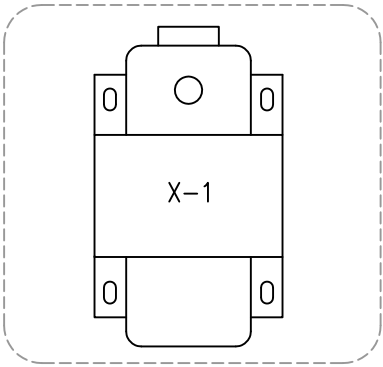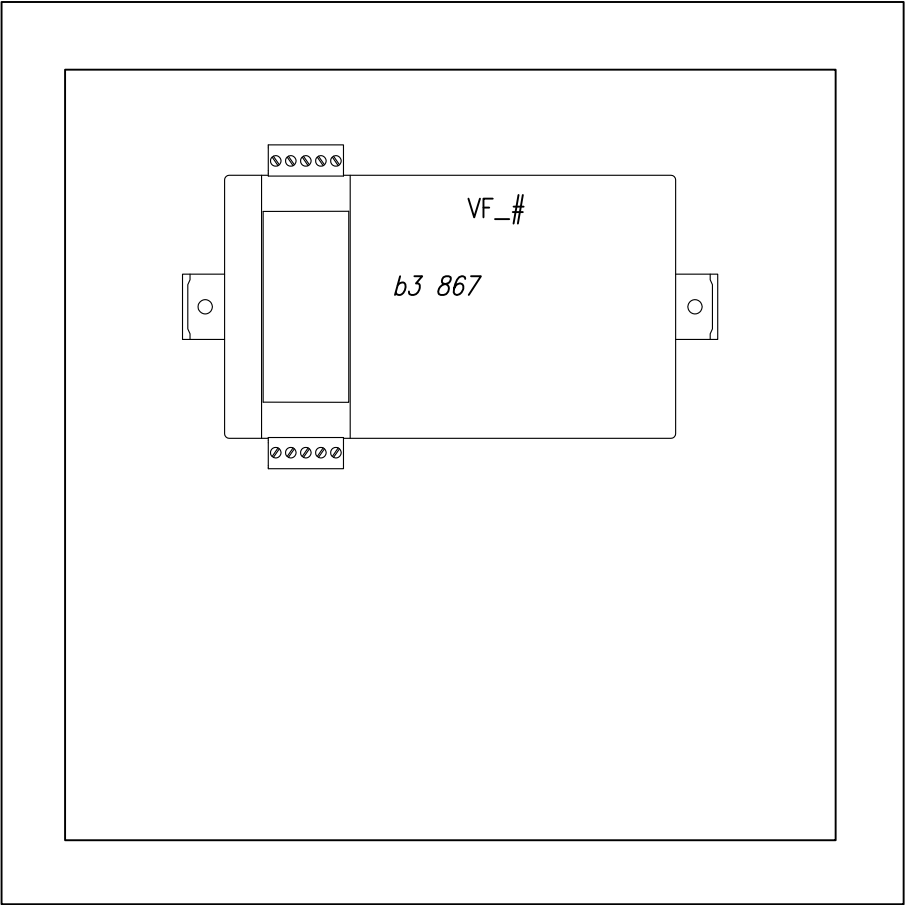

NEW 50 VA TRANSFORMER FOR
CONTROLLER OUTPUTS AND
b3 867 POWER FEED

Typical of 5 Panels				
Tag	Qty.	Mfg.	Model	Description
VF_#	1	Andover	b3 867	BACnet terminal controller
	1	Hoffman	HC12124P	Nema 1 hinged Cover enclosure w/ backplate
X-1	1	Veris/TAC	X050CBA	Control transformer, 50 VA, w/ circuit breaker

Title
RAVENS TYPICAL VF UNIT PANEL
(Typical of 5 Panels)

Project/Location
M&T BANK STADIUM (RAVENS)
MARYLAND STADIUM AUTHORITY PROJECT



ESI 45150 Business Court
Suite 100
Sterling, Virginia 20166
engineered Tel. (703) 471-6310
services inc Fax (703) 471-3919

PM: EK Engineer: BH

Asbuilt 11/22/10	Job # 4828	Dwg. Name 3.6 RAVENS_VF_UNIT_Panel
---------------------	---------------	---------------------------------------

Panels	Panel Location	Level
VF-11,12,13	South Mech. Rm. B	Service - B

NEW 16" X 12" PANEL

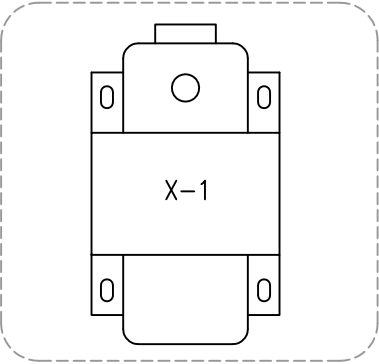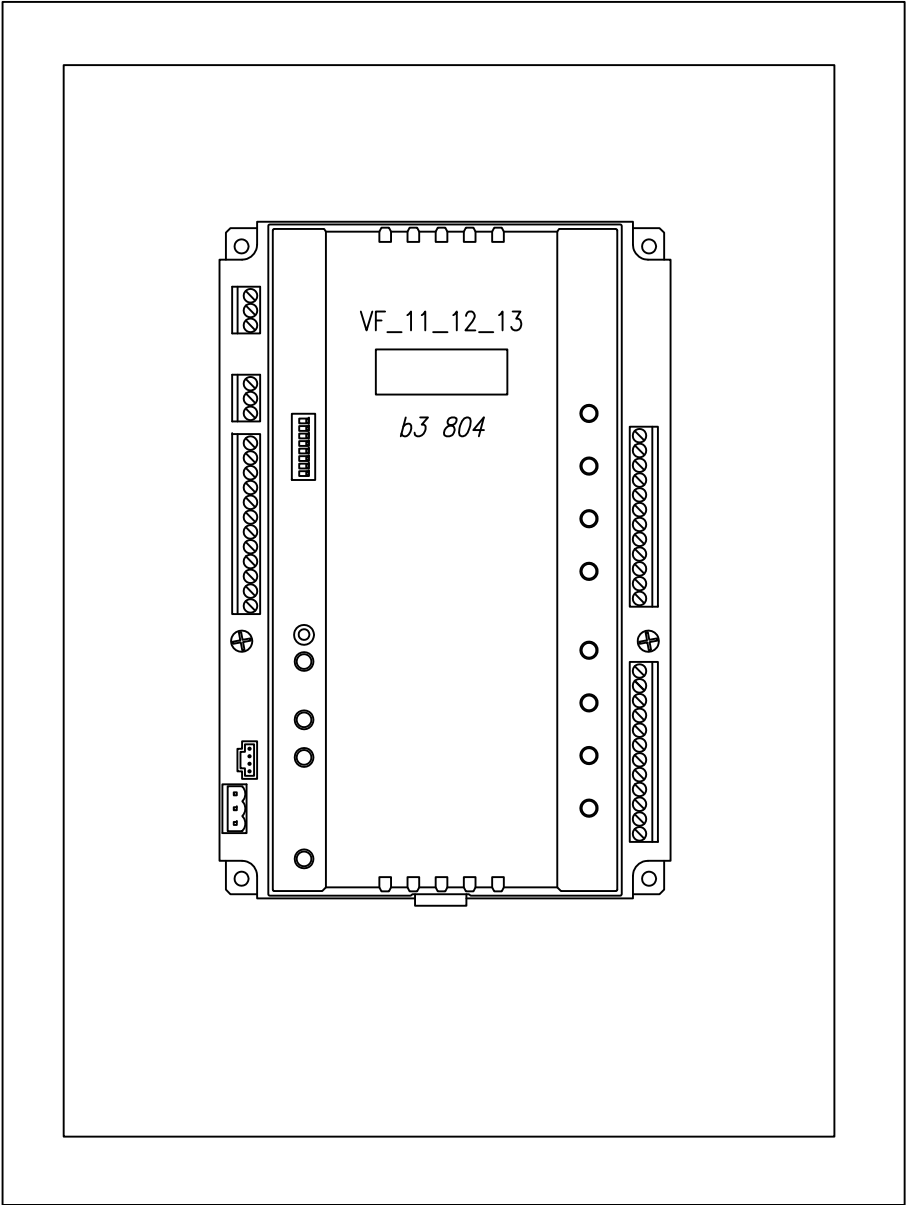


NEW 50 VA TRANSFORMER FOR
CONTROLLER OUTPUTS AND
b3 804 POWER FEED

Tag	Qty.	Mfg.	Model	Description
VF_11_12_13	1	Andover	b3 804	BACnet local controller
X-1	1	Hoffman	HC16124P	Nema 1 hinged Cover enclosure w/ backplate
	1	Veris/TAC	X050CBA	Control transformer, 50 VA, w/ circuit breaker



Title RAVENS VF-11,12,13 PANEL		
Project/Location M&T BANK STADIUM (RAVENS) MARYLAND STADIUM AUTHORITY PROJECT		
ESI engineered services inc 45150 Business Court Suite 100 Sterling, Virginia 20166 Tel. (703) 471-6310 Fax (703) 471-3919		
PM: EK		Engineer: BH
Asbuilt 11/22/10	Job # 4828	Dwg. Name 3.7 RAVENS_VF_11_12_13_Panel

NEW 26" X 20" PANEL

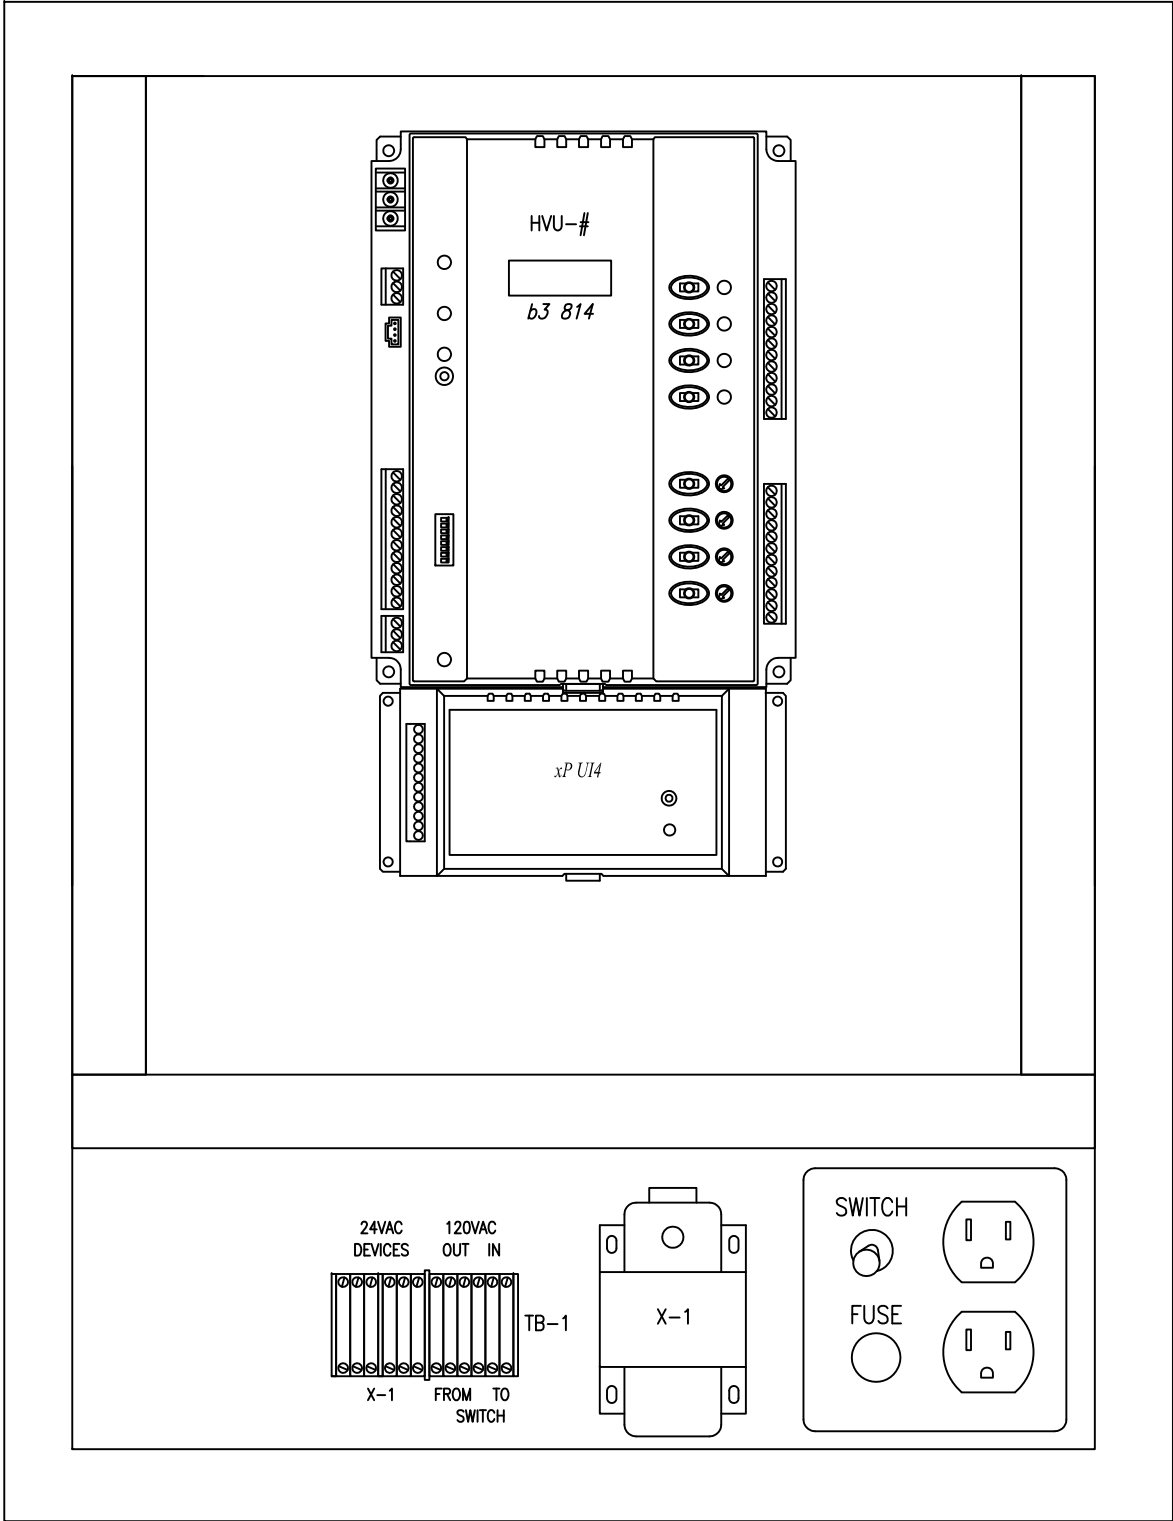

PANEL LOCATED NEAR EXISTING JOHNSON HVU PANEL

NEW DEVICES/PARTS INSTALLED
IN EXISTING HVU PANEL

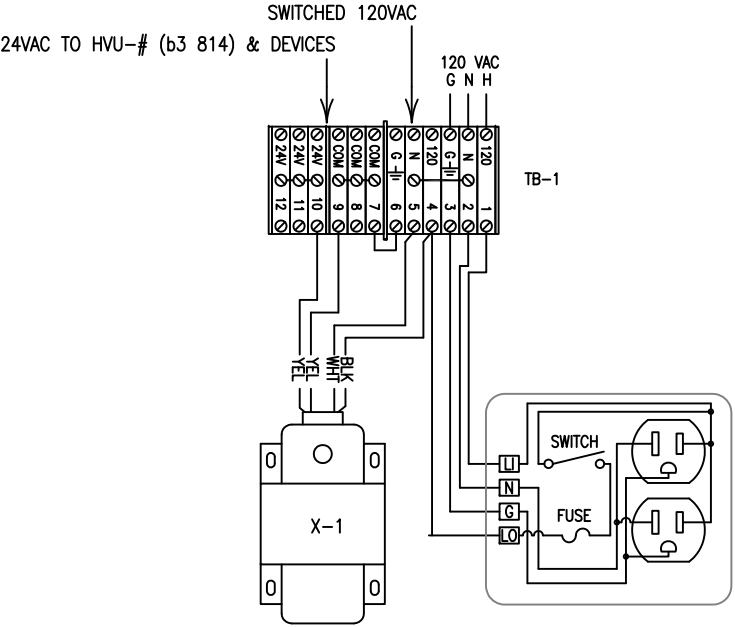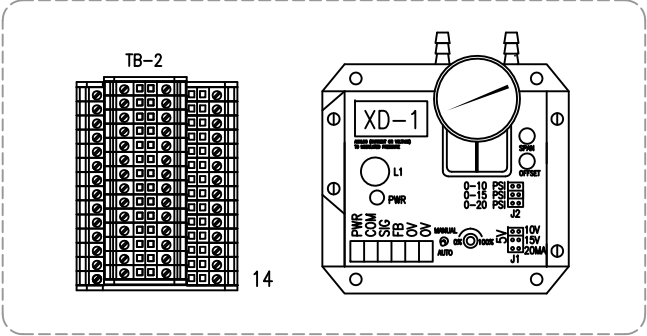

(Typical for 2)

Tag	Qty.	Mfg.	Model	Description
HVU-#	1	Andover	b3 814	BACnet local controller
"	1	Andover	xP U14	Expansion Module
XD-1	1	ACT	EPC2GFSB	Analog Current or Voltage Input to Pneumatic Output including Fail Safe
	1	Kele	RET2620	Nema 1 enclosure, with panel plate
	1	Kele	PRK-FS	Panel receptacle & disconnect
	2	Kele	GF-1S	Fuse 1 amp slow-blow
	-	Kele	DIN-3F	DIN Rail
	2	Panduit	F1X3WH6 w/ C1WH6	1.26"W x 3.12"H wire duct w/ cover
X-1	1	Veris/TAC	T-208	Control transformer, 120V~24V, 100VA
TB-1,2	-	Phoenix	UK5/UTTB series	terminal blocks & accessories

Title

NEW HVU-# Panel
(Typical for 2: HVU-1 & 2)

Project/Location

M&T BANK STADIUM (RAVENS)
MARYLAND STADIUM AUTHORITY PROJECT

ESI

engineered
services inc

45150 Business Court
Suite 100
Sterling, Virginia 20166
Tel. (703) 471-6310
Fax (703) 471-3919

PM: EK

Asbuilt
11/22/10

Engineer: BH



Job #
4828

Dwg. Name
3.8 HVU-1 & 2 Panel


NEW 12" X 12" PANEL

FRONT OF ENCLOSURE

INSIDE ENCLOSURE

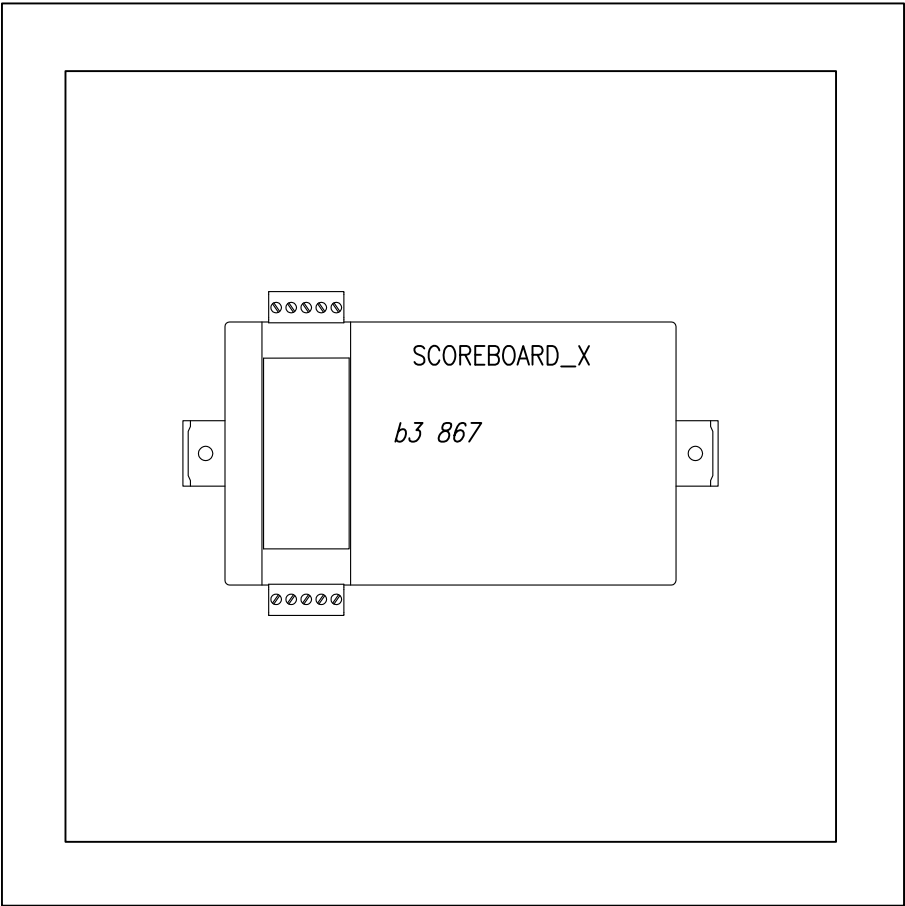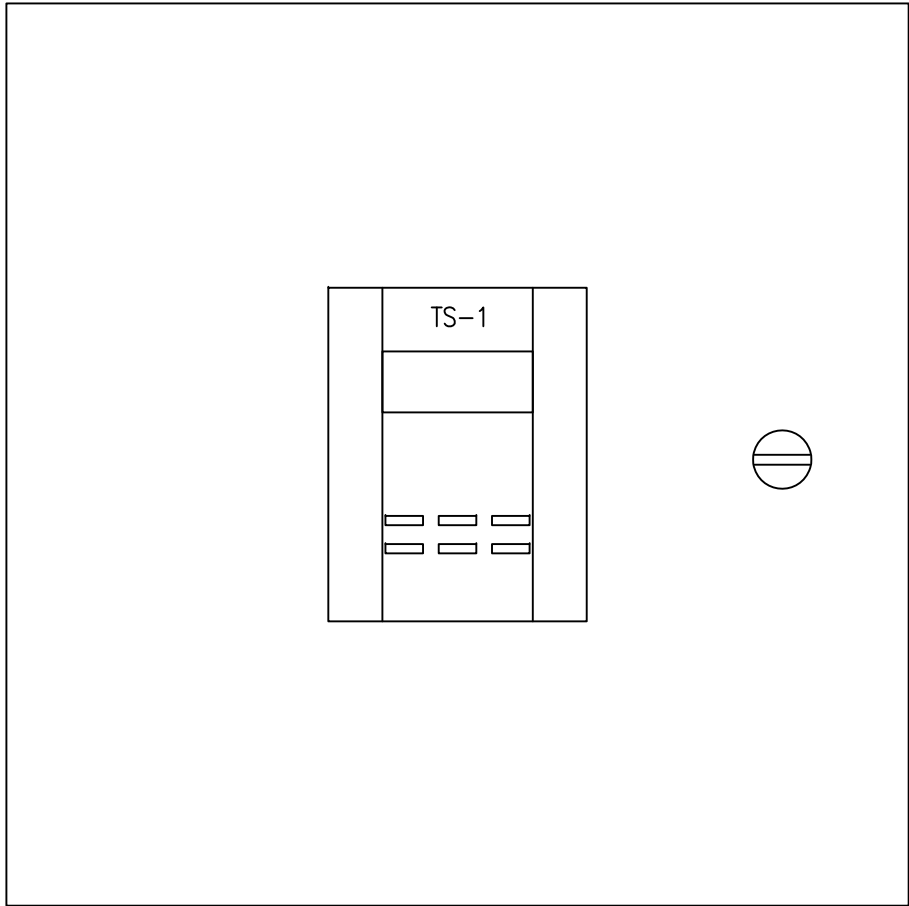


NEW 50 VA TRANSFORMER FOR
CONTROLLER OUTPUTS AND
b3 867 POWER FEED

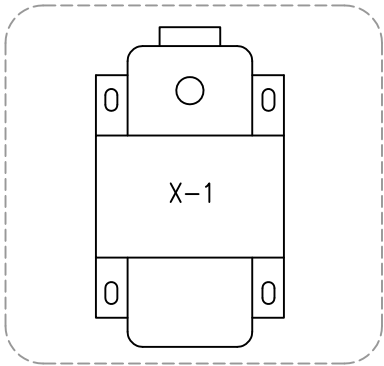

Typical of 2 Panels				
Tag	Qty.	Mfg.	Model	Description
SCOREBOARD_X	1	Andover	b3 867	Bacnet terminal controller
TS-1	1	Hoffman	HC12124P	Nema 1 hinged Cover enclosure w/ backplate
X-1	1	TAC	TTS-SD-LCD-1	Smart Sensor w/ LCD
	1	Veris/TAC	X050CBA	Control transformer, 50 VA, w/ circuit breaker


Title RAVENS Scoreboard EFs Panel (Typical of 2 Panels, EAST & WEST)		
Project/Location M&T BANK STADIUM (RAVENS) MARYLAND STADIUM AUTHORITY PROJECT		
ESI engineered services inc 45150 Business Court Suite 100 Sterling, Virginia 20166 Tel. (703) 471-6310 Fax (703) 471-3919		
PM: EK		Engineer: BH
Asbuilt 11/22/10	Job # 4828	Dwg. Name 3.9 Ravens Scoreboard EFs Pnl's

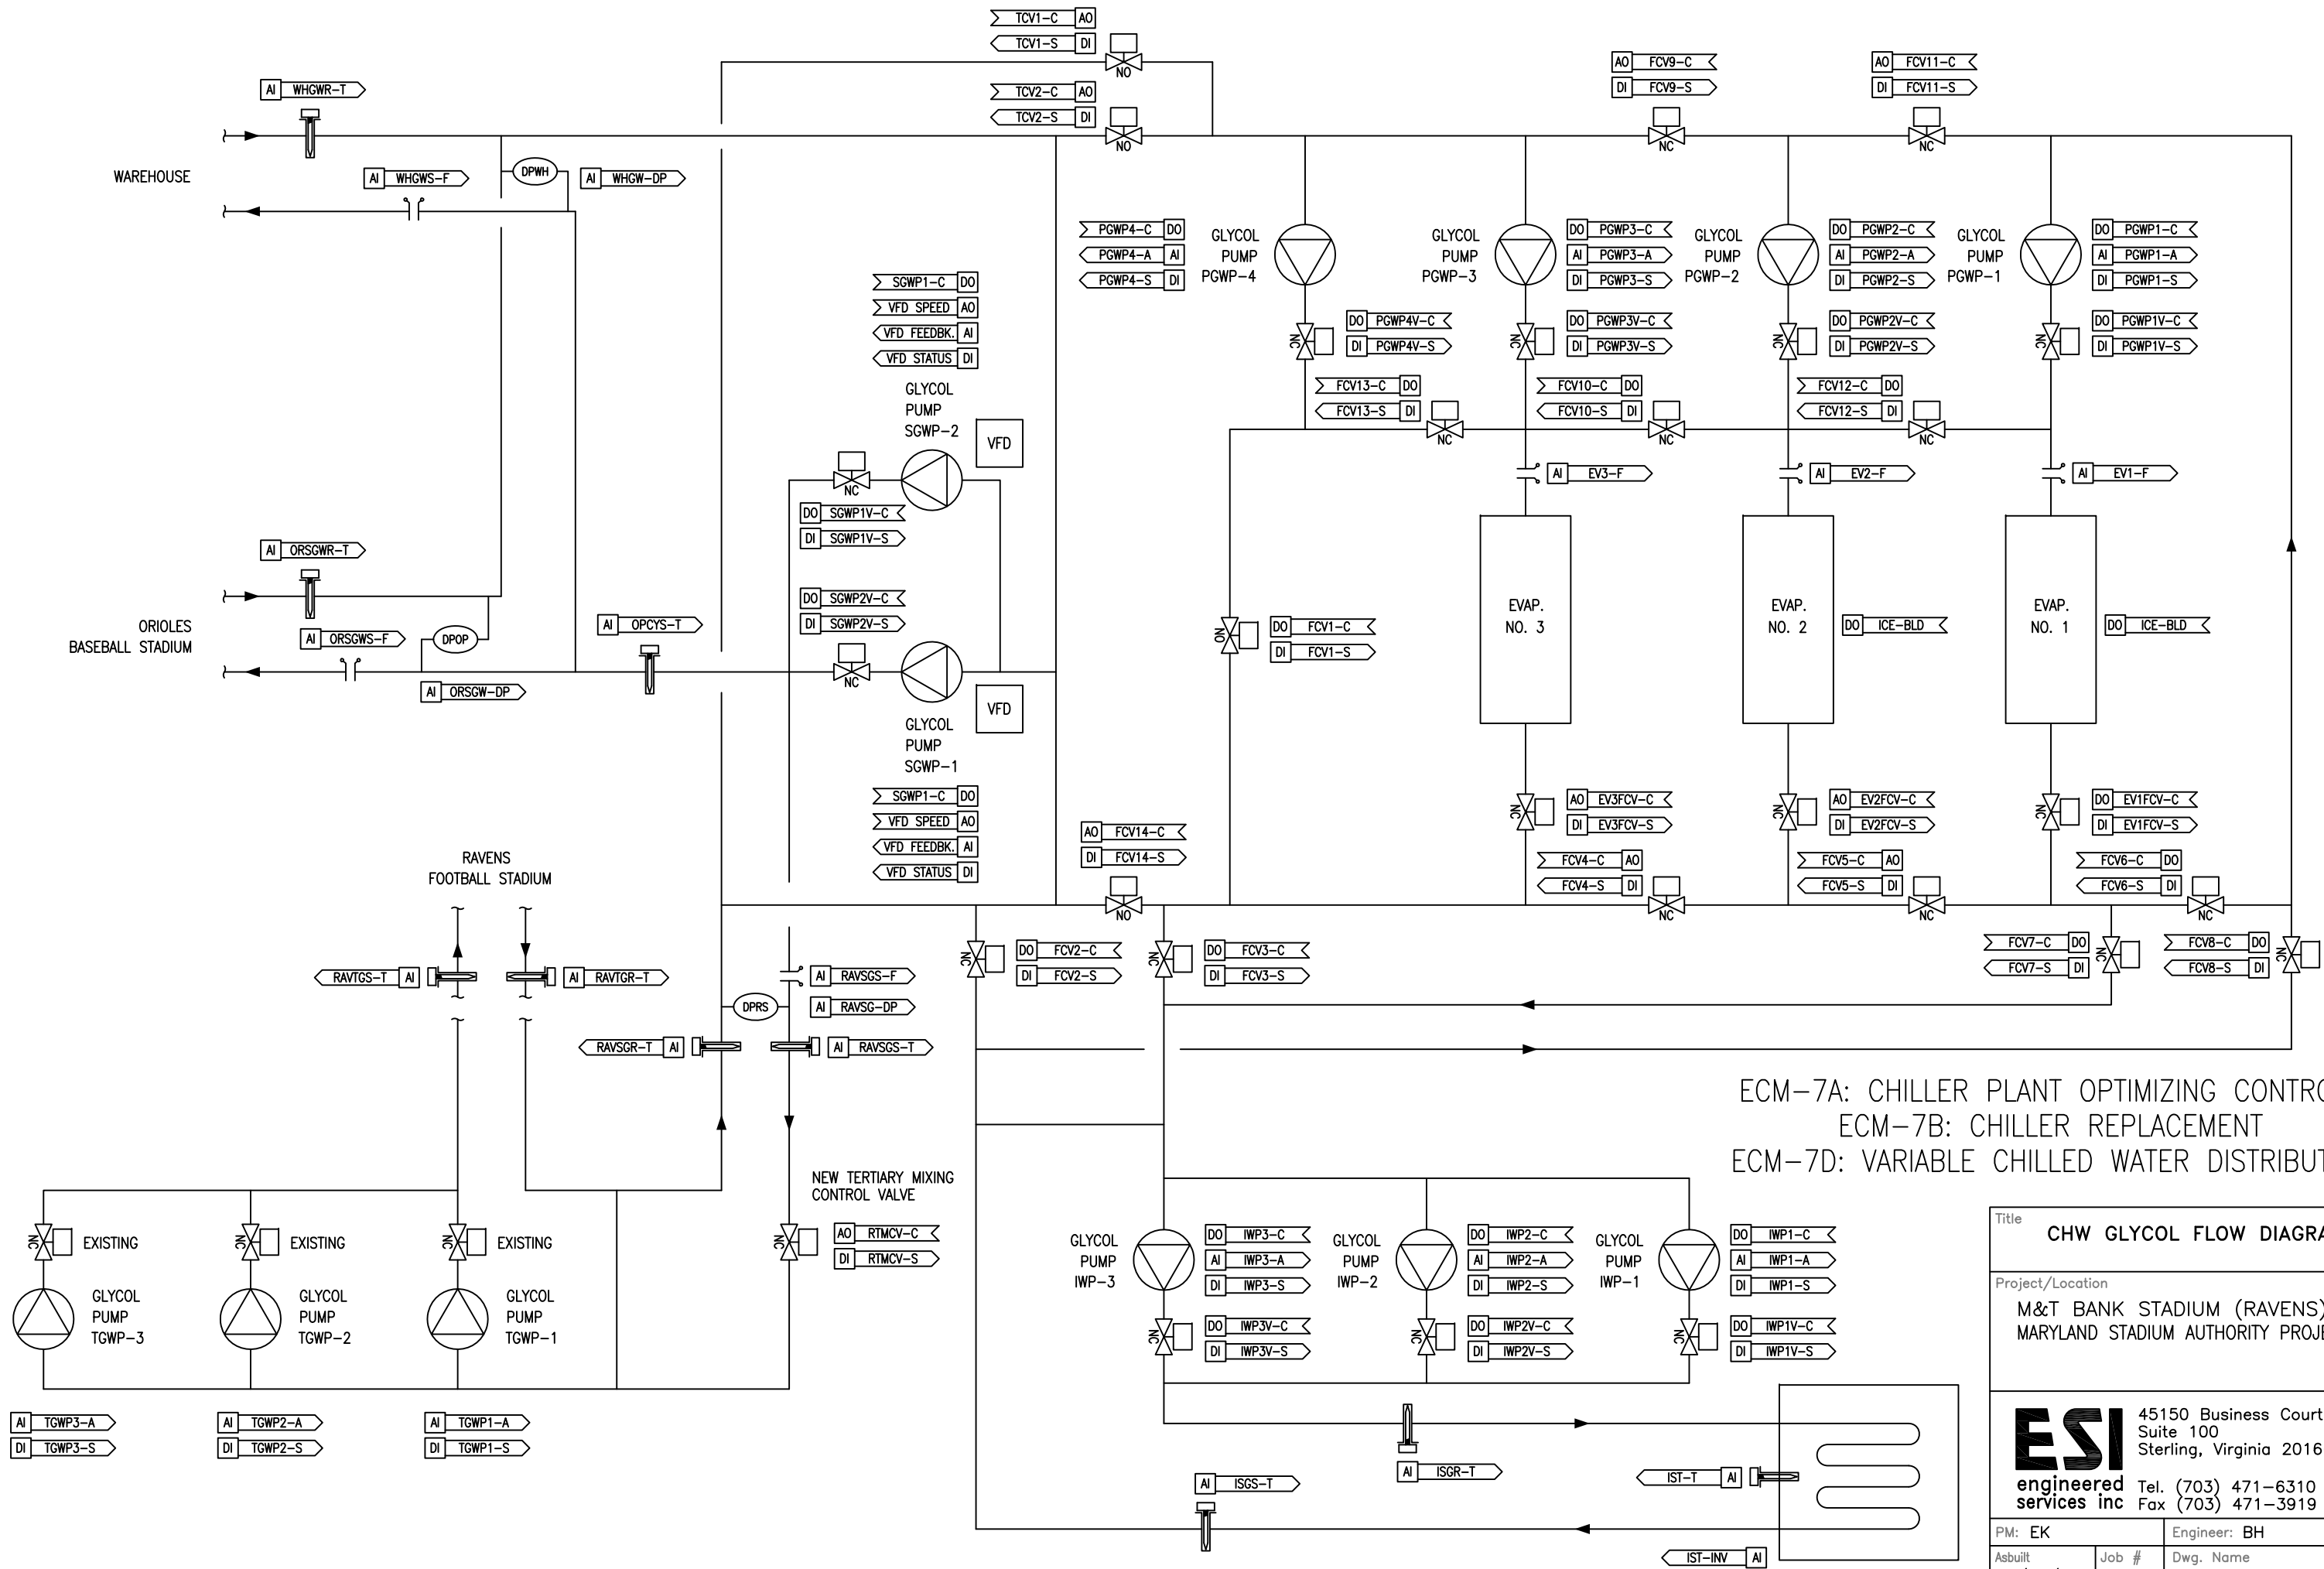


ECM-7A: CHILLER PLANT OPTIMIZING CONTROLS
ECM-7B: CHILLER REPLACEMENT
ECM-7D: VARIABLE CHILLED WATER DISTRIBUTION

Title CHW GLYCOL FLOW DIAGRAM	
Project/Location M&T BANK STADIUM (RAVENS) MARYLAND STADIUM AUTHORITY PROJECT	
ESI engineered services inc 45150 Business Court Suite 100 Sterling, Virginia 20166 Tel. (703) 471-6310 Fax (703) 471-3919	
PM: EK	Engineer: BH
Asbuilt 11/22/10	Dwg. Name 4.1 Glycol_Flow_Diagram

ECM-7A: CHILLER PLANT OPTIMIZING CONTROLS


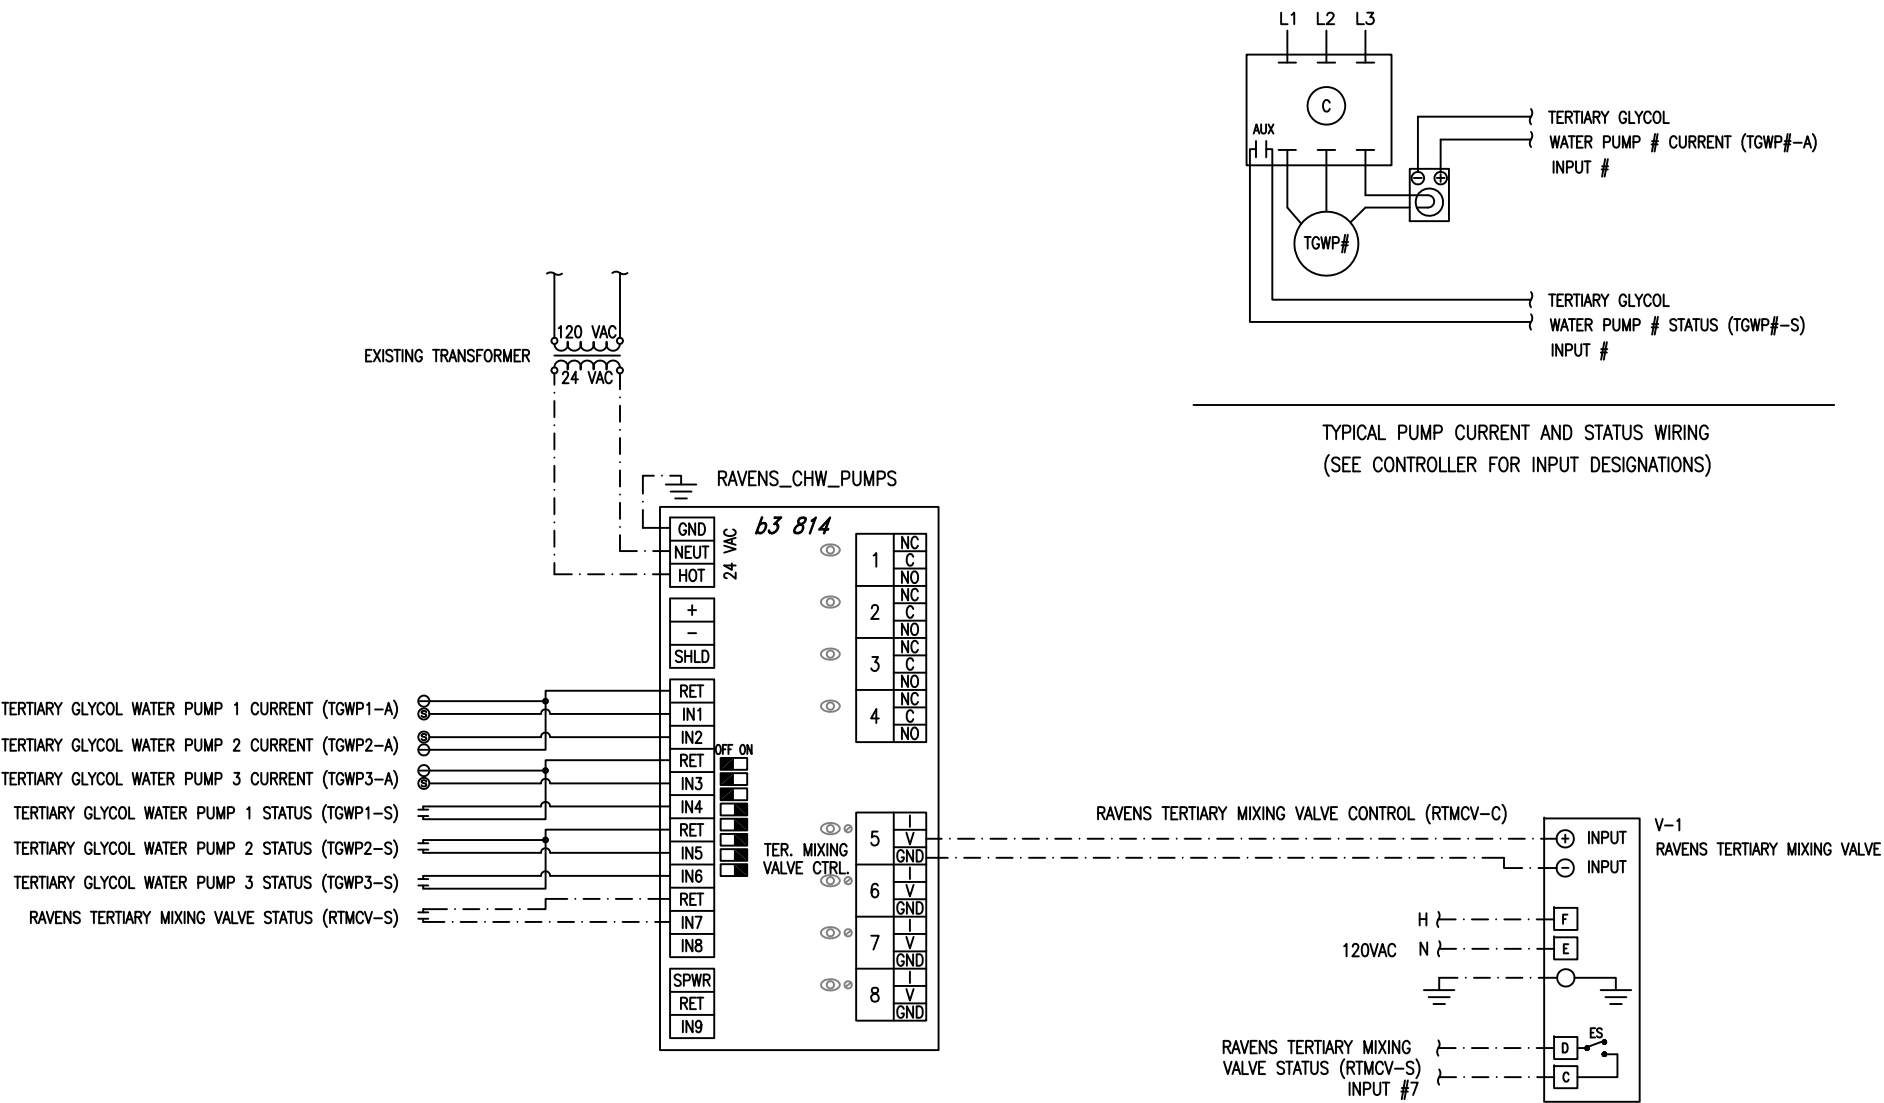


ECM-8E: HEATING CONTROLS UPGRADE AT RAVENS STADIUM

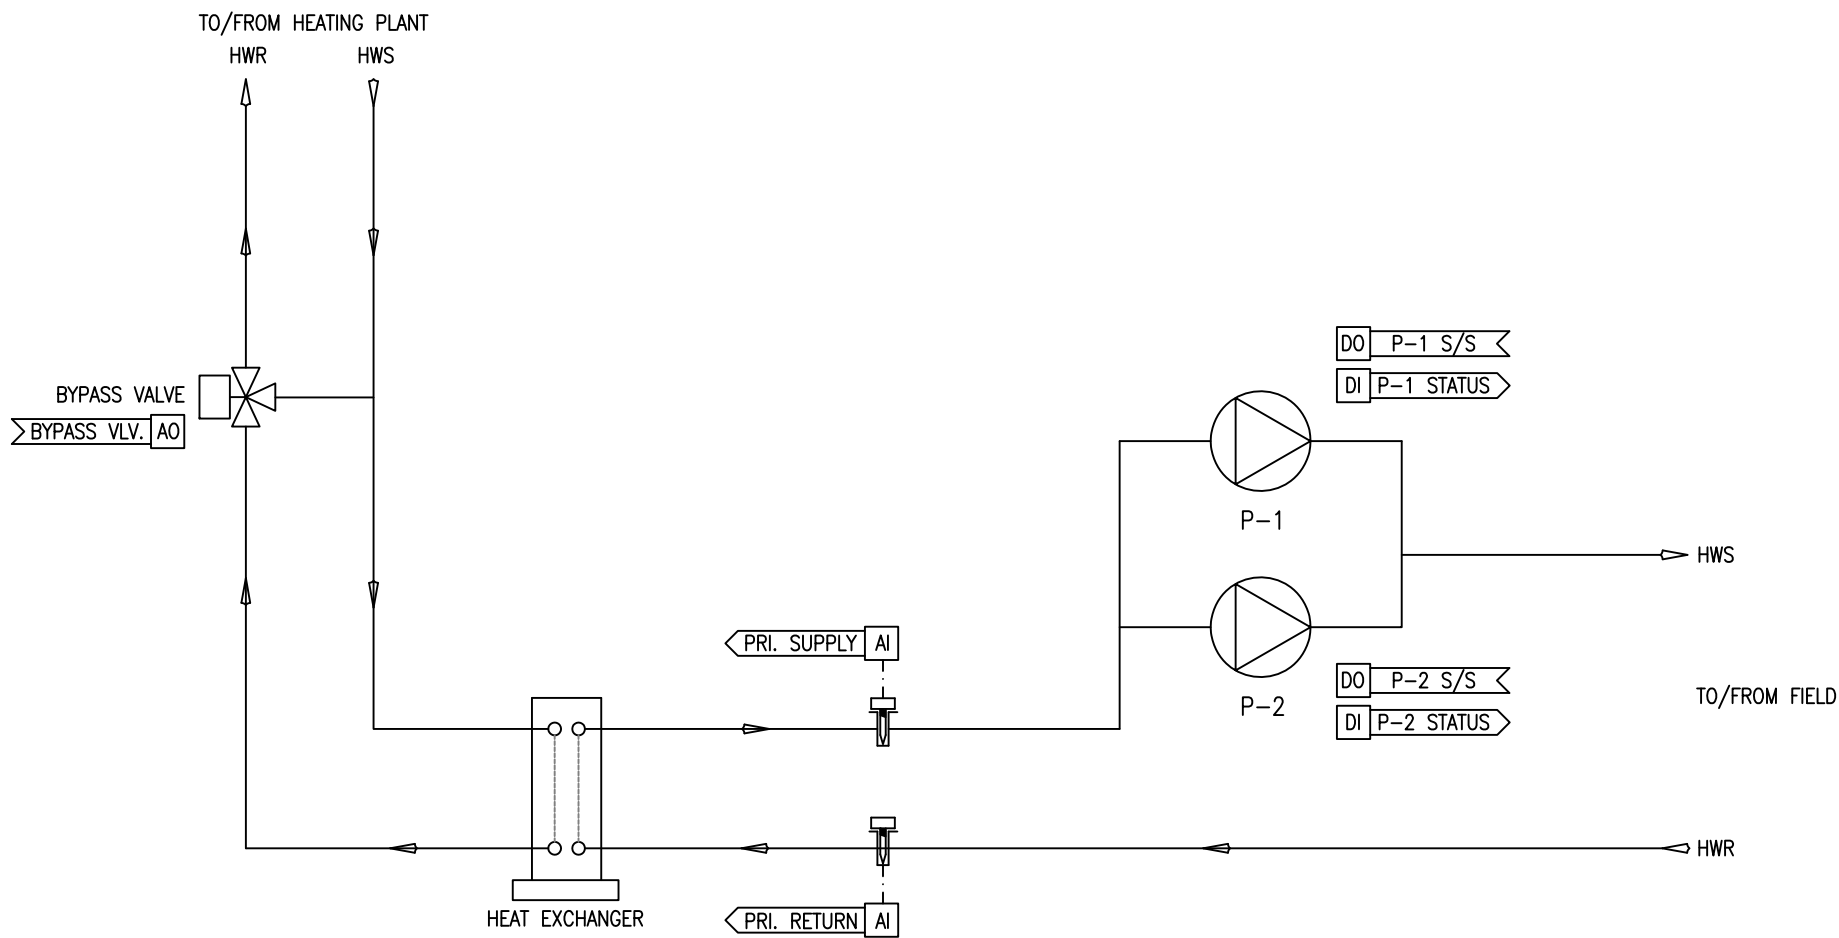

Title			FIELD HEATING UPGRADE Flow Diagram			
Project/Location			M&T BANK STADIUM (RAVENS) MARYLAND STADIUM AUTHORITY PROJECT			
			45150 Business Court Suite 100 Sterling, Virginia 20166 Tel. (703) 471-6310 Fax (703) 471-3919			
PM: EK		Engineer: BH				
Asbuilt 11/22/10	Job # 4828	Dwg. Name 4.3 RAVENS_Field_Heating_Flow				


ECM-8E: HEATING CONTROLS UPGRADE AT RAVENS STADIUM

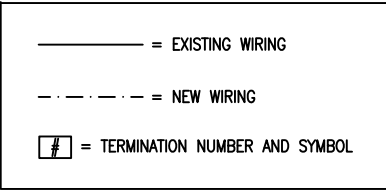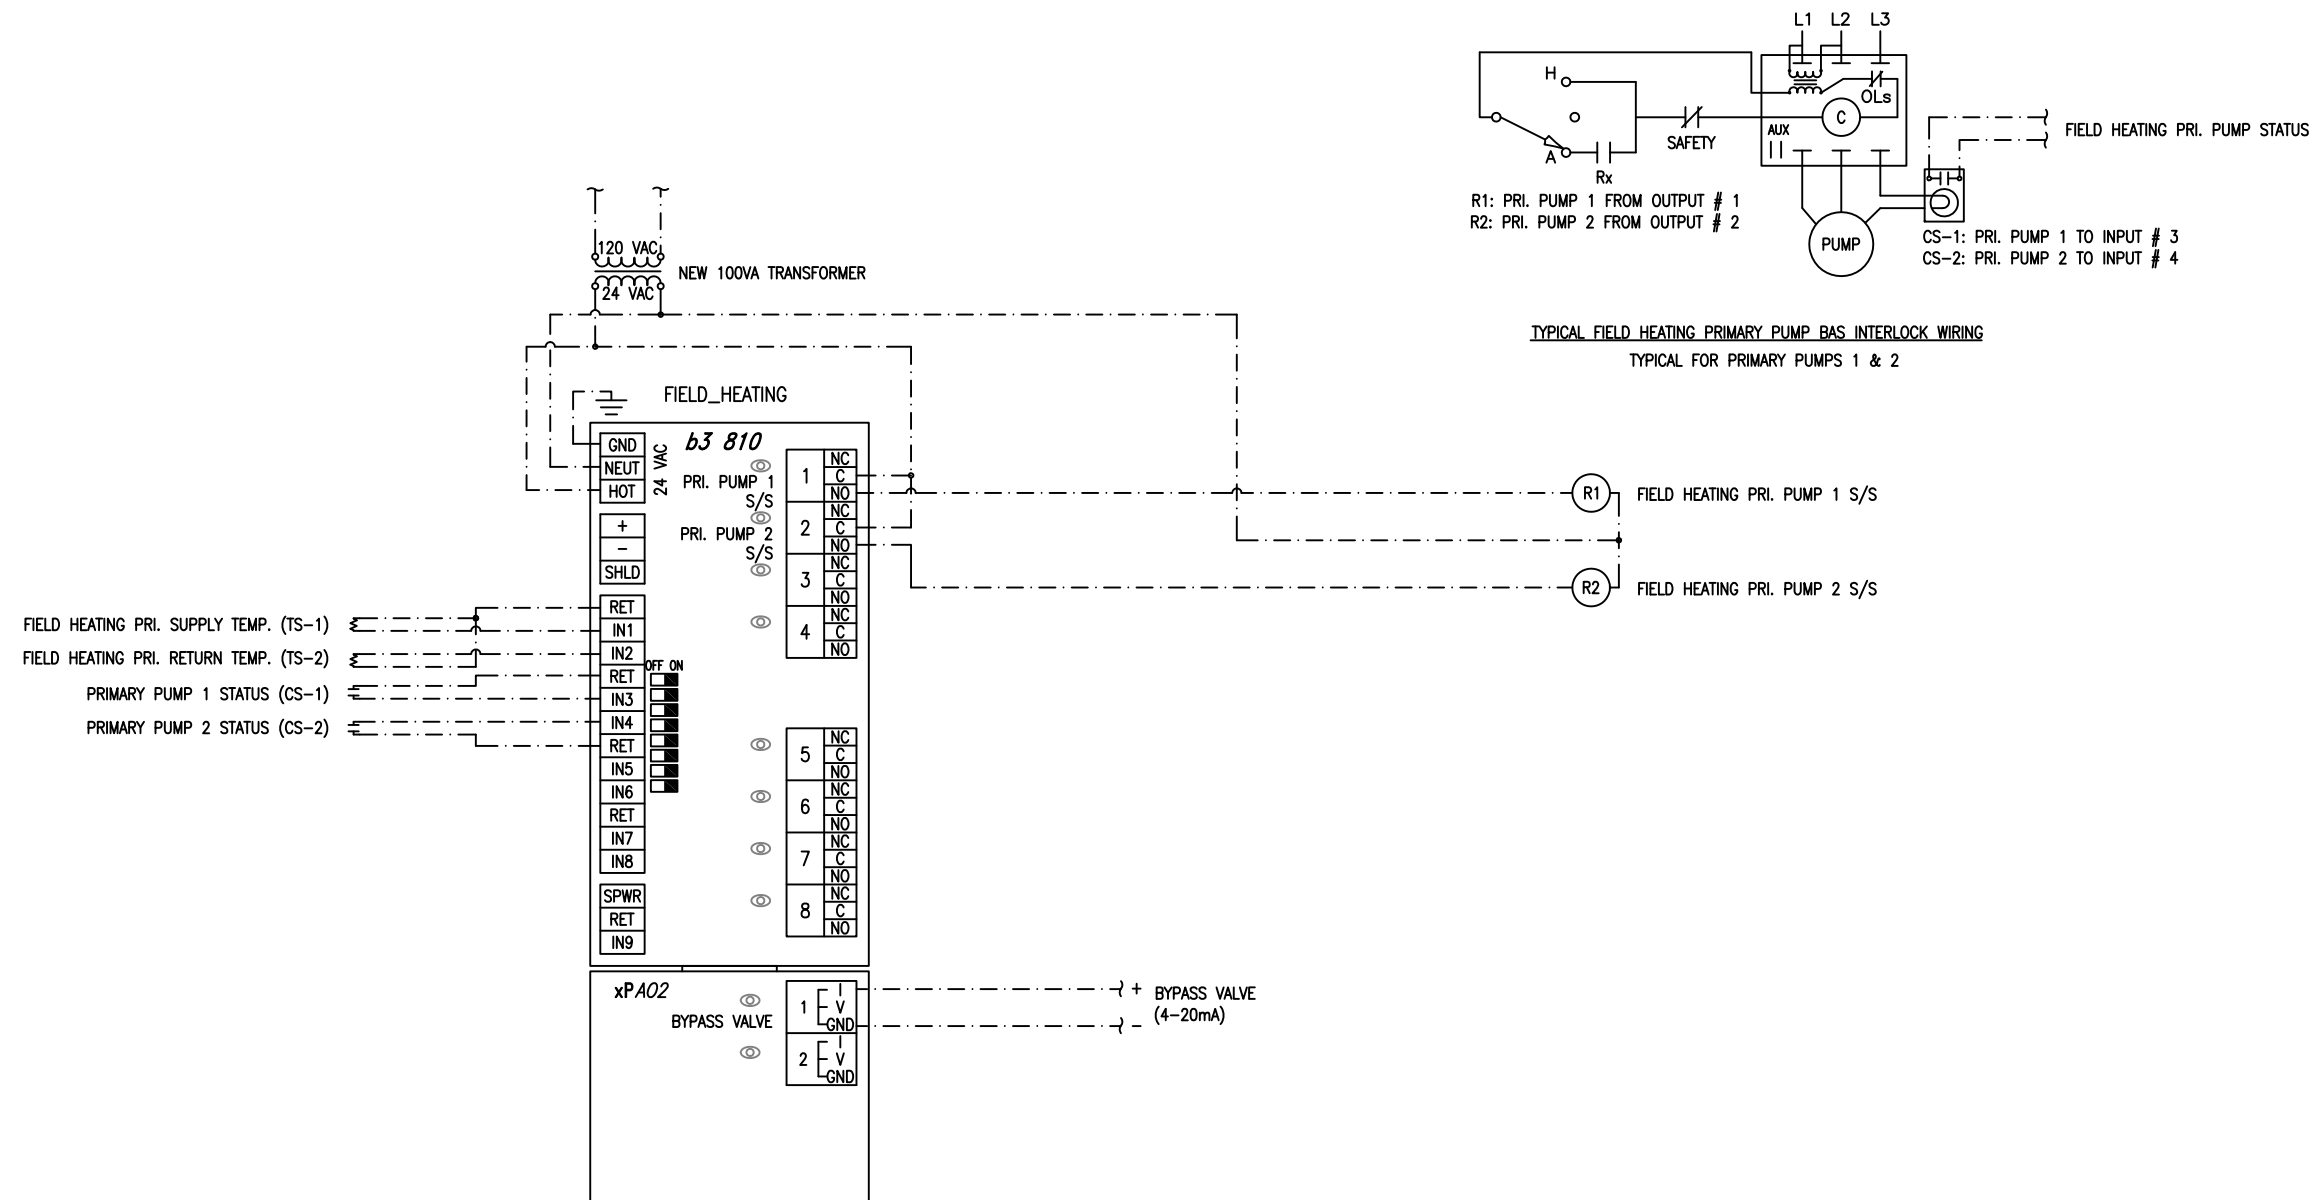

Tag	Qty.	Mfg.	Model	Range	Description
TS-1,2	2	Mamac	TE-703-C-7-A-2	-40°F to 210°F ±	Immersion temperature sensor, 4", 1/4" NPT thread adapter
"	1	Mamac	A-500-1-B-2	-	Thermowell, 4" stainless steel, 1/4" NPT internal, 1/2" NPT external
CS-1,2	2	Mamac	CT-810	1.0-200A adj.	Solid core adjustable setpoint current switch, max 150A continuous
R-1,2	2	Veris	V100	10amp @ 277vac	24vac SPDT relay w/ LED.


Title		FIELD HEATING UPGRADE Hardwired Points	
Project/Location		M&T BANK STADIUM (RAVENS) MARYLAND STADIUM AUTHORITY PROJECT	
ESI engineered services inc		45150 Business Court Suite 100 Sterling, Virginia 20166 Tel. (703) 471-6310 Fax (703) 471-3919	
PM: EK		Engineer: BH	
Asbuilt 11/22/10	Job # 4828	Dwg. Name 4.4 RAVENS_Field_Heating_Wire	

ECM-8E CO#2: CHANGE ORDER TO ADD 3 VALVES TO M&T HW SYSTEM

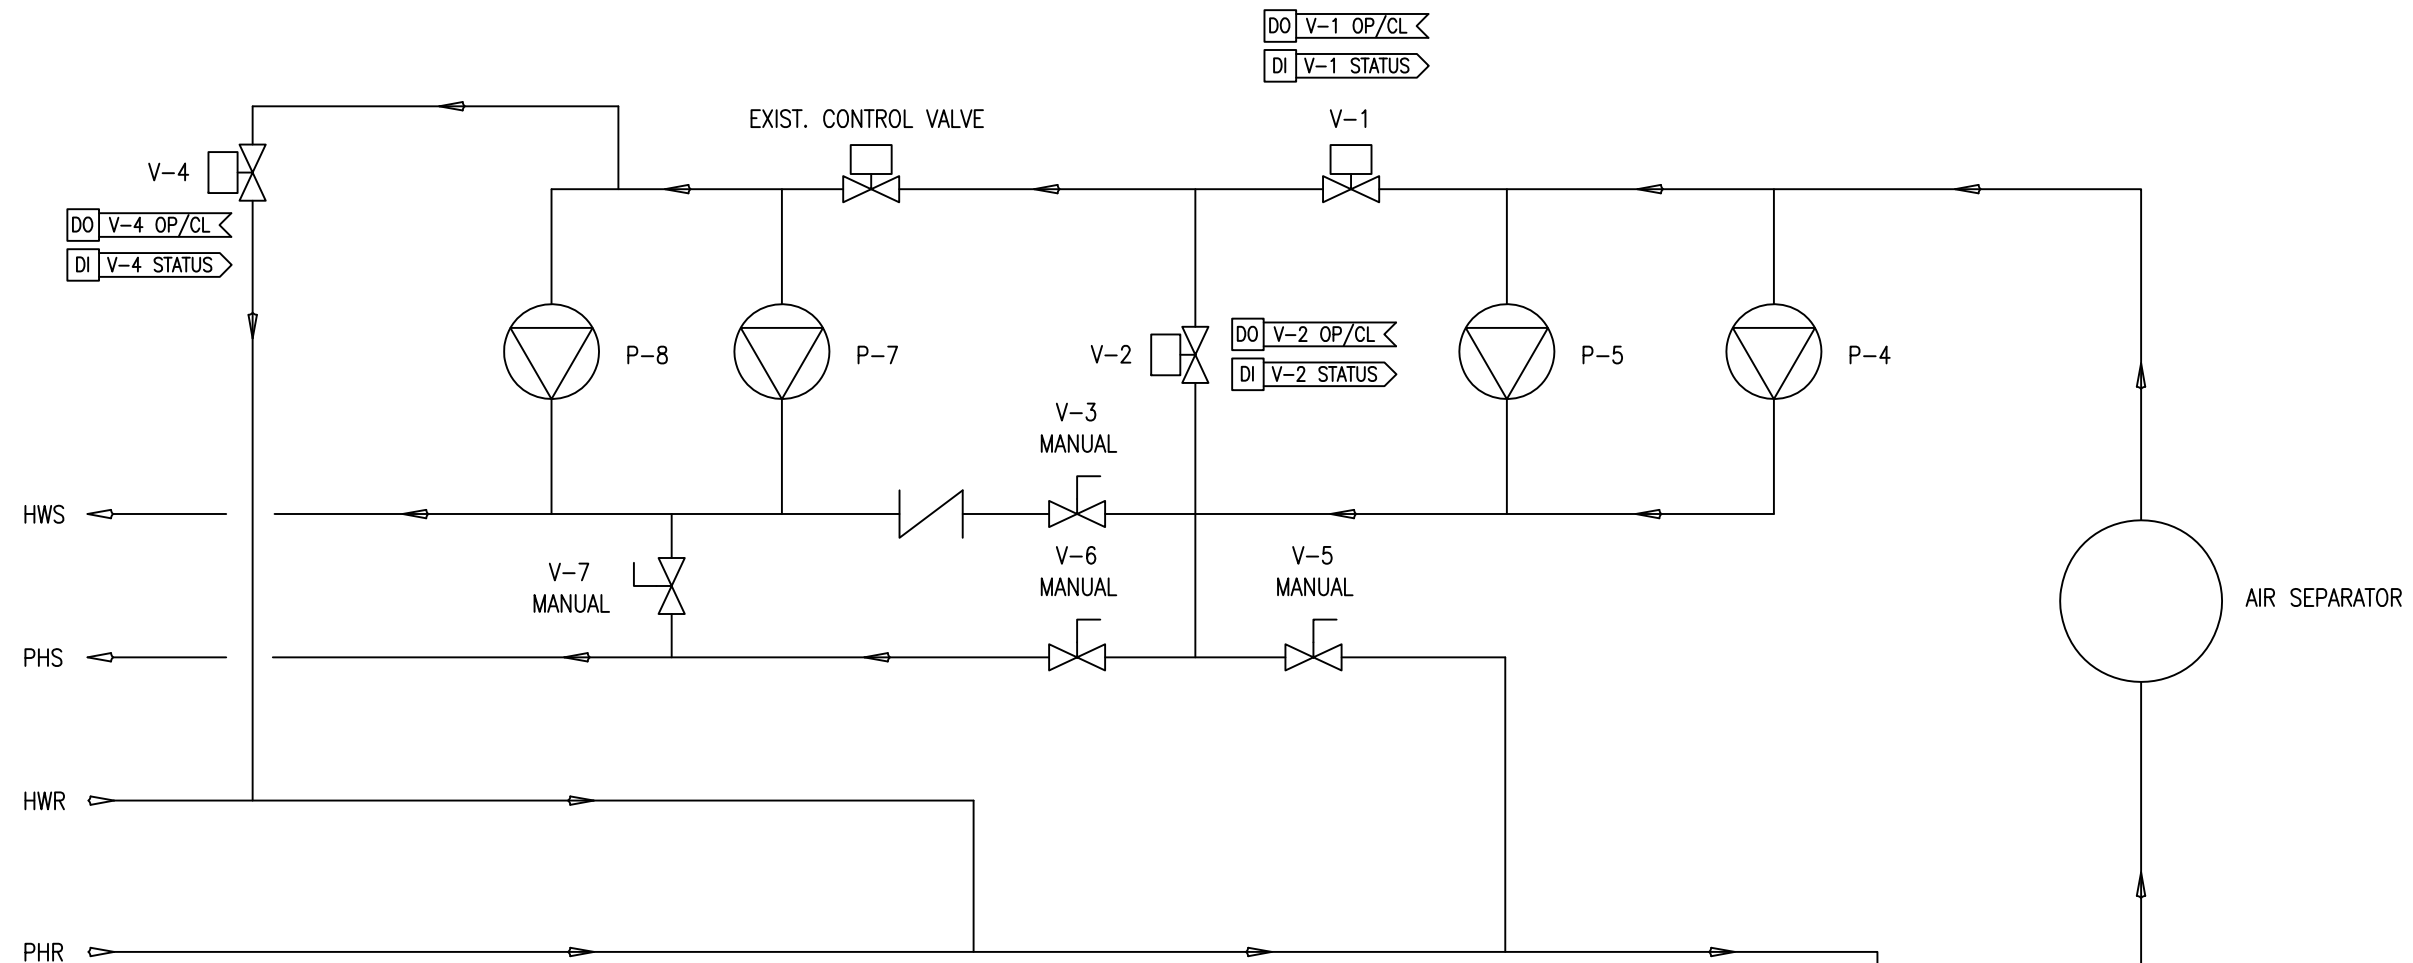


HEATING MODES OF OPERATION, VALVE CHART

VALVE	TYPE	NORMAL OPERATION	NORMAL OPERATION W/ FIELD HEATING	PRIMARY PUMP BYPASS	PRIMARY PUMP BYPASS W/ FIELD HEATING	SECONDARY PUMP BYPASS	SECONDARY PUMP BYPASS W/ FIELD HEATING
V-1	AUTOMATIC	CLOSED	CLOSED	OPEN	OPEN	CLOSED	CLOSED
V-2	AUTOMATIC	OPEN	OPEN	CLOSED	CLOSED	CLOSED	CLOSED
V-3	MANUAL	CLOSED	CLOSED	CLOSED	2 CLOS ED	OPEN	OPEN
V-4	AUTOMATIC	OPEN	OPEN	CLOSED	CLOSED	CLOSED	CLOSED
EX. V-5	MANUAL	OPEN	OPEN	CLOSED	CLOSED	CLOSED	CLOSED
EX. V-6	MANUAL	CLOSED	OPEN	CLOSED	OPEN	CLOSED	OPEN
V-7	MANUAL	CLOSED	CLOSED	CLOSED	OPEN	CLOSED	CLOS ED

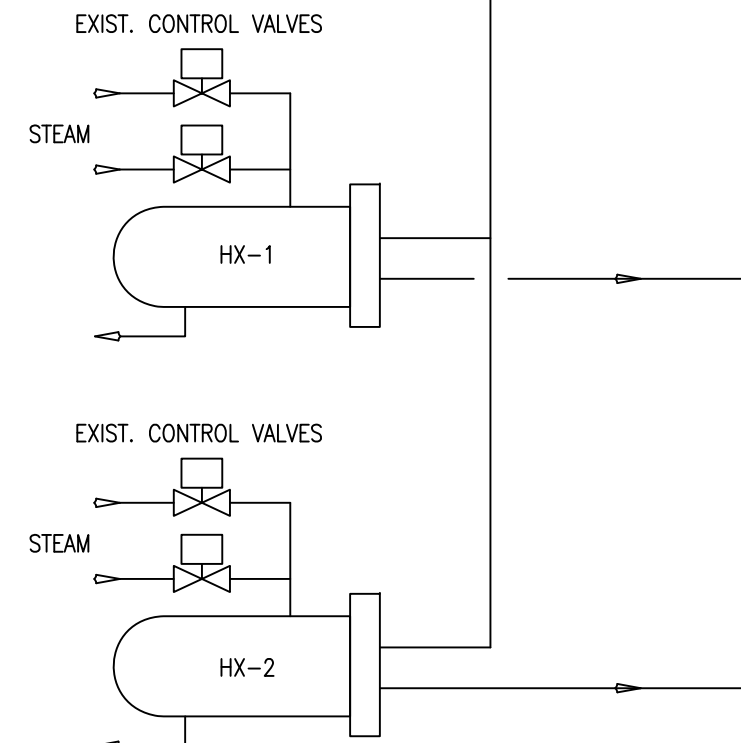


Title HEATING WATER PLANT Flow Diagram		
Project/Location M&T BANK STADIUM (RAVENS) MARYLAND STADIUM AUTHORITY PROJECT		
ESI engineered services inc 45150 Business Court Suite 100 Sterling, Virginia 20166 Tel. (703) 471-6310 Fax (703) 471-3919		
PM: EK	Engineer: BH	
Asbuilt 11/22/10	Job # 4828	Dwg. Name 4.5 HW Plant Flow Diagram

ECM-8E CO#2: CHANGE ORDER TO ADD 3 VALVES TO M&T HW SYSTEM

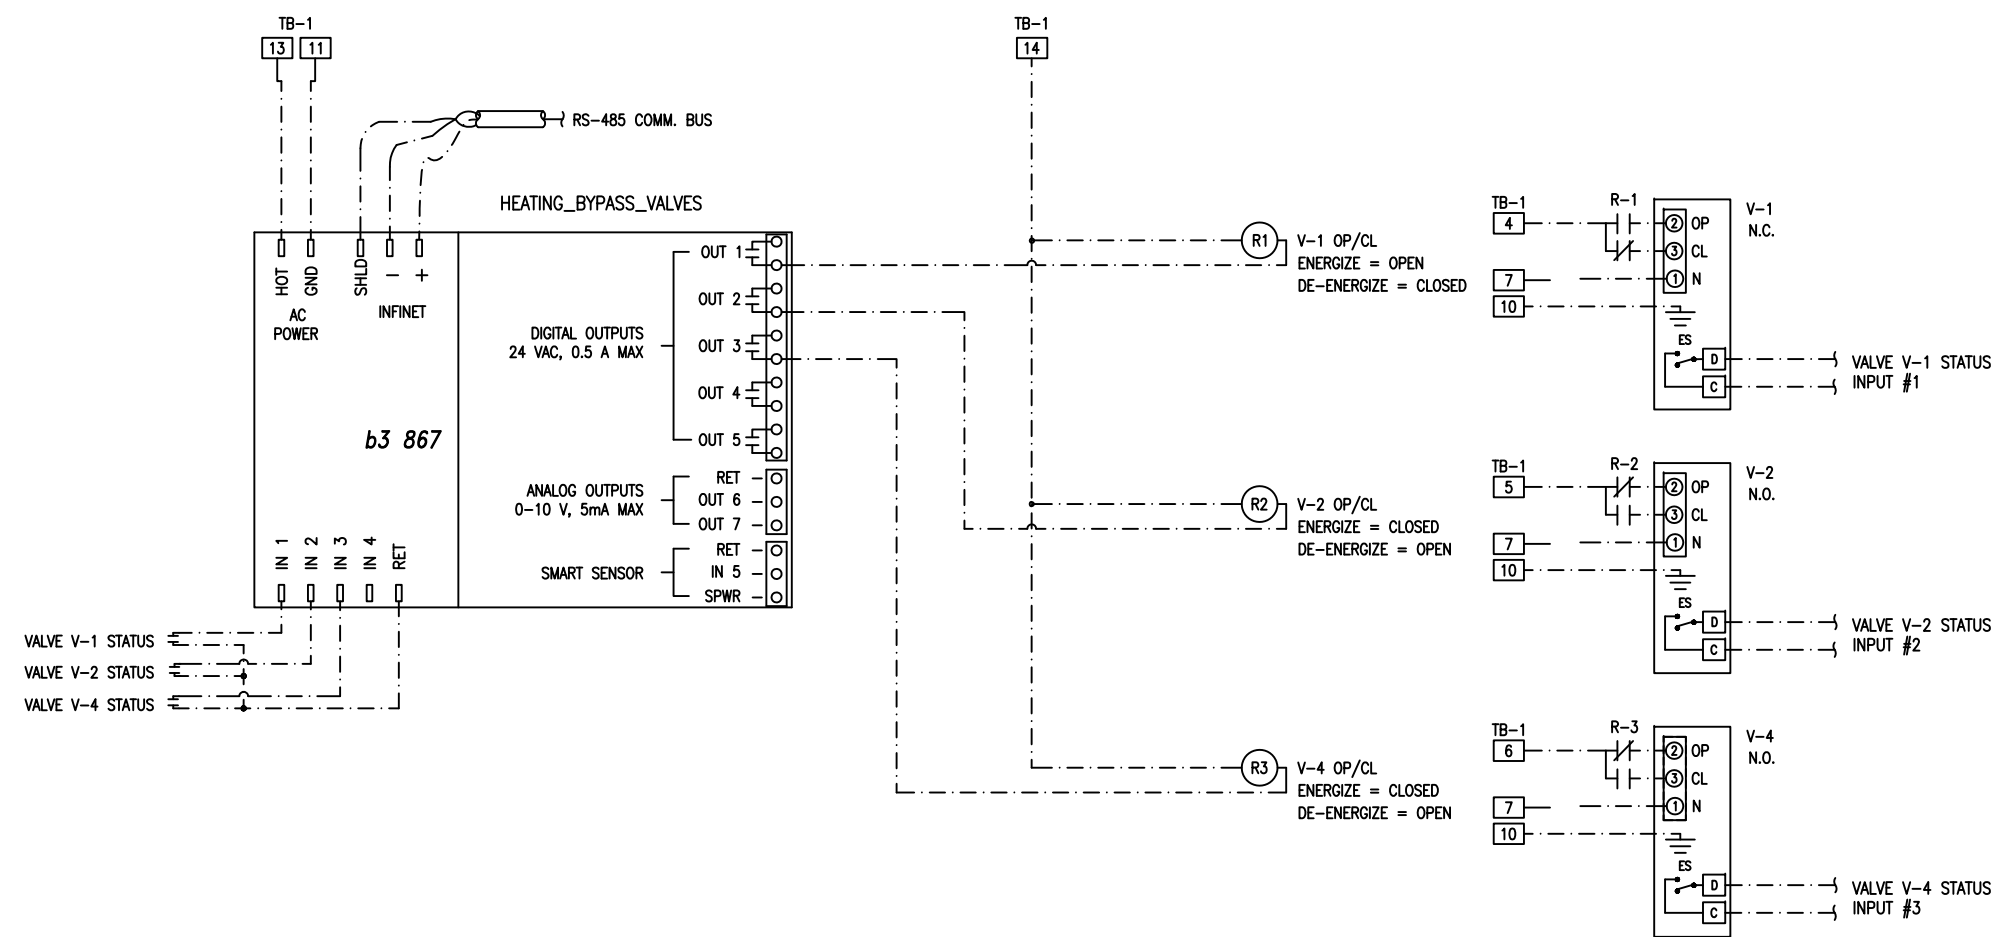

— = WIRING BY OTHERS
- - - - - = NEW WIRING
[#] = TERMINATION NUMBER AND SYMBOL

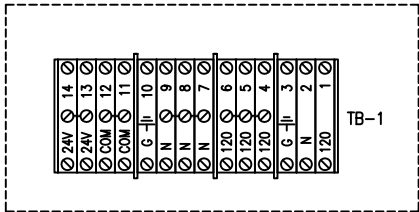


SEE PANEL DWG. 3.4 FOR POWER WIRING

Tag	Qty.	Mfg.	Model	Range	Description
R-1,2,3	3	Veris	V100	10amp @ 277vac	24vac SPDT relay w/ LED.
V-1,2,4	3	TAC	see schedule	2-pos	2-way 120V on/off non-spring return butterfly valve

Title HEATING BYPASS VALVES Hardwired Points		
Project/Location M&T BANK STADIUM (RAVENS) MARYLAND STADIUM AUTHORITY PROJECT		
ESI engineered services inc 45150 Business Court Suite 100 Sterling, Virginia 20166 Tel. (703) 471-6310 Fax (703) 471-3919		
PM: EK	Engineer: BH	
Asbuilt 11/22/10	Job # 4828	Dwg. Name 4.6 RAVENS_Heating Byp. Valves

ECM-9D(II): DEMAND VENTILATION CONTROL ON AHUs AT RAVENS STADIUM – CONTROLLER REPLACEMENT REQUIRED

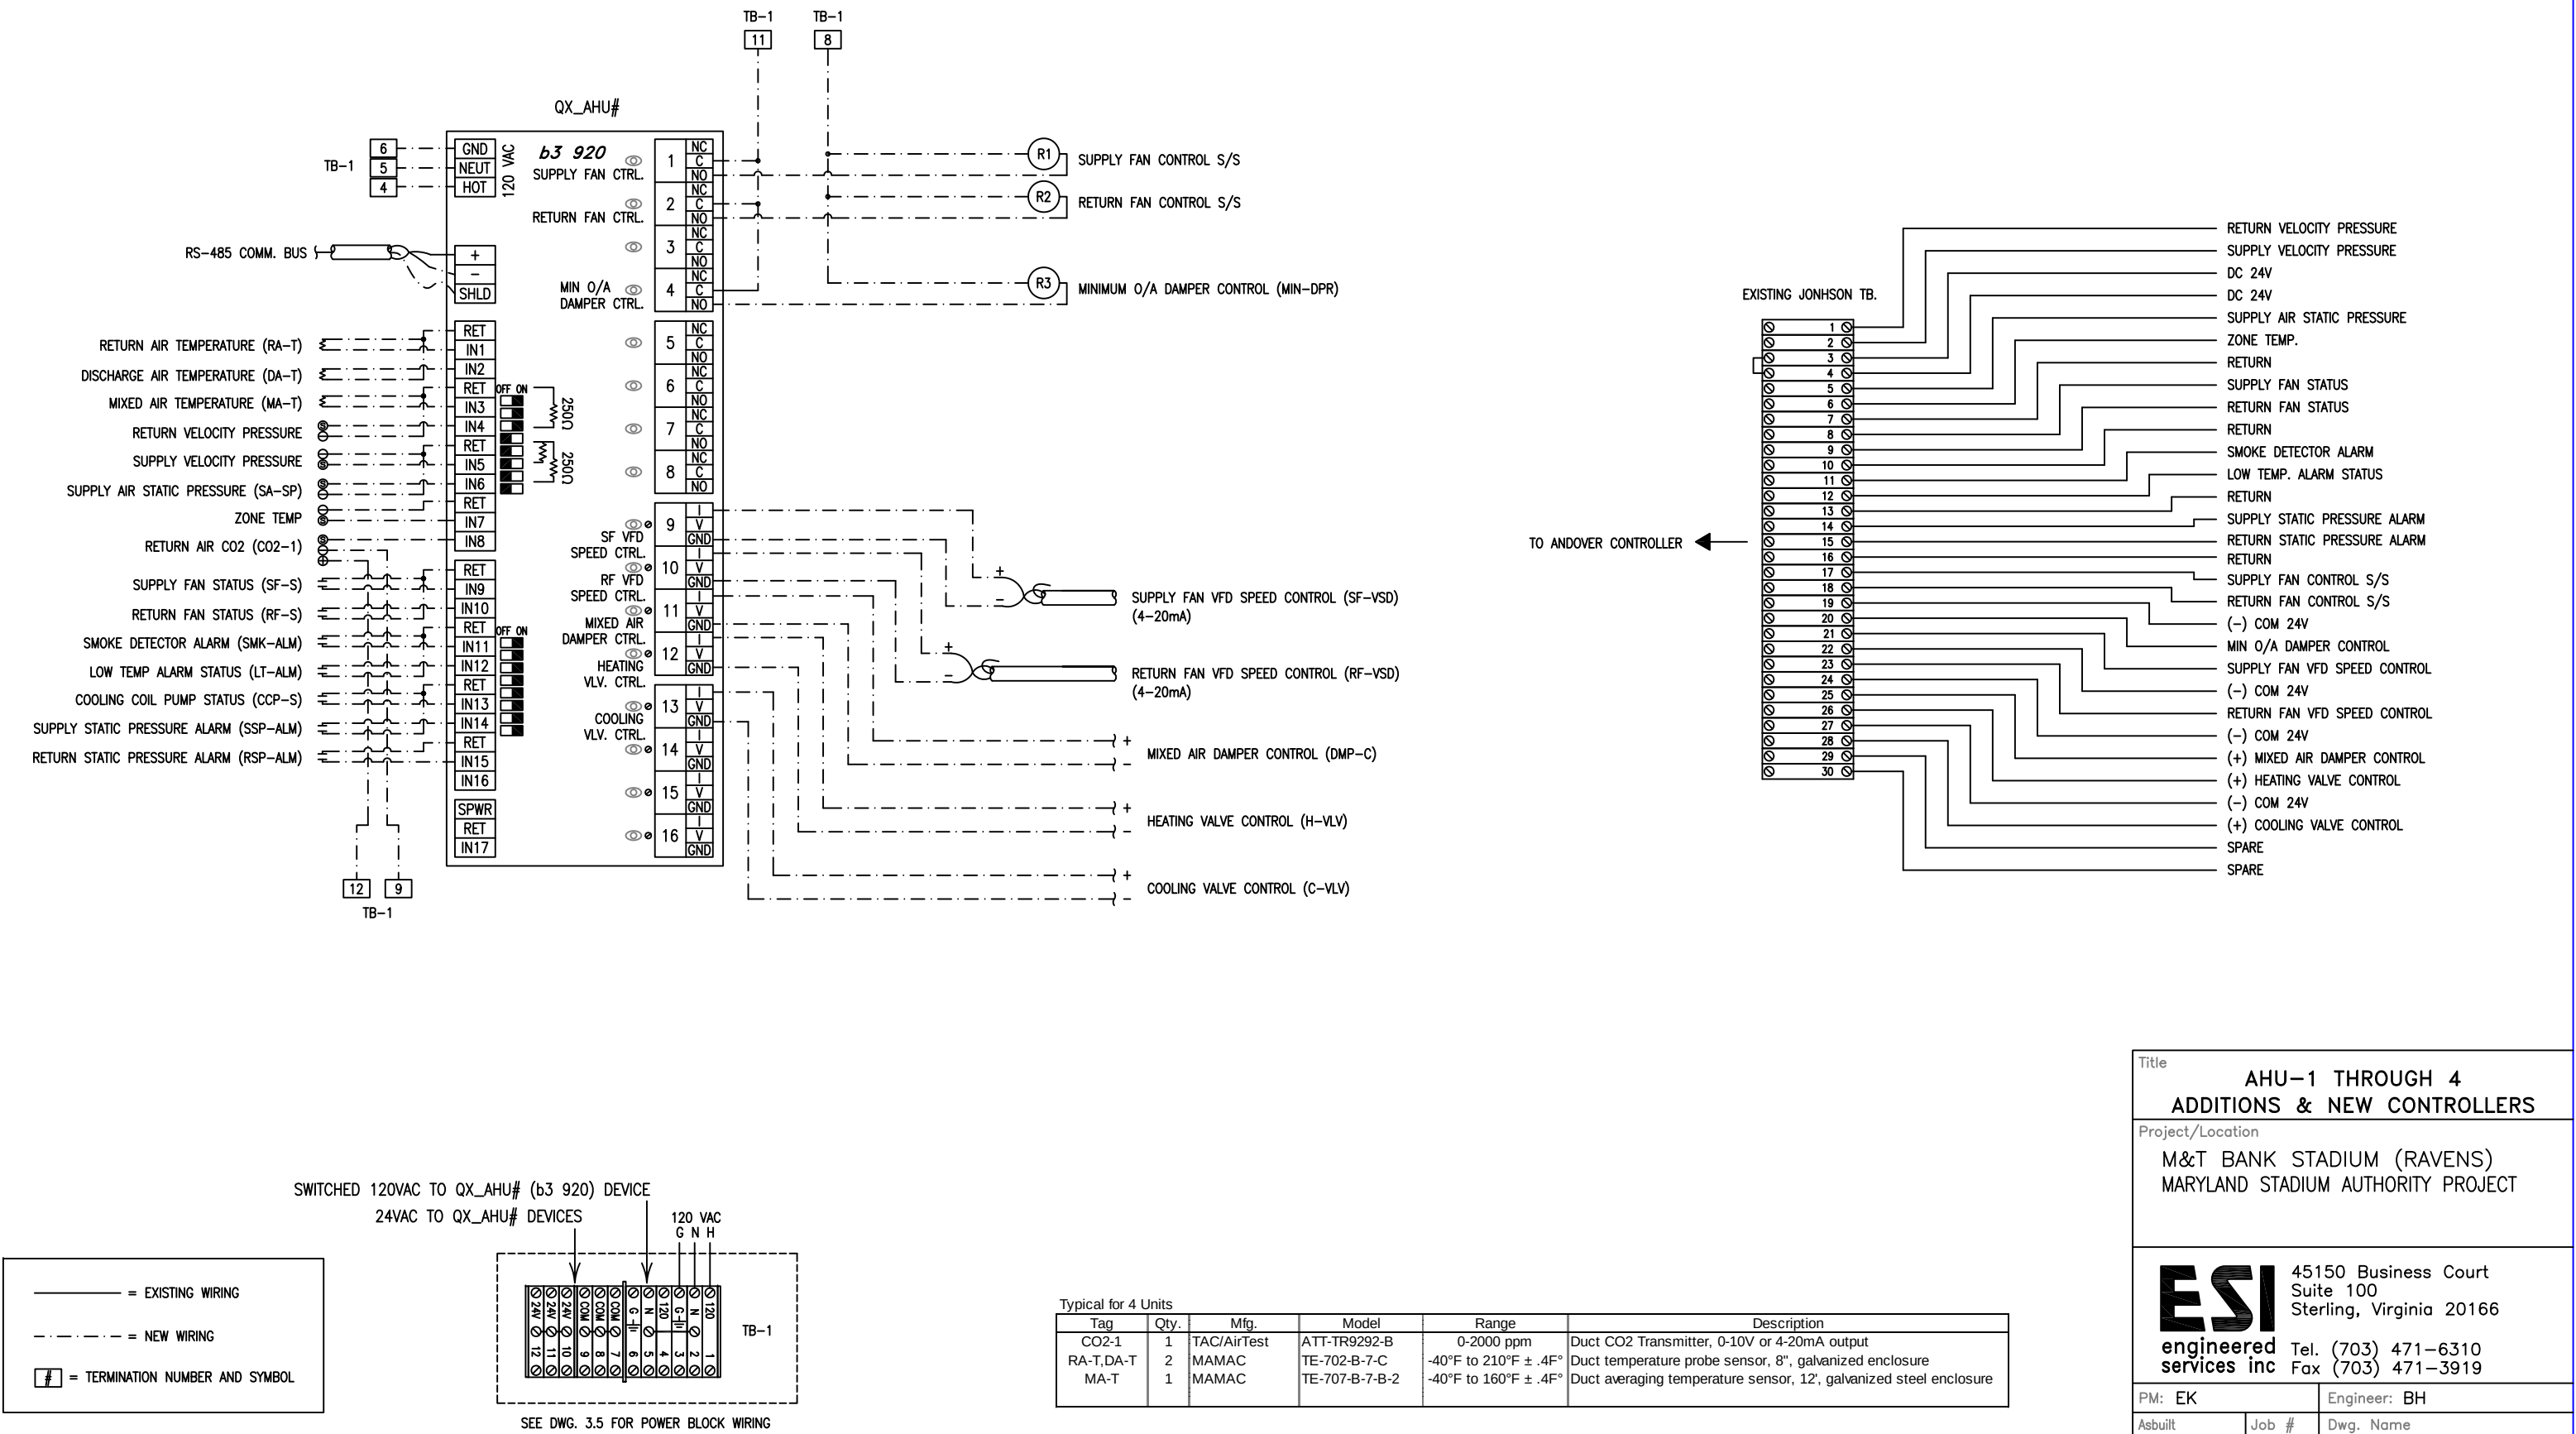

Title

AHU-1 THROUGH 4
ADDITIONS & NEW CONTROLLERS

Project/Location

M&T BANK STADIUM (RAVENS)
MARYLAND STADIUM AUTHORITY PROJECT

ESI

engineered
services inc

45150 Business Court
Suite 100
Sterling, Virginia 20166
Tel. (703) 471-6310
Fax (703) 471-3919

PM: EK


Asbuilt
11/22/10

Engineer: BH

Job #
4828

Dwg. Name
5.1 RAVENS.AHU_UNIT_1-4_Add

ECM-9D(II): DEMAND VENTILATION CONTROL ON AHUs AT RAVENS STADIUM – CONTROLLER REPLACEMENT REQUIRED

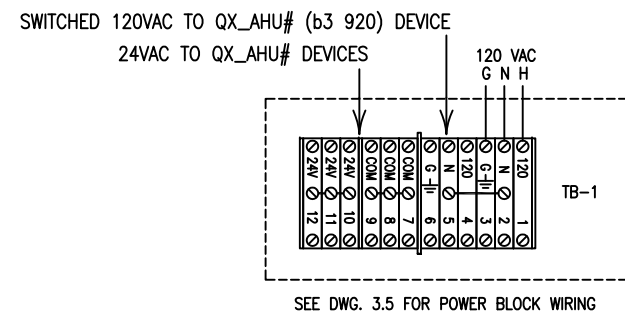

RAVENS.AHU_9 VFD Add					
Tag	Qty.	Mfg.	Model	Range	Description
CS-1,2	2	Veris	H904	3.5-135A	Split core current switch for VFDs
R-1,2	2	Veris	V100	10amp @ 277vac	24vac SPDT relay w/ LED.
CO2-1	1	TAC/AirTest	ATT-TR9292-B	0-2000 ppm	Duct CO2 Transmitter, 0-10V or 4-20mA output
RA-T,DA-T	2	MAMAC	TE-702-B-7-C	-40°F to 210°F ± .4°F	Duct temperature probe sensor, 8", galvanized enclosure
MA-T	1	MAMAC	TE-707-B-7-B-2	-40°F to 160°F ± .4°F	Duct averaging temperature sensor, 12', galvanized steel enclosure

Title		
AHU-9 ADDITIONS & NEW CONTROLLER		
Project/Location		
M&T BANK STADIUM (RAVENS) MARYLAND STADIUM AUTHORITY PROJECT		
 45150 Business Court Suite 100 Sterling, Virginia 20166 Tel. (703) 471-6310 Fax (703) 471-3919		
PM: EK		Engineer: BH
Asbuilt 11/22/10	Job # 4828	Dwg. Name 5.2 RAVENS.AHU_UNIT_9>Add

ECM-9D(II): DEMAND VENTILATION CONTROL ON AHUs AT RAVENS STADIUM

JOHNSON CONTROLS AHU CONTROLLER		
BO 1	⊖	7
24AC	⊖	8
BO 2	⊖	9
BO 3	⊖	10
24AC	⊖	11
BO 4	⊖	12
BO 5	⊖	13
24V	⊖	14
BO 6	⊖	15
BO 7	⊖	16
24AC	⊖	17
BO 8	⊖	18
BO 9	⊖	19
24AC	⊖	20
BO 10	⊖	21
+AO 1	⊖	22
-AOCM	⊖	23
+AO 2	⊖	24
+AO 3	⊖	25
-AOCM	⊖	26
+AO 4	⊖	27
+AO 5	⊖	28
-AOCM	⊖	29
+AO 6	⊖	30
BI 1	⊖	31
BICM	⊖	32
BI 2	⊖	33
BI 3	⊖	34
BICM	⊖	35
BI 4	⊖	36
BI 5	⊖	37
BICM	⊖	38
BI 6	⊖	39
BI 7	⊖	40
BICM	⊖	41
BI 8	⊖	42
+VDC	⊖	43
+AI 1	⊖	44
-AICOM	⊖	45
+AI 2	⊖	46
+AI 3	⊖	47
-AICM	⊖	48
+AI 4	⊖	49
+AI 5	⊖	50
-AICM	⊖	51
+AI 6	⊖	52
+AI 7	⊖	53
-AICM	⊖	54
+AI 8	⊖	55
+VDC	⊖	56


ANALOG INPUT JUMPER
SET TO VOLTAGE INPUT

T V C


AHU-# RETURN AIR CO2 (CO2-1)




TYPICAL FOR AHU-11 & 12

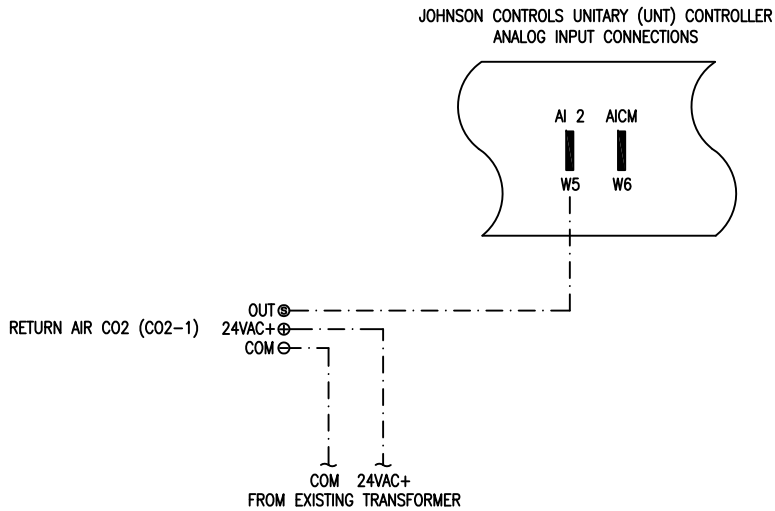


TYPICAL FOR AHU-10 & 14

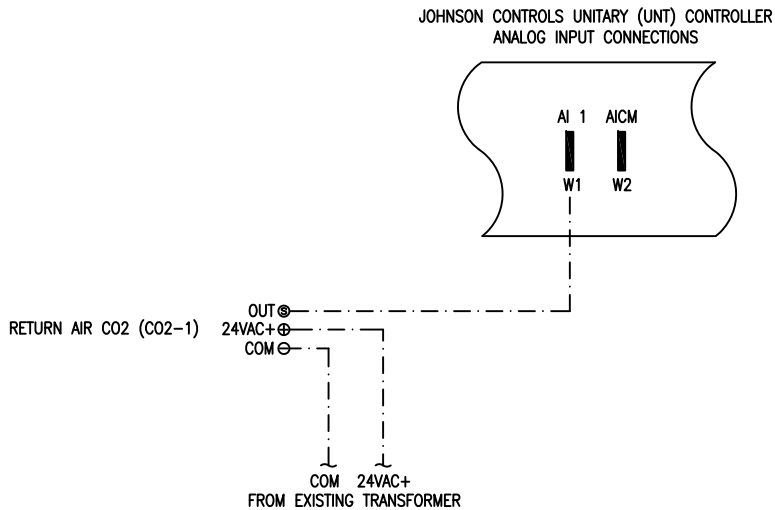

TYPICAL FOR AHU-15, 16 & 17

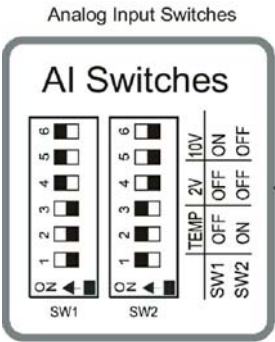

SWITCH SETTINGS:
RETURN AIR CO2 (CO2-1): SW1 TO ON, SW2 TO OFF

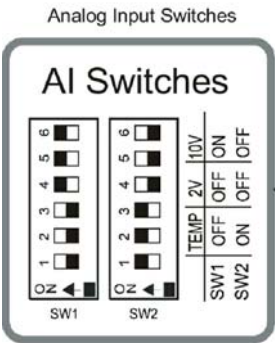

SWITCH SETTINGS:
RETURN AIR CO2 (CO2-1): SW1 TO ON, SW2 TO OFF

— = EXISTING WIRING

- - - - - = NEW WIRING

= TERMINATION NUMBER AND SYMBOL

Typical for 7 Units					
Tag	Qty.	Mfg.	Model	Range	Description
CO2-1	1	TAC/AirTest	ATT-TR9292-B	0-2000 ppm	Duct CO2 Transmitter, 0-10V or 4-20mA output

Title

AHU-10-12, 14-17
CO2 ADDITION TO EXISTING JC

Project/Location

M&T BANK STADIUM (RAVENS)
MARYLAND STADIUM AUTHORITY PROJECT

ESI

engineered
services inc

45150 Business Court
Suite 100
Sterling, Virginia 20166
Tel. (703) 471-6310
Fax (703) 471-3919

PM: EK


Asbuilt
11/22/10

Engineer: BH

Job #
4828

Dwg. Name
5.3 RAV.AHU_10-12_14-17_CO2

ECM-9E(II): CONVERT RAVENS STADIUM MAIN KITCHEN HOODS TO VARIABLE VOLUME



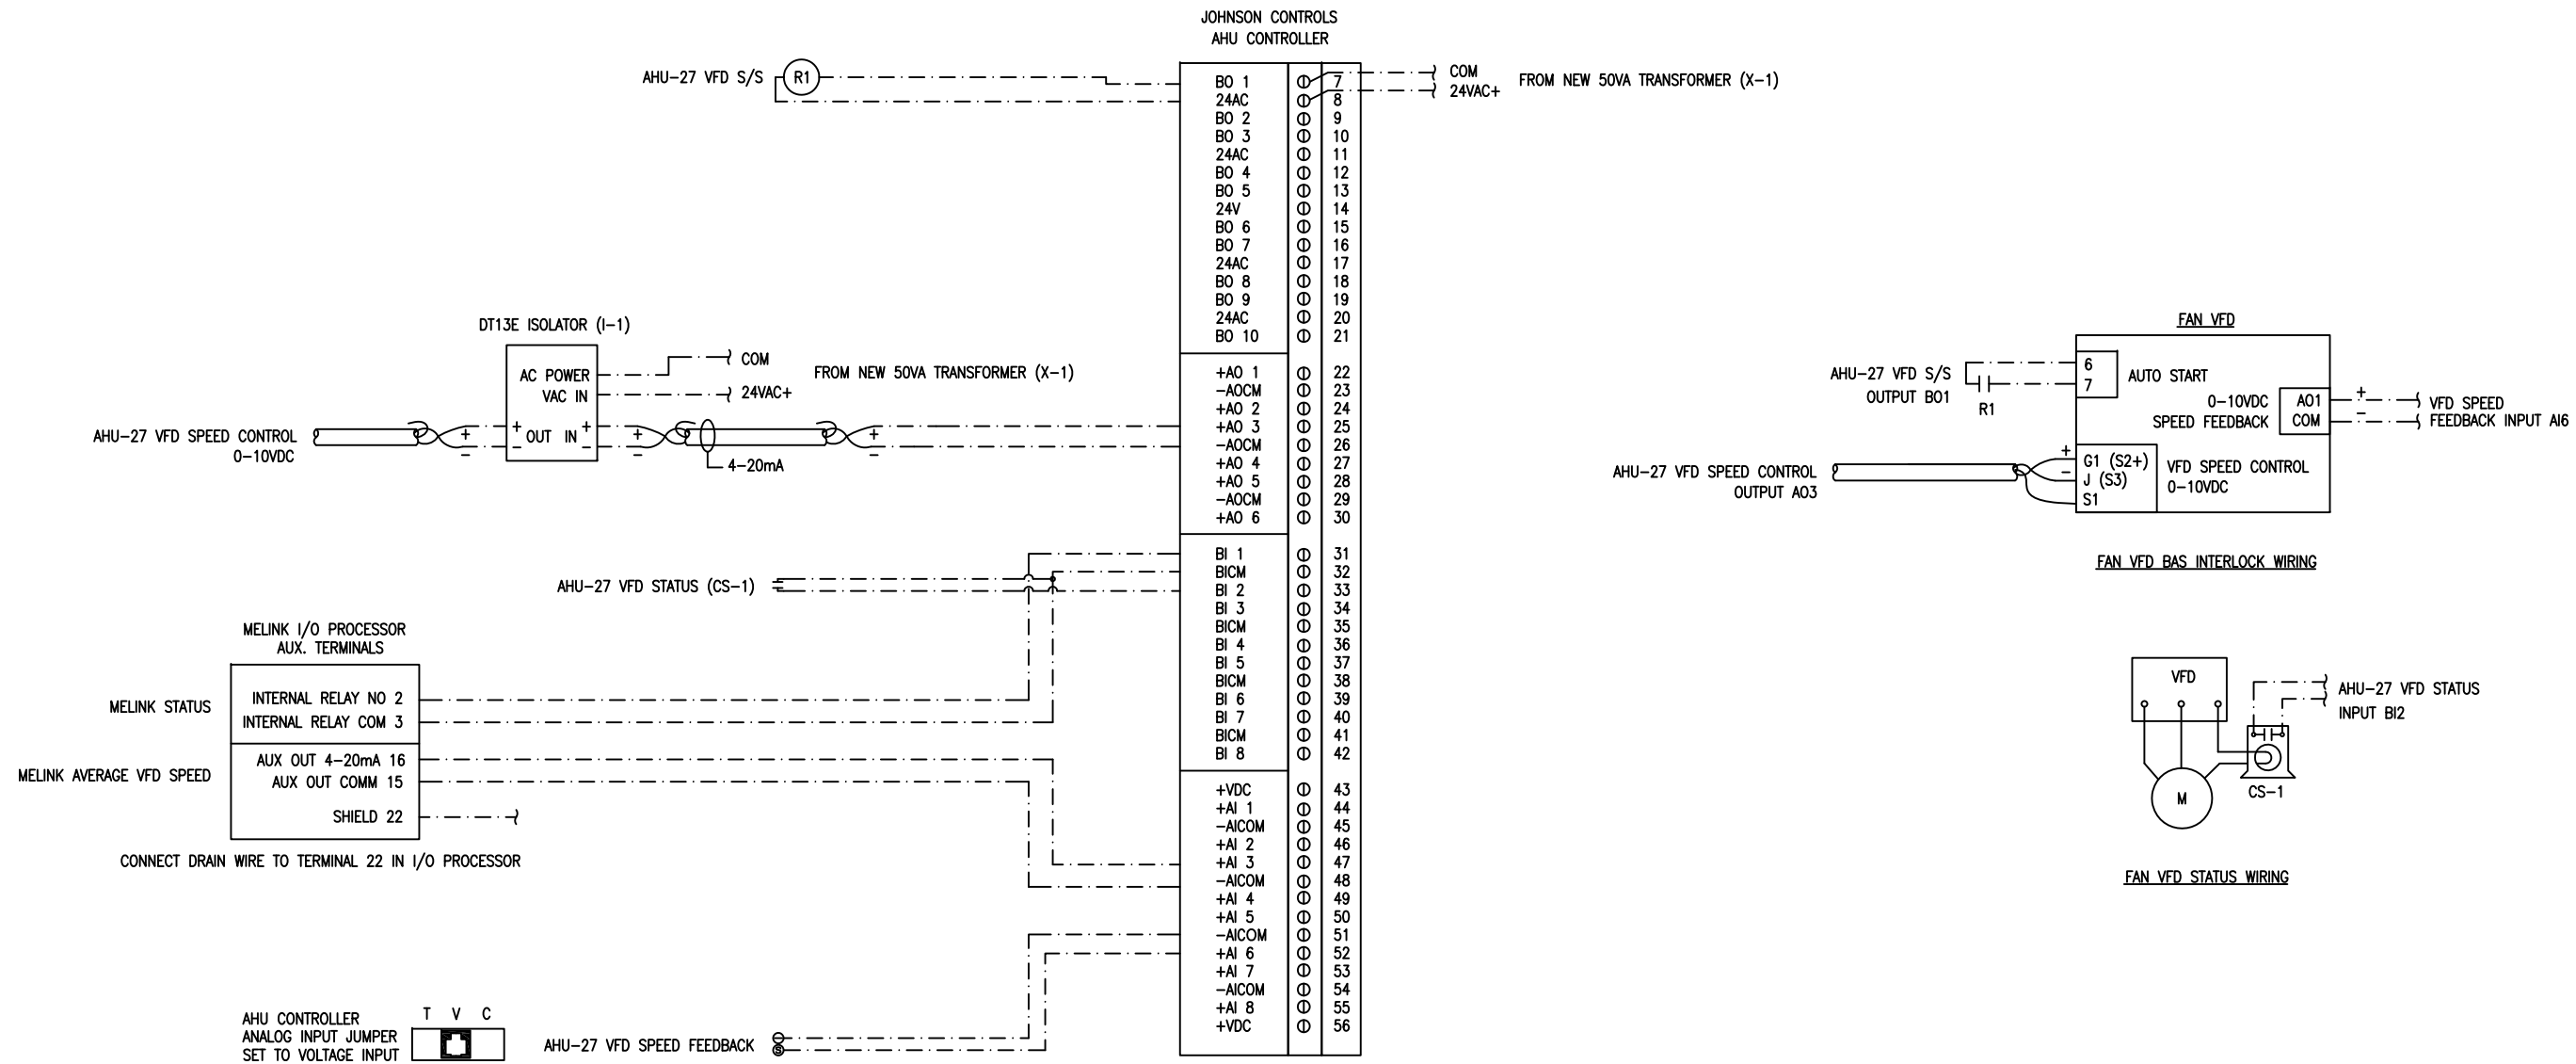


Tag	Qty.	Mfg.	Model	Range	Description
CS-1	1	Veris	H904	3.5-135A	Split core current switch for VFDs
R-1	1	Veris	V100	10amp @ 277vac	24vac SPDT relay w/ LED.
X-1	1	Veris	X050CBA	120/240/277/480V~	Control transformer, 50 VA, w/ circuit breaker
I-1	1	Kele	DT13E-24	-	Isolated DC to DC Transmitter

Title			AHU-27		
VFD & MELINK ADD. TO EXISTING JC					
Project/Location			M&T BANK STADIUM (RAVENS) MARYLAND STADIUM AUTHORITY PROJECT		
			45150 Business Court Suite 100 Sterling, Virginia 20166 Tel. (703) 471-6310 Fax (703) 471-3919		
PM: EK			Engineer: BH		
Asbuilt 11/22/10	Job # 4828	Dwg. Name 5.4 RAVENS.AHU-27_Add			

ECM-9G: EMCS CONTROL OF EXHAUST FANS AT RAVENS STADIUM

Unit #	Service	Level
VF-9	North Mech. Rm. A	Service - A

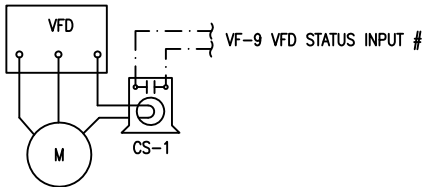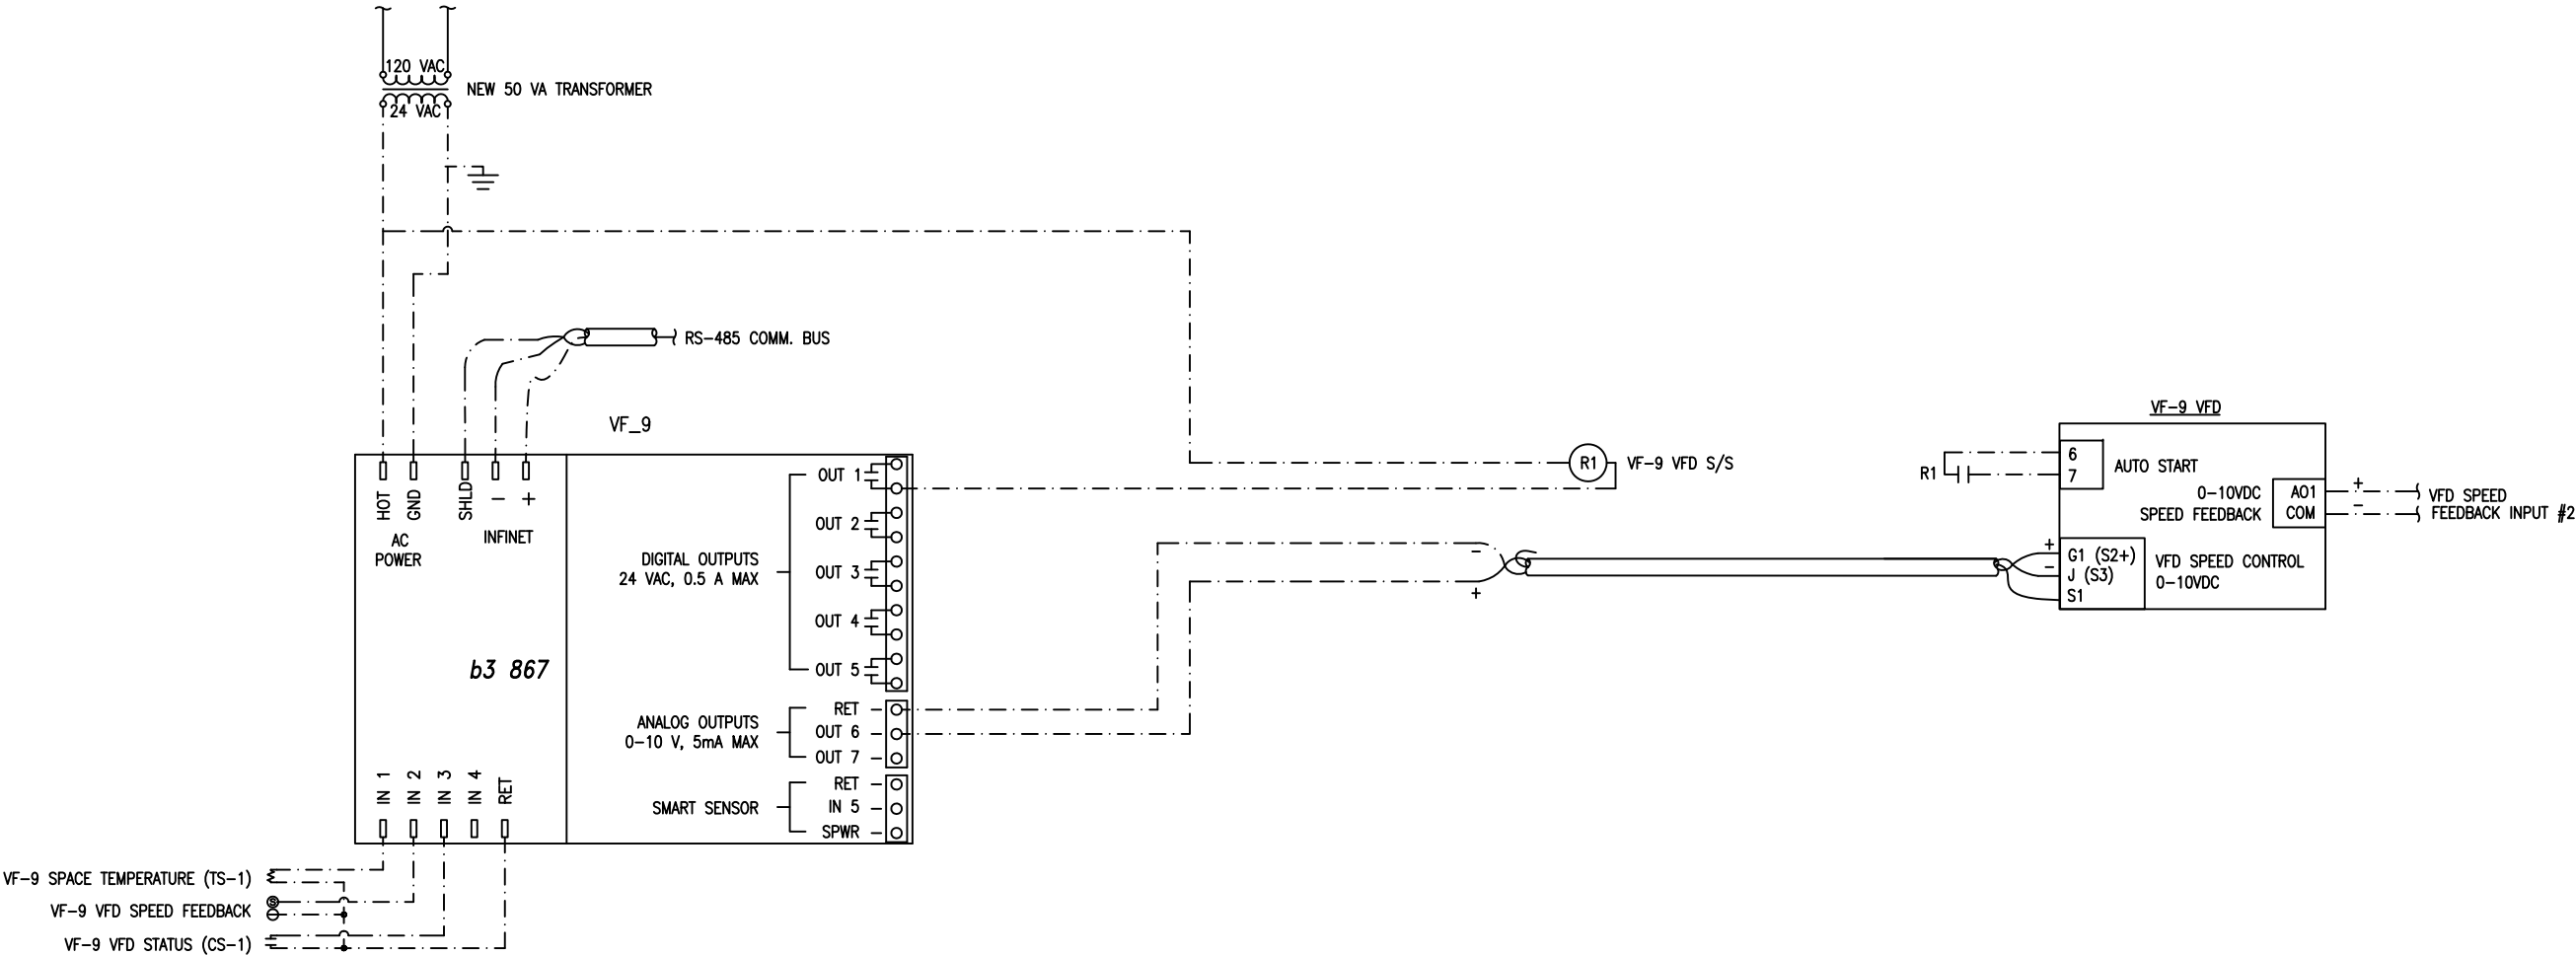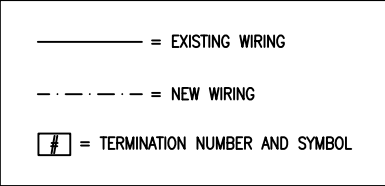

VF-9 VFD FAN STATUS WIRING

SEE DWG. 3.6 FOR PANEL LAYOUT AND BILL OF MATERIALS


Tag	Qty.	Mfg.	Model	Range	Description
TS-1	1	Mamac	TE-205-EX-7-0	32°F to 158°F	Space temp. sensor
R-1	1	Veris	V100	10amp @ 277vac	24vac SPDT relay w/ LED.
CS-1	1	Veris	H904	3.5-135A	Split core current switch for VFDs

Title VF-9 VFD Hardwired Points		
Project/Location M&T BANK STADIUM (RAVENS) MARYLAND STADIUM AUTHORITY PROJECT		
ESI engineered services inc 45150 Business Court Suite 100 Sterling, Virginia 20166 Tel. (703) 471-6310 Fax (703) 471-3919		
PM: EK		Engineer: BH
Asbuilt 11/22/10	Job # 4828	Dwg. Name 6.1 RAVENS VF-9 VFD Wiring

ECM-9G: EMCS CONTROL OF EXHAUST FANS AT RAVENS STADIUM

— = EXISTING WIRING
- - - - = NEW WIRING
= TERMINATION NUMBER AND SYMBOL

Unit #	Service	Level
VF-11	South Mech. Rm. B	Service - B
VF-12	South Mech. Rm. B	Service - B
VF-13	South Mech. Rm. B	Service - B

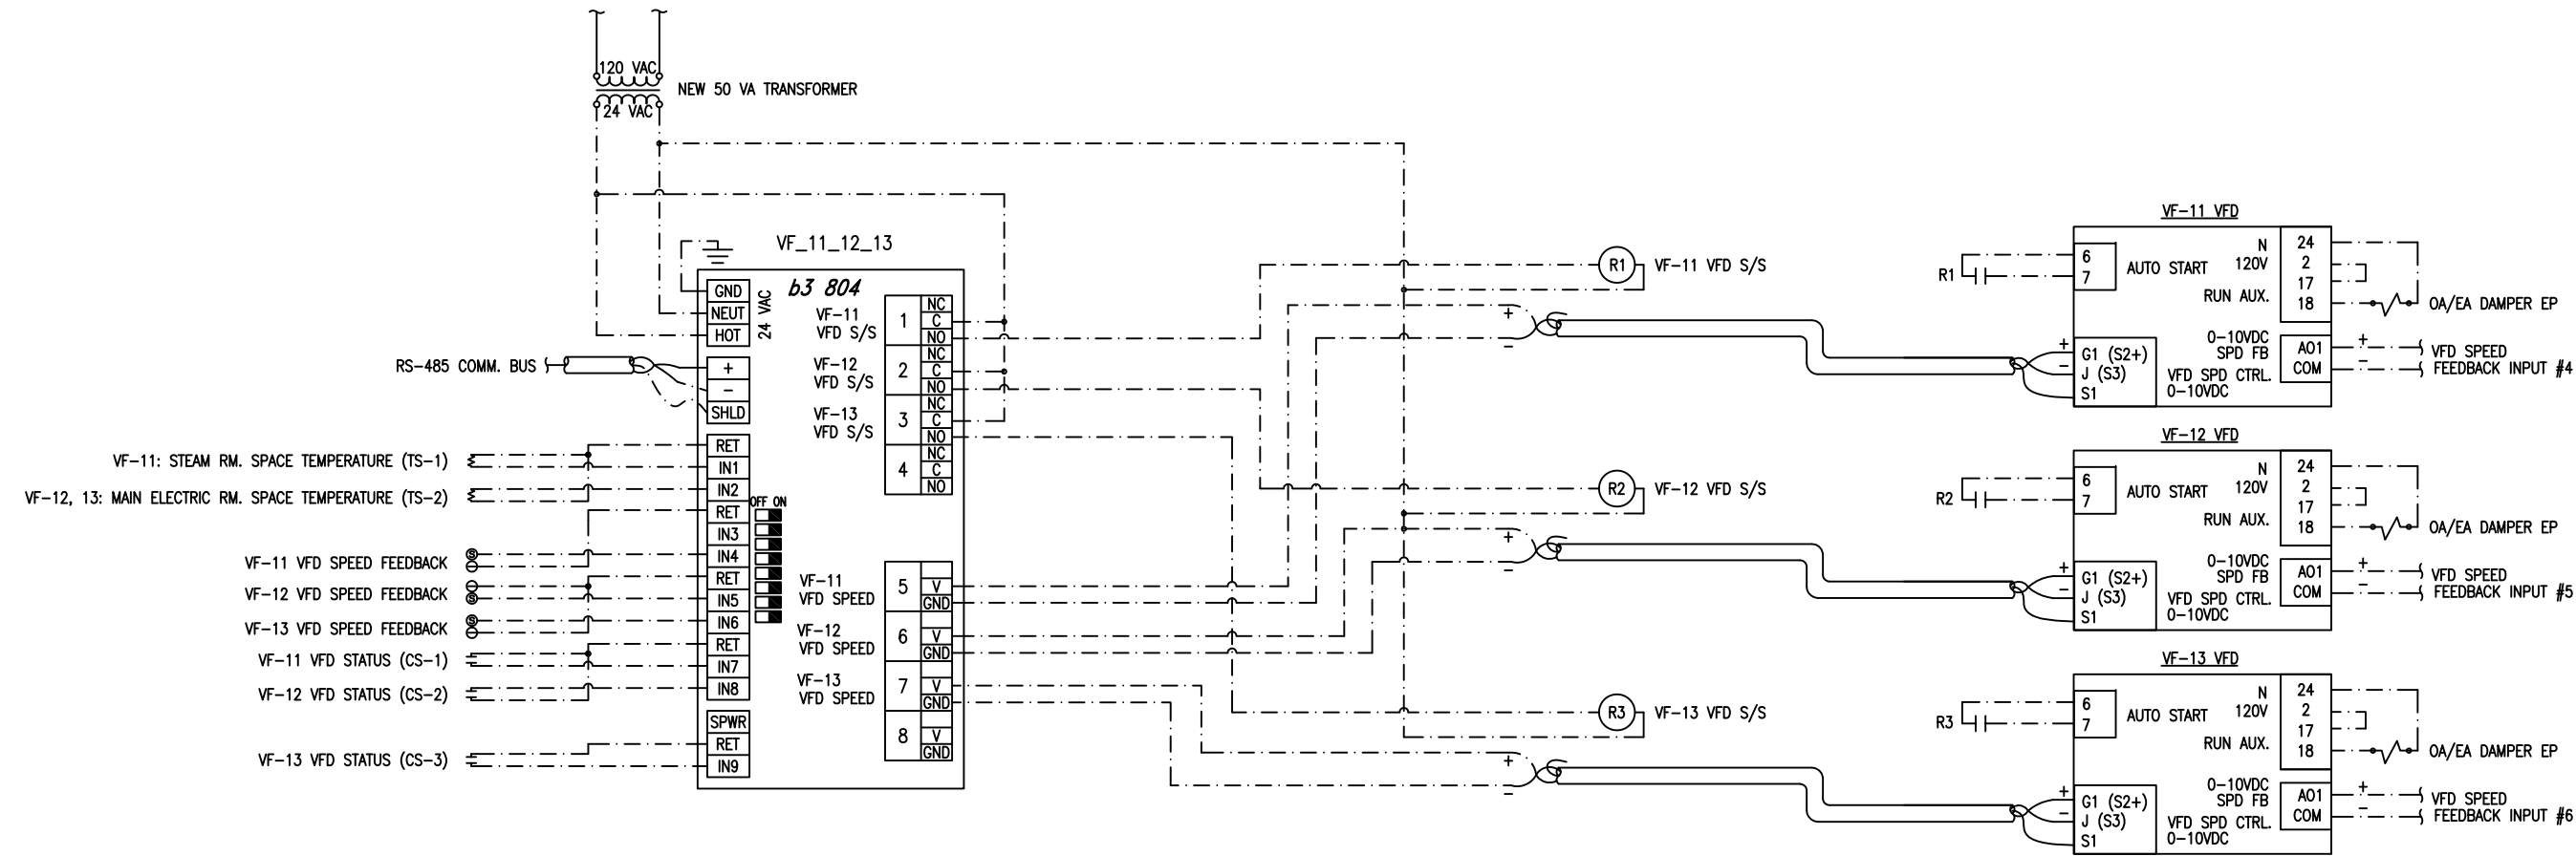

VF-# VFD FAN STATUS WIRING- TYPICAL OF 3 VFDs (VF-11,12,13)




SEE DWG. 3.7 FOR PANEL LAYOUT AND BILL OF MATERIALS

Tag	Qty.	Mfg.	Model	Range	Description
TS-1,2	2	Mamac	TE-205-EX-7-0	32°F to 158°F	Space temp. sensor
R-1,2,3	3	Veris	V100	10amp @ 277vac	24vac SPDT relay w/ LED.
CS-1,2,3	3	Veris	H904	3.5-135A	Split core current switch for VFDs

Title VF-11,12,13 VFD Hardwired Points		
Project/Location M&T BANK STADIUM (RAVENS) MARYLAND STADIUM AUTHORITY PROJECT		
ESI engineered services inc 45150 Business Court Suite 100 Sterling, Virginia 20166 Tel. (703) 471-6310 Fax (703) 471-3919		
PM: EK		Engineer: BH
Asbuilt 11/22/10	Job # 4828	Dwg. Name 6.2 RAVENS VF-11,12,13 VFD

ECM-9G: EMCS CONTROL OF EXHAUST FANS AT RAVENS STADIUM

Unit #	Service	Level
VF-26A & B	Electric Room	Press-A
VF-27A & B	Electric Room	Press-B
VF-28A & B	Electric Room	Press-C
VF-29A & B	Electric Room	Press-D

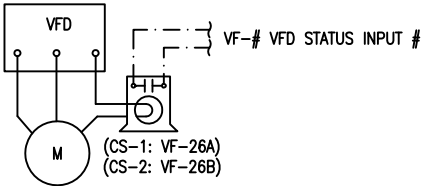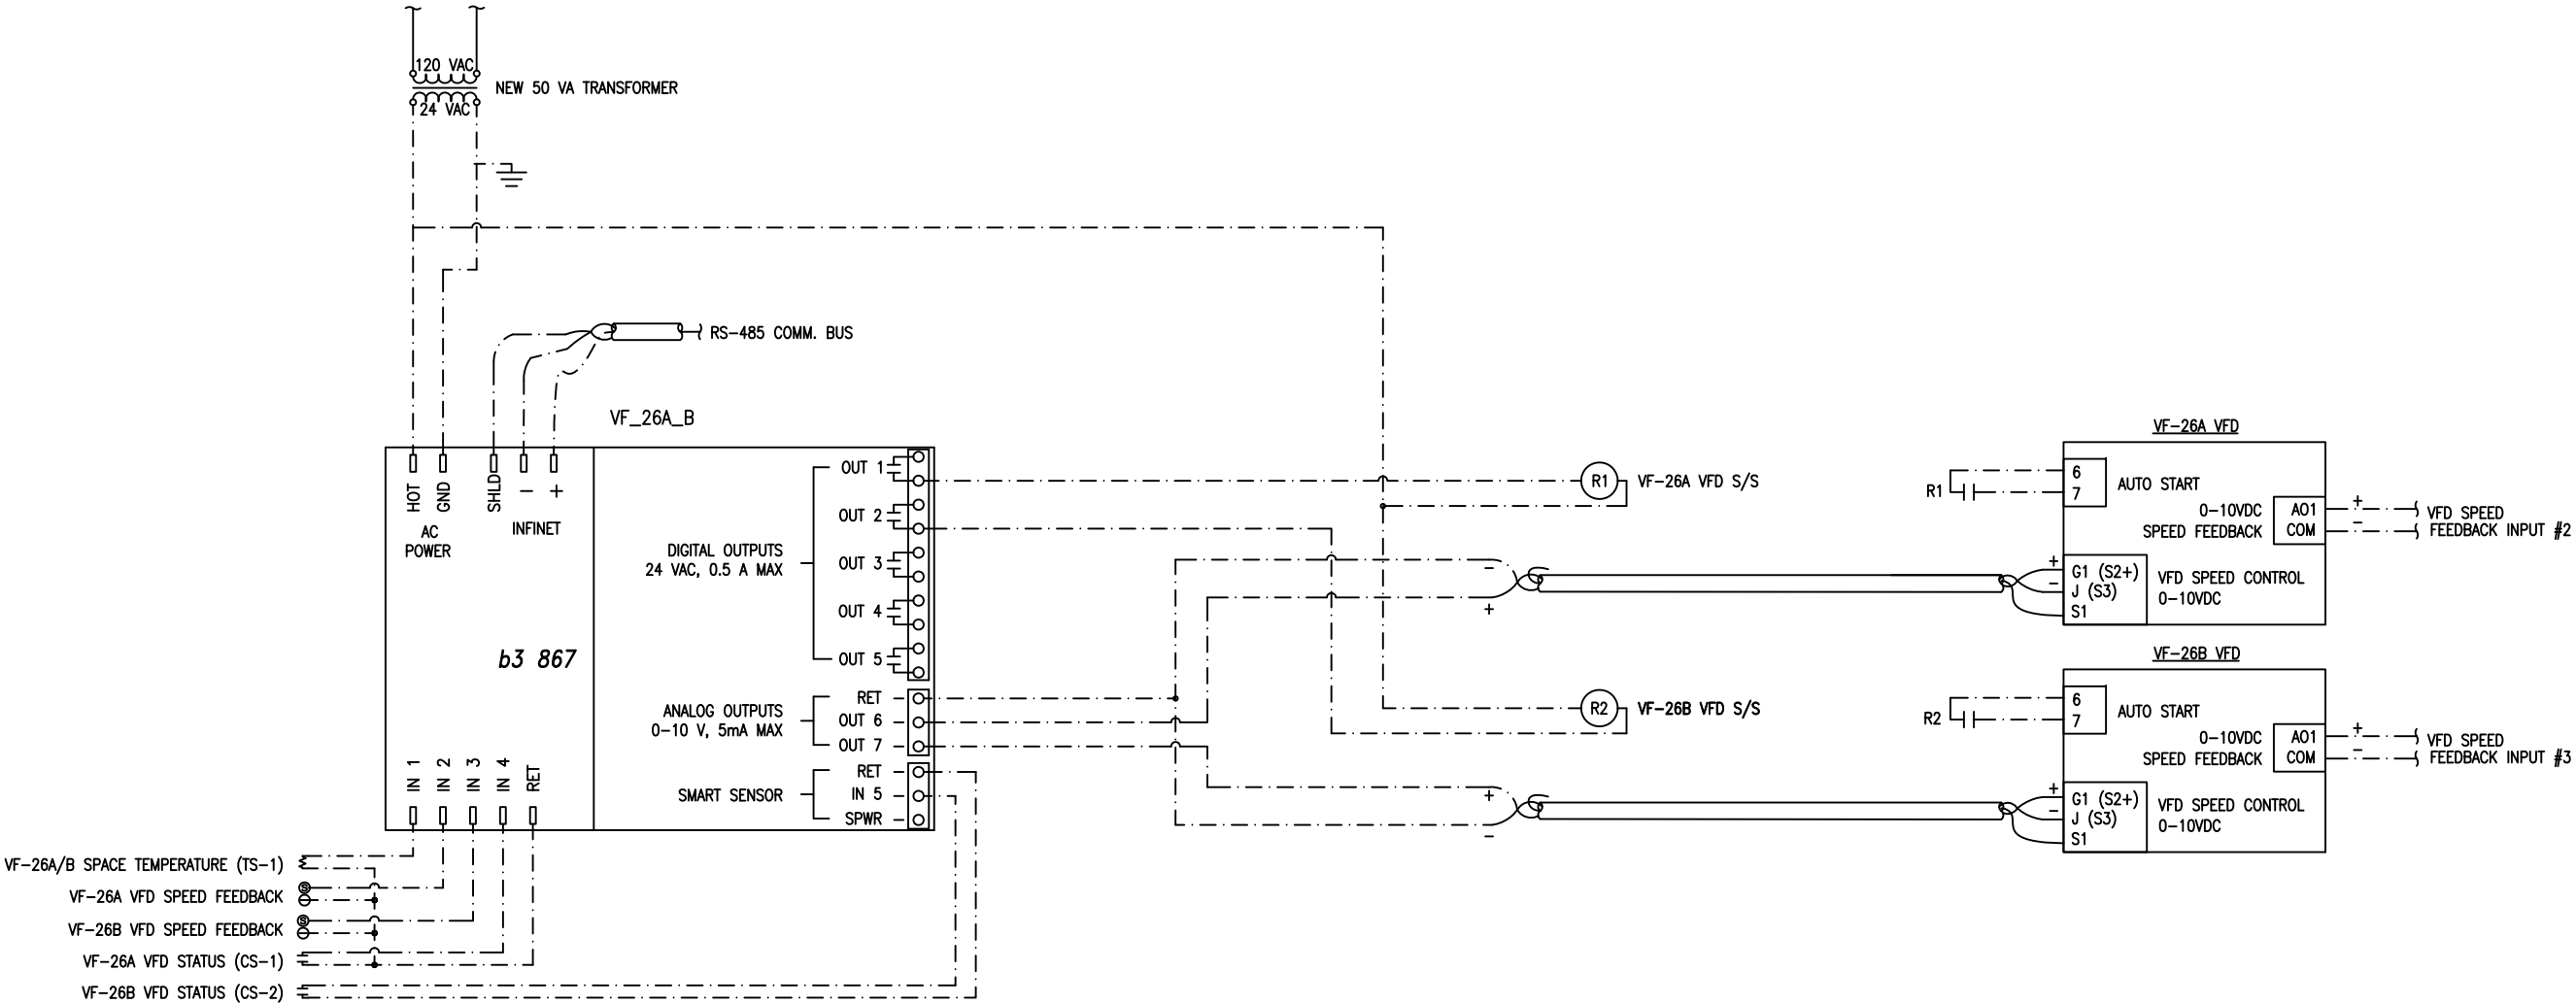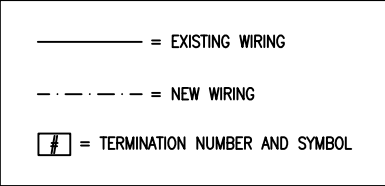

VF-26A & B VFD FAN STATUS WIRING, TYPICAL FOR 6 ADDITIONAL VFDS ((VF-27,28,29(A&B)))

SEE DWG. 3.6 FOR PANEL LAYOUT AND BILL OF MATERIALS






Typical for 4

Tag	Qty.	Mfg.	Model	Range	Description
TS-1	1	Mamac	TE-205-EX-7-0	32°F to 158°F	Space temp. sensor
R-1,2	2	Veris	V100	10amp @ 277vac	24vac SPDT relay w/ LED.
CS-1,2	2	Veris	H904	3.5-135A	Split core current switch for VFDs


Title VF-26A_B VFD Hardwired Points. Typical for VF-27,28,29(A&B)		
Project/Location M&T BANK STADIUM (RAVENS) MARYLAND STADIUM AUTHORITY PROJECT		
ESI engineered services inc		45150 Business Court Suite 100 Sterling, Virginia 20166 Tel. (703) 471-6310 Fax (703) 471-3919
PM: EK		Engineer: BH
Asbuilt 11/22/10	Job # 4828	Dwg. Name 6.3 RAV.VF-26_27_28_29AB_VFD

ECM-9H: MODIFY OPERATION OF SERVICE LEVEL HEATING AND VENTILATING UNITS AT RAVENS STADIUM – CONTROLLER REPLACEMENT REQUIRED

ECM-9H: MODIFY OPERATION OF SERVICE LEVEL HEATING AND VENTILATING UNITS AT RAVENS STADIUM – CONTROLLER REPLACEMENT REQUIRED

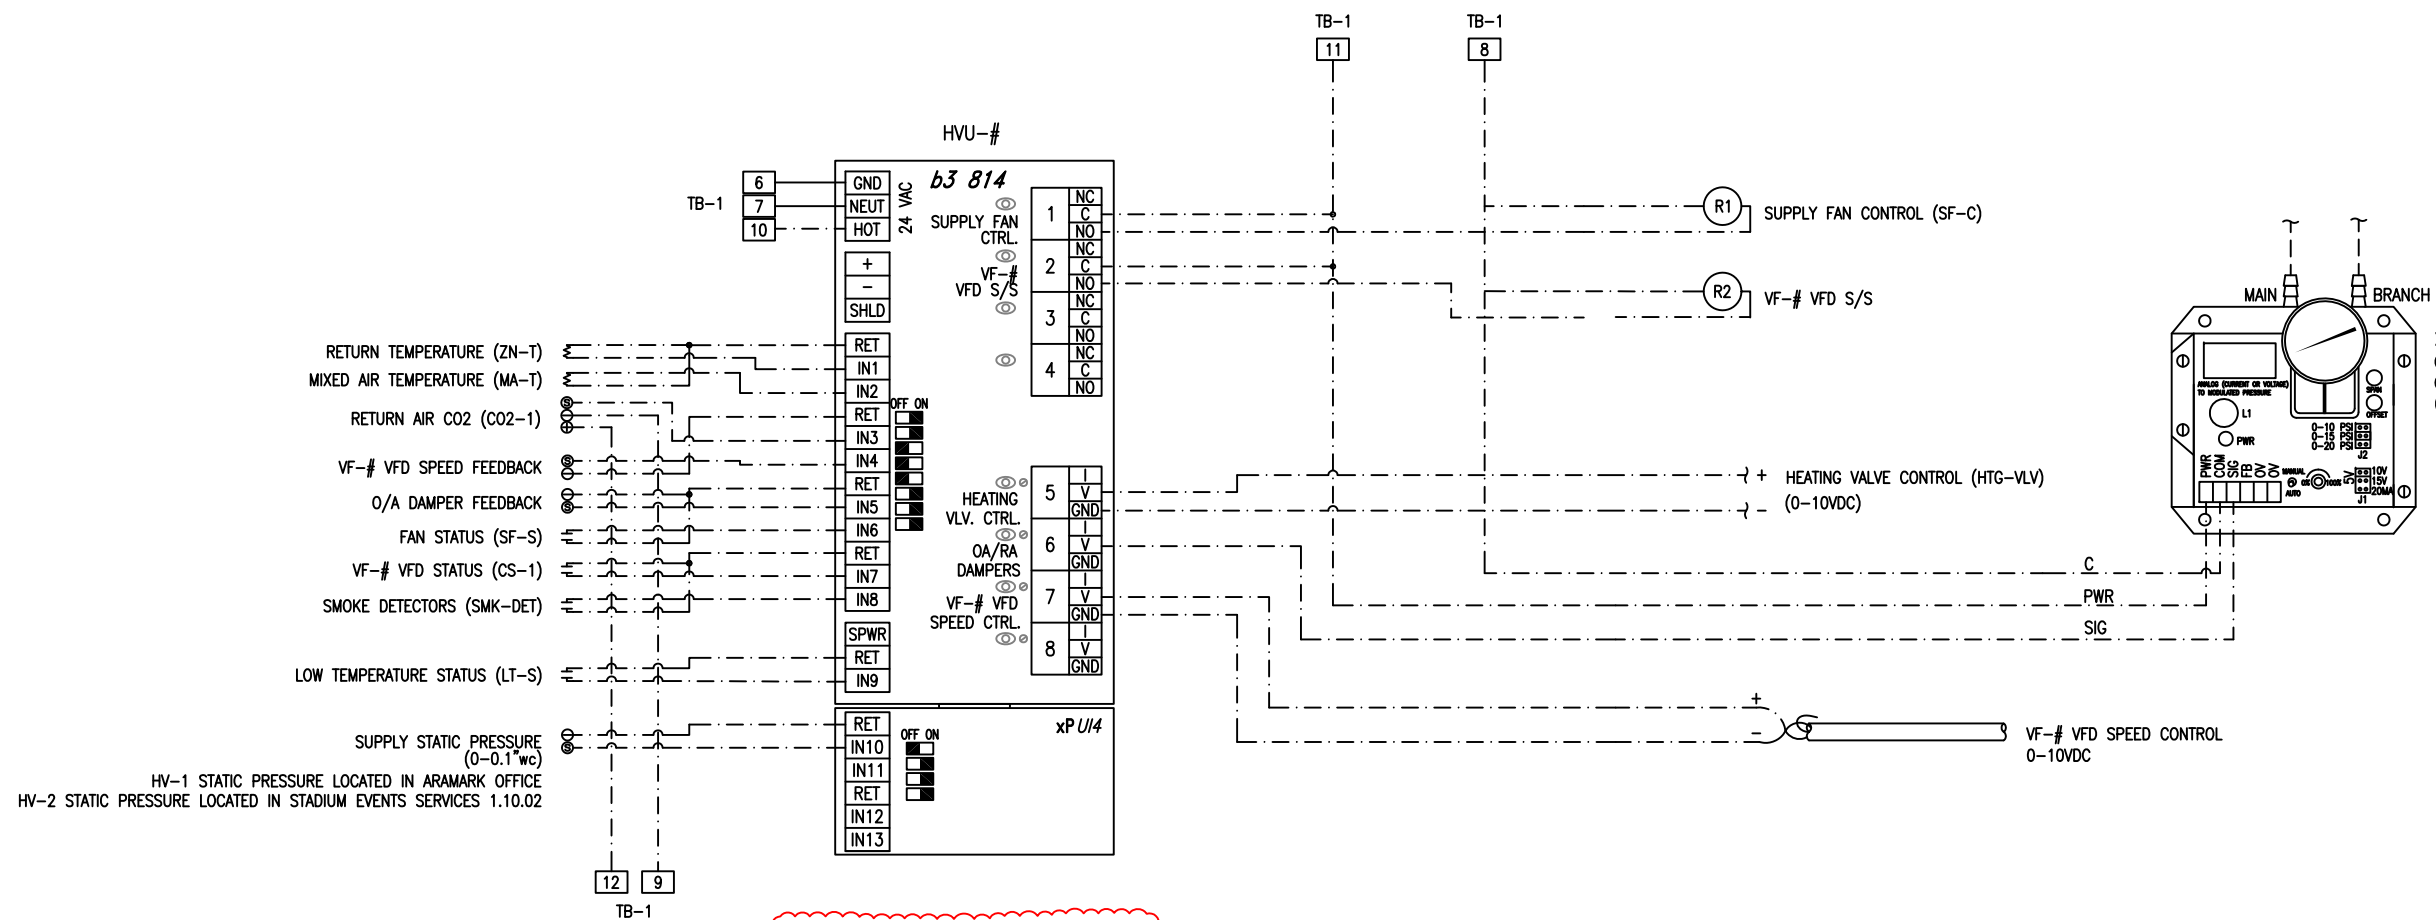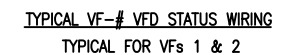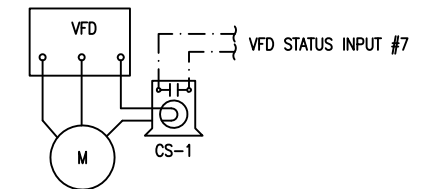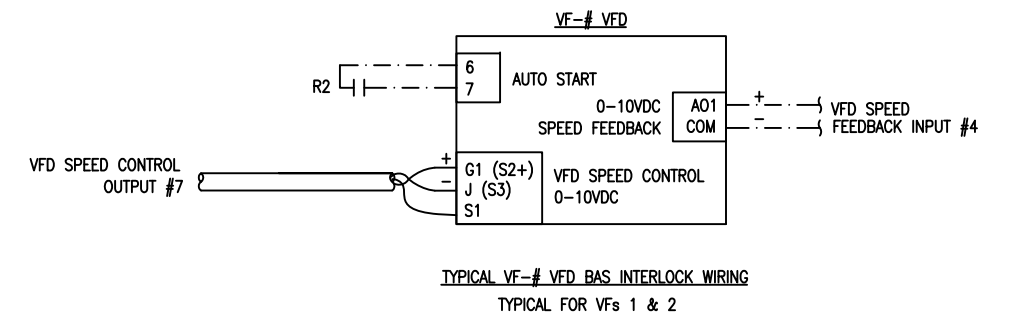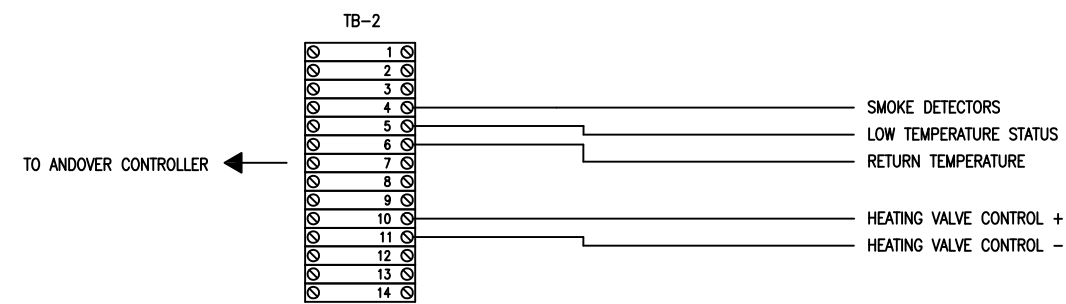

TB-2 & XD-1 INSTALLED IN EXISTING HVU PANEL

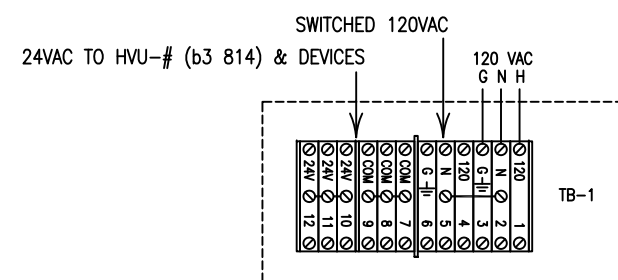


SEE DWG. 3.8 FOR POWER BLOCK WIRING

Typical for 2 Units




Tag	Qty.	Mfg.	Model	Range	Description
ZN-T	1	MAMAC	TE-205-G-7	-40°F to 140°F ± .4°F	Space temp. sensor without enclosure
MA-T	1	MAMAC	TE-707-B-7-B-2	-40°F to 160°F ± .4°F	Duct averaging temperature sensor, 12', galvanized steel enclosure
CO2-1	1	TAC/AirTest	ATT-TR9292-B	0-2000 ppm	Duct CO2 Transmitter, 0-10V or 4-20mA output
CS-1	1	Veris	H904	3.5-135A	Split core current switch for VFDs
R-2	1	Veris	V100	10amp @ 277vac	24vac SPDT relay w/ LED.

Title		
HVU-1 & 2 ADDITIONS TO NEW CONTROLLER		
Project/Location		
M&T BANK STADIUM (RAVENS) MARYLAND STADIUM AUTHORITY PROJECT		
 45150 Business Court Suite 100 Sterling, Virginia 20166 Tel. (703) 471-6310 Fax (703) 471-3919		
PM: EK		Engineer: BH
Asbuilt 11/22/10	Job # 4828	Dwg. Name 7.2 RAVENS.HVU-1&2_Add._Wiring


ECM-9H: MODIFY OPERATION OF SERVICE LEVEL HEATING AND VENTILATING UNITS AT RAVENS STADIUM

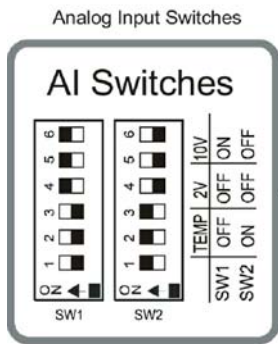

SWITCH SETTINGS:
MIXED AIR TEMPERATURE (TS-1): SW1 TO OFF, SW2 TO ON
RETURN AIR CO2 (CO2-1): SW1 TO ON, SW2 TO OFF

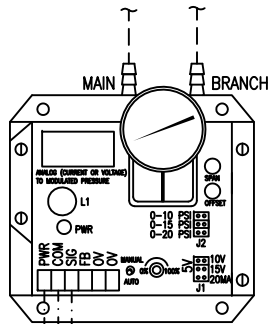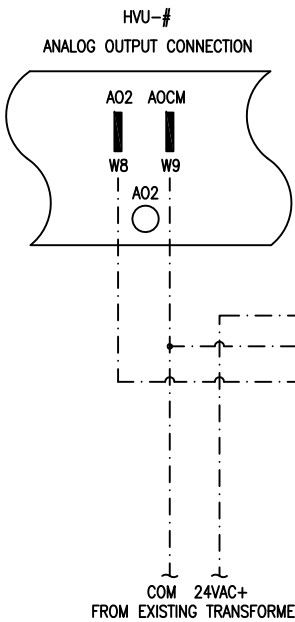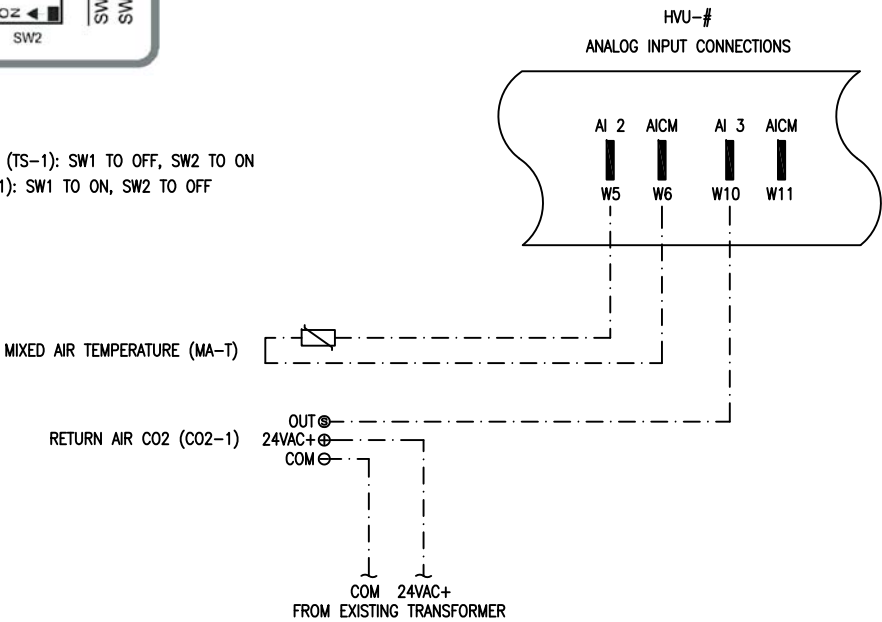

XD-1
OA/RA DAMPER
OA DAMPER N.C./ RA DAMPER N.O.
(0-10VDC = 0-15psi)

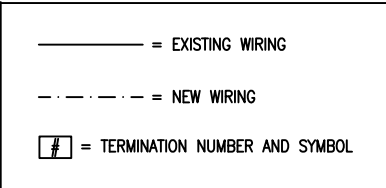

Typical for 2 Units

Tag	Qty.	Mfg.	Model	Range	Description
MA-T	1	MAMAC	TE-707-B-4-B-2	-40°F to 160°F ± .4F°	Duct averaging temperature sensor, 12", galvanized steel enclosure
CO2-1	1	TAC/AirTest	ATT-TR9292-B	0-2000 ppm	Duct CO2 Transmitter, 0-10V or 4-20mA output
XD-1	1	ACT	EPC2GFSB	0 to 10,15,20 VDC , 0-20mA	Analog Current or Voltage Input to Pneumatic Output including Fail Safe

Title

HVU-3 & 5
ADDITIONS TO EXISTING JC

Project/Location

M&T BANK STADIUM (RAVENS)
MARYLAND STADIUM AUTHORITY PROJECT

ESI

engineered
services inc

45150 Business Court
Suite 100
Sterling, Virginia 20166
Tel. (703) 471-6310
Fax (703) 471-3919

PM: EK



Asbuilt
11/22/10

Engineer: BH


Job #
4828

Dwg. Name
7.3 RAVENS.HVU-3&5_Add._Wiring

ECM-8E: HEATING CONTROLS UPGRADE AT RAVENS STADIUM

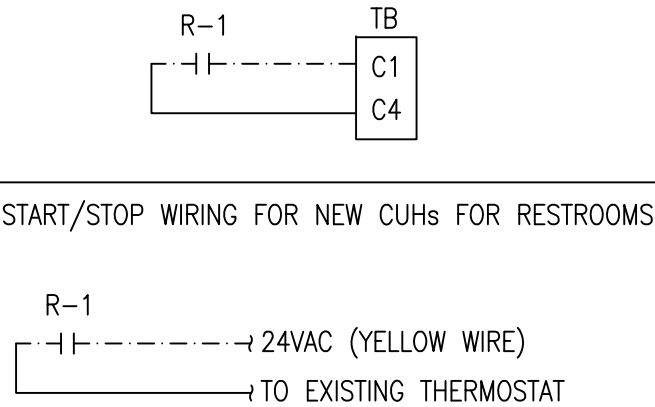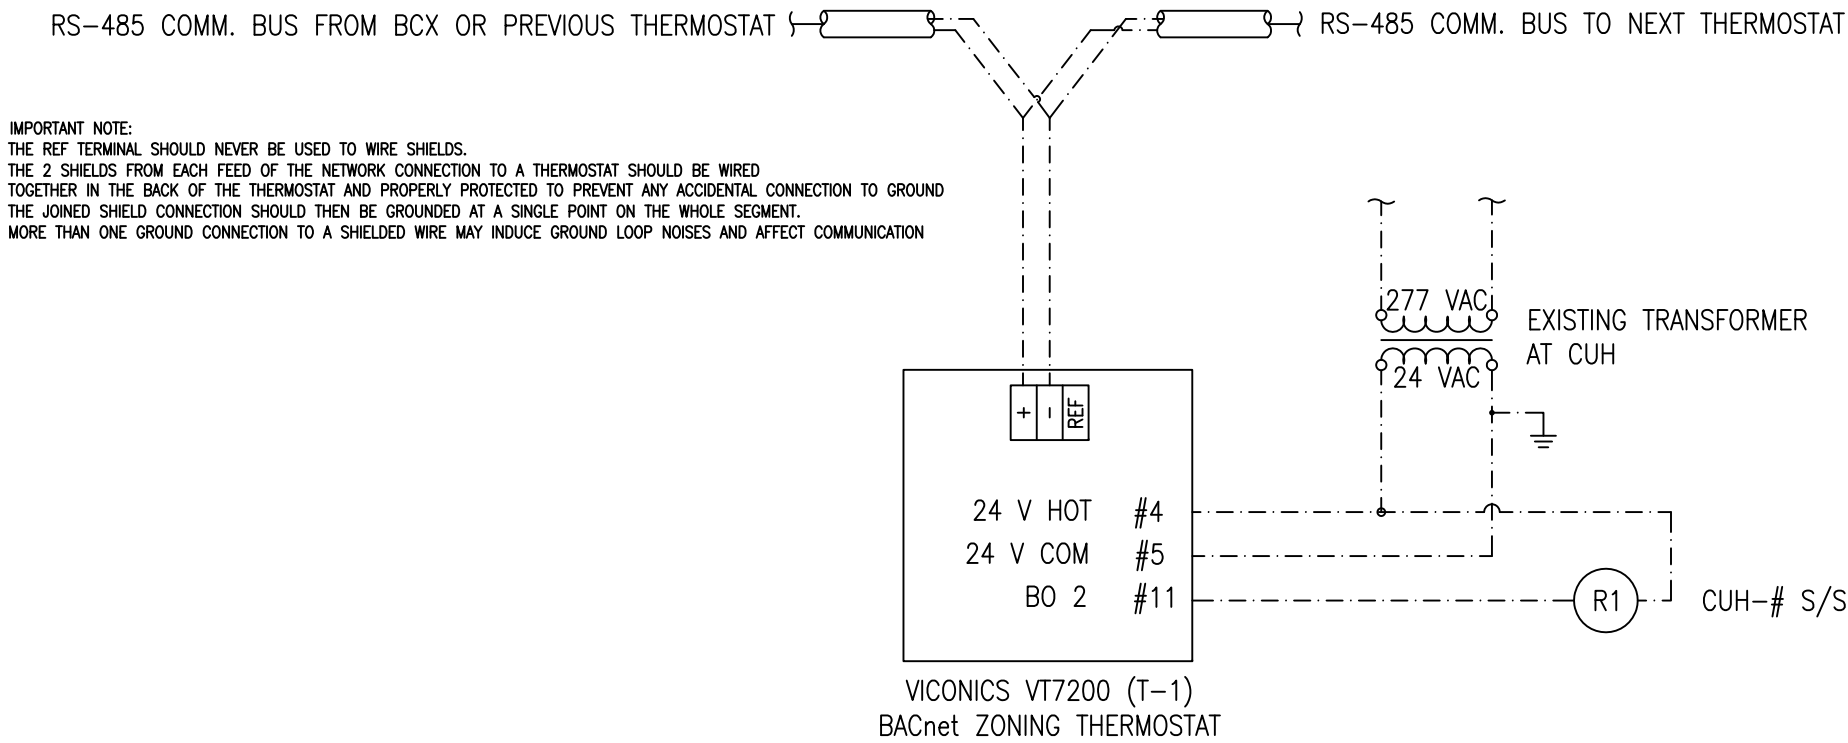


WIRING TYPICAL FOR 141 CUHs
SEE DRAWING 2.1 THROUGH 2.4 FOR QUADS A THRU D RS-485 BACnet COMM. TOPOLOGY

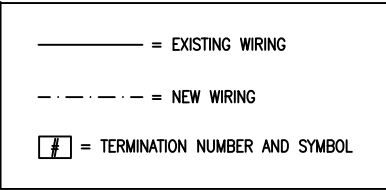


Tag	Qty.	Mfg.	Model	Range	Description
R-1	141	Veris	V100	10amp @ 277vac	24vac SPDT relay w/ LED.
T-1	141	Viconics	VT7200C5018B	40°F to 90°F	24vac Zoning Thermostat, BACnet MS-TP communicating model

Title CABINET UNIT HEATERS THERMOSTAT WIRING (Typ. 141)		
Project/Location M&T BANK STADIUM (RAVENS) MARYLAND STADIUM AUTHORITY PROJECT		
ESI engineered services inc		45150 Business Court Suite 100 Sterling, Virginia 20166 Tel. (703) 471-6310 Fax (703) 471-3919
PM: EK		Engineer: BH
Asbuilt 11/22/10	Job # 4828	Dwg. Name 8.1 RAVENS_CUHs

ECM-9G: EMCS CONTROL OF EXHAUST FANS AT RAVENS STADIUM

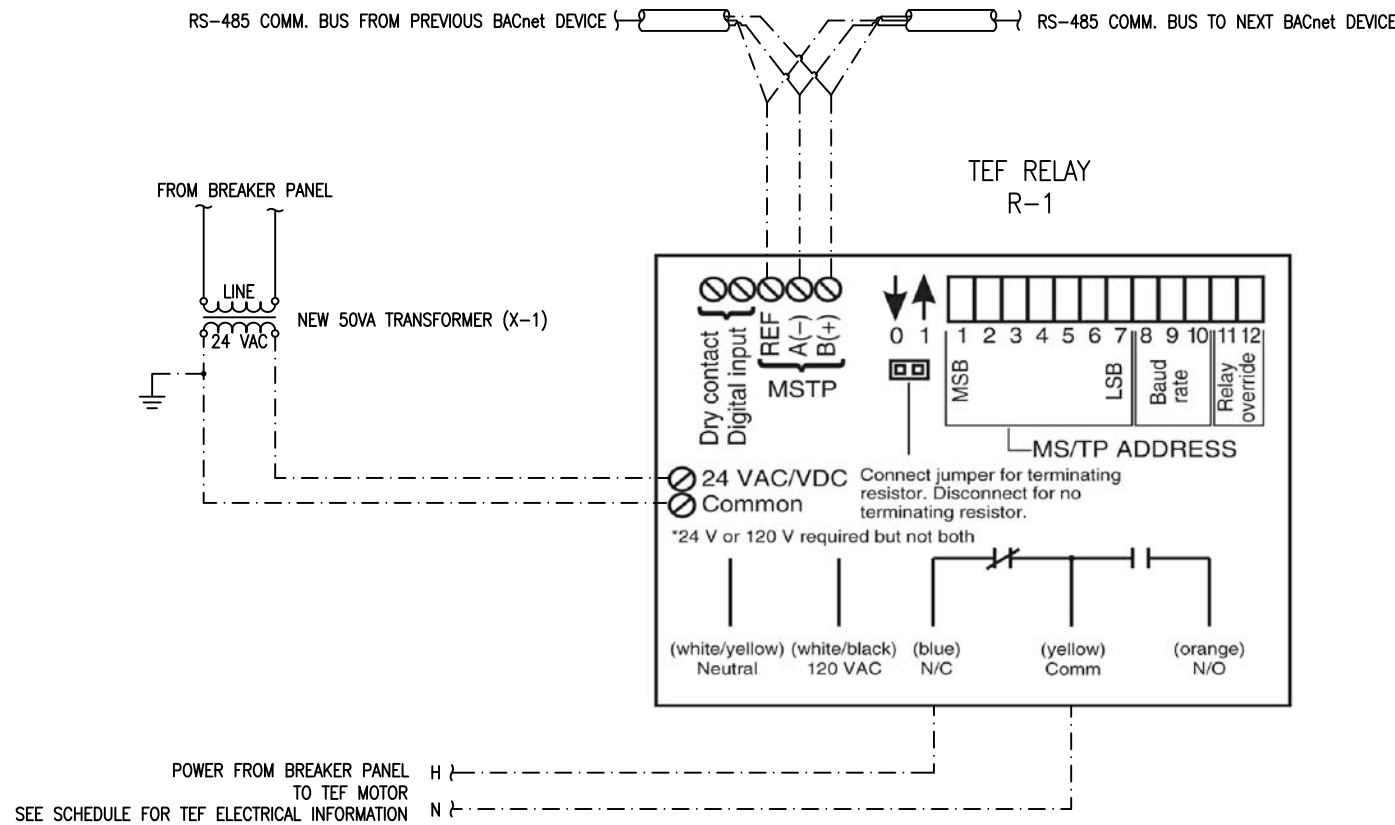

TEF RELAY WIRING DIAGRAM

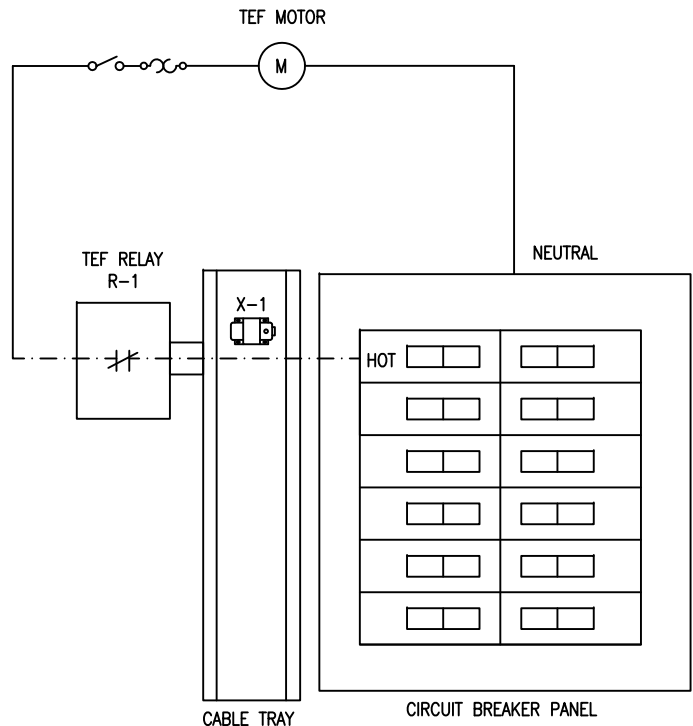

TEF REMOTE WIRING (SINGLE PHASE SHOWN)


SEE DRAWING 2.1 THROUGH 2.4 FOR QUADS A THRU D RS-485 BACnet COMM. TOPOLOGY & RELAY LOCATIONS

DIP Switches			Baud Rate	DIP Switches		Relay State*
8	9	10		11	12	
0	0	0	9600	1	0	Auto
0	0	1	19200	X	1	Override on
0	1	0	38400	0	0	Override off
0	1	1	57600	*Device must be powered for override		
1	0	0	76800			
1	0	1	115200			

All other combinations=9600 baud

* Dry contact digital input is a general purpose input that is not tied to the relay internally. Can be used with any dry contact switching device, such as a current sensor, to feed back to the network.

- Notes:
- MS/TP Address & Baud Rate must be set prior to power up via DIP switches.
 - Device ID will default to 277XXX where XXX is the MS/TP Address.
 - Examples:
 - Device ID can be changed via network command. Once changed, it will no longer default to 277XXX.
 - (MS/TP Address & Device ID must be unique.)
 - PIC Statement Available for Download
 - Objects included in device are:
 - BO 1 (Binary output)
 - BI 1 (Binary input)
 - BI 2 (Binary input)
 - AI 1 (Analog input)
 - This model utilizes only:
 - BO 1
 - BI 1
 - Device Instance changed via Object Identifier
 - Property of Device Object

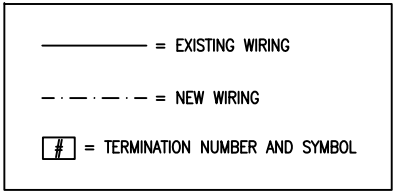

Tag	Qty.	Mfg.	Model	Range	Description
R-1	80	Kele	RIBTW2401B-BC	20amp @ 277vac	24vac SPDT BACnet relay in a box
X-1	80	Veris	X050CBA	120/240/277/480V~24V	Control transformer, 50 VA, w/ circuit breaker

Title

TOILET EXHAUST FAN RELAY WIRING
(Typical for 80 TEFs)

Project/Location

M&T BANK STADIUM (RAVENS)
MARYLAND STADIUM AUTHORITY PROJECT

ESI

engineered
services inc

45150 Business Court
Suite 100
Sterling, Virginia 20166
Tel. (703) 471-6310
Fax (703) 471-3919



PM: EK

Asbuilt
11/22/10


Engineer: BH

Job #
4828

Dwg. Name
8.2 RAVENS_TEF_Wiring

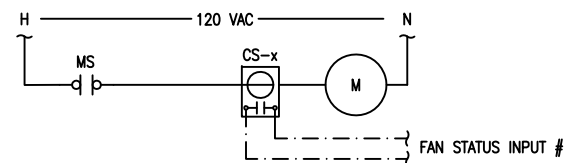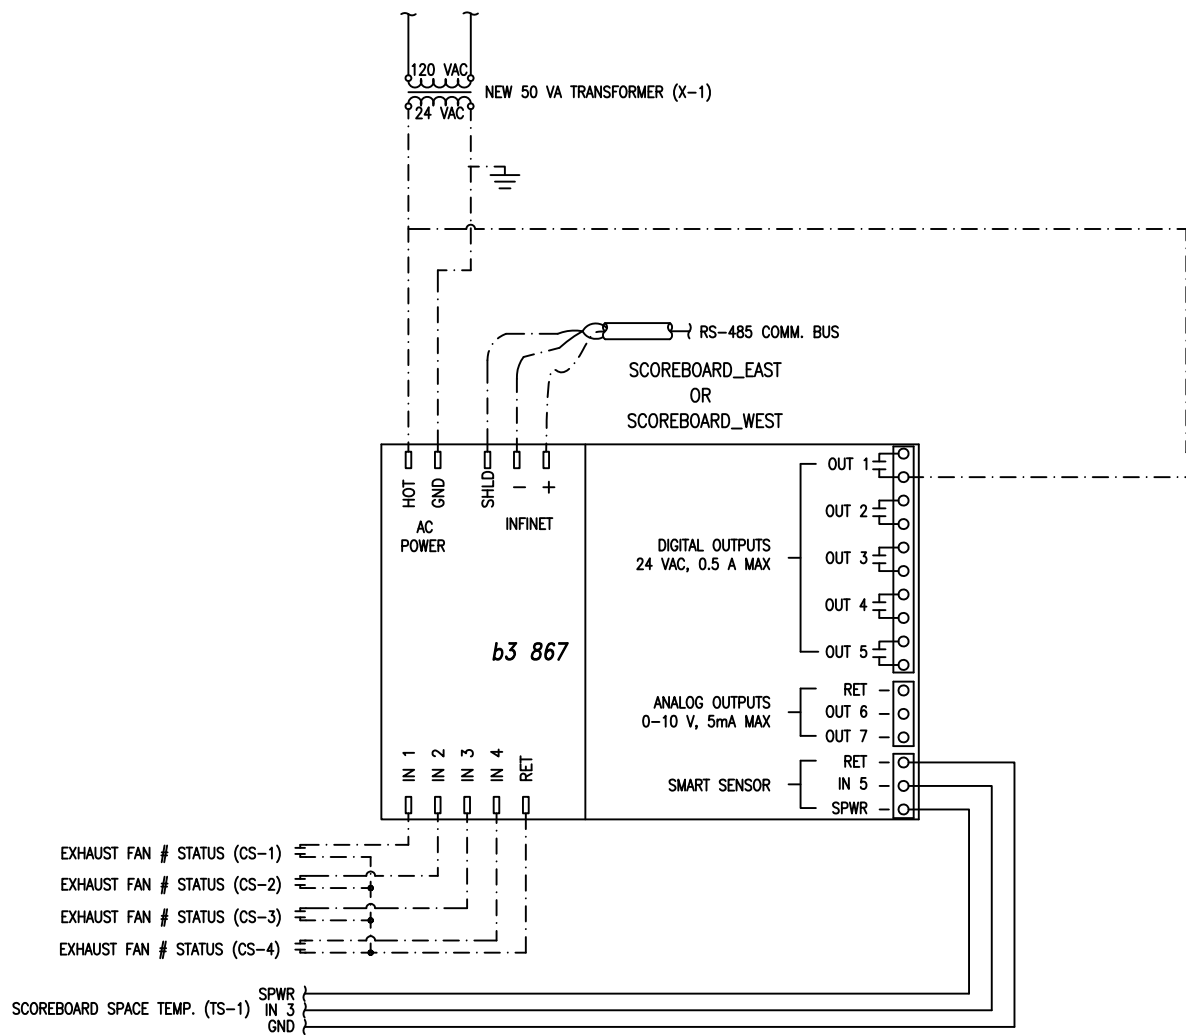

TYPICAL EXHAUST FAN STATUS WIRING
(TYPICAL FOR 4 EXHAUST FANS)






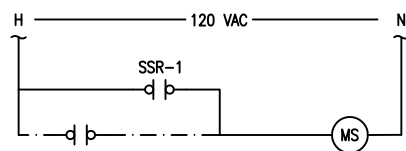


SSR-1 = SCOREBOARD STATUS RELAY BOARD (N.O.)
MS = EXHAUST FANS MOTOR STARTER

— = PANEL WIRING
- - - - - = FIELD WIRING
[#] = TERMINATION NUMBER AND SYMBOL

Tag	Qty.	Mfg.	Model	Range	Description
CS-1,2,3,4 R-1	4 1	Mamac Veris	CT-810 V100	1.0-200A adj. 10amp @ 277vac	Solid core adjustable setpoint current switch, max 150A continuous 24vac SPDT relay w/ LED.

Title SCOREBOARD EFs WIRING (Typical for 2, EAST & WEST)		
Project/Location M&T BANK STADIUM (RAVENS) MARYLAND STADIUM AUTHORITY PROJECT		
ESI engineered services inc 45150 Business Court Suite 100 Sterling, Virginia 20166 Tel. (703) 471-6310 Fax (703) 471-3919		
PM: EK	Engineer: BH	
Asbuilt 11/22/10	Job # 4828	Dwg. Name 8.3 Ravens Scoreboard EFs

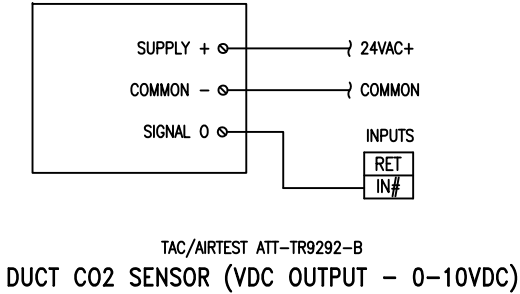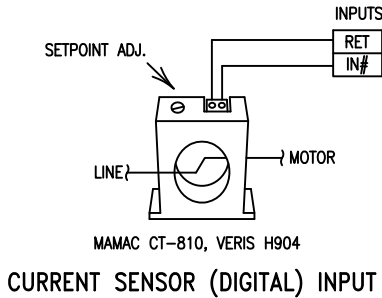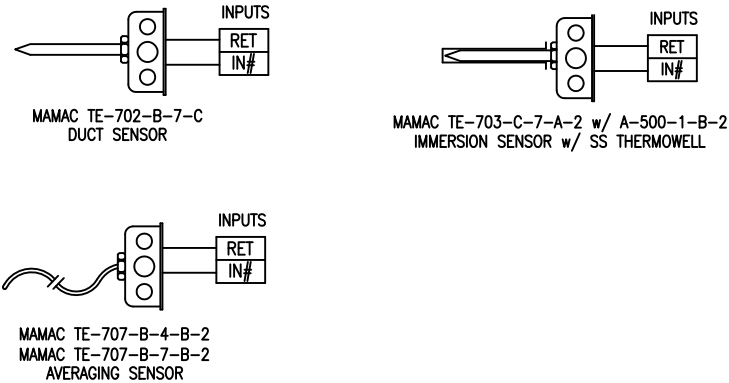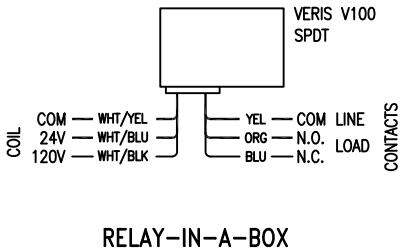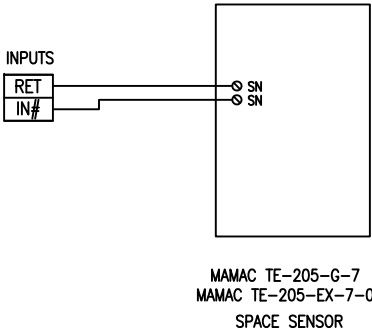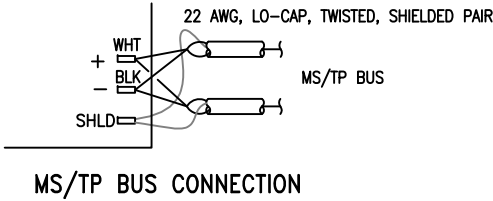

Title TYPICAL WIRING DETAILS		
Project/Location M&T BANK STADIUM (RAVENS) MARYLAND STADIUM AUTHORITY PROJECT		
ESI engineered services inc		45150 Business Court Suite 100 Sterling, Virginia 20166 Tel. (703) 471-6310 Fax (703) 471-3919
PM: EK		Engineer: BH
Asbuilt 11/22/10	Job # 4828	Dwg. Name 9.1 Typical_Details